

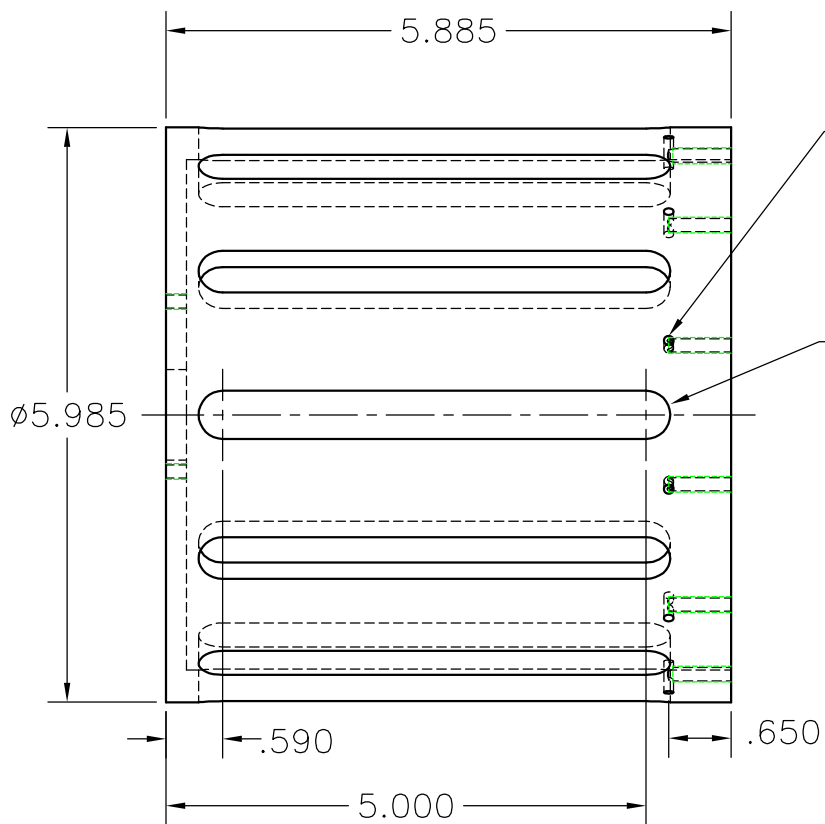


TAP #8-32
 .650 DEEP
 ON $\phi 5.590$ CIRCLE
 12 PLACES
 EQUALLY SPACED 30° APART
 15° OUT OF PHASE
 WITH SLOTS

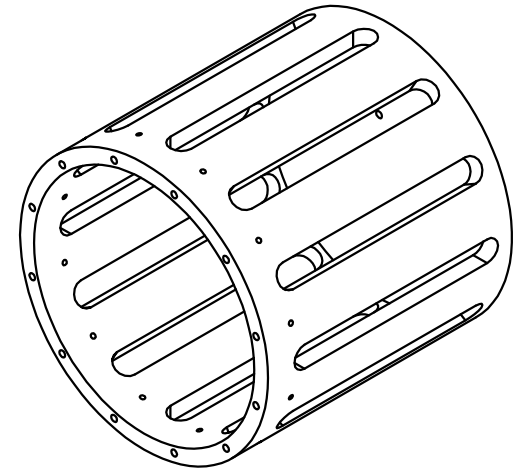

DRILL VENTS
 FOR TAPPED HOLES
 $\phi .100$
 THRU SHELL
 12 PLACES

R.250
 SLOT 12 PLACES
 EQUALLY SPACE
 30° APART

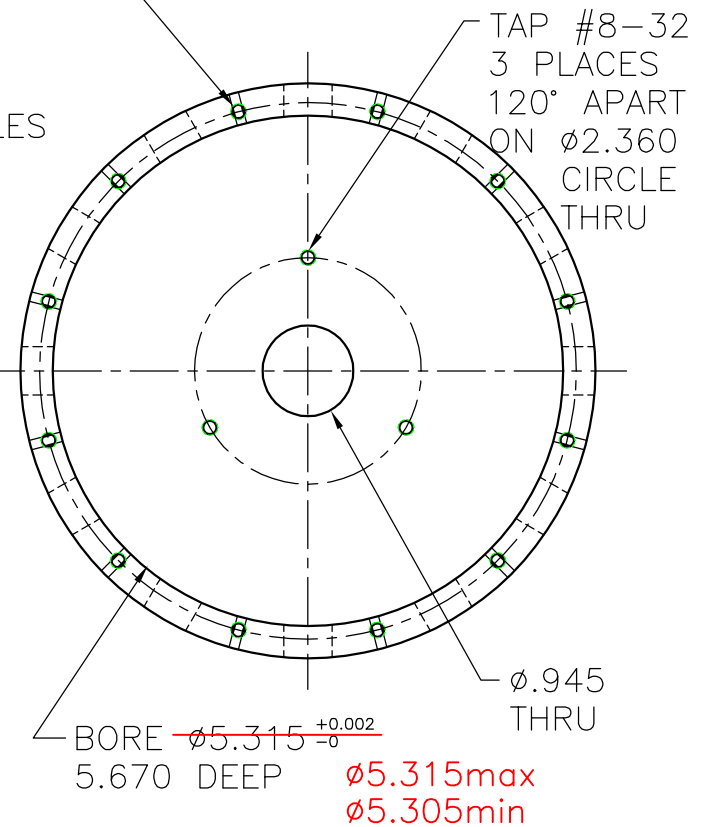

TAP #8-32
 3 PLACES
 120° APART
 ON $\phi 2.360$
 CIRCLE
 THRU

BORE ~~$\phi 5.315$~~ $\begin{matrix} +0.002 \\ -0 \end{matrix}$
 5.670 DEEP

$\phi 5.315_{max}$
 $\phi 5.305_{min}$

$\phi .945$
 THRU

UF PHYS

ELIGO LLO FR

SCALE: HALF (INCHES)

DATE: NOVEMBER 27, 2006

WILLIAMS, LUKE

MAGNET CAN

D080173-00

QTY: 1

MATERIAL: 6061-T6