


- NOTES:**
- SEE SHEET BT-C-002 FOR GENERAL NOTES, LEGEND AND ABBREVIATIONS.
 - SEE SHEET BT-C-004 FOR TYPICAL SECTIONS AND DETAILS.
 - CONTRACTOR SHALL GRADE AND LEVEL SITE FOR HIS USE, BUT IN A MANNER THAT IT CONTINUOUSLY AND EFFECTIVELY DRAINS AND CAUSES NO DAMAGE OR PONDING IN CONSTRUCTION WORK AREAS OR FINAL SITE.

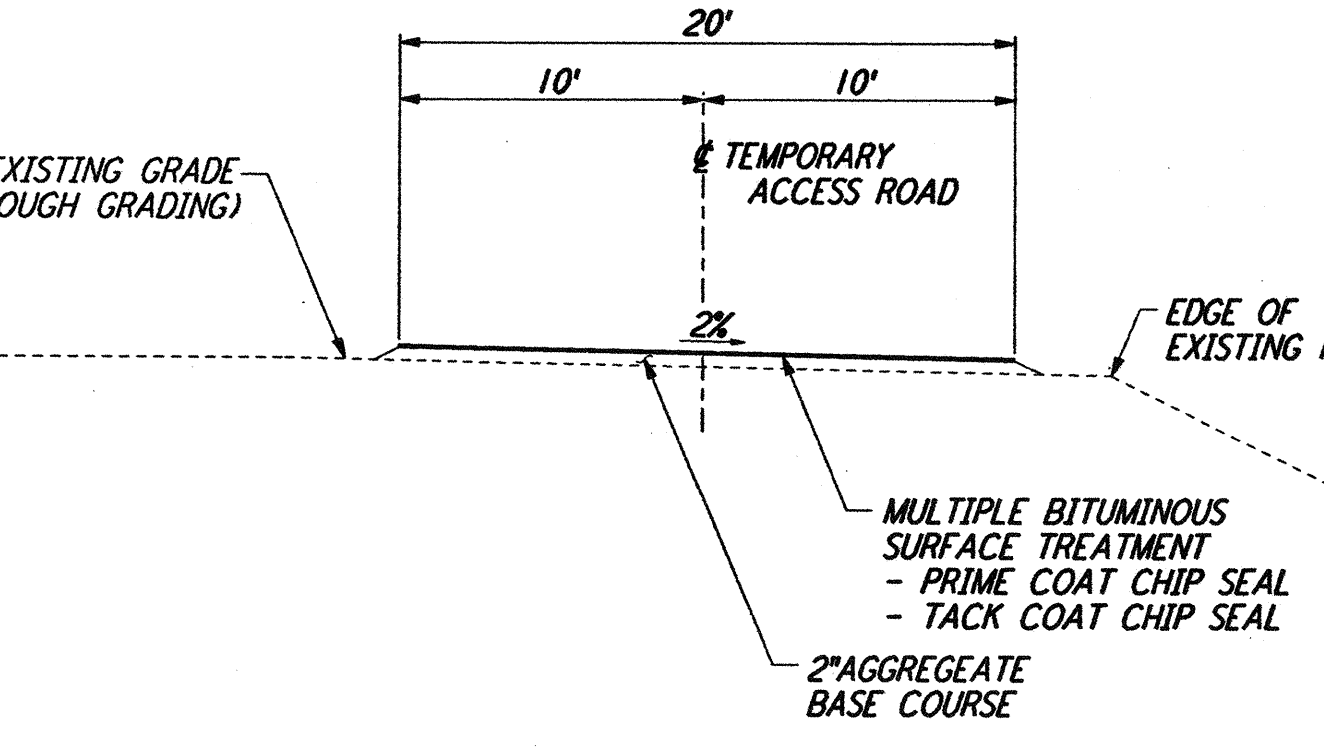


TEMPORARY ACCESS ROAD
 NOT TO SCALE


CURVE DATA (TEMPORARY ACCESS ROAD)					
STATION	R	Δ	L	T	REMARK
1	40.00'	90°00'00"	62.83'	40.00'	EDGE OF ROAD
2	55.00'	51°29'57"	49.44'	26.53'	EDGE OF ROAD
3	55.00'	38°30'03"	36.96'	19.21'	EDGE OF ROAD
4	110.00'	30°00'00"	57.60'	29.47'	
5	110.00'	11°44'13"	22.53'	11.31'	
6	64.33'	18°15'47"	20.51'	10.34'	TEMPORARY ACCESS ROAD
7	62.00'	48°19'28"	52.29'	27.81'	
8	63.00'	48°19'28"	53.14'	28.26'	

not be reproduced, copied, loaned, exhibited, or used in any other way, except by written consent from PARSONS to the borrower.


This document and the design it covers are the property of PARSONS. They are loaned only with the borrower's expressed written agreement that they will

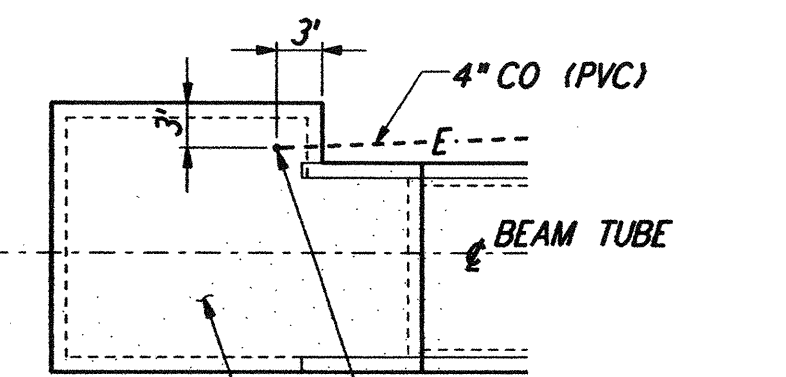

DETAIL
 NOT TO SCALE

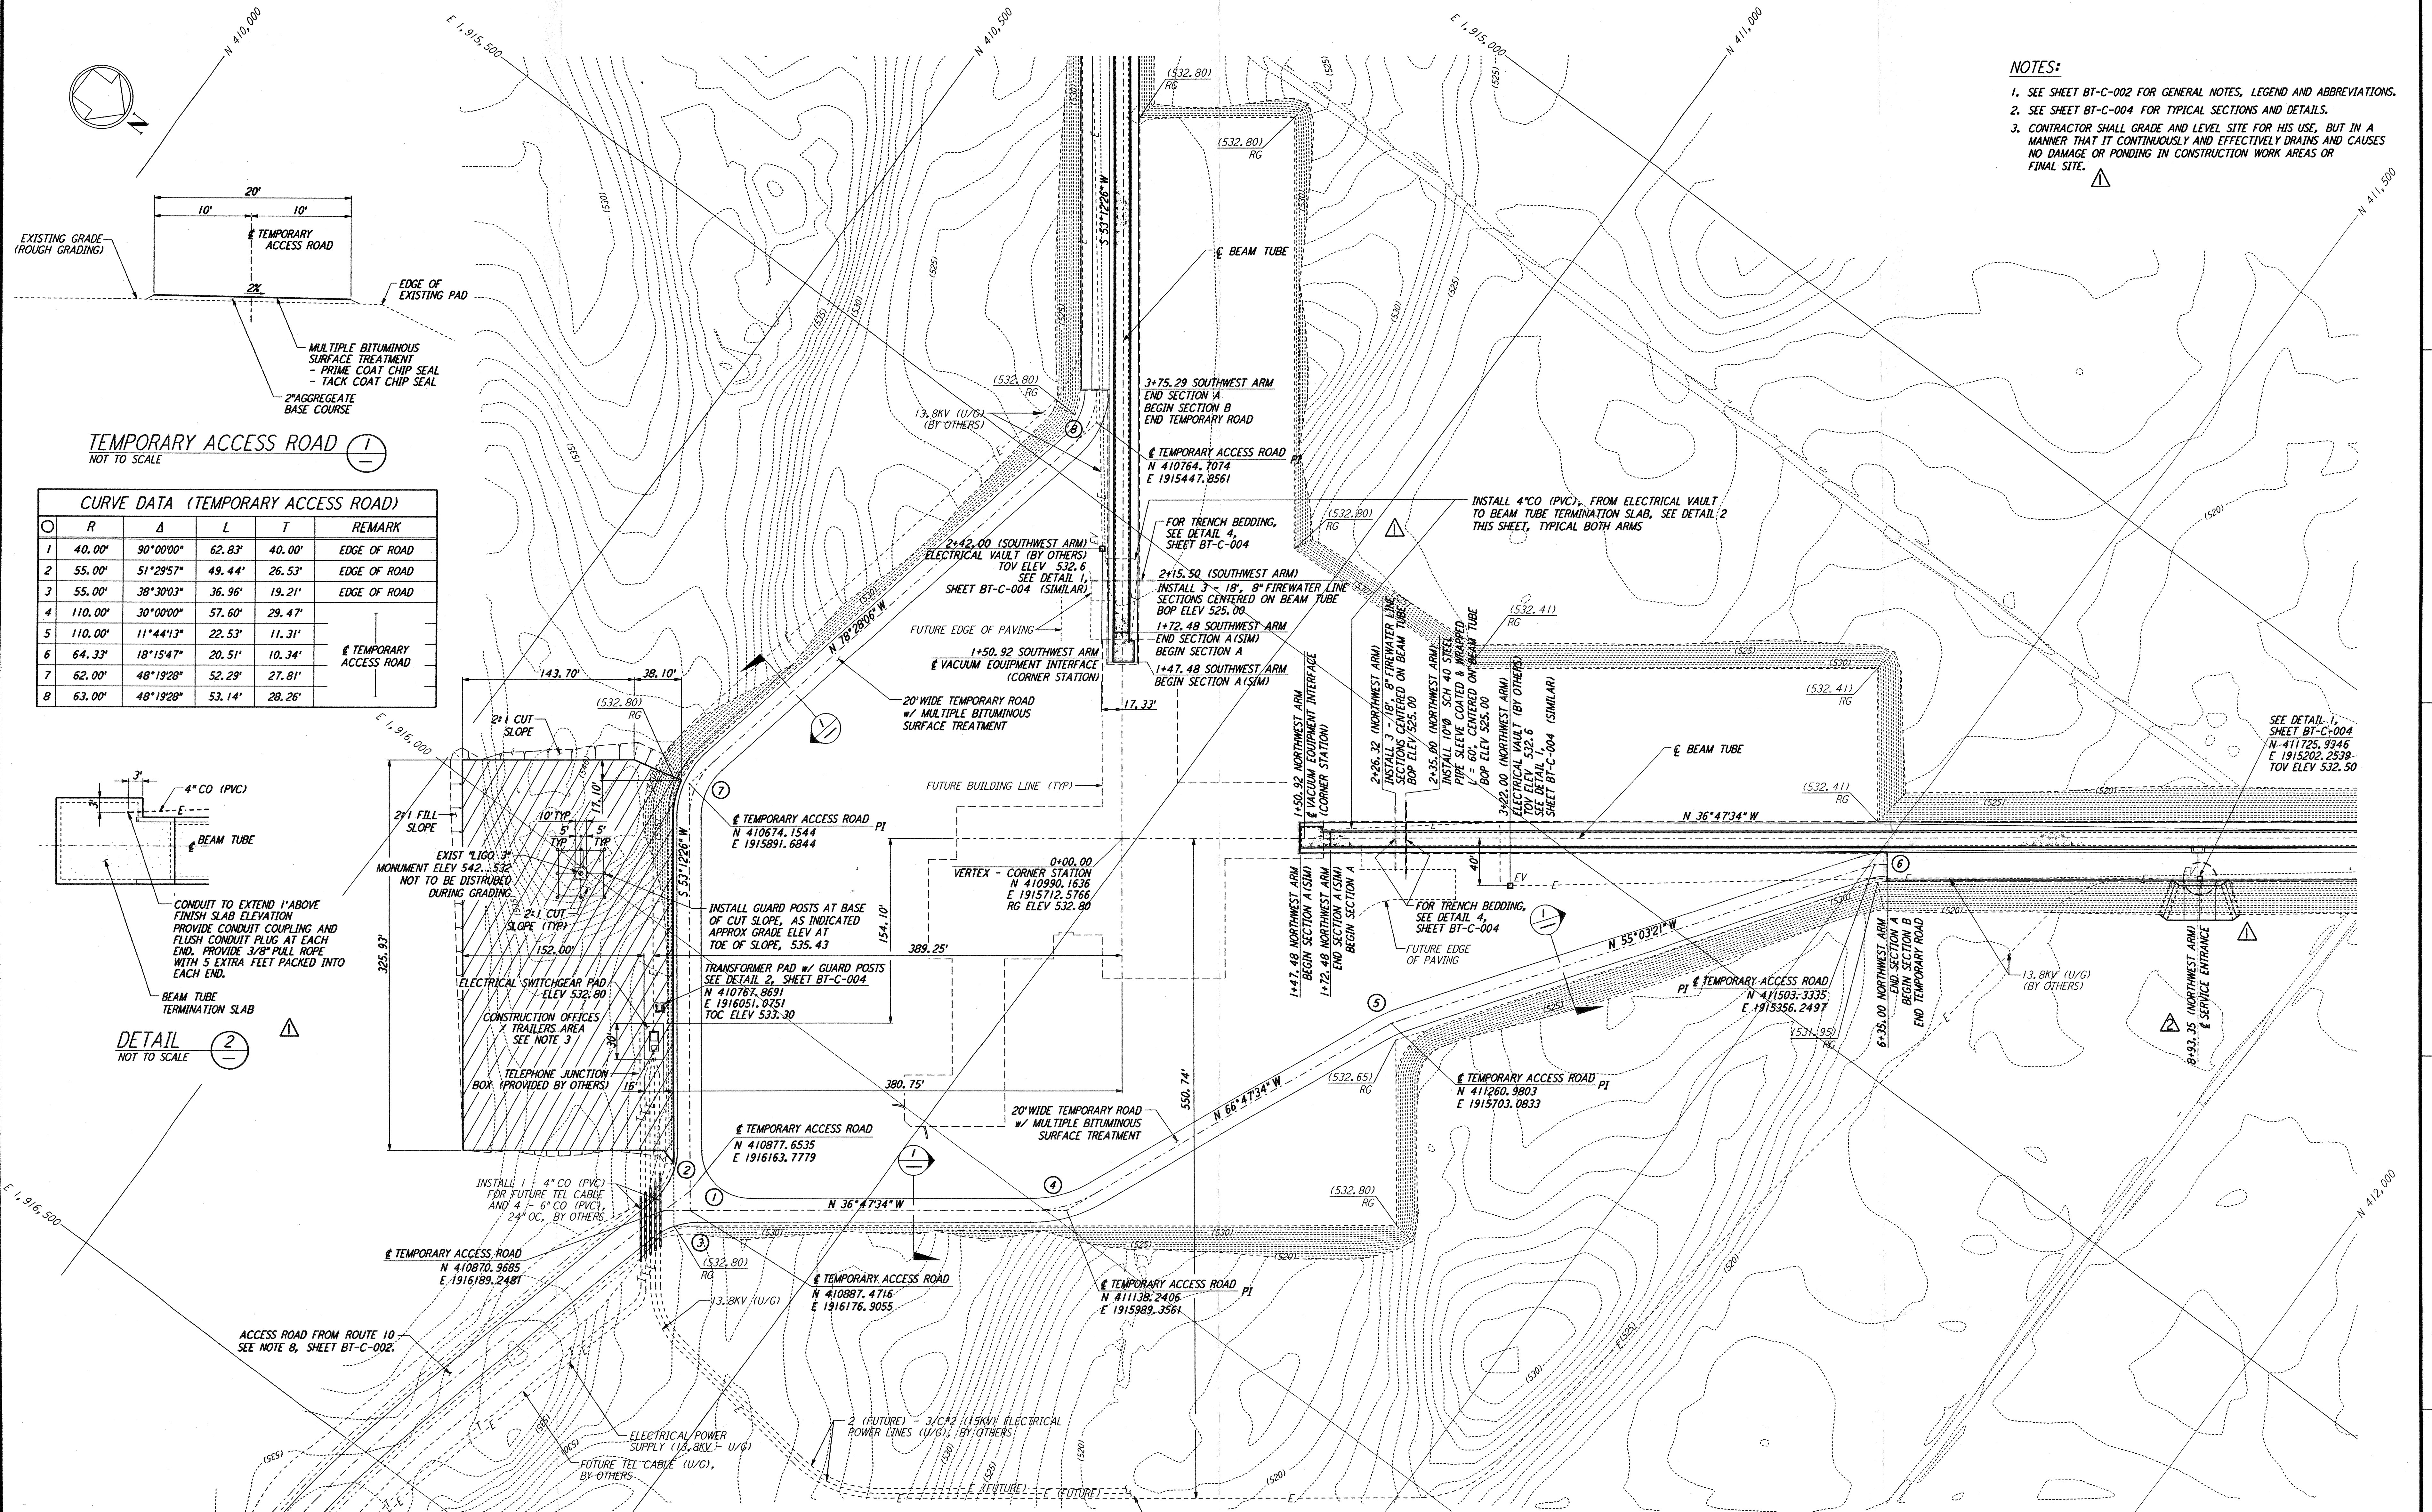

LIGO-D960165-03-0

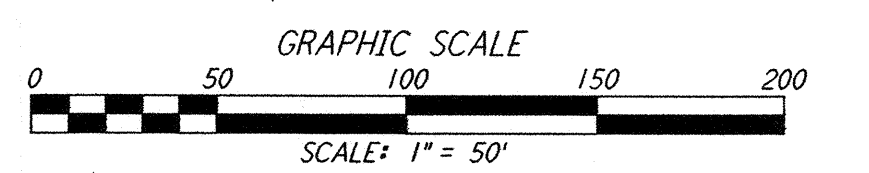

NO.	DATE	BY	CHKD	ENGR	PROJ	DESCRIPTION
3	1-22-99	MET	--	--	MDW	ISSUED FOR AS BUILT
2	5-10-96	WRB	TDM	JB	MDW	REVISED BEAM TUBE SERVICE ENTRANCES
1	2-29-96	WRB	TDM	JB	MDW	CHANGE ORDER NO. 2

ISSUED FOR CONSTRUCTION
 DRAWN WRB 1-19-96
 CHECKED MP 1-19-96
 ENGINEER JB 1-19-96
 PROJ MDW 1-19-96

AS-BUILT DRAWINGS

PARSONS

100 WEST WALNUT STREET
 PASADENA, CALIFORNIA

LIGO

CALIFORNIA INSTITUTE OF TECHNOLOGY
 MASSACHUSETTS INSTITUTE OF TECHNOLOGY

LASER INTERFEROMETER
 GRAVITATIONAL-WAVE OBSERVATORY
 BTE SITework & FABRICATION - HANFORD, WA

CIVIL CORNER STATION PLAN

SCALE: 1" = 50'
 CONTRACT NUMBER: PP150969
 PROJECT NUMBER: 8094

BT-C-005