



This document and the design it covers are the property of PARSONS. They are loaned only with the borrower's expressed written agreement that they will not be reproduced, copied, loaned, exhibited, or used in any other way, except by written consent from PARSONS to the borrower.

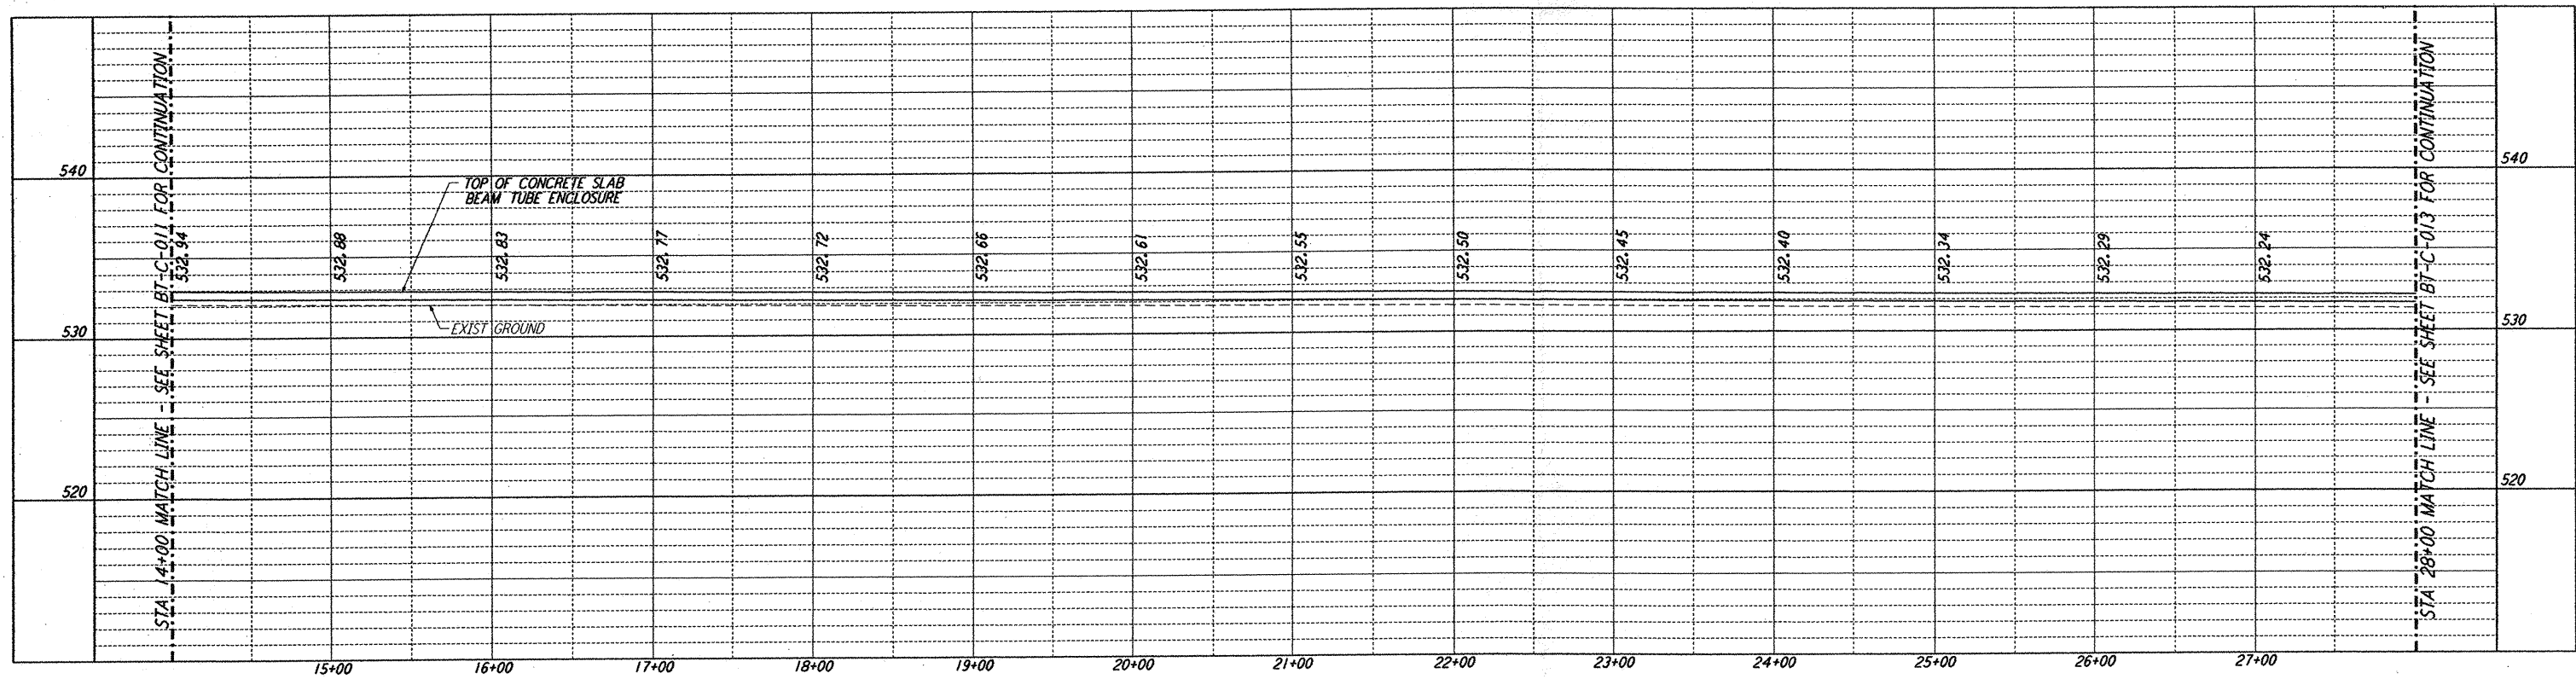


- NOTES:**
1. SEE SHEET BT-C-002 FOR GENERAL NOTES, LEGEND AND ABBREVIATIONS.
 2. SEE SHEET BT-C-004 FOR TYPICAL SECTIONS AND DETAILS.


PROFILE
 SCALES: HORIZ: 1" = 50'
 VERT: 1" = 5'

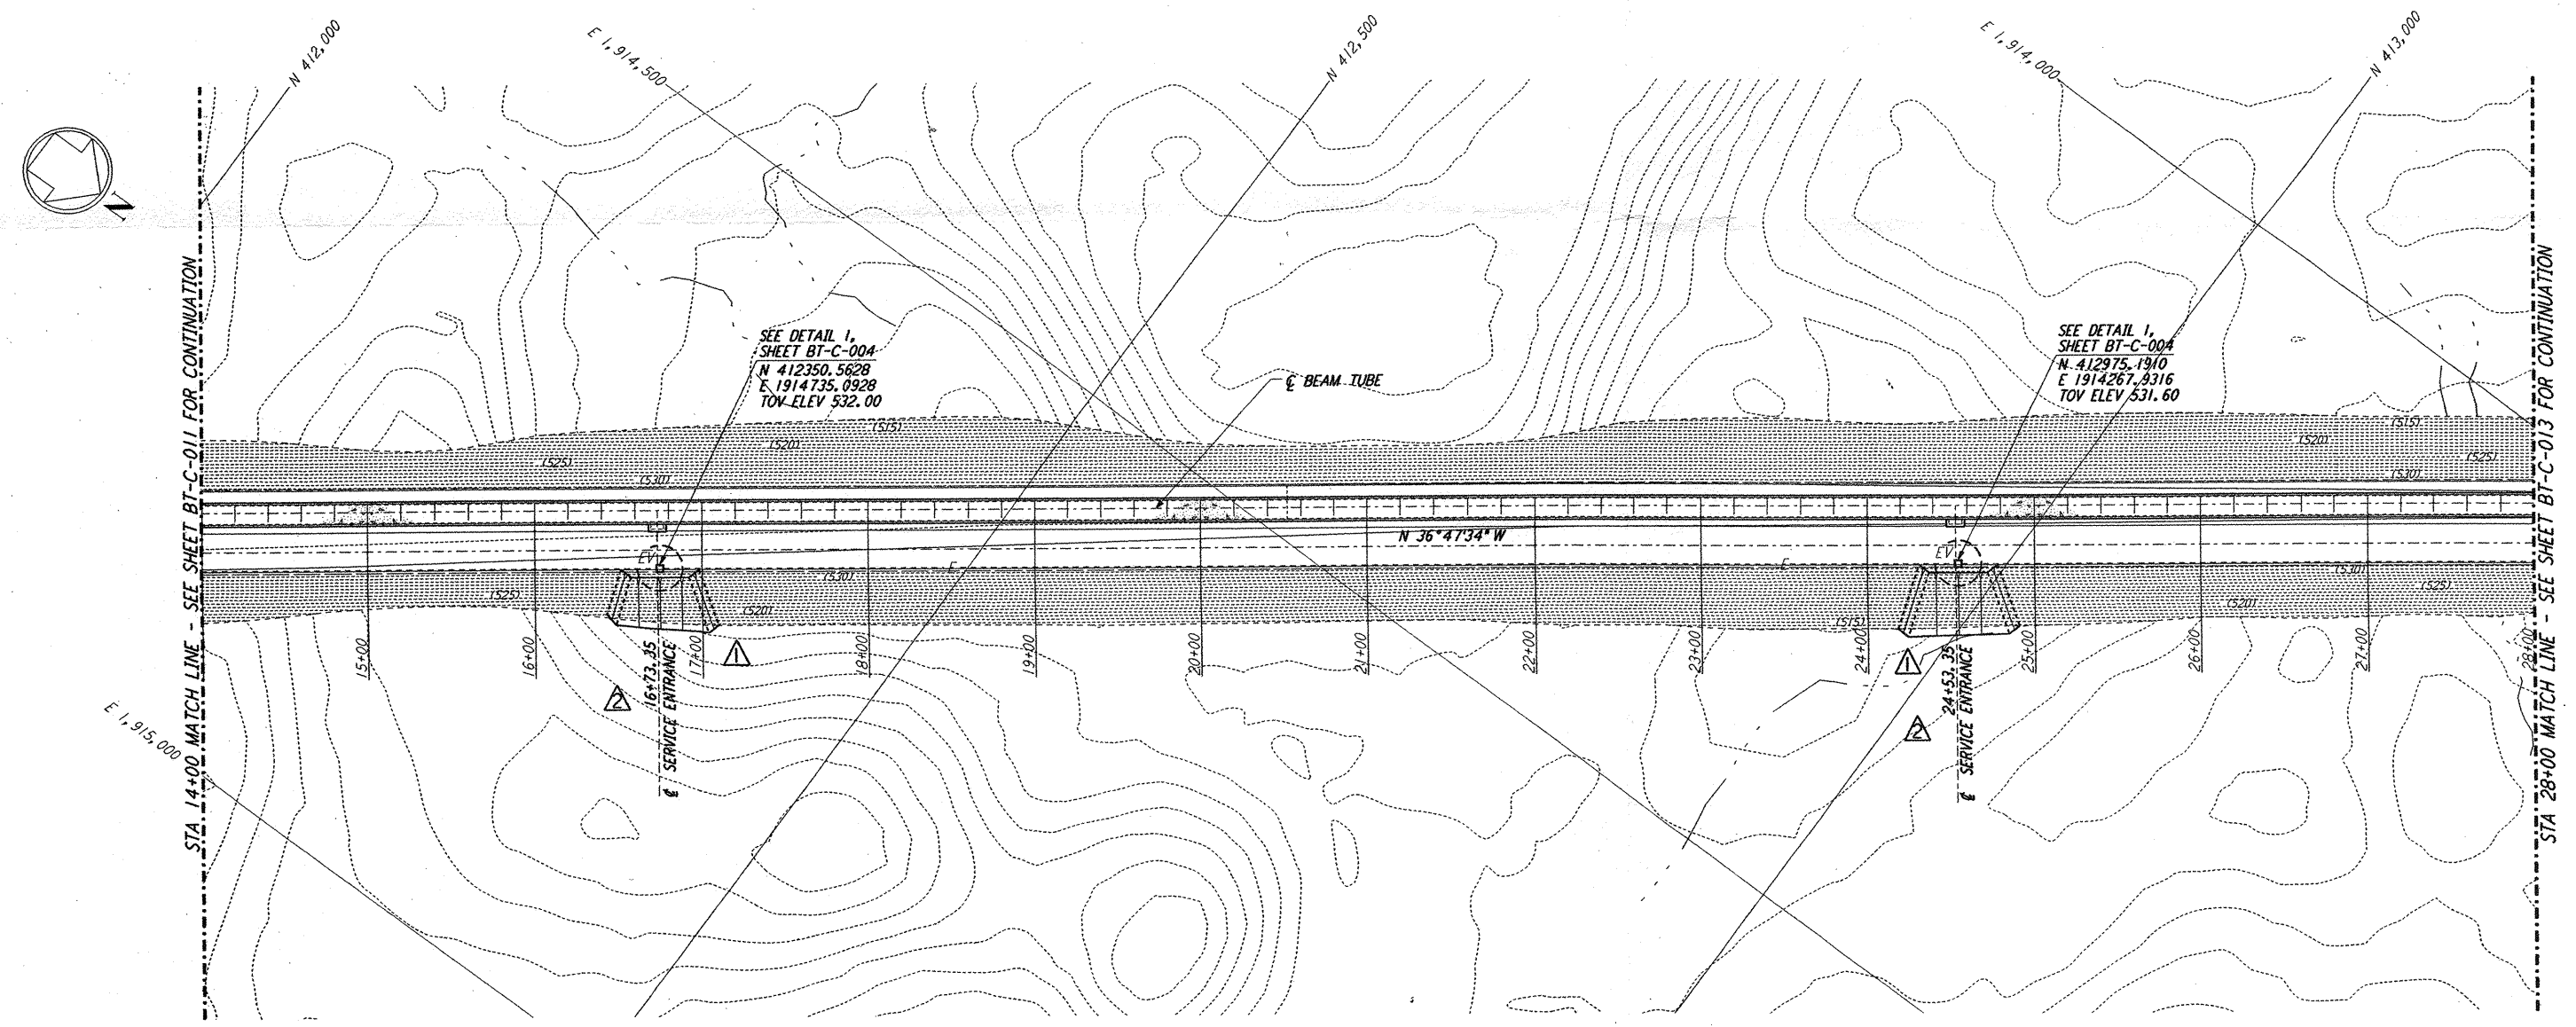

PLAN
 SCALE: 1" = 50'

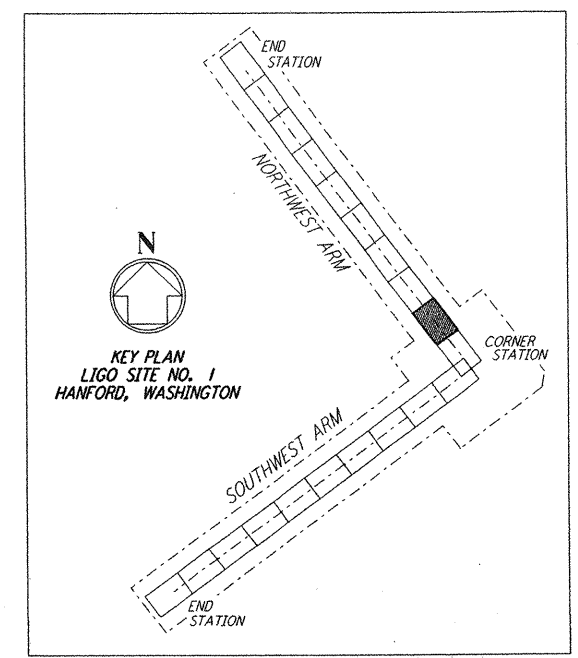

LIGO-D960167-03-0

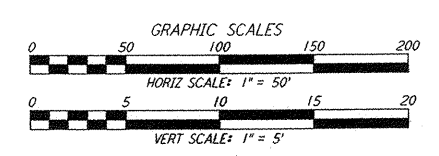

DRAWING NO.	DESCRIPTION

NO.	DATE	BY	CHKD	ENGR	PROJ	DESCRIPTION
3	1-22-99	MET			MDW	ISSUED FOR AS BUILT
2	5-10-96	WRB	TDM	JJB	MDW	REVISED BEAM TUBE SERVICE ENTRANCES
1	2-29-96	WRB	TDM	JJB	MDW	CHANGE ORDER NO. 2

ISSUED FOR CONSTRUCTION	WRB	1-19-96
DRAWN	MP	1-19-96
CHECKED	JJB	1-19-96
ENGINEER	MDW	1-19-96
PROJ		

AS-BUILT DRAWINGS

100 WEST WALNUT STREET
 PASADENA, CALIFORNIA

CALIFORNIA INSTITUTE OF TECHNOLOGY
 MASSACHUSETTS INSTITUTE OF TECHNOLOGY

LASER INTERFEROMETER
 GRAVITATIONAL-WAVE OBSERVATORY
 BTE SITWORK & FABRICATION - HANFORD, WA

TITLE: **CIVIL NORTHWEST ARM PLAN AND PROFILE**
 STA 14+00 TO STA 28+00

SCALE: AS NOTED
 CONTRACT NUMBER: PP150969
 PROJECT NUMBER: 8094

SHEET NUMBER: **BT - C - 012**

Thu Jan 21 13:34:35 1999 G:\PLOT\GWS3\3882\DF 52806 KAV388A\ce012a.prf LIGOBTF3.BDR