
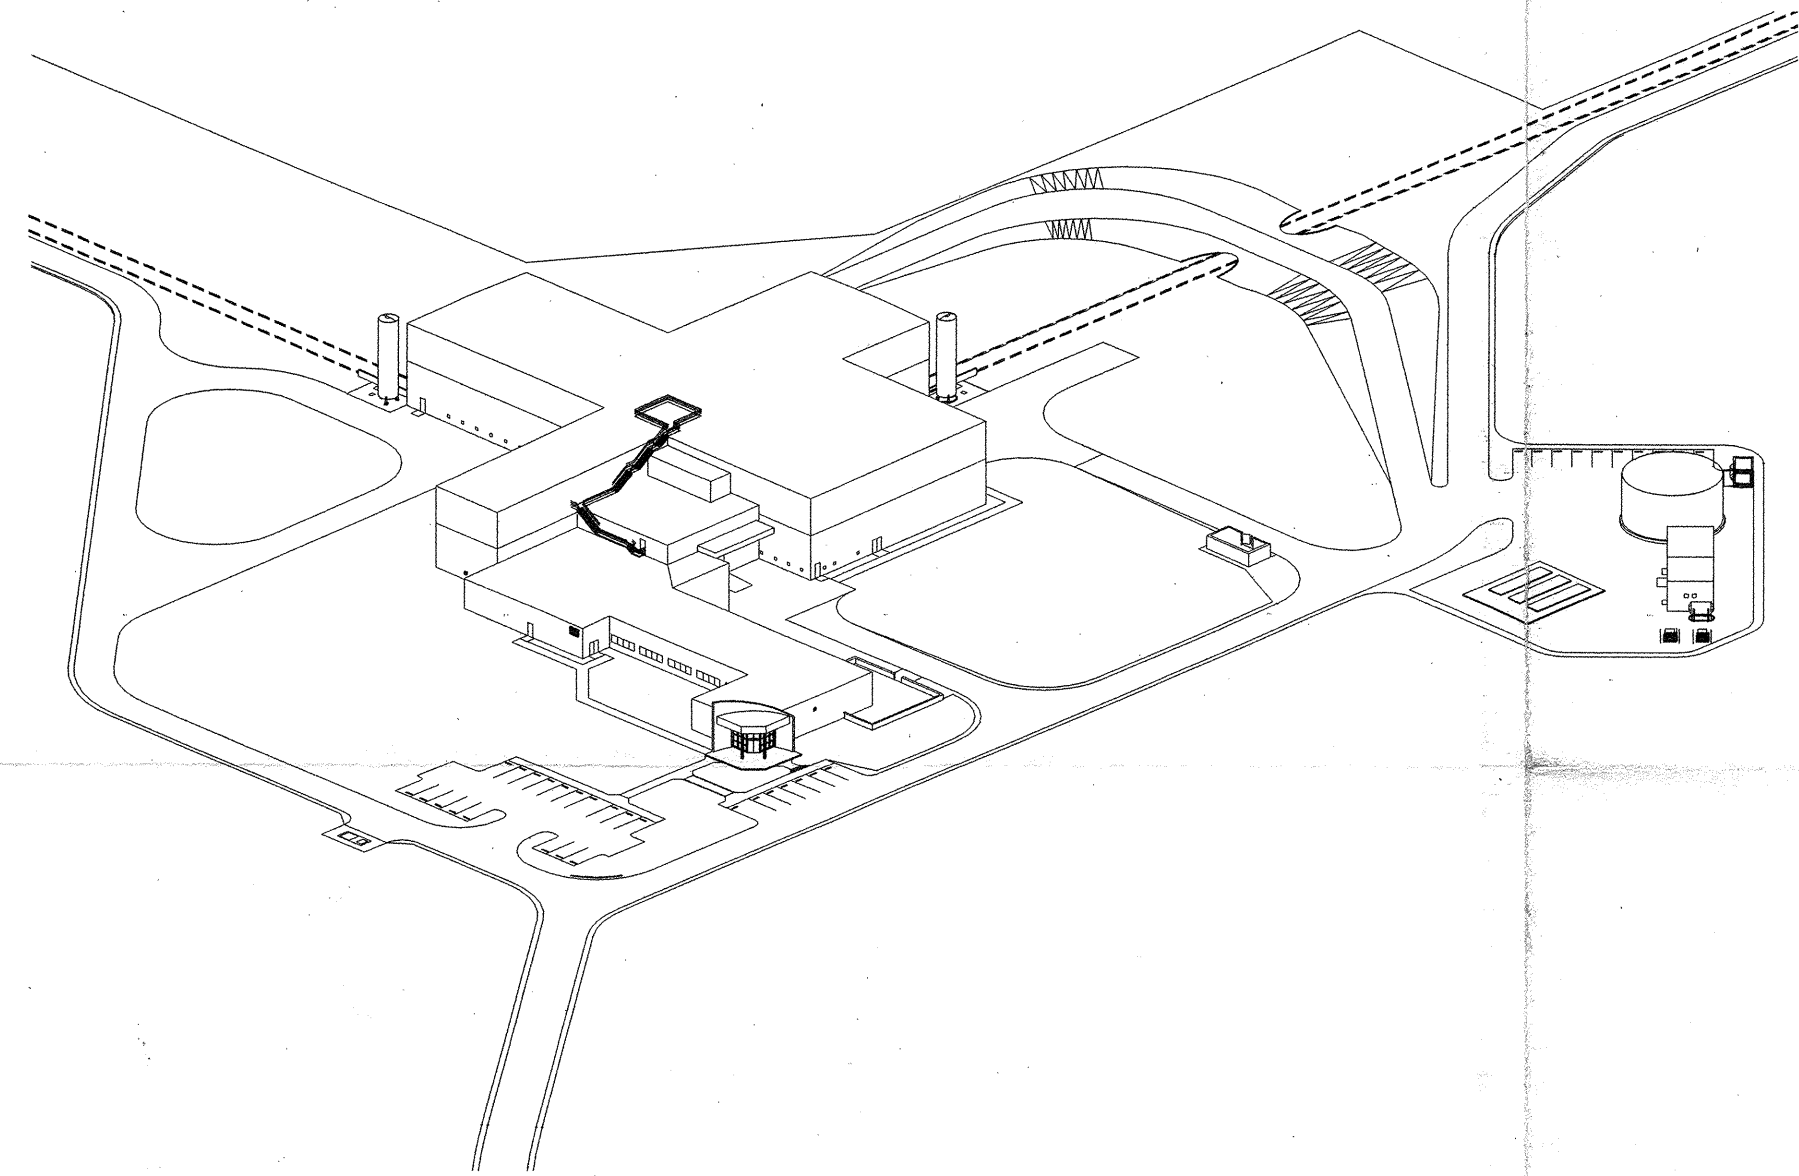


LASER INTERFEROMETER GRAVITATIONAL-WAVE OBSERVATORY

HANFORD FACILITY ISSUED FOR CONSTRUCTION SET BUILDING AND INFRASTRUCTURE CONSTRUCTION

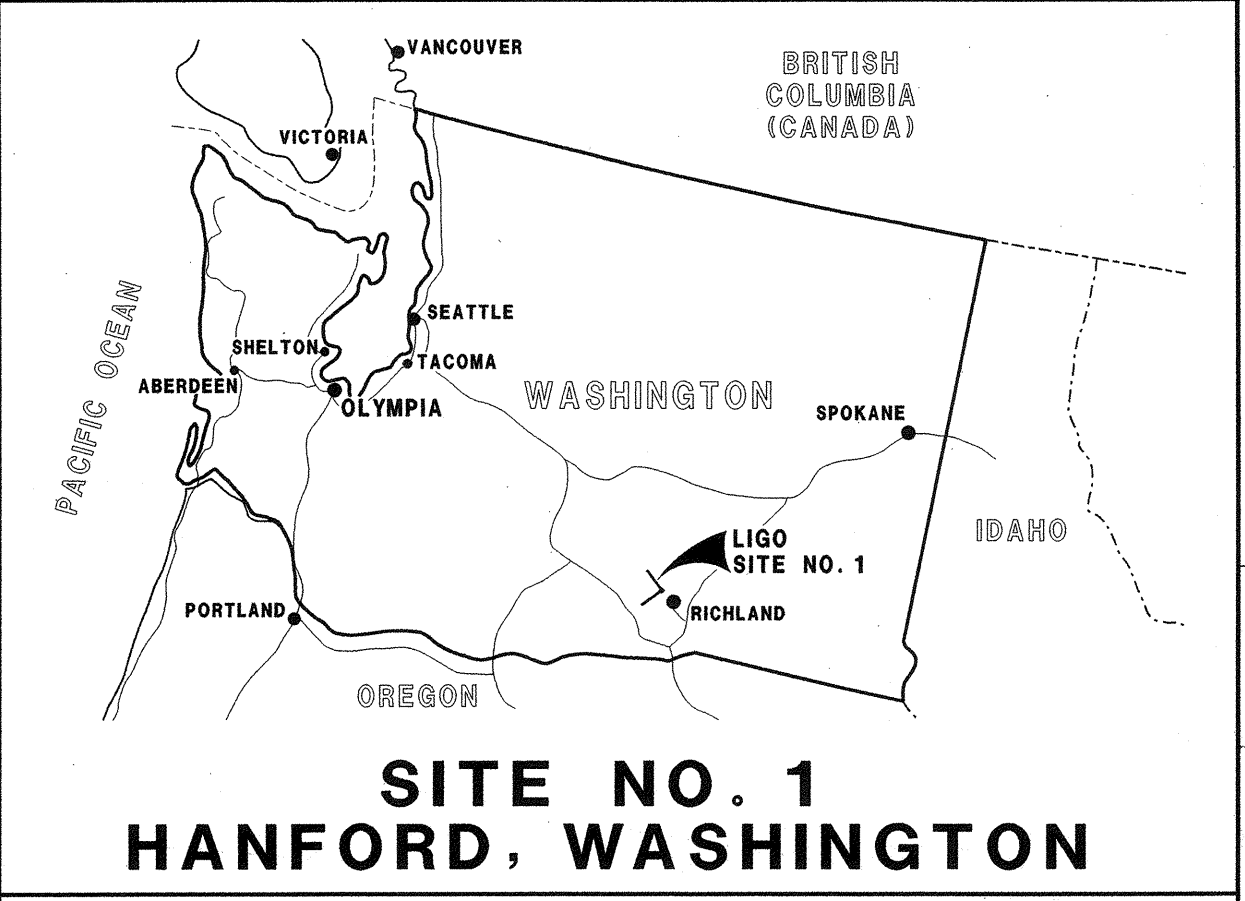

LIGO-D960193-02-O

DRAWING LIST

REV	DATE	SHEET NO.	TITLE
2	7-15-98	WA-G-001	GENERAL COVER & DRAWING INDEX SHEET 1
2	7-15-98	WA-G-002	GENERAL DRAWING INDEX SHEET 2
2	7-15-98	WA-G-003	GENERAL DRAWING INDEX SHEET 3
1	5-15-98	WA-C-001	CIVIL DRAWING INDEX LOCATION & VICINITY MAPS
1	5-15-98	WA-C-002	CIVIL GENERAL NOTES, LEGEND & ABBREVIATIONS
1	5-15-98	WA-C-003	CIVIL DRAWING MATRIX
1	5-15-98	WA-C-004	CIVIL TYPICAL SECTIONS & DETAILS
2	5-15-98	WA-C-006	CIVIL CORNER STATION PLOT PLAN, ENLARGED PLANS

DRAWING LIST

REV	DATE	SHEET NO.	TITLE
2	5-15-98	WA-C-008	CIVIL CORNER STATION GRADING PLAN, ENLARGED PLANS
1	5-15-98	WA-C-011	CIVIL NORTHWEST ARM PLAN AND PROFILE STA 0+00 TO STA 14+00
1	5-15-98	WA-C-012	CIVIL NORTHWEST ARM PLAN AND PROFILE STA 14+00 TO STA 28+00
1	5-15-98	WA-C-013	CIVIL NORTHWEST ARM PLAN AND PROFILE STA 28+00 TO STA 42+00
1	5-15-98	WA-C-014	CIVIL NORTHWEST ARM PLAN AND PROFILE STA 42+00 TO STA 56+00
1	5-15-98	WA-C-015	CIVIL NORTHWEST ARM PLAN AND PROFILE STA 56+00 TO STA 70+00
1	5-15-98	WA-C-016	CIVIL NORTHWEST ARM PLAN AND PROFILE STA 70+00 TO STA 84+00
1	5-15-98	WA-C-017	CIVIL NORTHWEST ARM PLAN AND PROFILE STA 84+00 TO STA 98+00
1	5-15-98	WA-C-018	CIVIL NORTHWEST ARM PLAN AND PROFILE STA 98+00 TO STA 112+00
1	5-15-98	WA-C-019	CIVIL NORTHWEST ARM PLAN AND PROFILE STA 112+00 TO STA 126+00
1	5-15-98	WA-C-020	CIVIL NORTHWEST ARM PLAN AND PROFILE STA 126+00 TO STA 133+00

DRAWING LIST

REV	DATE	SHEET NO.	TITLE
1	5-15-98	WA-C-021	CIVIL NORTHWEST ARM MID-STATION, PLOT PLAN
1	5-15-98	WA-C-022	CIVIL NORTHWEST ARM MID-STATION, GRADING PLAN
1	5-15-98	WA-C-023	CIVIL NORTHWEST ARM MID-STATION, UTILITY PLAN
1	5-15-98	WA-C-025	CIVIL NORTHWEST ARM END-STATION, PLOT PLAN
1	5-15-98	WA-C-026	CIVIL NORTHWEST ARM END-STATION, GRADING PLAN
1	5-15-98	WA-C-027	CIVIL NORTHWEST ARM END-STATION, UTILITY PLAN
1	5-15-98	WA-C-031	CIVIL SOUTHWEST ARM PLAN AND PROFILE STA 0+00 TO STA 14+00
1	5-15-98	WA-C-032	CIVIL SOUTHWEST ARM PLAN AND PROFILE STA 14+00 TO STA 28+00
1	5-15-98	WA-C-033	CIVIL SOUTHWEST ARM PLAN AND PROFILE STA 28+00 TO STA 42+00
1	5-15-98	WA-C-034	CIVIL SOUTHWEST ARM PLAN AND PROFILE STA 42+00 TO STA 56+00
1	5-15-98	WA-C-035	CIVIL SOUTHWEST ARM PLAN AND PROFILE STA 56+00 TO STA 70+00

not be reproduced, copied, loaned, exhibited, or used in any other way, except by written consent from PARSONS to the borrower.

This document and the design it covers are the property of PARSONS. They are loaned only with the borrower's expressed written agreement that they will

REV	DATE	BY	CHKD	ENGR	PROJ	DESCRIPTION
2	07-15-98	MEI	MEI	MEI		ISSUED FOR AS-BUILT
1	04-01-97	MEI	TDM	MEI	TDM	ADDED REV COLUMN & UPDATED INDEX SHEET

AS-BUILT DRAWINGS
 100 WEST WALNUT STREET
 PASADENA, CALIFORNIA

PARSONS
 100 WEST WALNUT STREET
 PASADENA, CALIFORNIA

LIGO
 CALIFORNIA INSTITUTE OF TECHNOLOGY
 MASSACHUSETTS INSTITUTE OF TECHNOLOGY

LASER INTERFEROMETER
 GRAVITATIONAL-WAVE OBSERVATORY
 SITE NO. 1 - HANFORD, WASHINGTON

GENERAL COVER & DRAWING INDEX SHEET 1

SCALE: NONE
 SHEET NUMBER: PPI50969
 PROJECT NUMBER: 8094
WA-G-001