
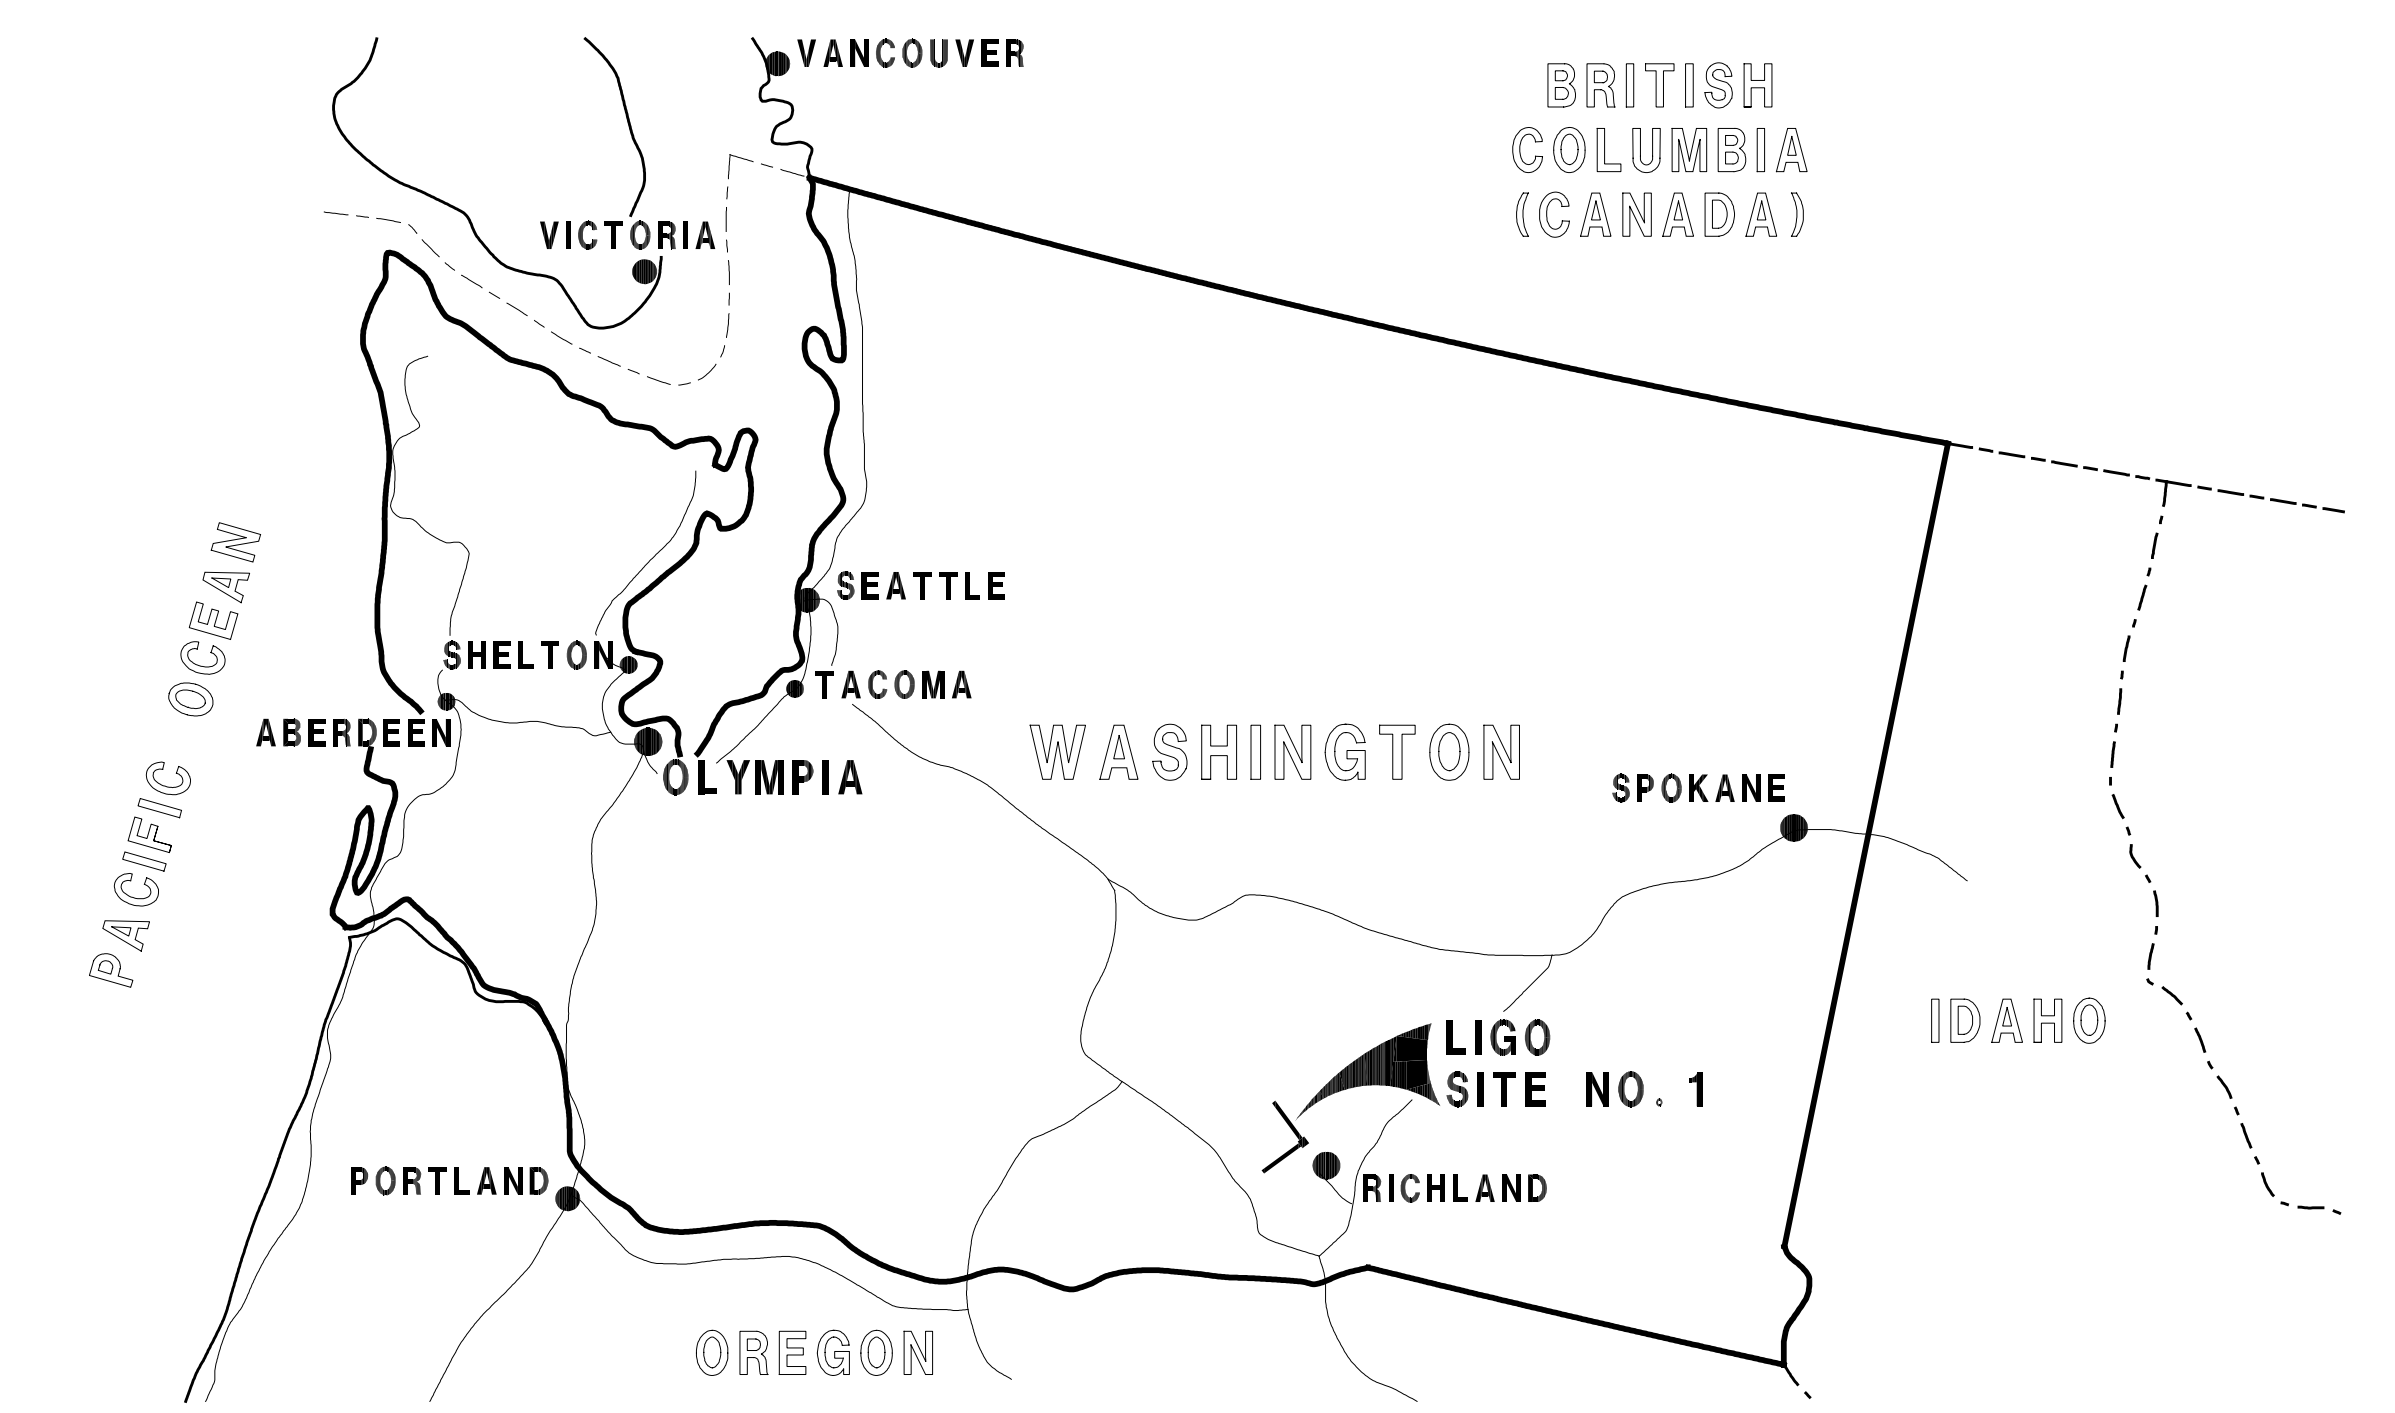


# LASER INTERFEROMETER GRAVITATIONAL-WAVE OBSERVATORY

## HANFORD FACILITY ISSUED FOR CONSTRUCTION SET BUILDING AND INFRASTRUCTURE CONSTRUCTION

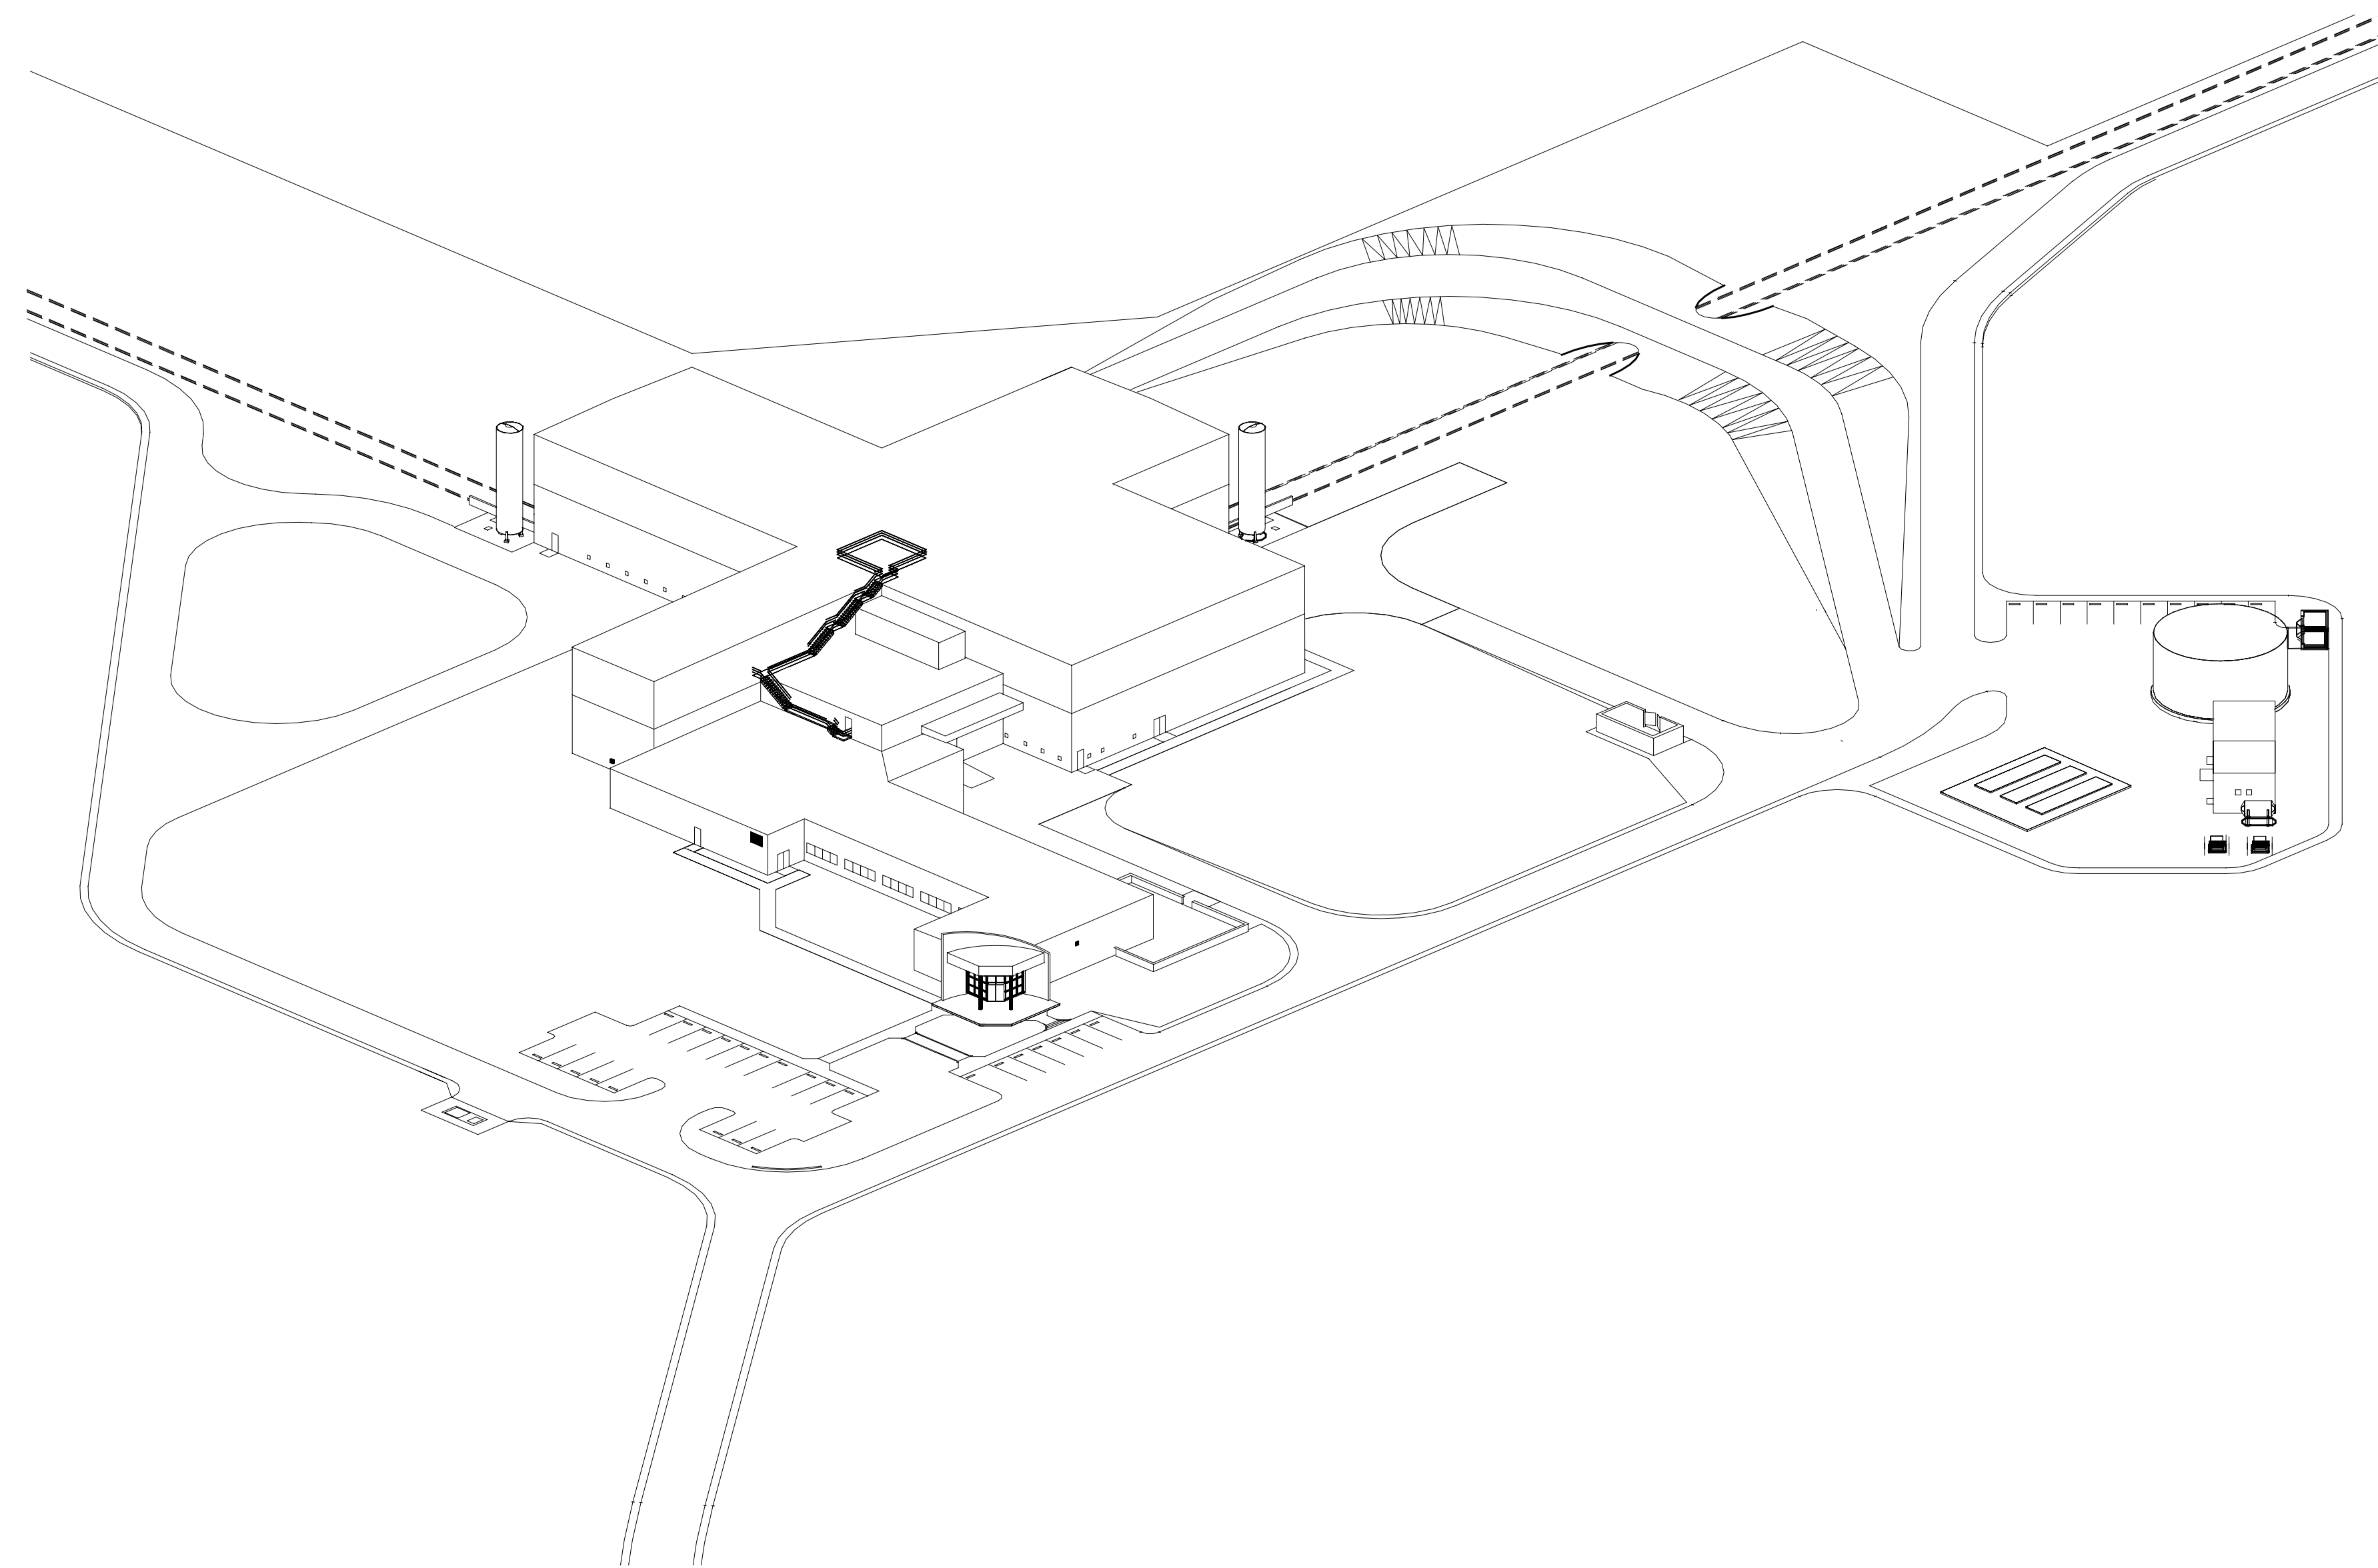

**SITE NO. 1  
 HANFORD, WASHINGTON**

LIGO-D960193-02-0

### DRAWING LIST

REV	DATE	SHEET NO.	TITLE
2	7-15-98	WA-G-001	GENERAL COVER & DRAWING INDEX SHEET 1
2	7-15-98	WA-G-002	GENERAL DRAWING INDEX SHEET 2
2	7-15-98	WA-G-003	GENERAL DRAWING INDEX SHEET 3
1	5-15-98	WA-C-001	CIVIL DRAWING INDEX LOCATION & VICINITY MAPS
1	5-15-98	WA-C-002	CIVIL GENERAL NOTES, LEGEND & ABBREVIATIONS
1	5-15-98	WA-C-003	CIVIL DRAWING MATRIX
1	5-15-98	WA-C-004	CIVIL TYPICAL SECTIONS & DETAILS
2	5-15-98	WA-C-006	CIVIL CORNER STATION PLOT PLAN, ENLARGED PLANS

### DRAWING LIST

REV	DATE	SHEET NO.	TITLE
2	5-15-98	WA-C-008	CIVIL CORNER STATION GRADING PLAN, ENLARGED PLANS
1	5-15-98	WA-C-011	CIVIL NORTHWEST ARM PLAN AND PROFILE STA 0+00 TO STA 14+00
1	5-15-98	WA-C-012	CIVIL NORTHWEST ARM PLAN AND PROFILE STA 14+00 TO STA 28+00
1	5-15-98	WA-C-013	CIVIL NORTHWEST ARM PLAN AND PROFILE STA 28+00 TO STA 42+00
1	5-15-98	WA-C-014	CIVIL NORTHWEST ARM PLAN AND PROFILE STA 42+00 TO STA 56+00
1	5-15-98	WA-C-015	CIVIL NORTHWEST ARM PLAN AND PROFILE STA 56+00 TO STA 70+00
1	5-15-98	WA-C-016	CIVIL NORTHWEST ARM PLAN AND PROFILE STA 70+00 TO STA 84+00
1	5-15-98	WA-C-017	CIVIL NORTHWEST ARM PLAN AND PROFILE STA 84+00 TO STA 98+00
1	5-15-98	WA-C-018	CIVIL NORTHWEST ARM PLAN AND PROFILE STA 98+00 TO STA 112+00
1	5-15-98	WA-C-019	CIVIL NORTHWEST ARM PLAN AND PROFILE STA 112+00 TO STA 126+00
1	5-15-98	WA-C-020	CIVIL NORTHWEST ARM PLAN AND PROFILE STA 126+00 TO STA 133+00

### DRAWING LIST

REV	DATE	SHEET NO.	TITLE
1	5-15-98	WA-C-021	CIVIL NORTHWEST ARM MID-STATION, PLOT PLAN
1	5-15-98	WA-C-022	CIVIL NORTHWEST ARM MID-STATION, GRADING PLAN
1	5-15-98	WA-C-023	CIVIL NORTHWEST ARM MID-STATION, UTILITY PLAN
1	5-15-98	WA-C-025	CIVIL NORTHWEST ARM END-STATION, PLOT PLAN
1	5-15-98	WA-C-026	CIVIL NORTHWEST ARM END-STATION, GRADING PLAN
1	5-15-98	WA-C-027	CIVIL NORTHWEST ARM END-STATION, UTILITY PLAN
1	5-15-98	WA-C-031	CIVIL SOUTHWEST ARM PLAN AND PROFILE STA 0+00 TO STA 14+00
1	5-15-98	WA-C-032	CIVIL SOUTHWEST ARM PLAN AND PROFILE STA 14+00 TO STA 28+00
1	5-15-98	WA-C-033	CIVIL SOUTHWEST ARM PLAN AND PROFILE STA 28+00 TO STA 42+00
1	5-15-98	WA-C-034	CIVIL SOUTHWEST ARM PLAN AND PROFILE STA 42+00 TO STA 56+00
1	5-15-98	WA-C-035	CIVIL SOUTHWEST ARM PLAN AND PROFILE STA 56+00 TO STA 70+00

REV	DATE	BY	CHKD	ENGR	PROJ	DESCRIPTION
2	07-15-98	MEI	MEI	MEI		ISSUED FOR AS-BUILT
1	04-01-97	MEI	TDM	MEI	TDM	ADDED REV COLUMN & UPDATED INDEX SHEET

**AS-BUILT  
 DRAWINGS**

**PARSONS**  
 100 WEST WALNUT STREET  
 PASADENA, CALIFORNIA

**LIGO**  
 CALIFORNIA INSTITUTE OF TECHNOLOGY  
 MASSACHUSETTS INSTITUTE OF TECHNOLOGY

LASER INTERFEROMETER  
 GRAVITATIONAL-WAVE OBSERVATORY  
**SITE NO. 1 - HANFORD, WASHINGTON**

GENERAL COVER & DRAWING INDEX SHEET 1	NONE	PPI50969	8094
<b>WA - G - 001</b>			

This document and the design it covers are the property of **PARSONS**. They are loaned only with the borrower's expressed written agreement that they will not be reproduced, copied, loaned, exhibited, or used in any other way, except by written consent from **PARSONS** to the borrower.