




This document and the design it covers are the property of PARSONS. They are loaned only with the borrower's expressed written agreement that they will not be reproduced, copied, loaned, exhibited, or used in any other way, except by written consent from PARSONS to the borrower.

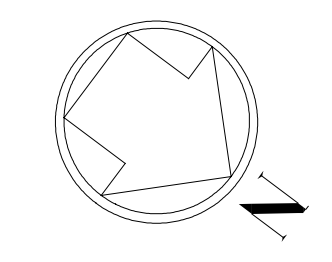



**NOTES:**  
 1. SEE SHEET WA-C-002 FOR GENERAL NOTES, LEGEND AND ABBREVIATIONS.

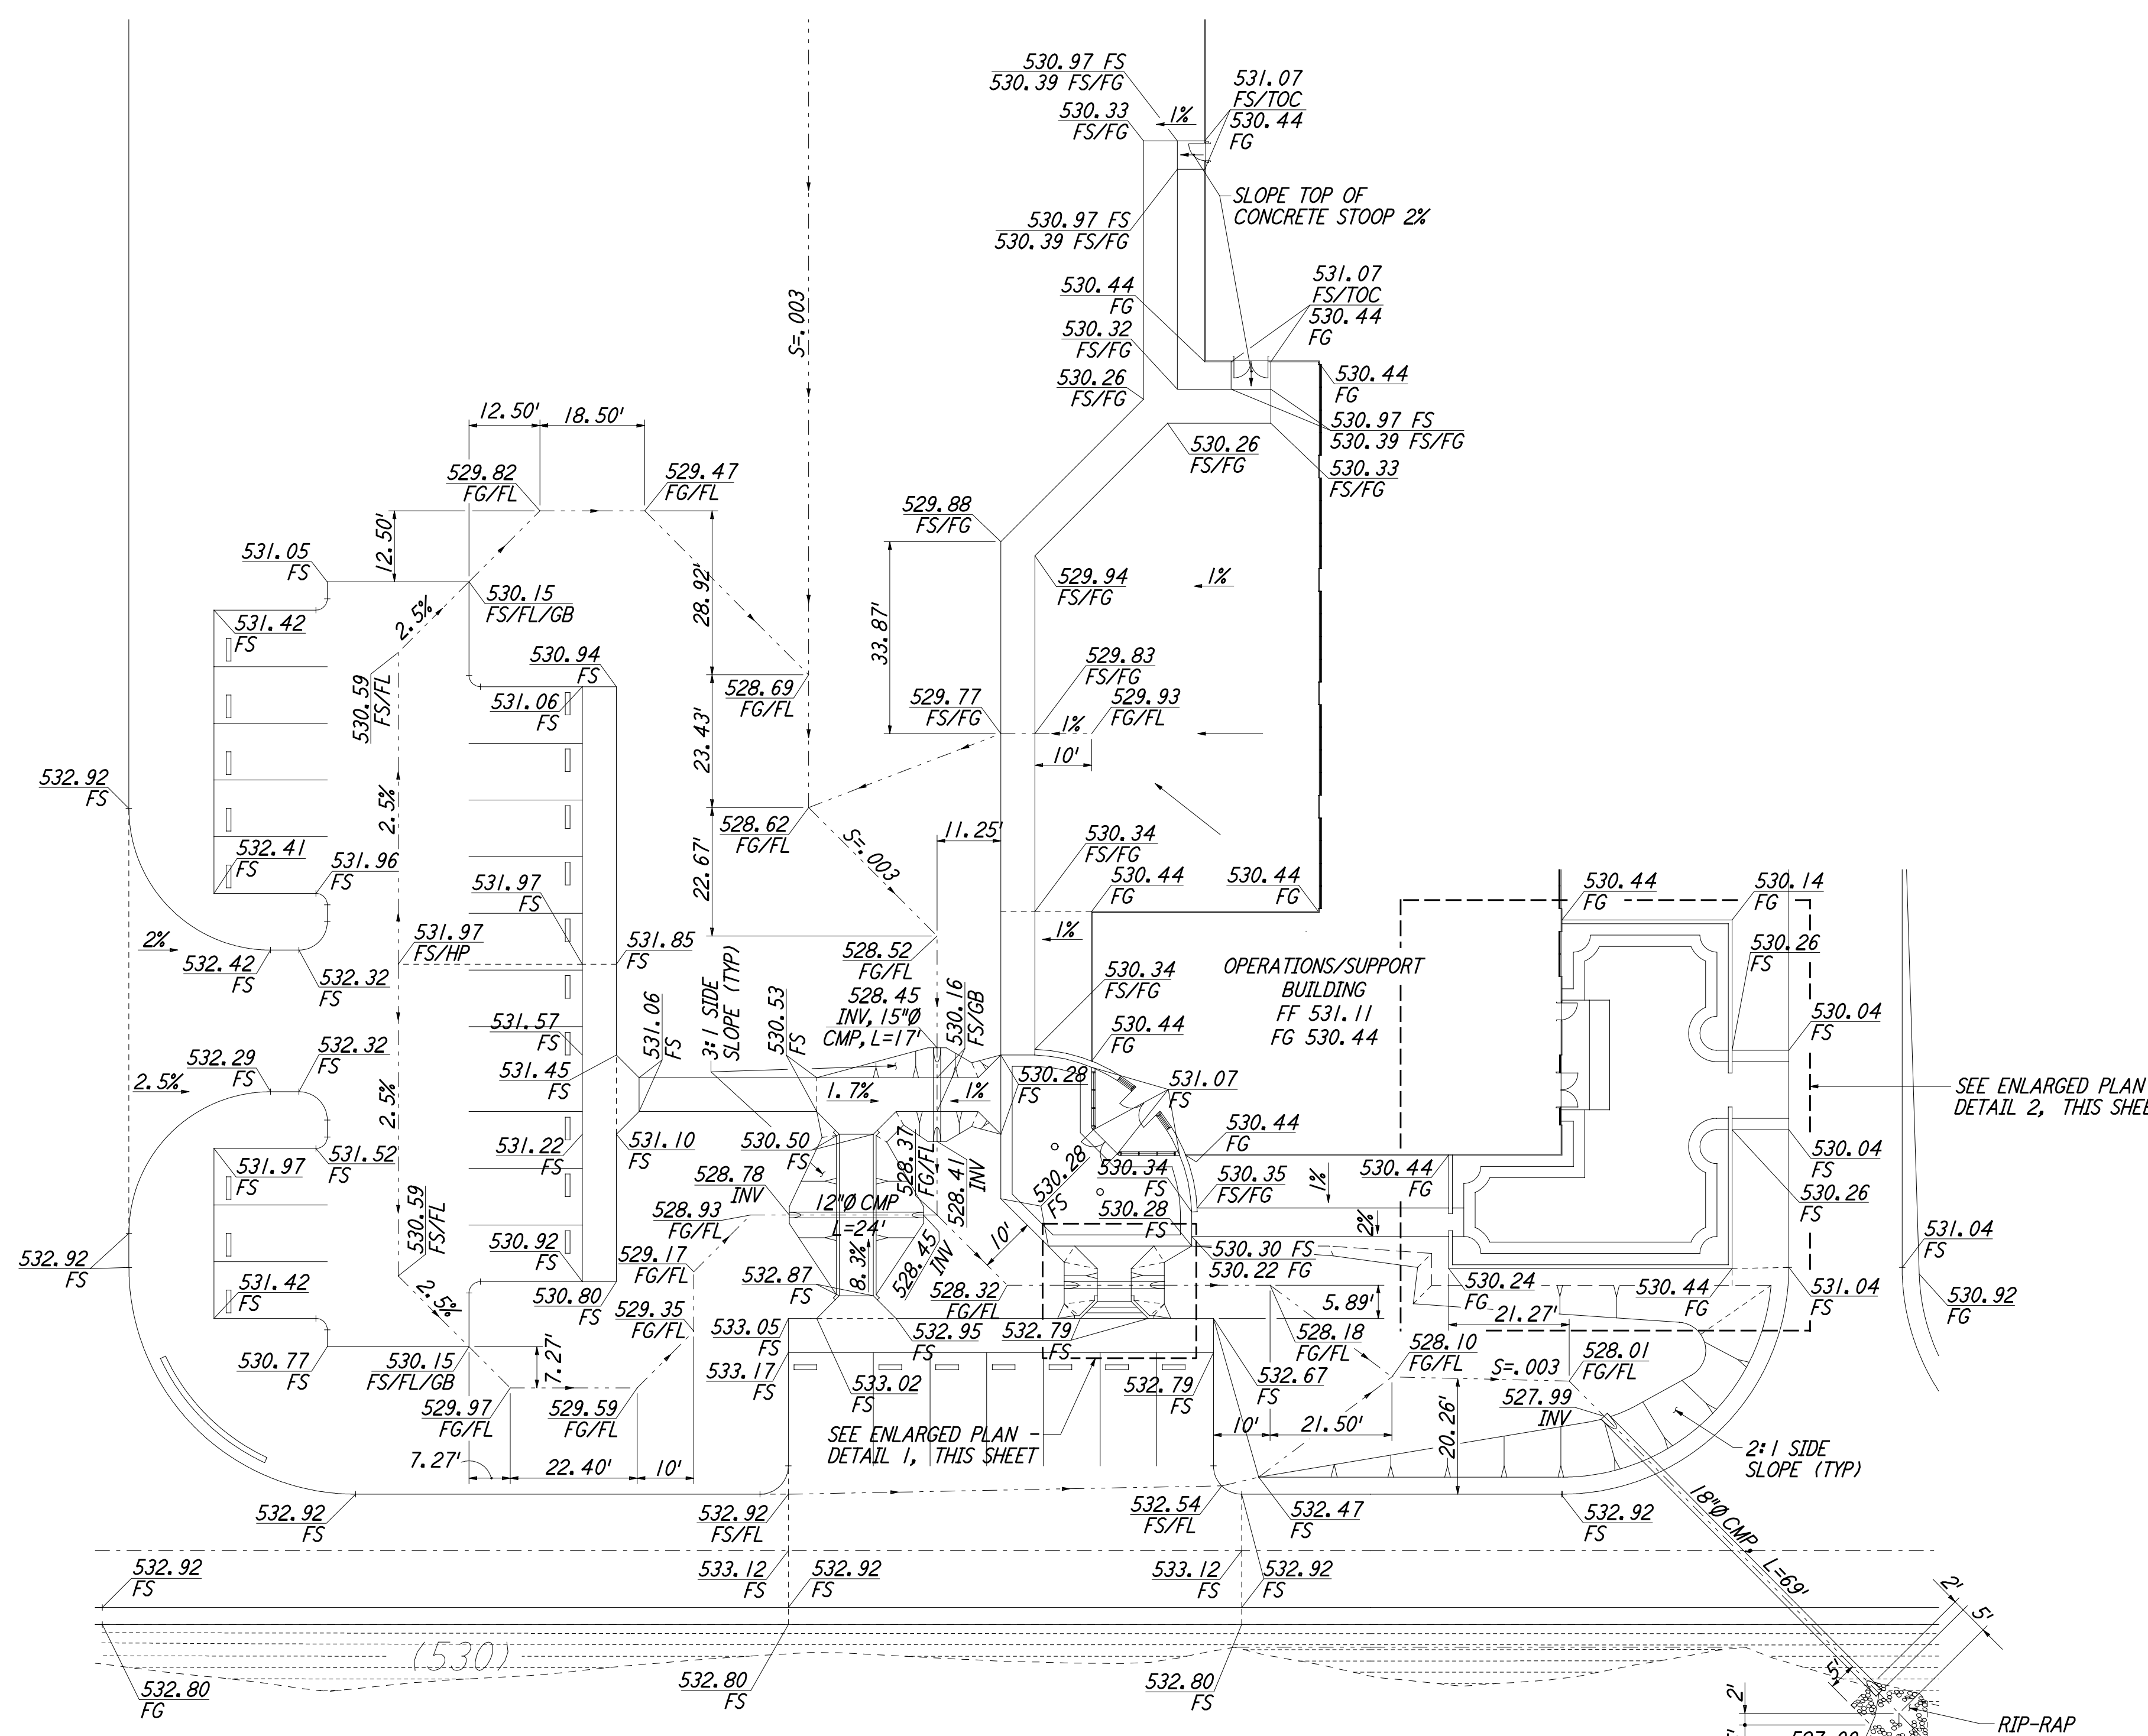


**ENLARGED AREA - BUILDING ENTRANCE**  
 SCALE: 1" = 20'

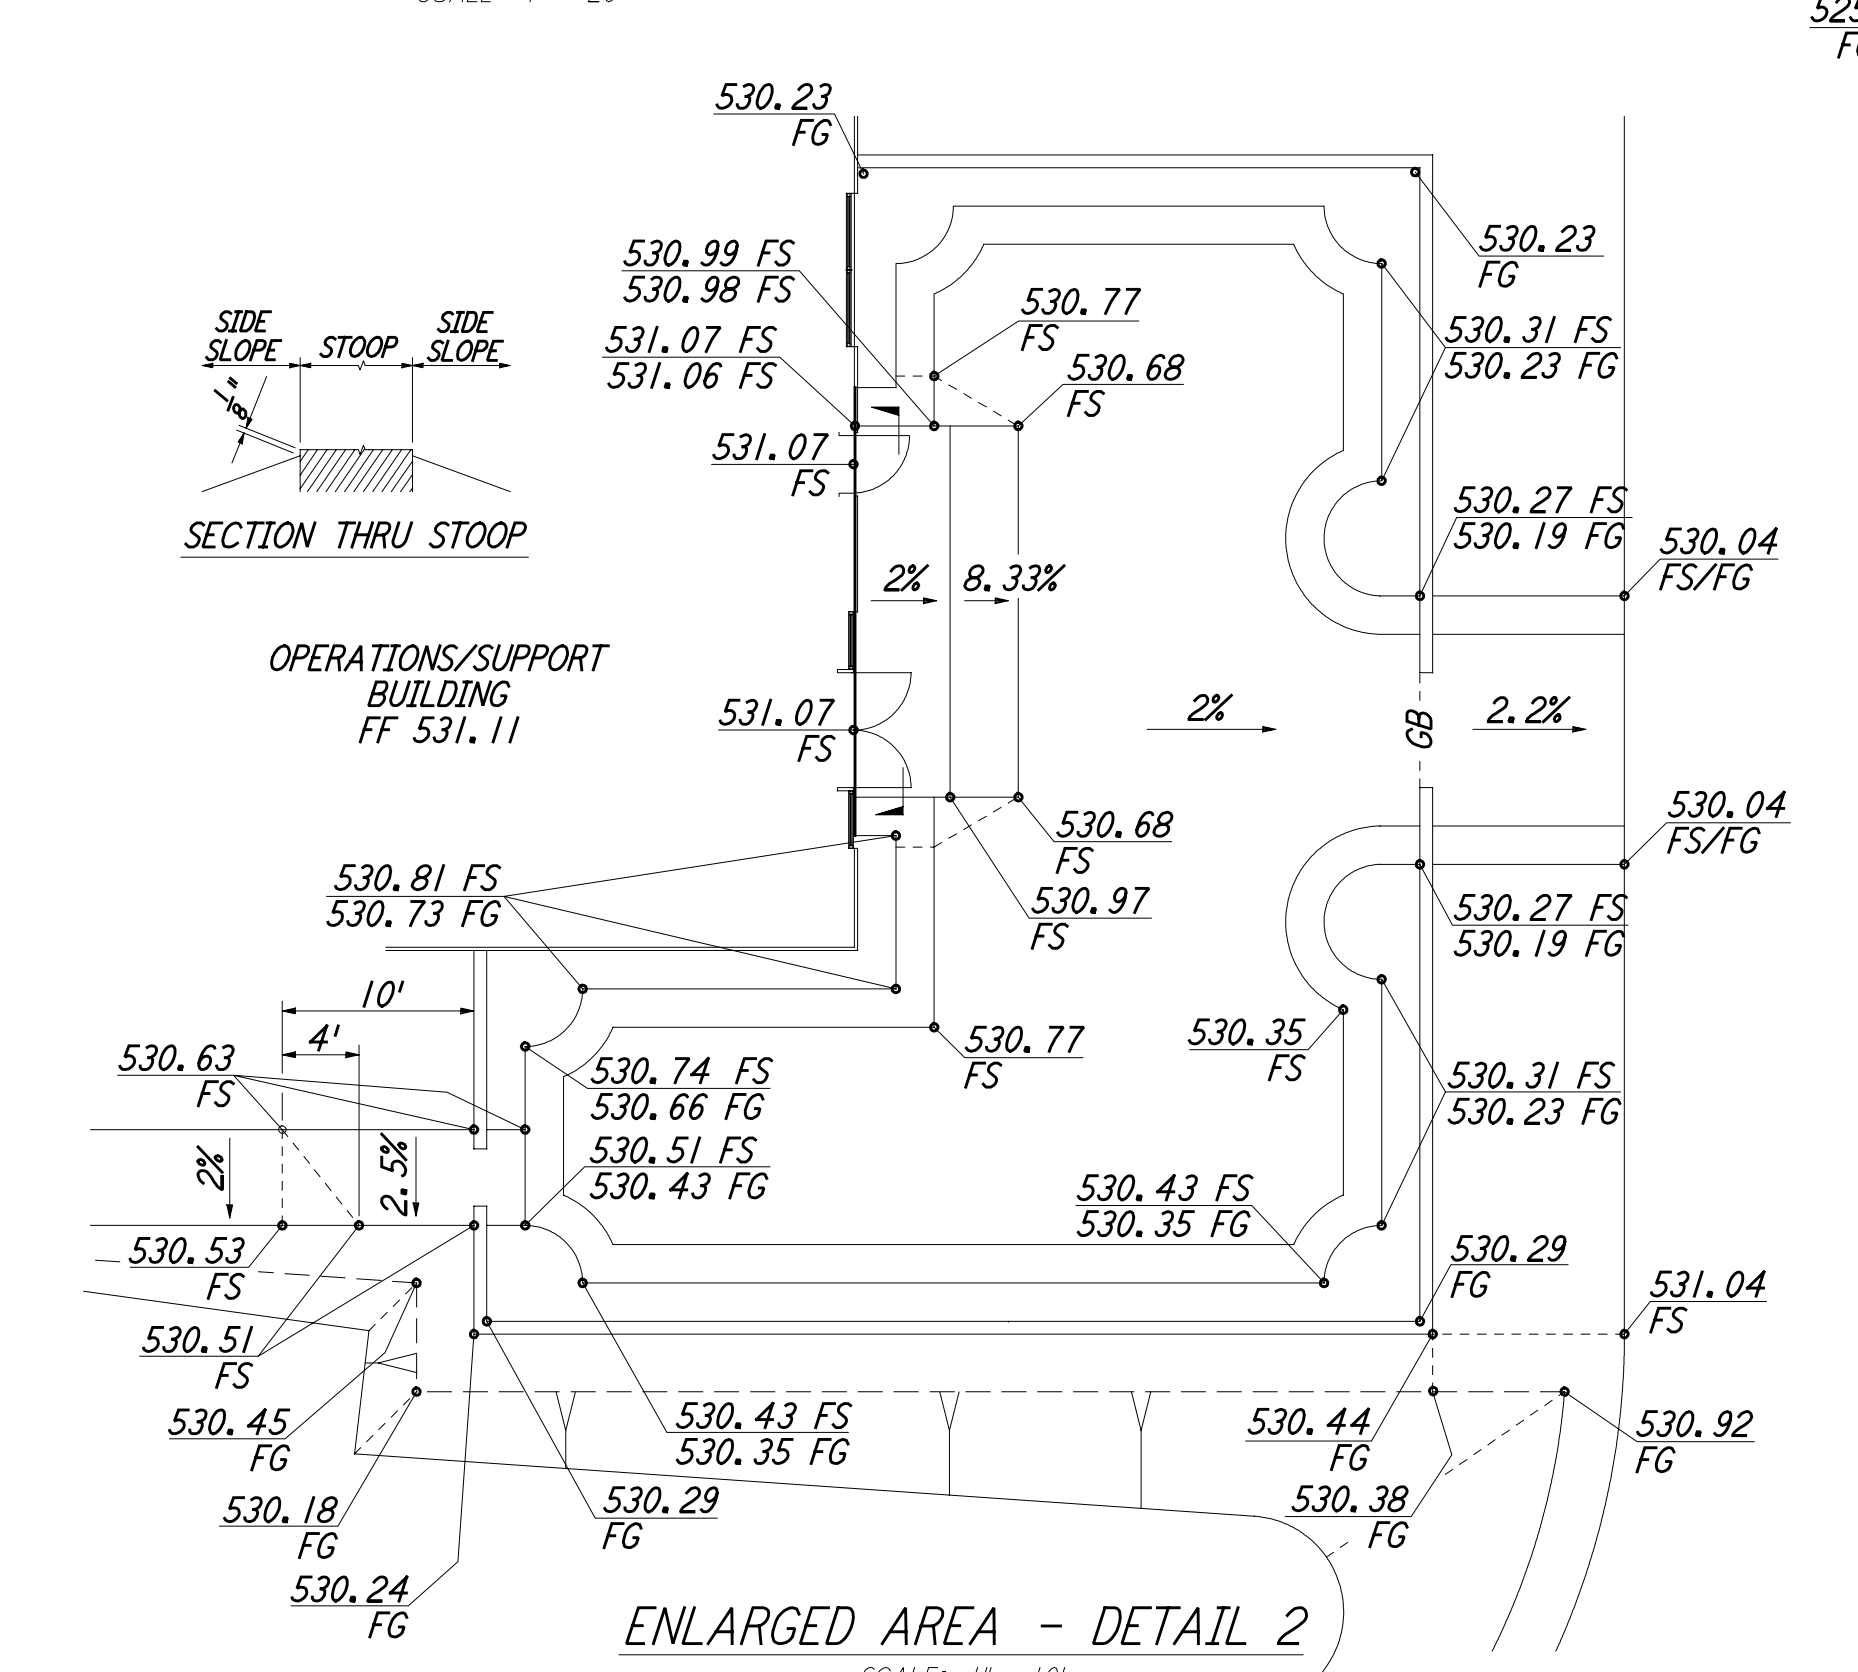


**ENLARGED AREA - DETAIL 1**  
 SCALE: 1" = 5'

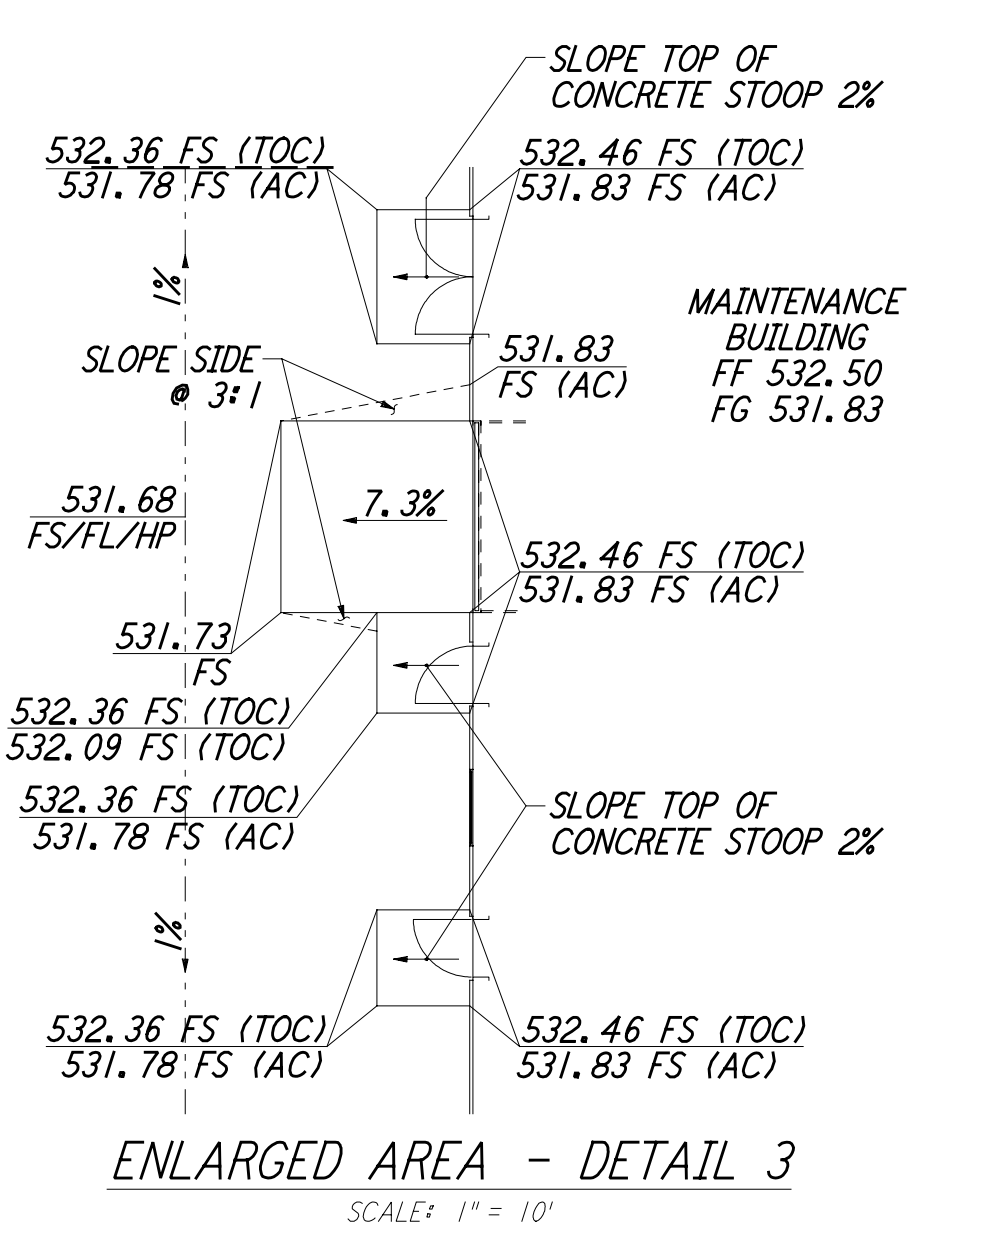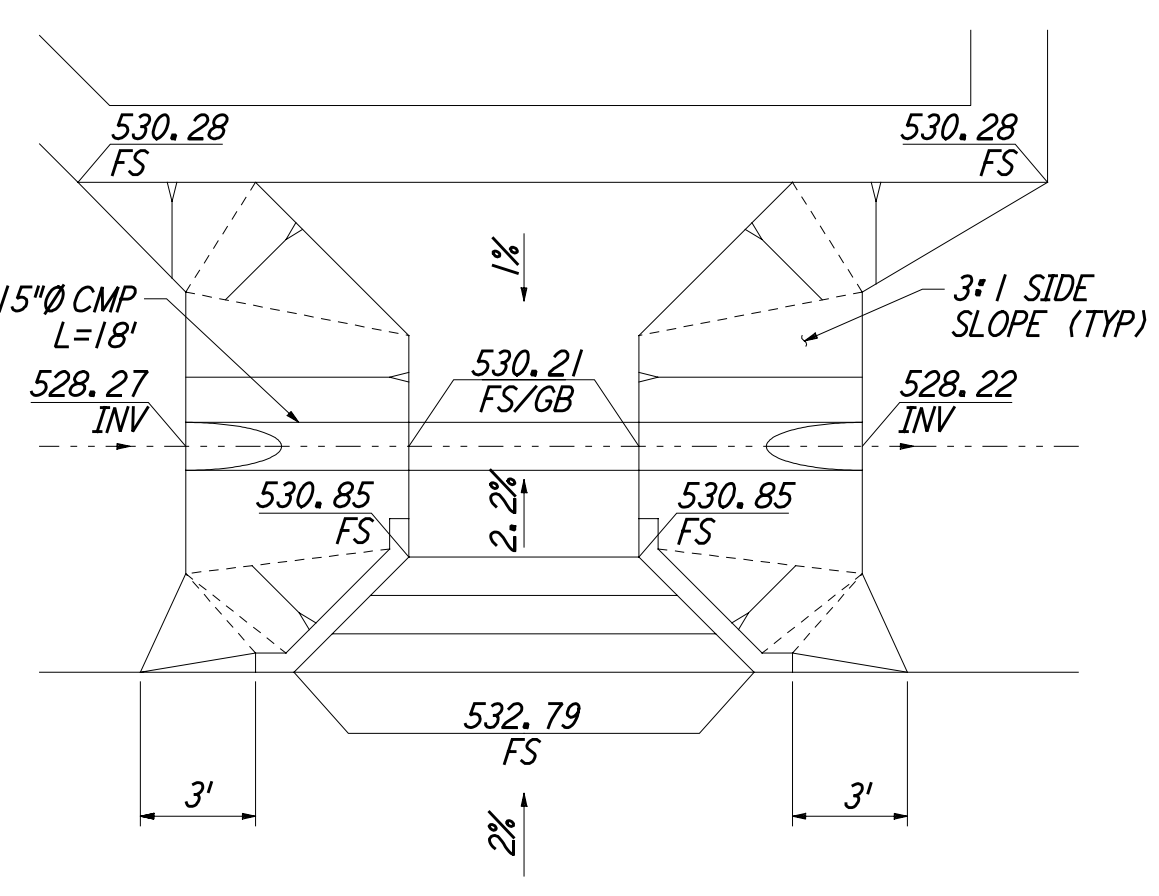

**ENLARGED AREA - DETAIL 3**  
 SCALE: 1" = 10'

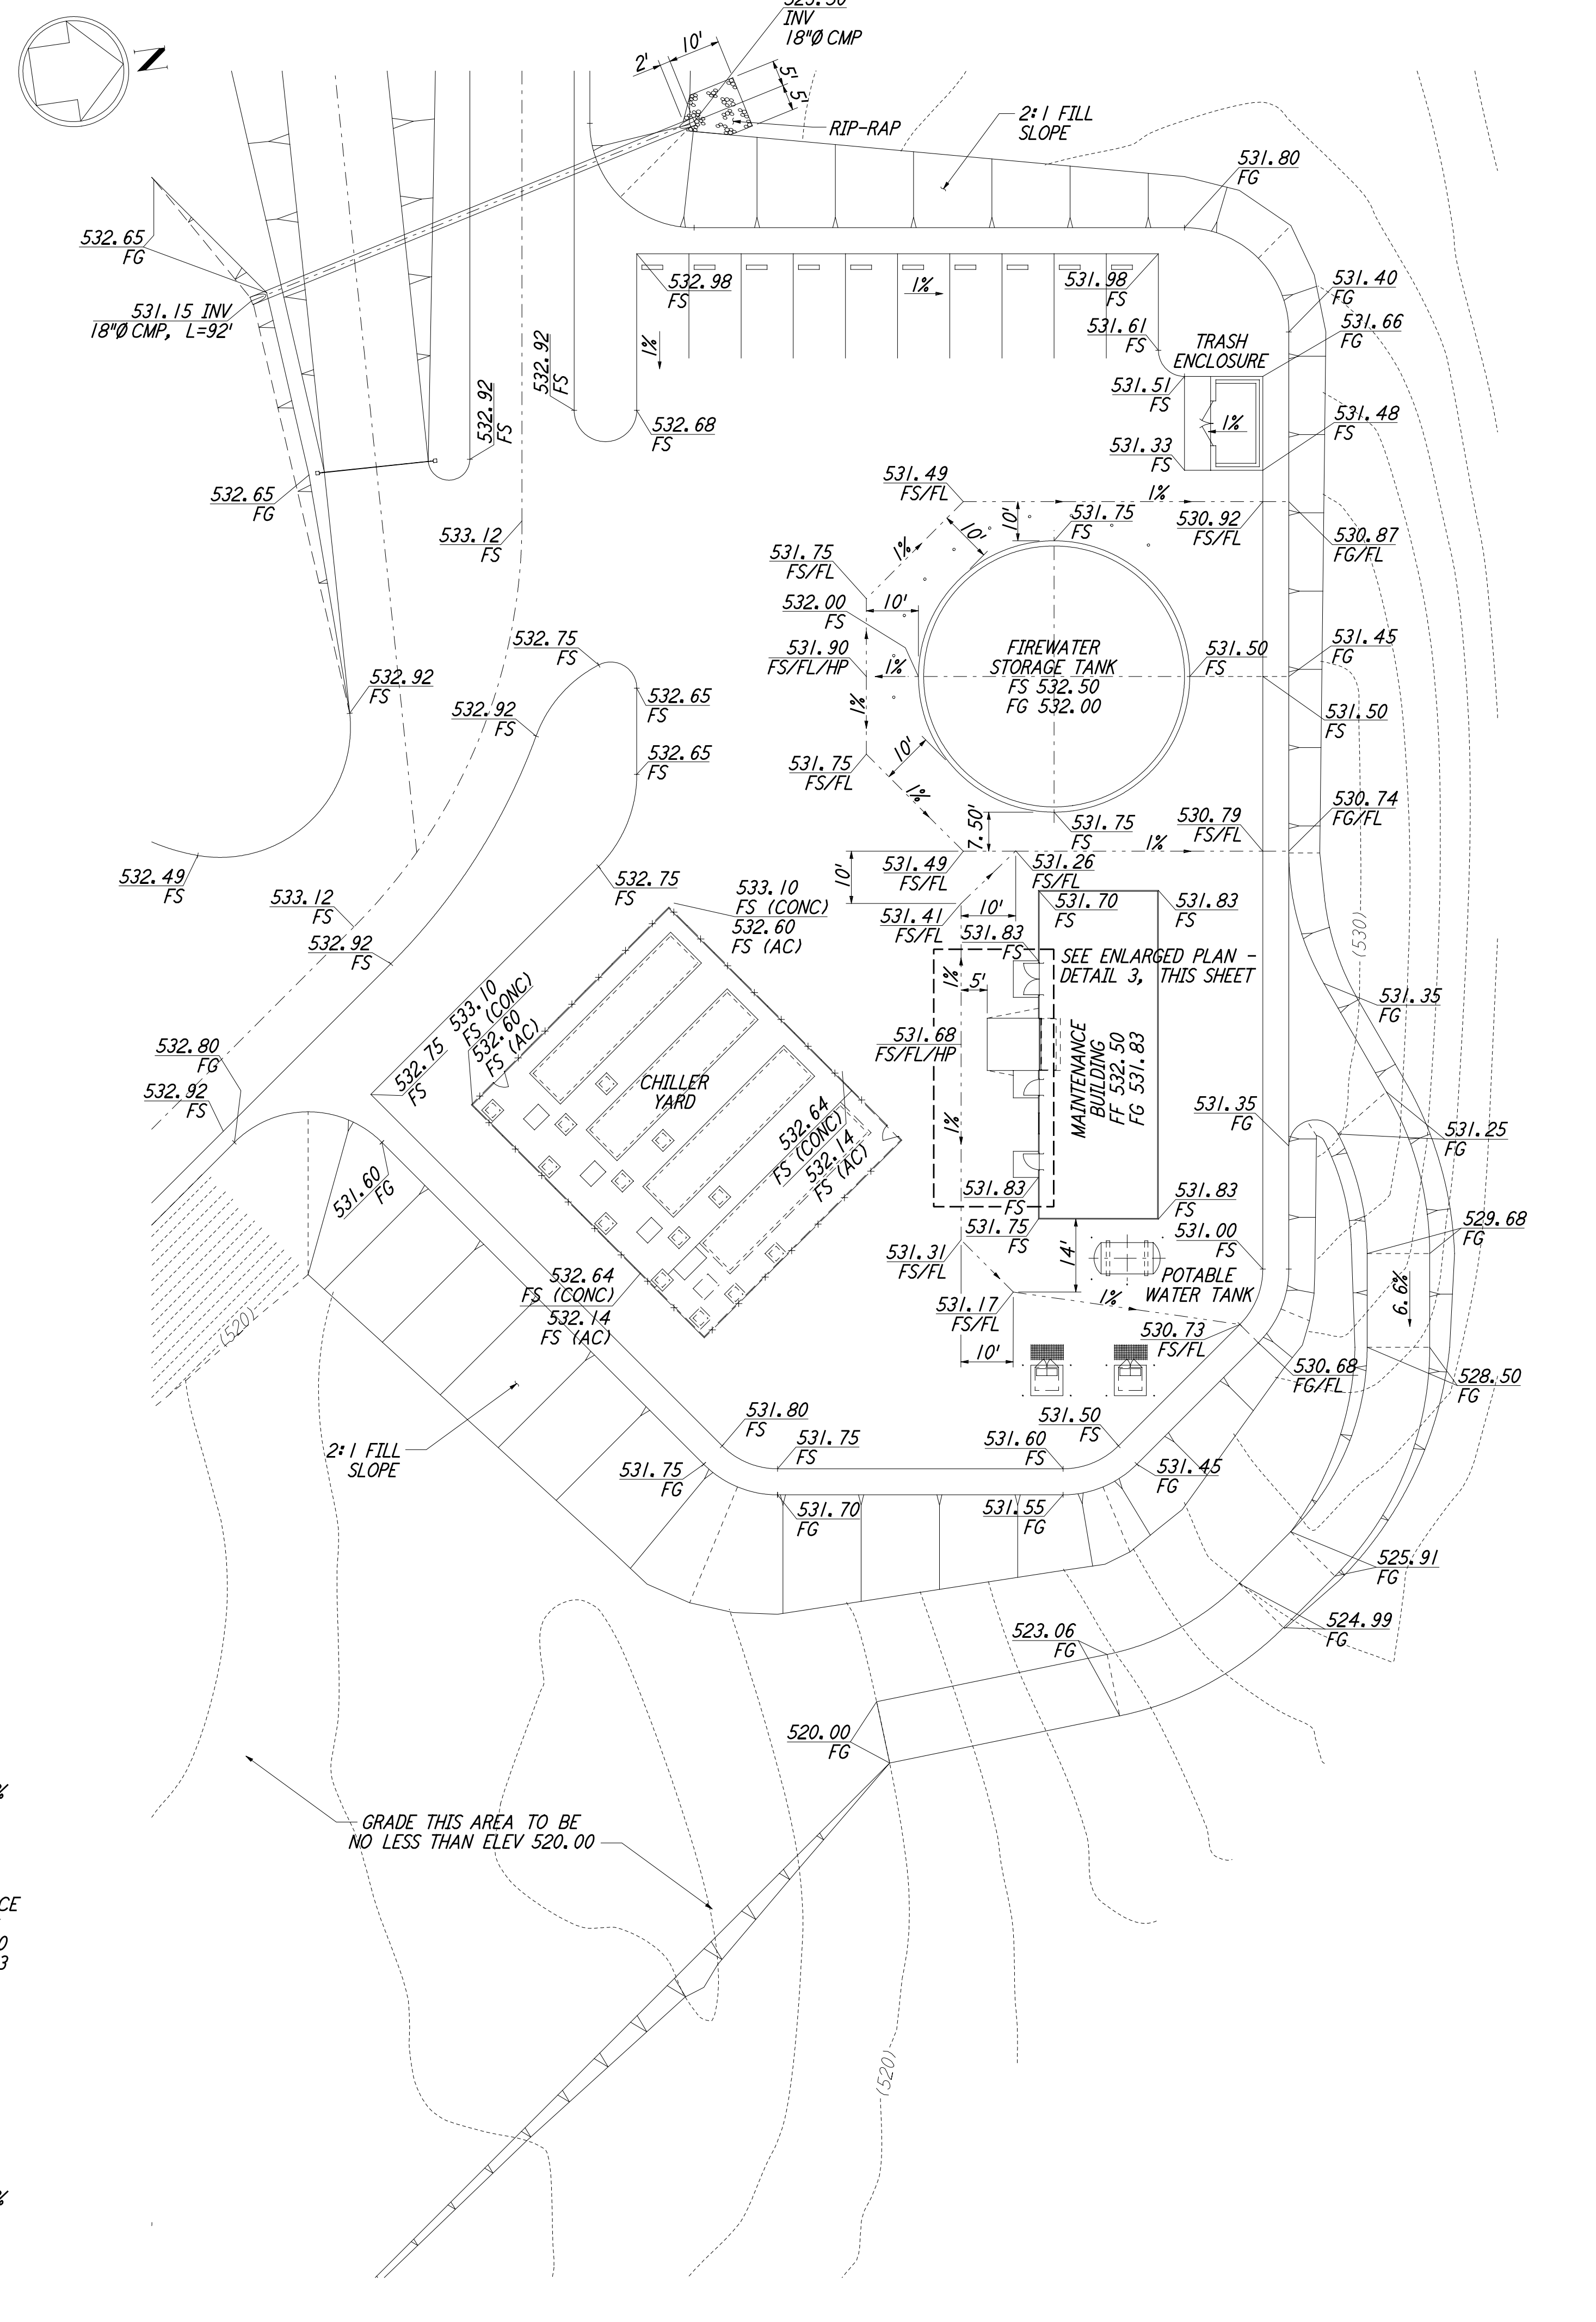

**ENLARGED AREA - MAINTENANCE YARD**  
 SCALE: 1" = 20'

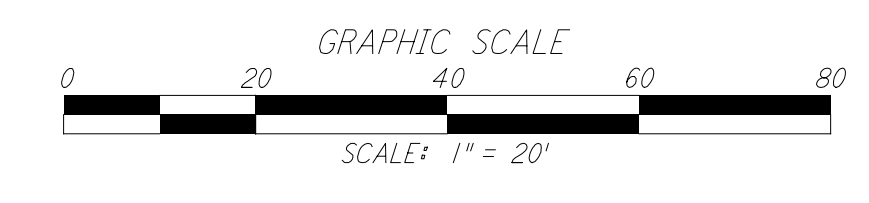

LIGO-D960201-02-0

NO.	DATE	BY	CHKD	ENGR	PROJ	DESCRIPTION
1	2-28-97	WRB	ML	JB	MDW	ISSUED FOR AS-BUILT
2	5/15/98	WRB	ML	JB	MDW	ADDED WALK/WALL OPENING, REVISED GRADING

NO.	DATE	BY	CHKD	ENGR	PROJ	DESCRIPTION
1	2-28-97	WRB	ML	JB	MDW	ISSUED FOR AS-BUILT
2	5/15/98	WRB	ML	JB	MDW	ADDED WALK/WALL OPENING, REVISED GRADING

FOR CONSTRUCTION  
 DRAWN WRB 9/28/95  
 CHECKED ML 7/9/96  
 ENGINEER JB 7/9/96  
 PROJ MDW 7/9/96

**AS-BUILT DRAWINGS**

100 WEST WALNUT STREET  
 PASADENA, CALIFORNIA

CALIFORNIA INSTITUTE OF TECHNOLOGY  
 MASSACHUSETTS INSTITUTE OF TECHNOLOGY

LASER INTERFEROMETER  
 GRAVITATIONAL-WAVE OBSERVATORY  
 SITE NO. 1 - HANFORD, WASHINGTON

TITLE	CIVIL CORNER STATION GRADING PLAN ENLARGED PLANS	SCALE	AS NOTED	DESIGN NUMBER	PP150969	PROJECT NUMBER	8094
SHEET NUMBER	WA-C-008	REVISIONS					