



**NOTES:**  
 1. SEE SHEET WA-C-002 FOR GENERAL NOTES, LEGEND AND ABBREVIATIONS.


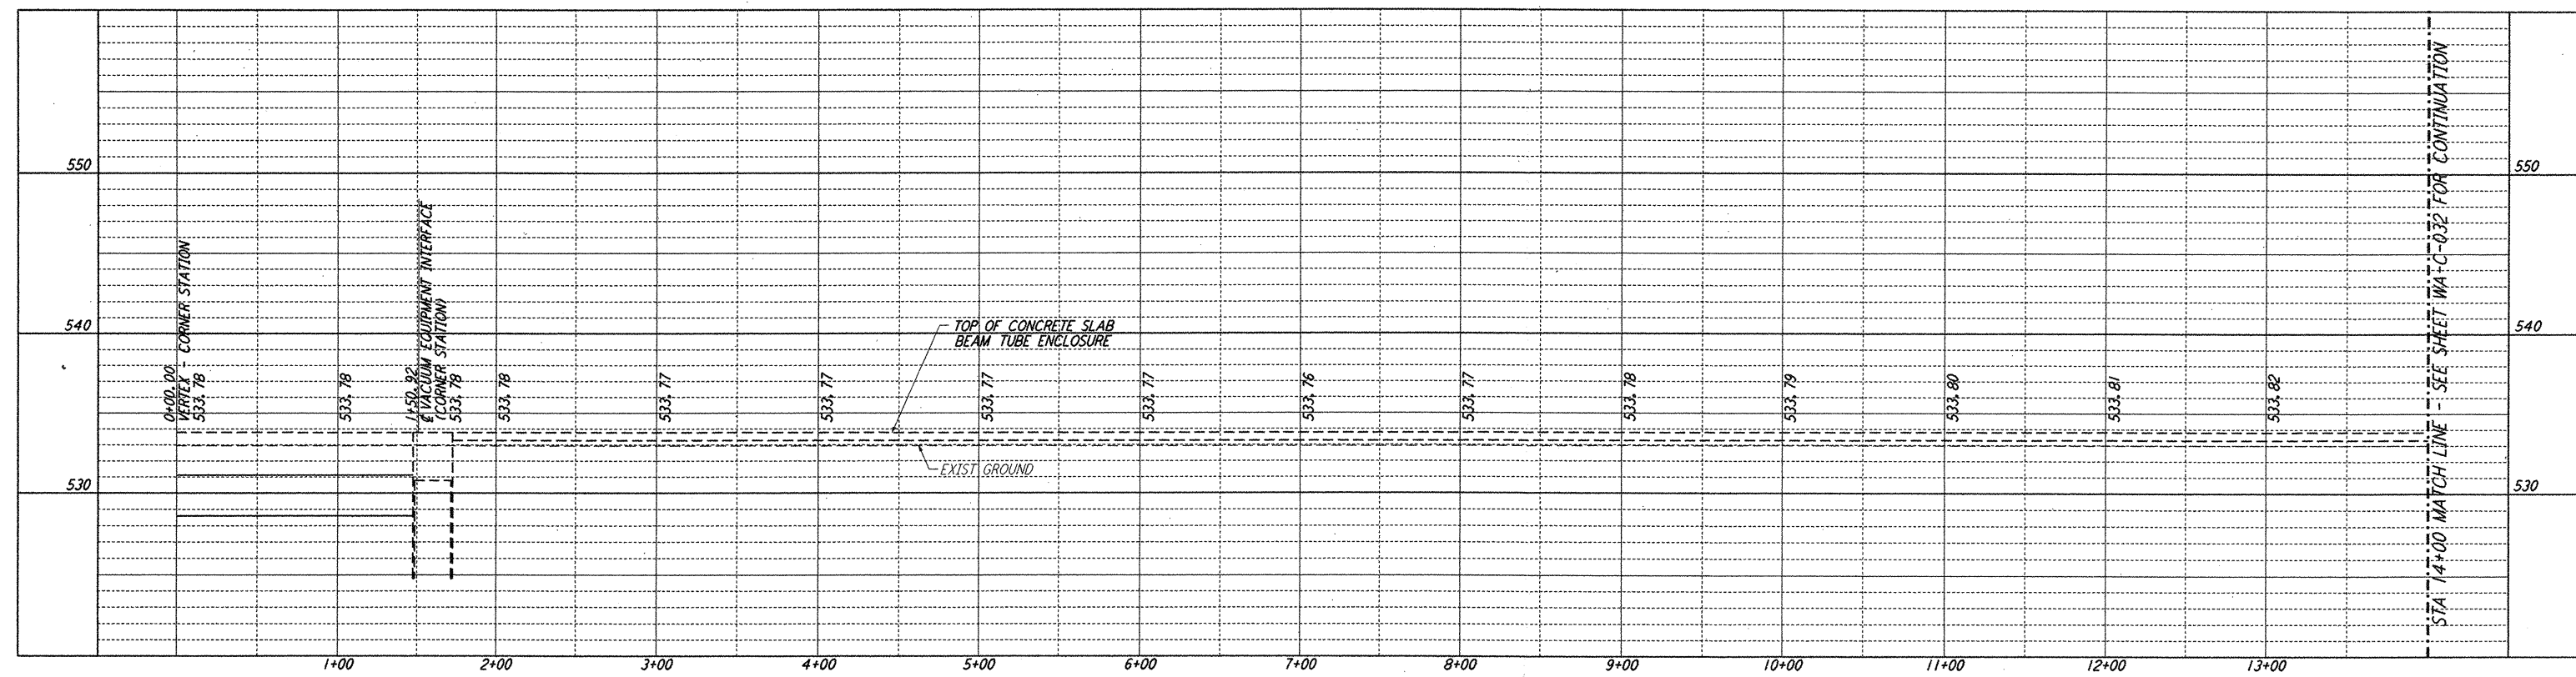


**PROFILE**  
 SCALES: HORIZ: 1" = 50'  
 VERT: 1" = 5'

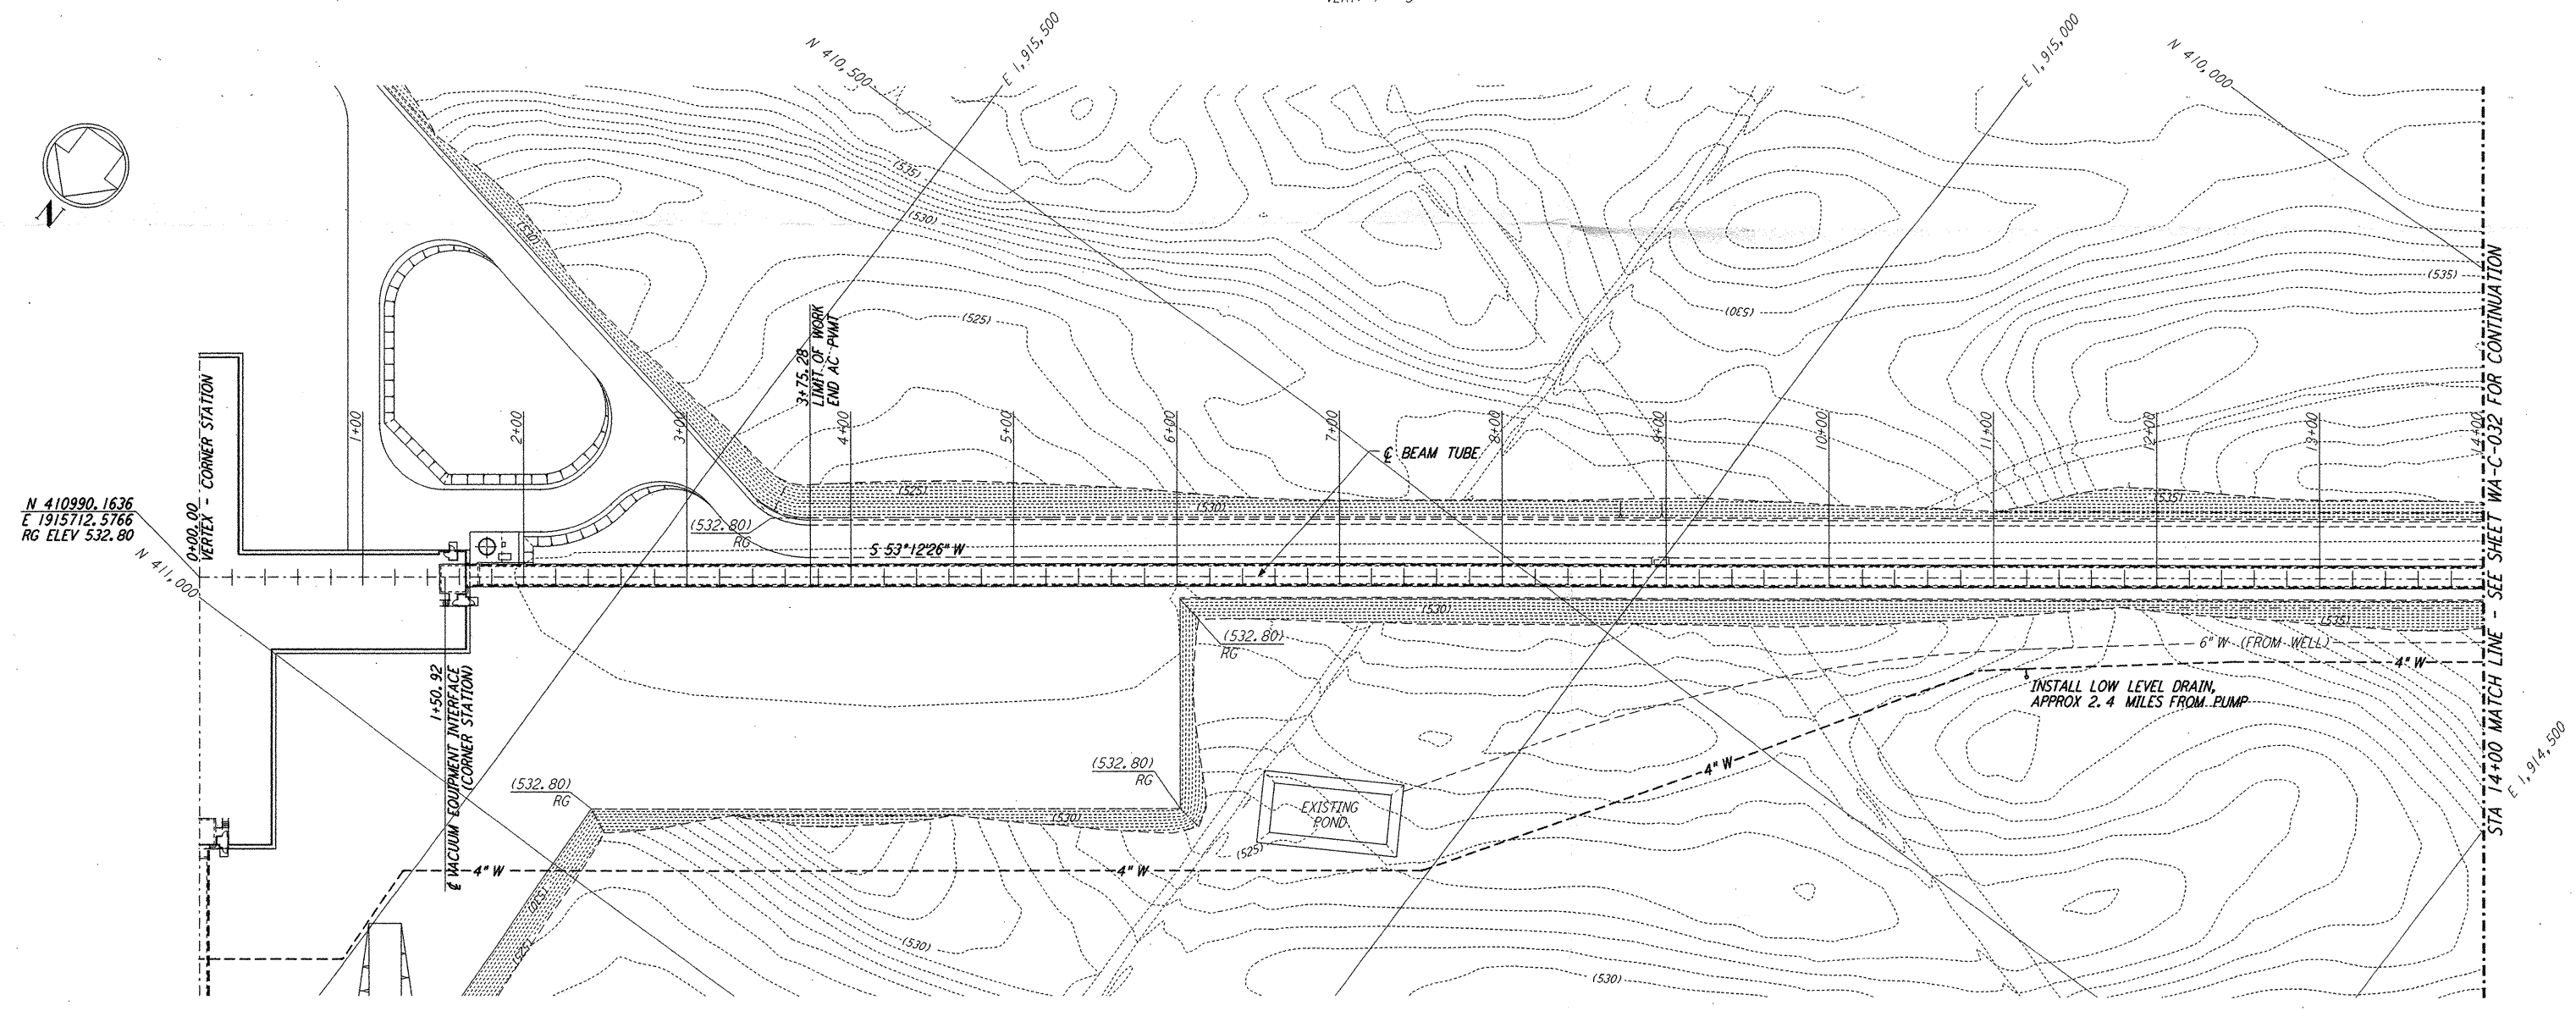

**PLAN**  
 SCALE: 1" = 50'

**NOTES:**  
 SEE SHEET WA-C-505 FOR PLOT PLAN,  
 SHEET WA-C-507 FOR GRADING PLAN  
 AND SHEET WA-C-509 FOR UTILITY PLAN  
 AT CORNER STATION.

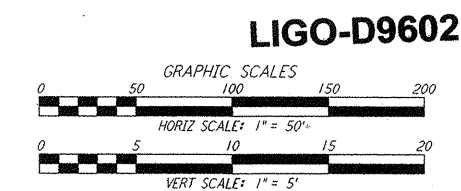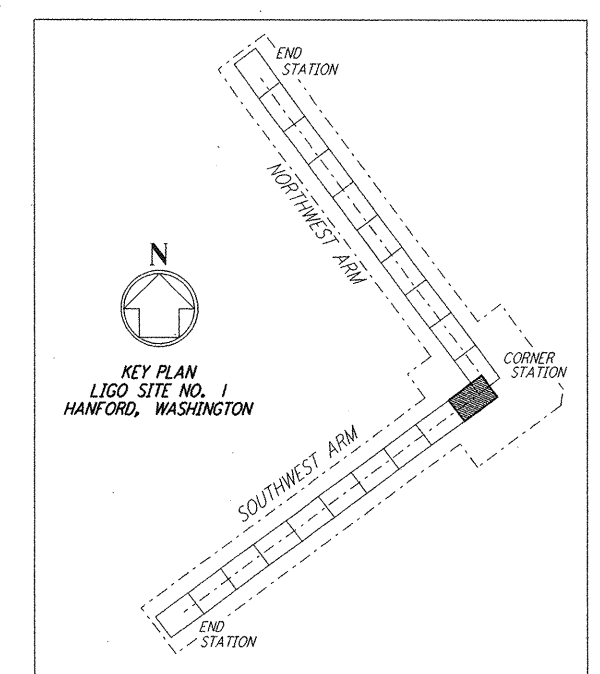

**LIGO-D960218-01-O**

**TITLE**  
 LASER INTERFEROMETER  
 GRAVITATIONAL-WAVE OBSERVATORY  
 SITE NO. 1 - HANFORD, WASHINGTON

**SCALE**  
 AS NOTED

**CONTRACT NUMBER**  
 PPI50969

**PROJECT NUMBER**  
 8094

**REVISIONS**

**DATE**  
 5/15/98

**BY**  
 WRB

**CHKD**  
 [Signature]

**ENGR**  
 [Signature]

**PROJ**  
 [Signature]

**ISSUED FOR AS-BUILT**

**DESCRIPTION**  
 CIVIL  
 SOUTHWEST ARM  
 PLAN AND PROFILE  
 STA 0+00 TO STA 14+00

**WA-C-031**

**FOR CONSTRUCTION**

DRAWN	WRB	9/28/95
CHECKED	ML	7/9/96
ENGINEER	JB	7/9/96
PROJ	MDW	7/9/96

**AS-BUILT DRAWINGS**

**PARSONS**

100 WEST WALNUT STREET  
 PASADENA, CALIFORNIA

**LIGO**

CALIFORNIA INSTITUTE OF TECHNOLOGY  
 MASSACHUSETTS INSTITUTE OF TECHNOLOGY

not be reproduced, copied, loaned, exhibited, or used in any other way, except by written consent from PARSONS to the borrower.

This document and the design it covers are the property of PARSONS. They are loaned only with the borrower's expressed written agreement that they will

NO.	DATE	BY	CHKD	ENGR	PROJ	DESCRIPTION
1	5/15/98	WRB	[Signature]	[Signature]	[Signature]	ISSUED FOR AS-BUILT

DRAWING NO.	DESCRIPTION