




NOTES:
 1. SEE SHEET WA-C-002 FOR GENERAL NOTES, LEGEND AND ABBREVIATIONS.

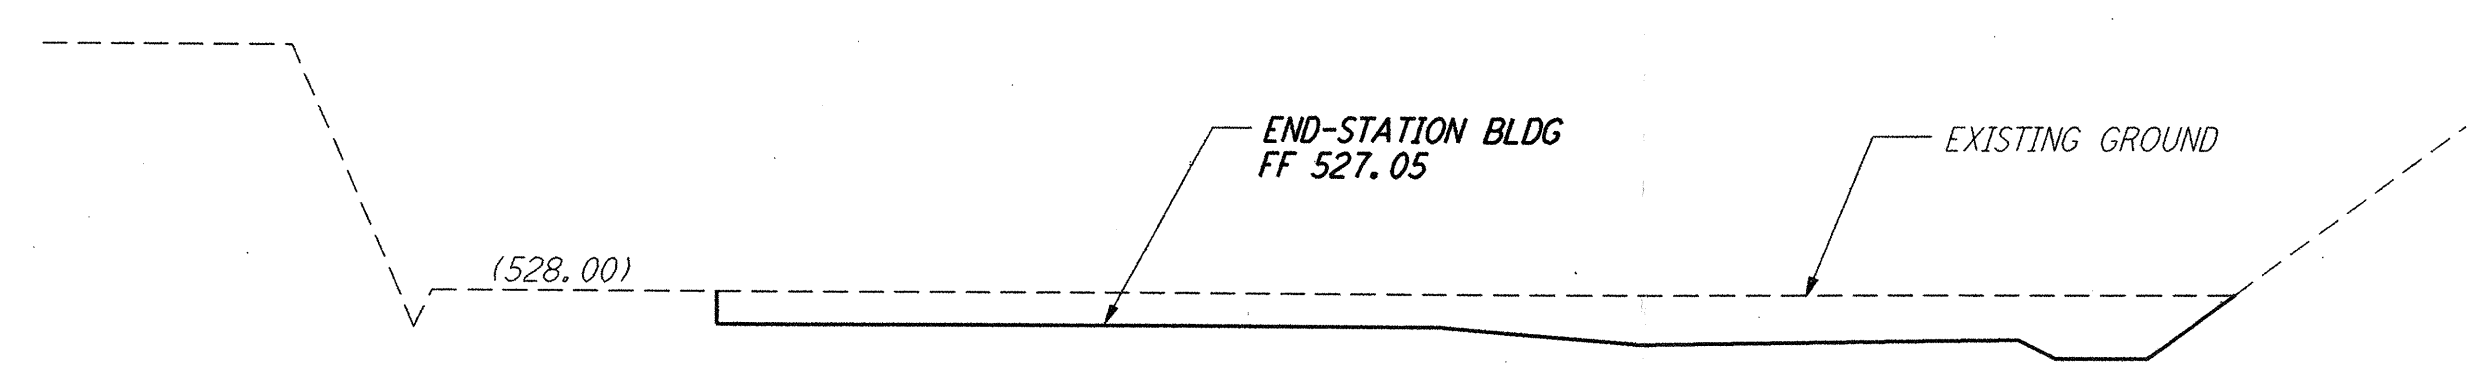


SECTION
 SCALES: HORIZ: 1" = 20'
 VERT: 1" = 10'
 REF: WA-C-054 WA-C-026

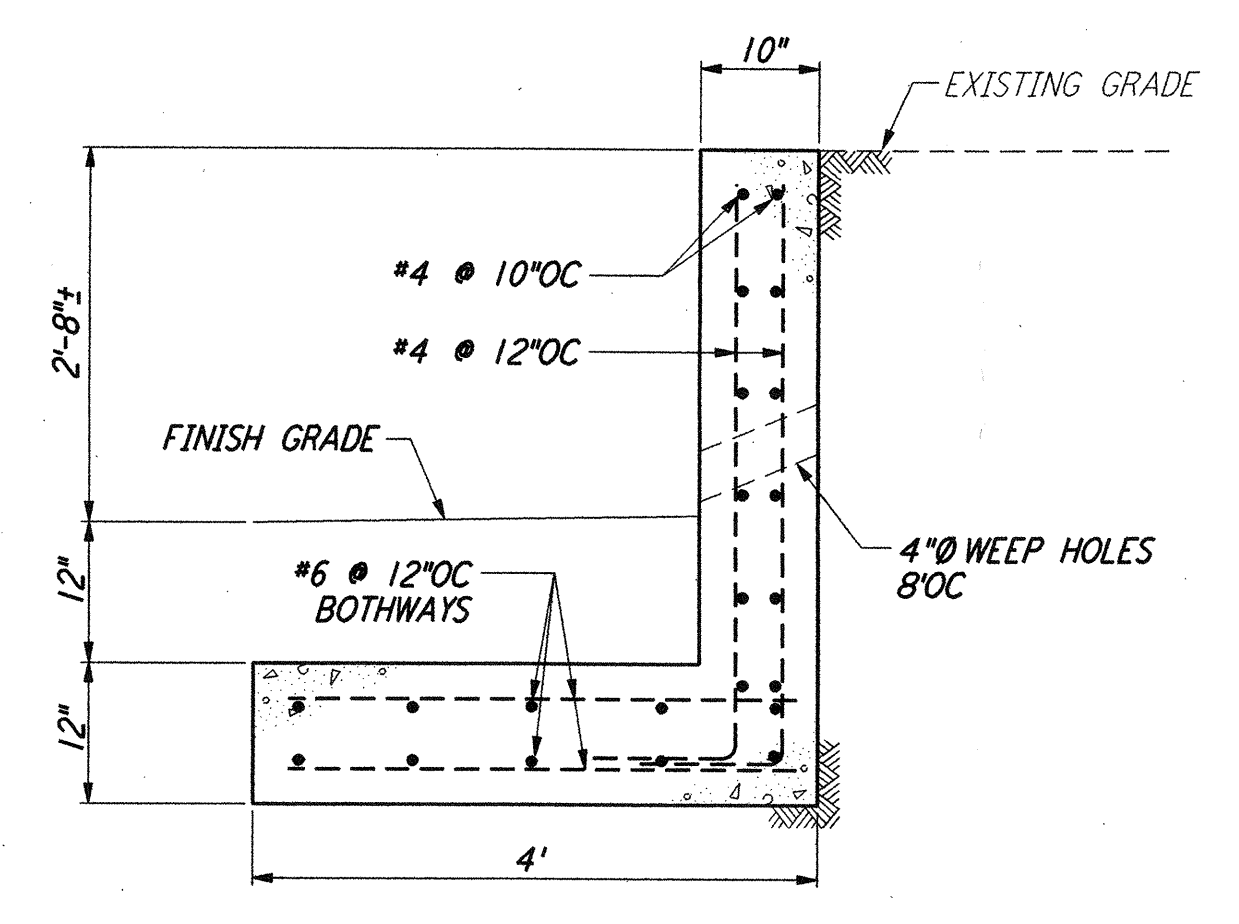

RETAINING WALL
 NOT TO SCALE
 REF: WA-C-054 WA-C-026 WA-C-046

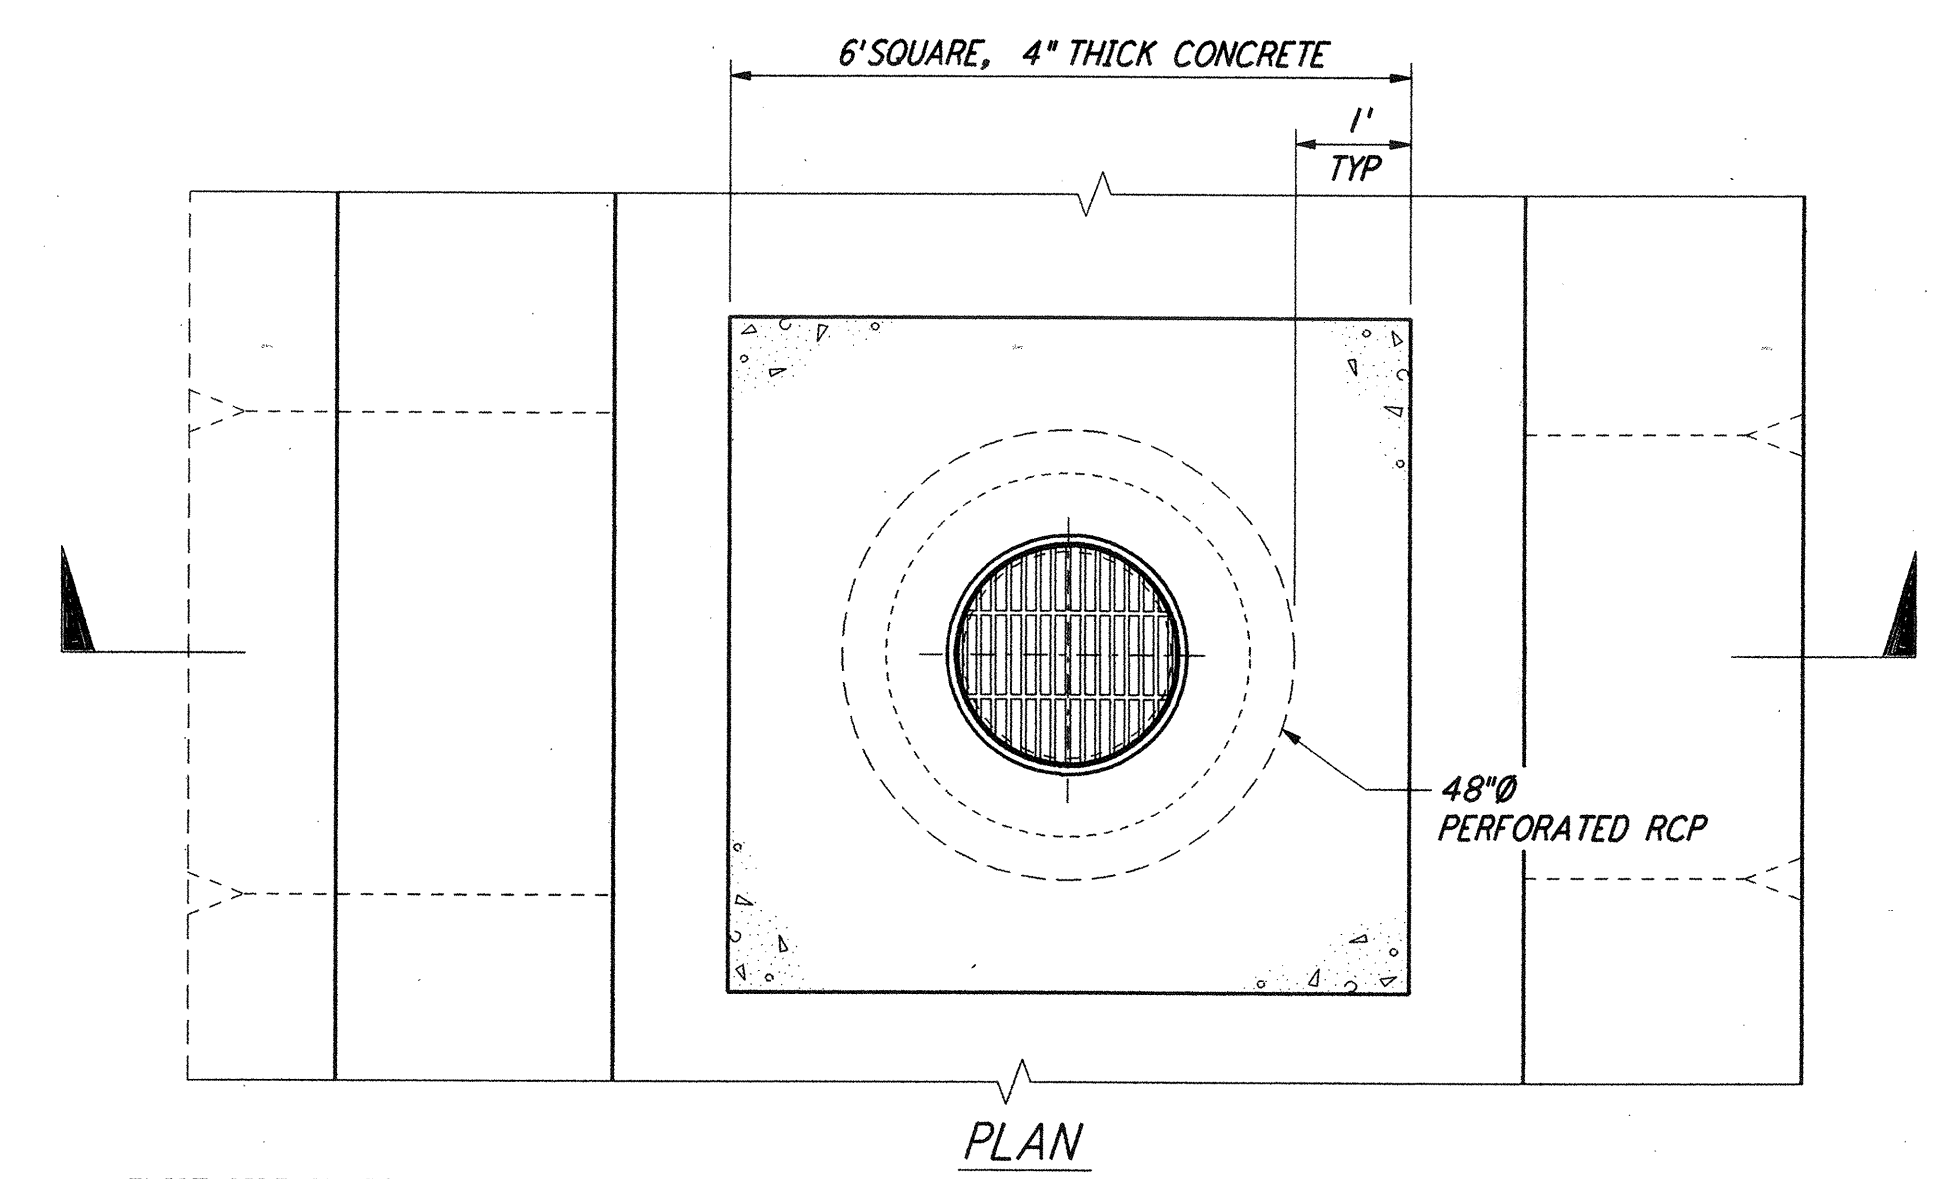

PLAN

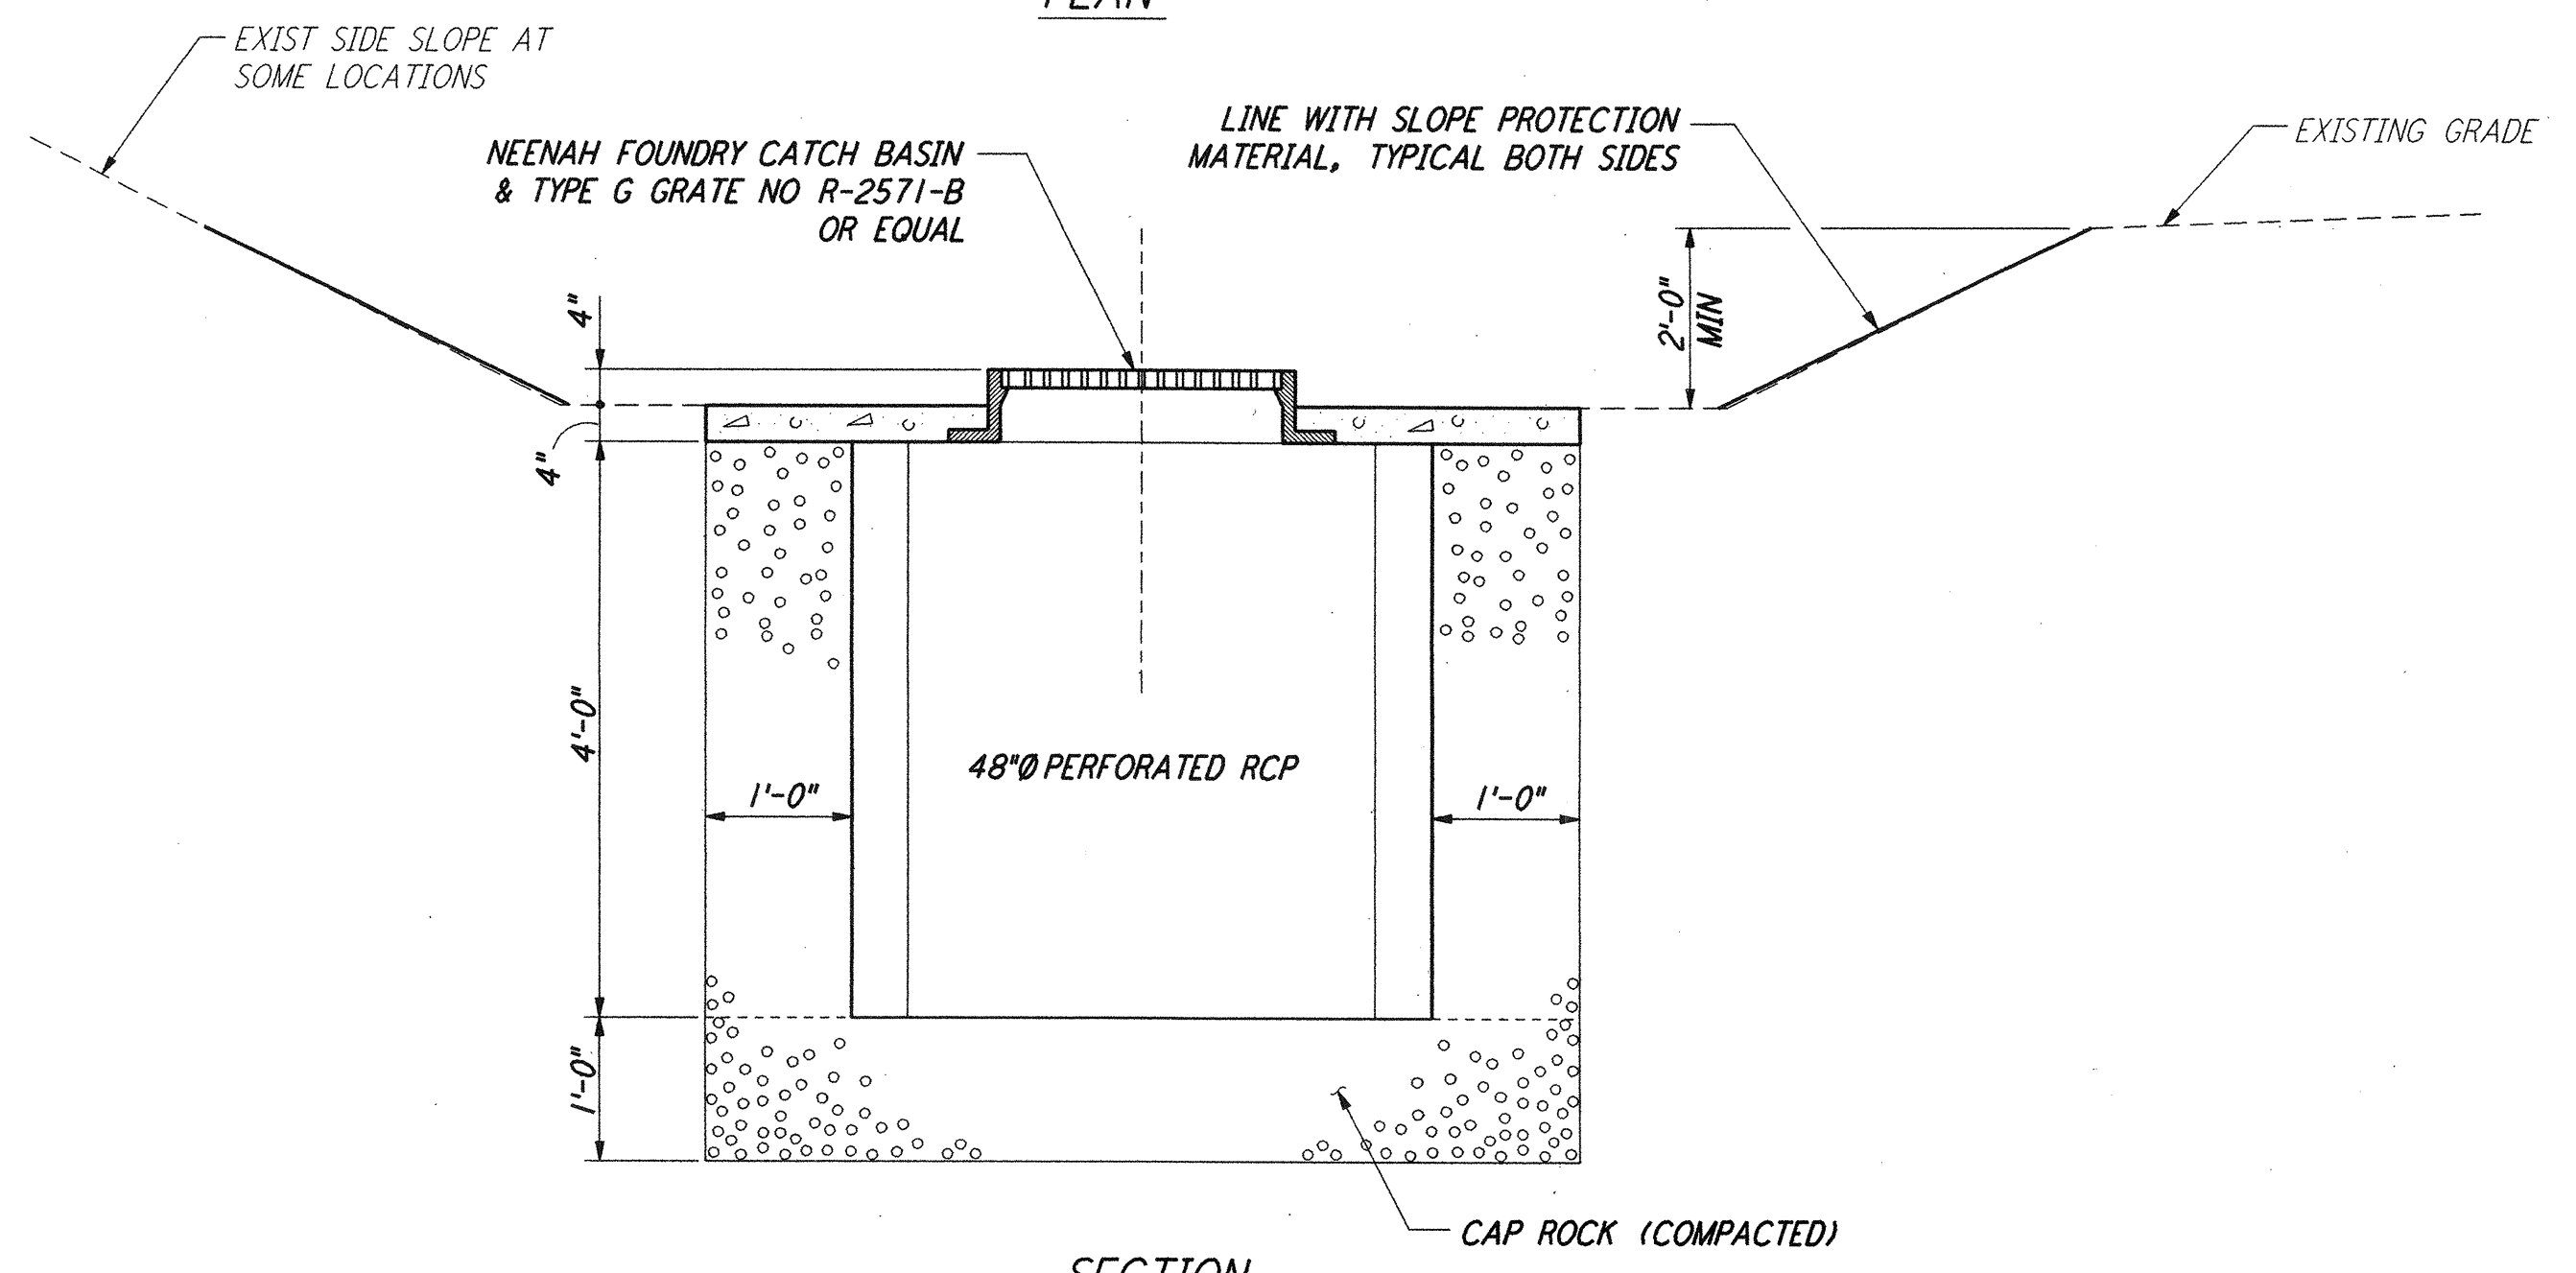

SECTION
 48" PERFORATED RCP W/ GRATE
 NOT TO SCALE
 REF: WA-C-054 WA-C-022 WA-C-026 WA-C-042

This document and the design it covers are the property of PARSONS. They are loaned only with the borrower's expressed written agreement that they will not be reproduced, copied, loaned, exhibited, or used in any other way, except by written consent from PARSONS to the borrower.

LIGO-D960238-01-O

NO.	DATE	BY	CHKD	ENGR	PROJ	DESCRIPTION
1	5/15/98	WRB	SB	DB	PK	ISSUED FOR AS-BUILT

FOR CONSTRUCTION			
DRAWN	WRB	9/28/95	
CHECKED	ML	7/9/96	
ENGINEER	JB	7/9/96	
PROJ	MDW	7/9/96	

AS-BUILT DRAWINGS

PARSONS
 100 WEST WALNUT STREET
 PASADENA, CALIFORNIA

LIGO
 CALIFORNIA INSTITUTE OF TECHNOLOGY
 MASSACHUSETTS INSTITUTE OF TECHNOLOGY

LASER INTERFEROMETER
 GRAVITATIONAL-WAVE OBSERVATORY
 SITE NO. 1 - HANFORD, WASHINGTON

SCALE	CONTRACT NUMBER	PROJECT NUMBER
AS NOTED	PP150969	8094
SHEET NUMBER		REVISIONS
WA-C-054		△

CIVIL GRADING SECTIONS & DETAILS SHEET 2