



This document and the design it covers are the property of PARSONS. They are loaned only with the borrower's expressed written agreement that they will not be reproduced, copied, loaned, exhibited, or used in any other way, except by written consent from PARSONS to the borrower.

This document and the design it covers are the property of PARSONS. They are loaned only with the borrower's expressed written agreement that they will not be reproduced, copied, loaned, exhibited, or used in any other way, except by written consent from PARSONS to the borrower.

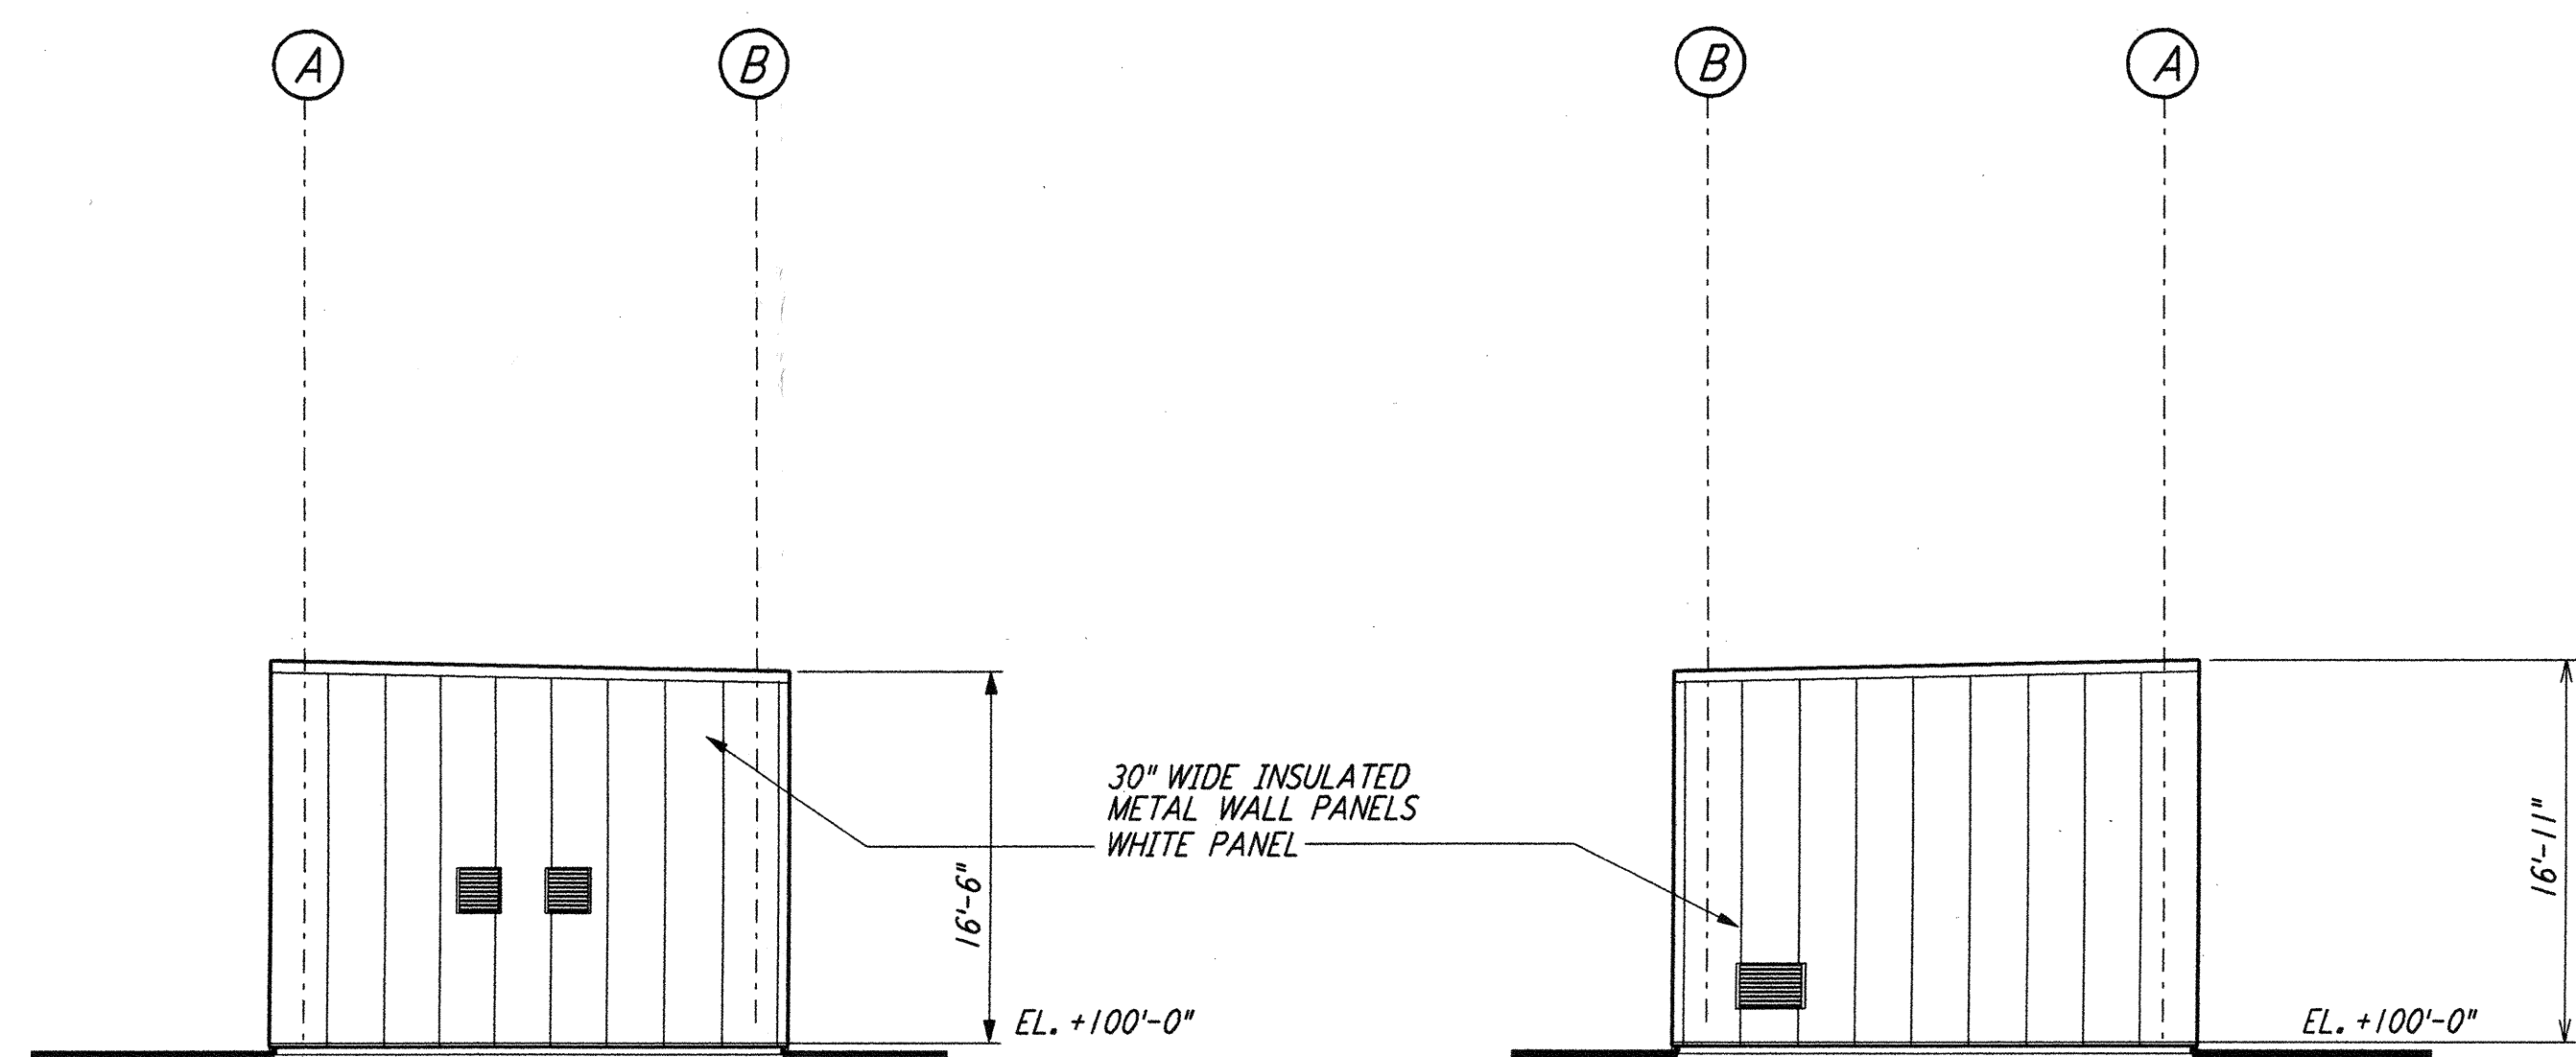




ELEVATION A REF  
 $\frac{1}{8}'' = 1'-0''$  WA-A-143 WA-A-112

ELEVATION C REF  
 $\frac{1}{8}'' = 1'-0''$  WA-A-143 WA-A-112

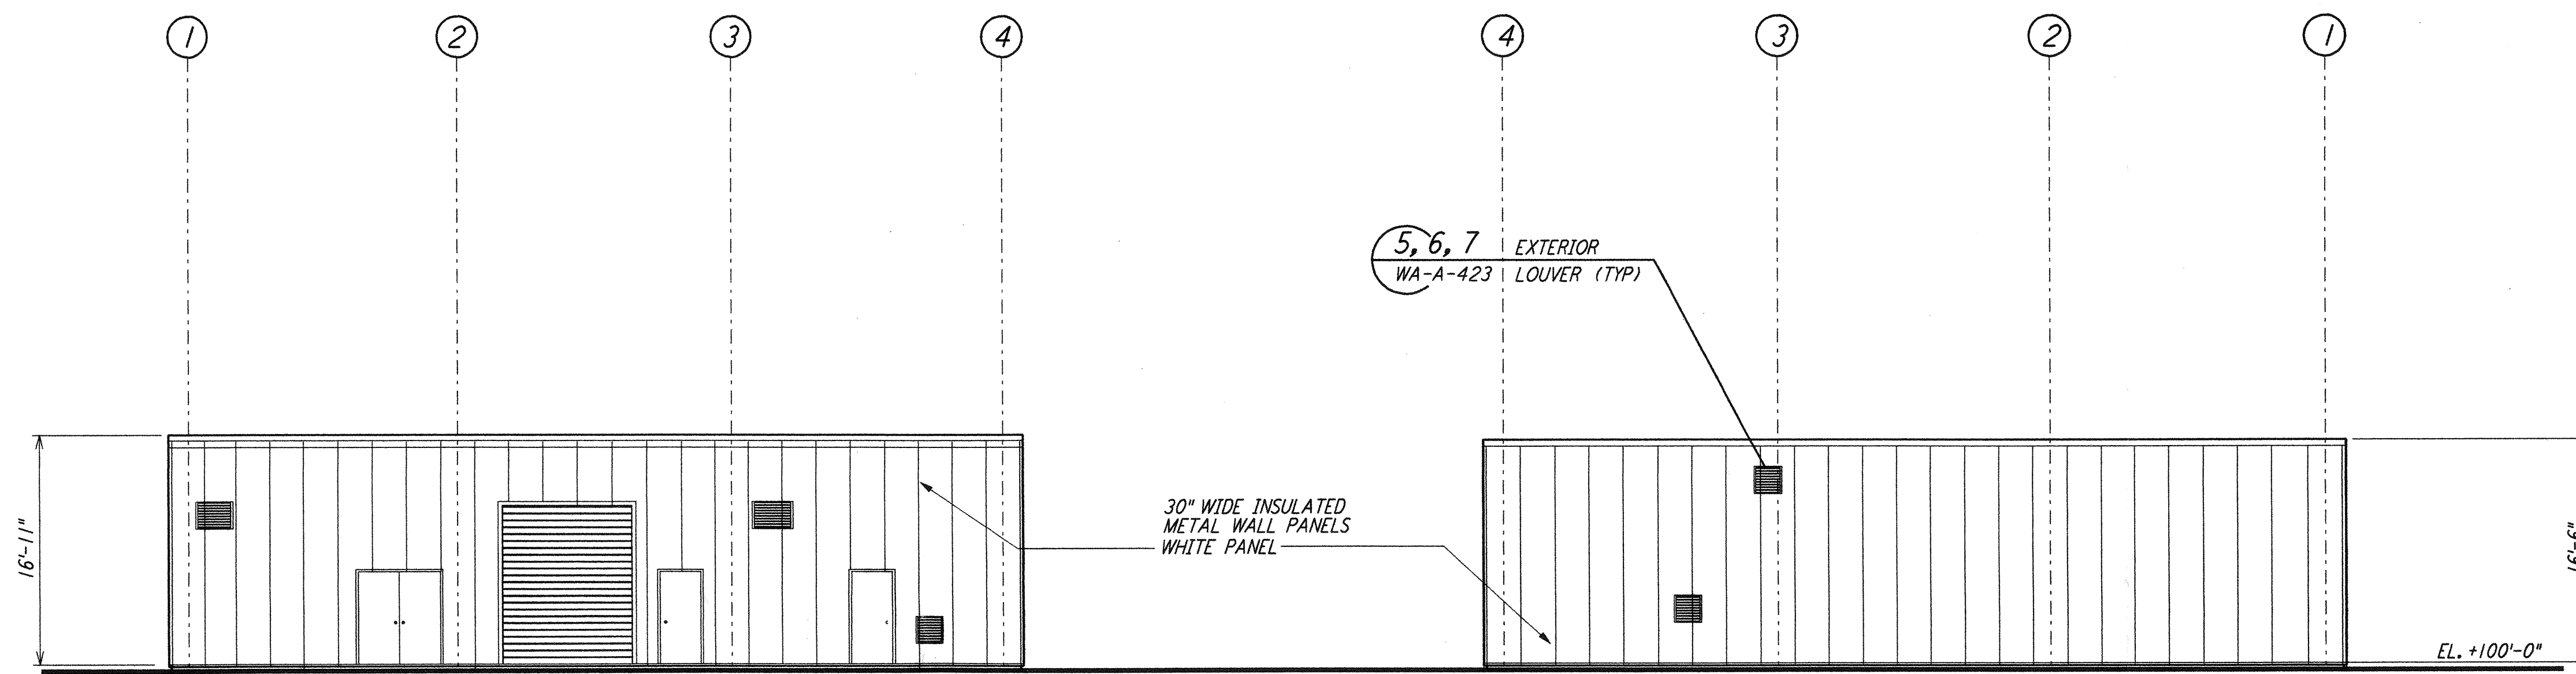


ELEVATION B REF  
 $\frac{1}{8}'' = 1'-0''$  WA-A-143 WA-A-112

ELEVATION D REF  
 $\frac{1}{8}'' = 1'-0''$  WA-A-143 WA-A-112

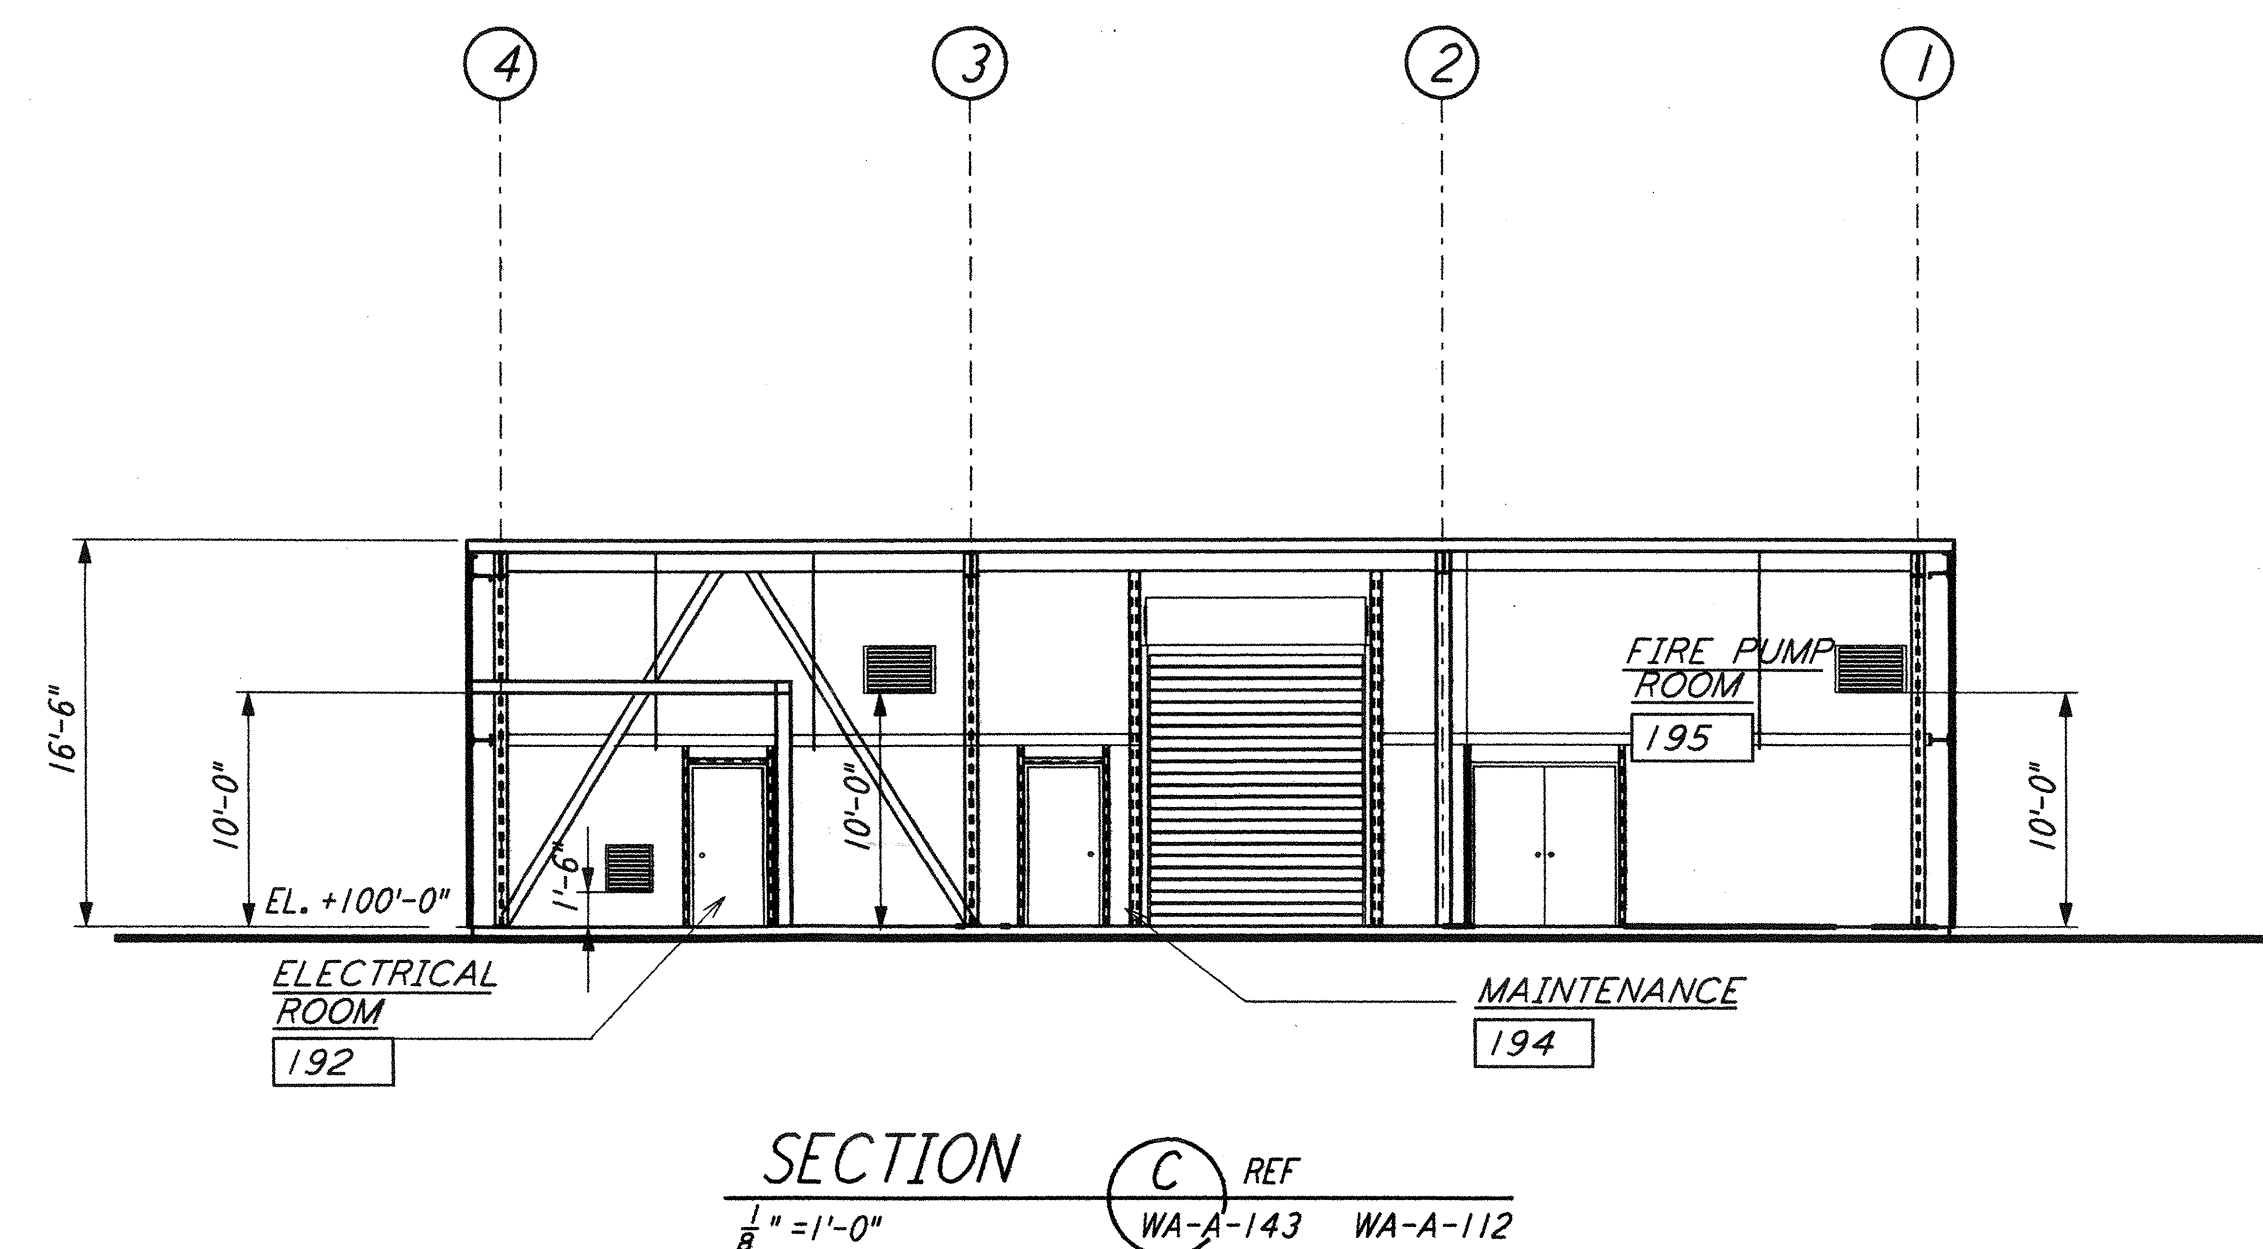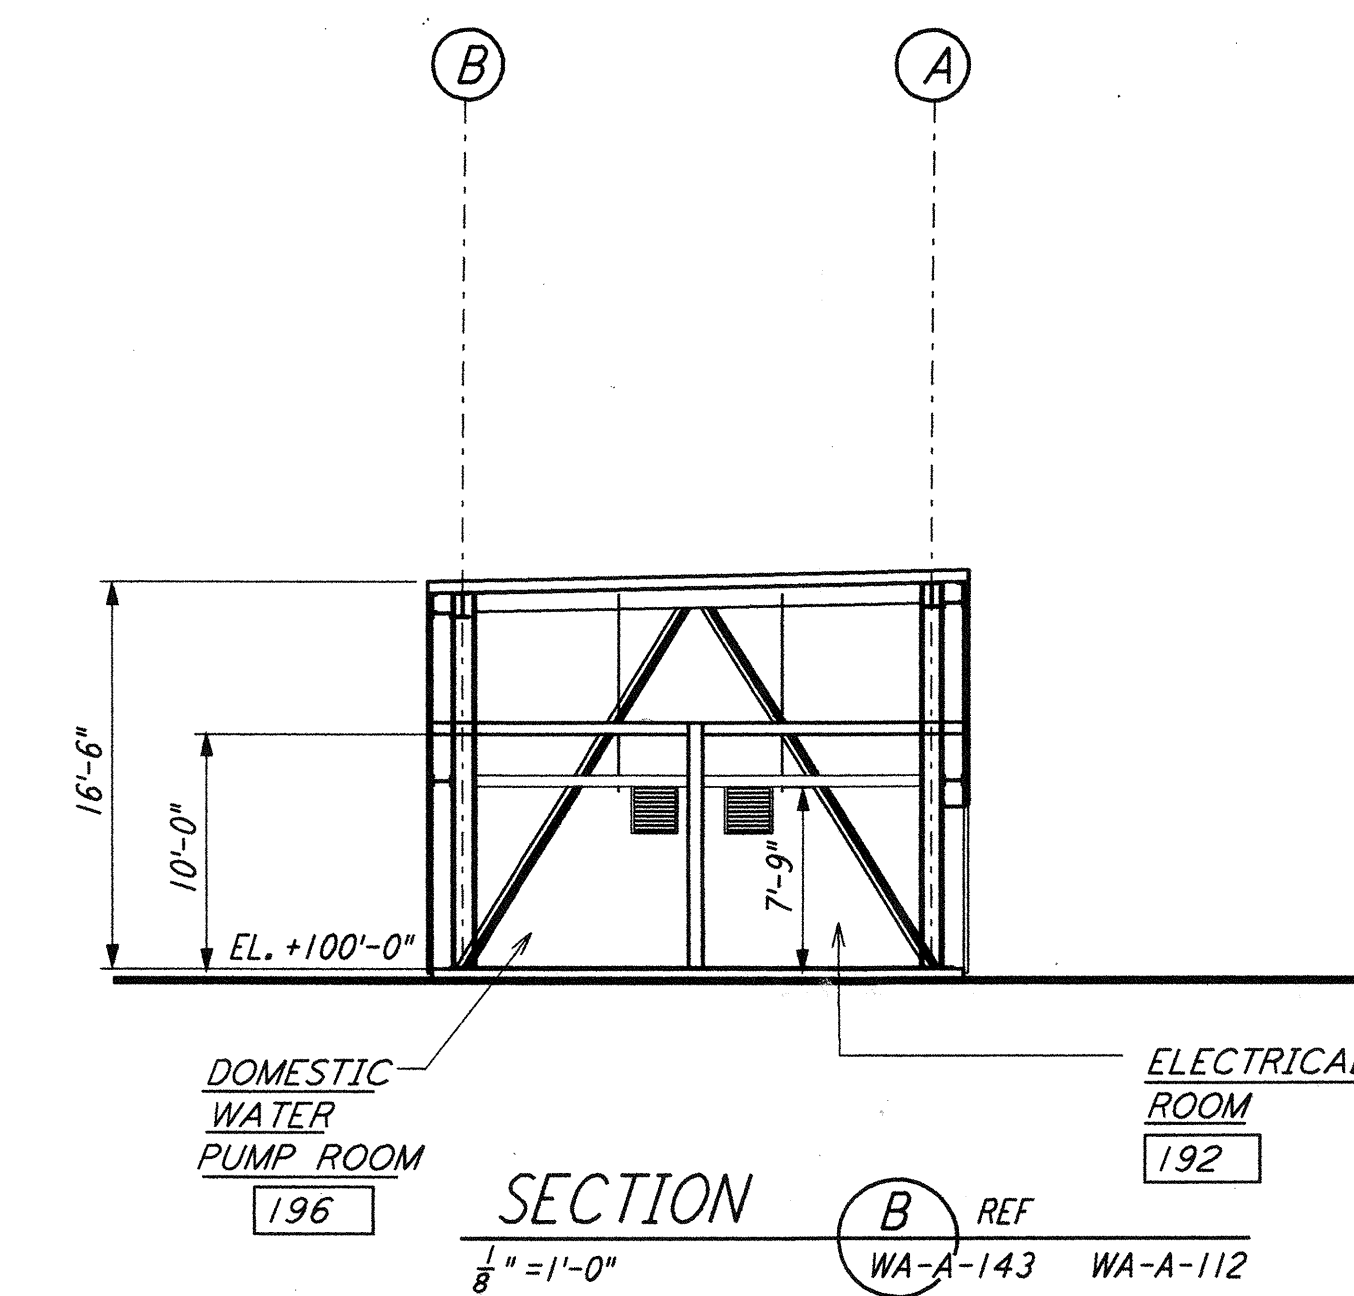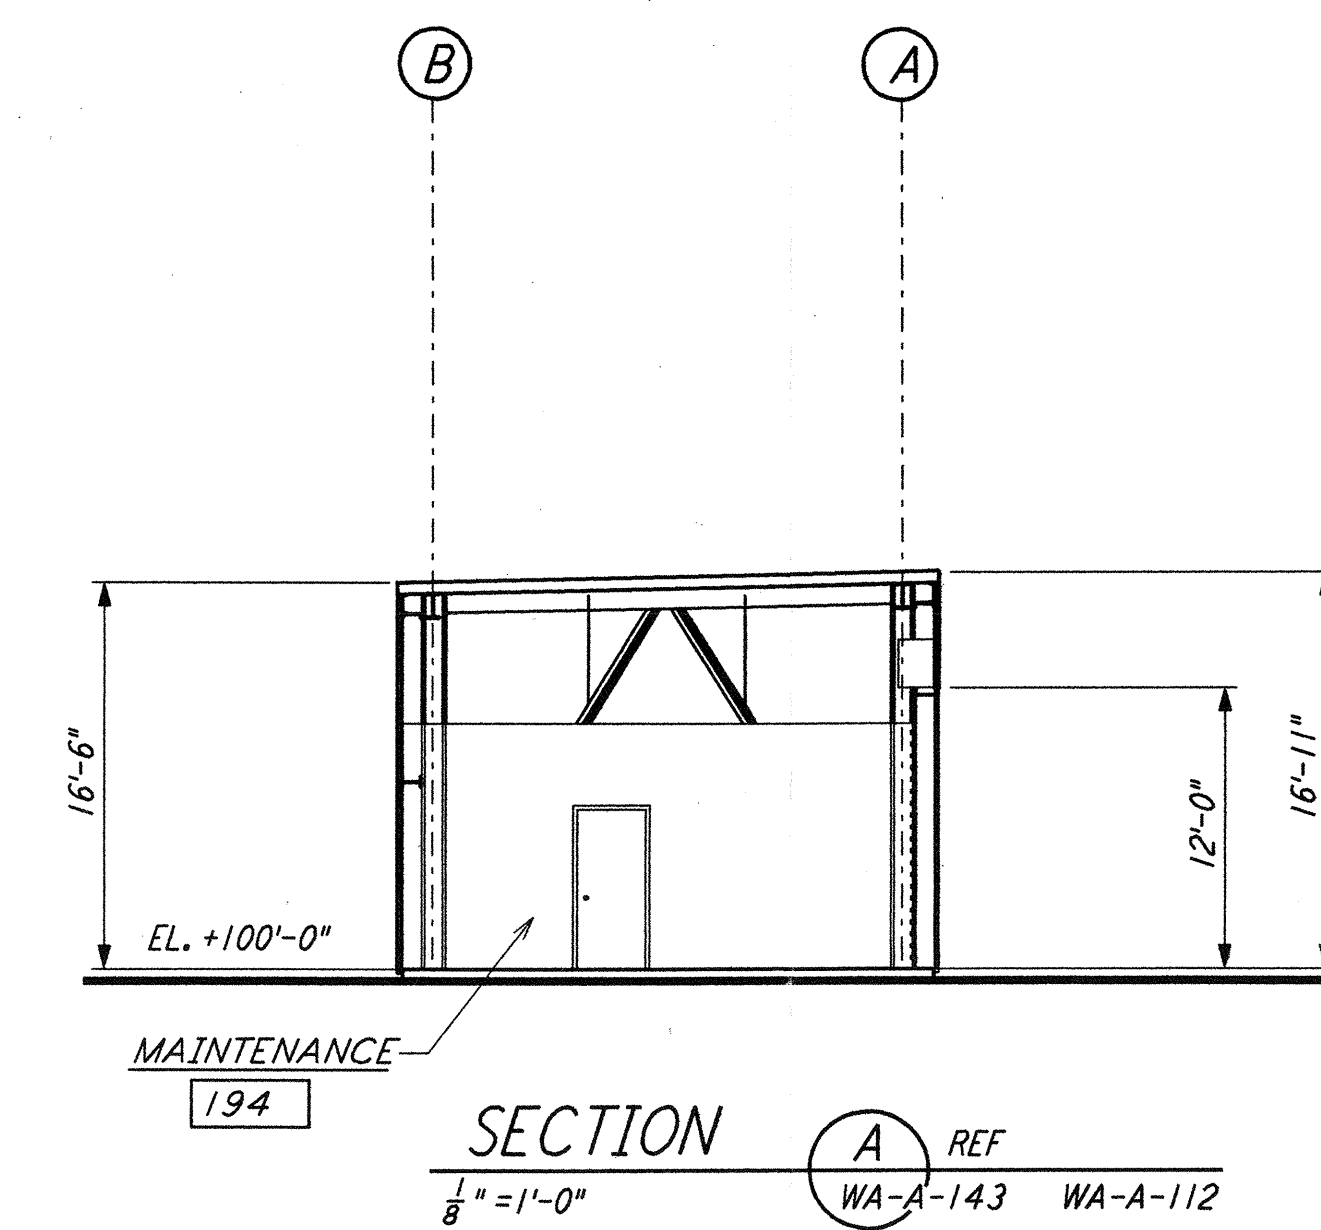

DATUM POINT EL +100, 00 = 531.11' (LVEA)  
 DATUM POINT EL +100, 00 = 531.11' (OSB)  
 DATUM POINT EL +100, 00 = 532.50' (MAINTENANCE BLDG)

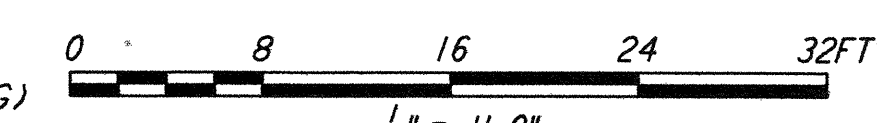

LIGO-D960255-01-0

NO.	DATE	BY	CHKD	ENGR	PROJ	DESCRIPTION
1	5-15-98	CKT	MM	MM	MM	ISSUED FOR AS-BUILT

NO.	DATE	BY	CHKD	ENGR	PROJ	DESCRIPTION
1	5-12-96	CKT	MM	MM	MM	ISSUED FOR CONSTRUCTION
2	5-26-96	TB	MM	MM	MM	CHECKED
3	7-12-96	bkk	MM	MM	MM	ENGINEER
4	7-12-96	MDW	MM	MM	MM	PROJ

AS-BUILT DRAWINGS

**PARSONS**  
 100 WEST WALNUT STREET  
 PASADENA, CALIFORNIA

**LIGO**  
 CALIFORNIA INSTITUTE OF TECHNOLOGY  
 MASSACHUSETTS INSTITUTE OF TECHNOLOGY

LASER INTERFEROMETER  
 GRAVITATIONAL-WAVE OBSERVATORY  
 SITE NO. 1 - HANFORD, WASHINGTON  
**ARCHITECTURAL CORNER STATION MAINTENANCE BUILDING ELEVATION/ SECTION**  
 SCALE: AS NOTED CONTRACT NUMBER: PP150969 PROJECT NUMBER: 8094  
**WA-A-143**