



not be reproduced, copied, loaned, exhibited, or used in any other way, except by written consent from PARSONS to the borrower.


This document and the design it covers are the property of PARSONS. They are loaned only with the borrower's expressed written agreement that they will

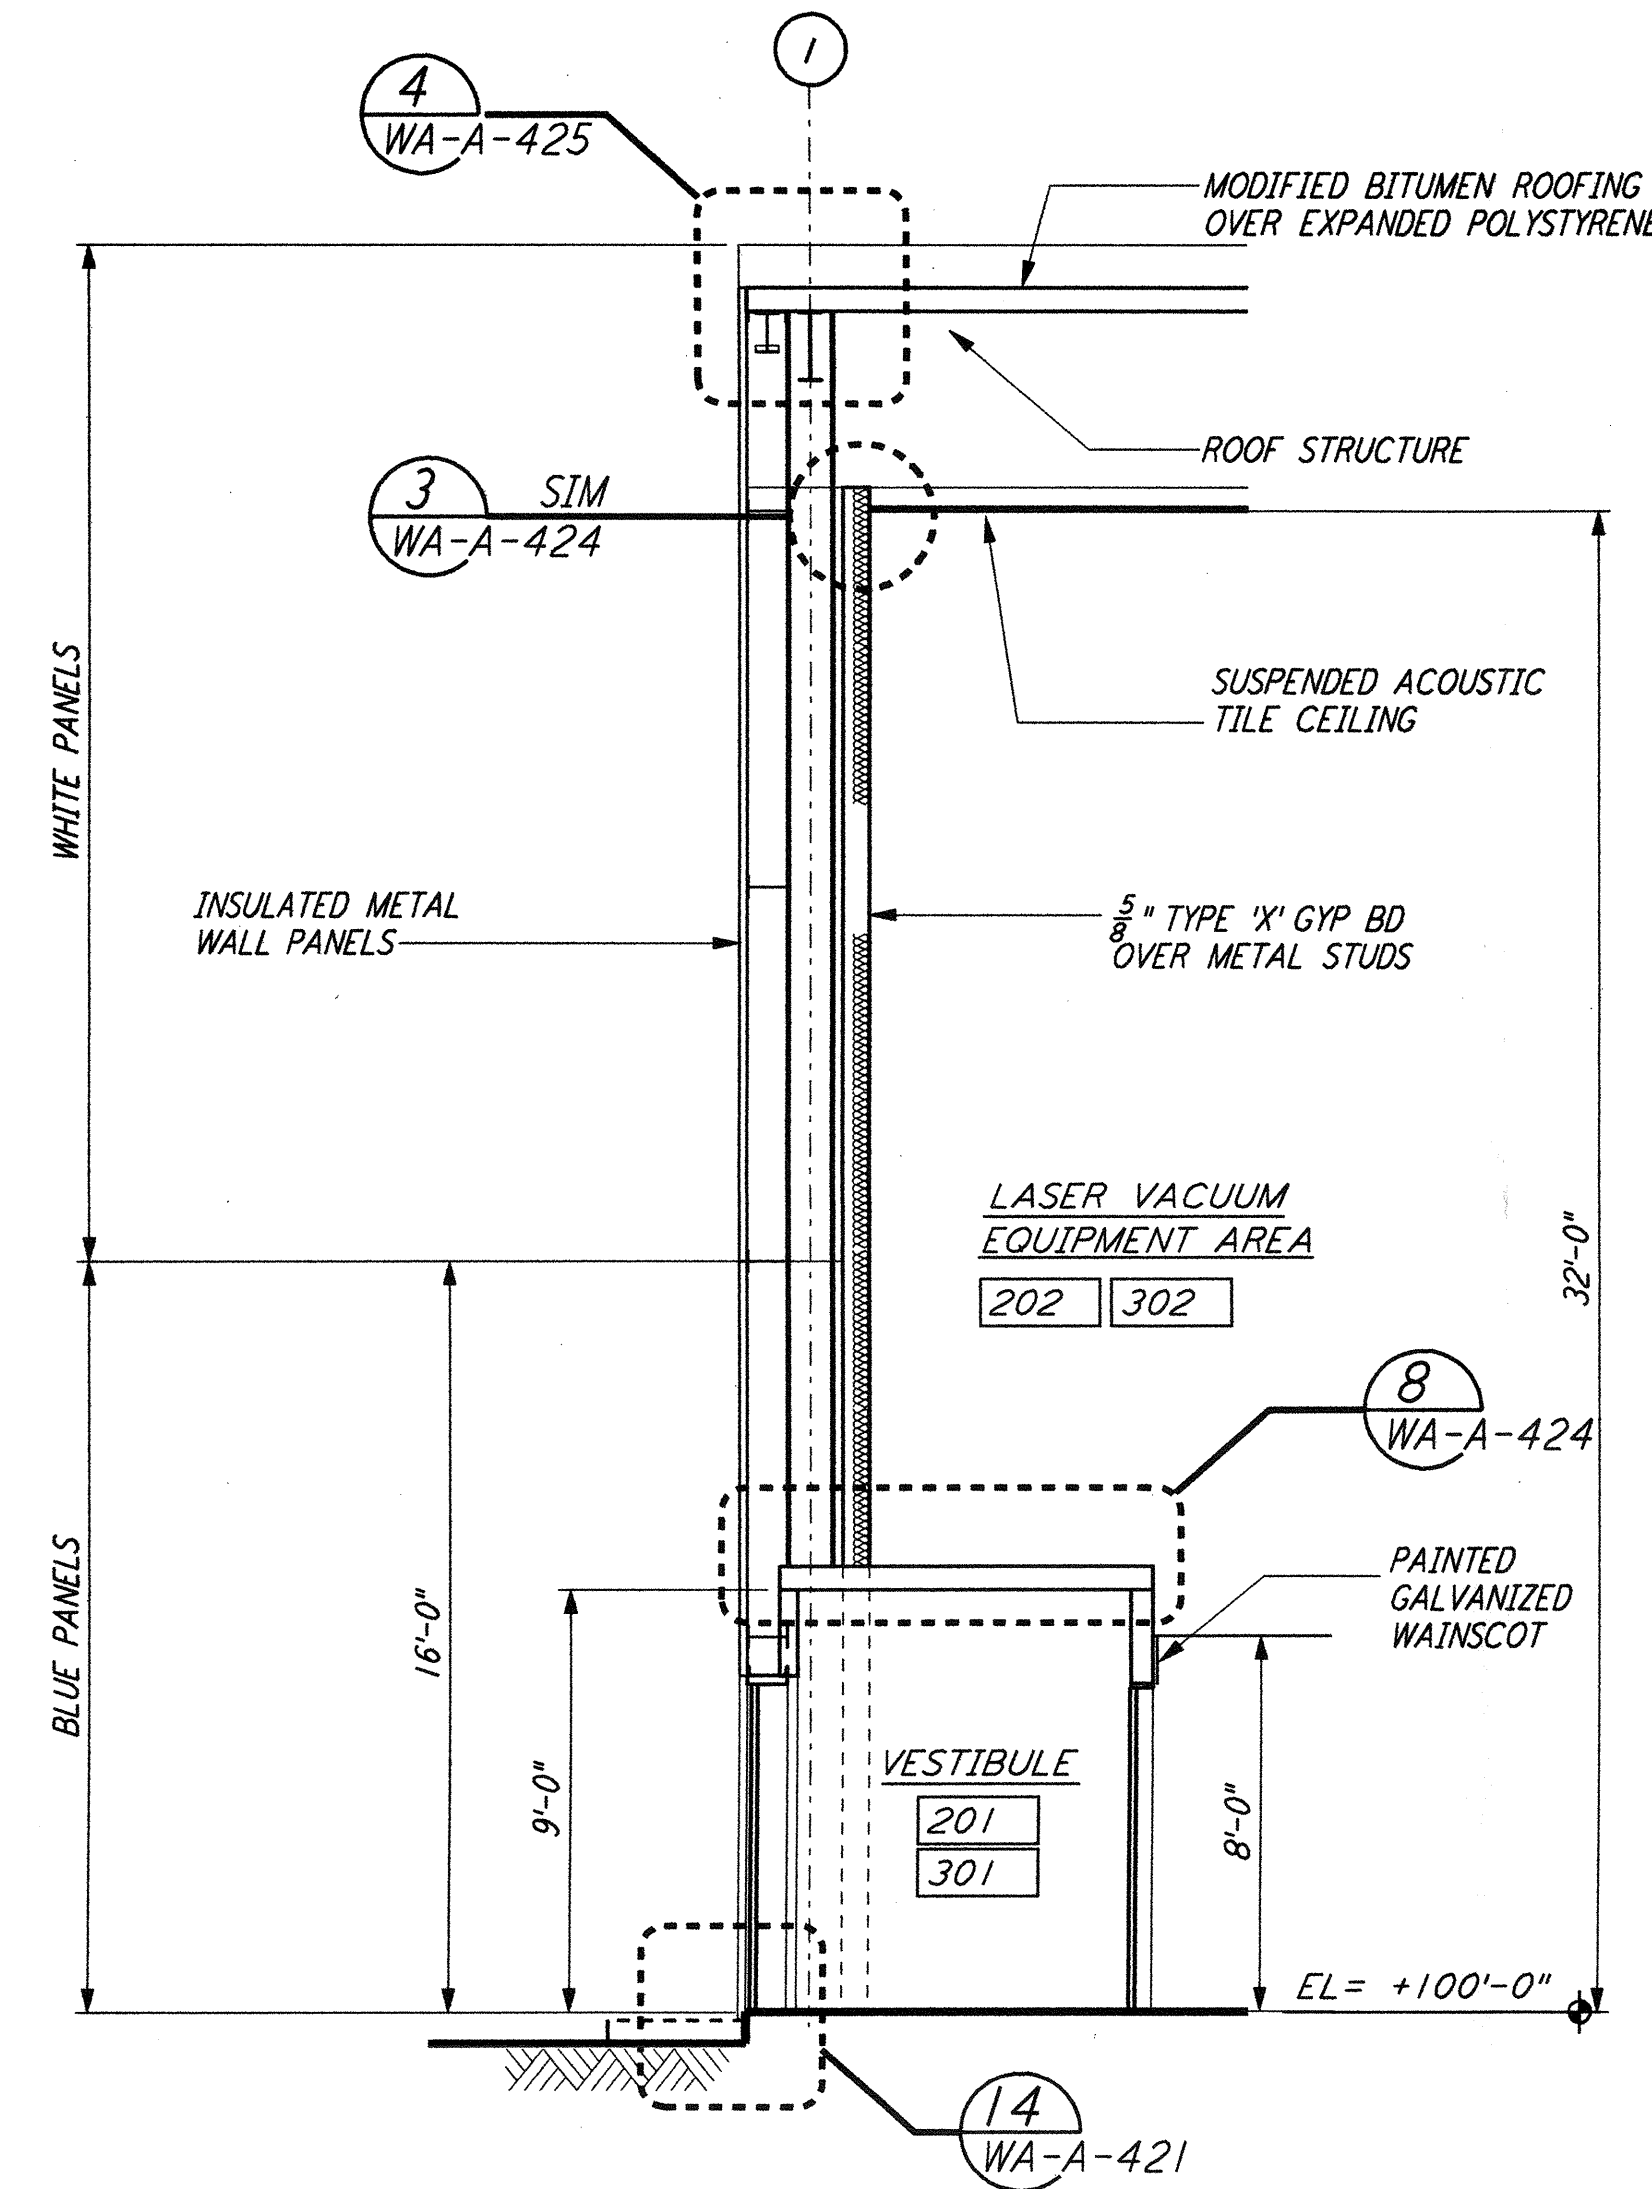


WALL SECTION
 $\frac{1}{4}" = 1'-0"$
 G REF
 WA-A-261 WA-A-251

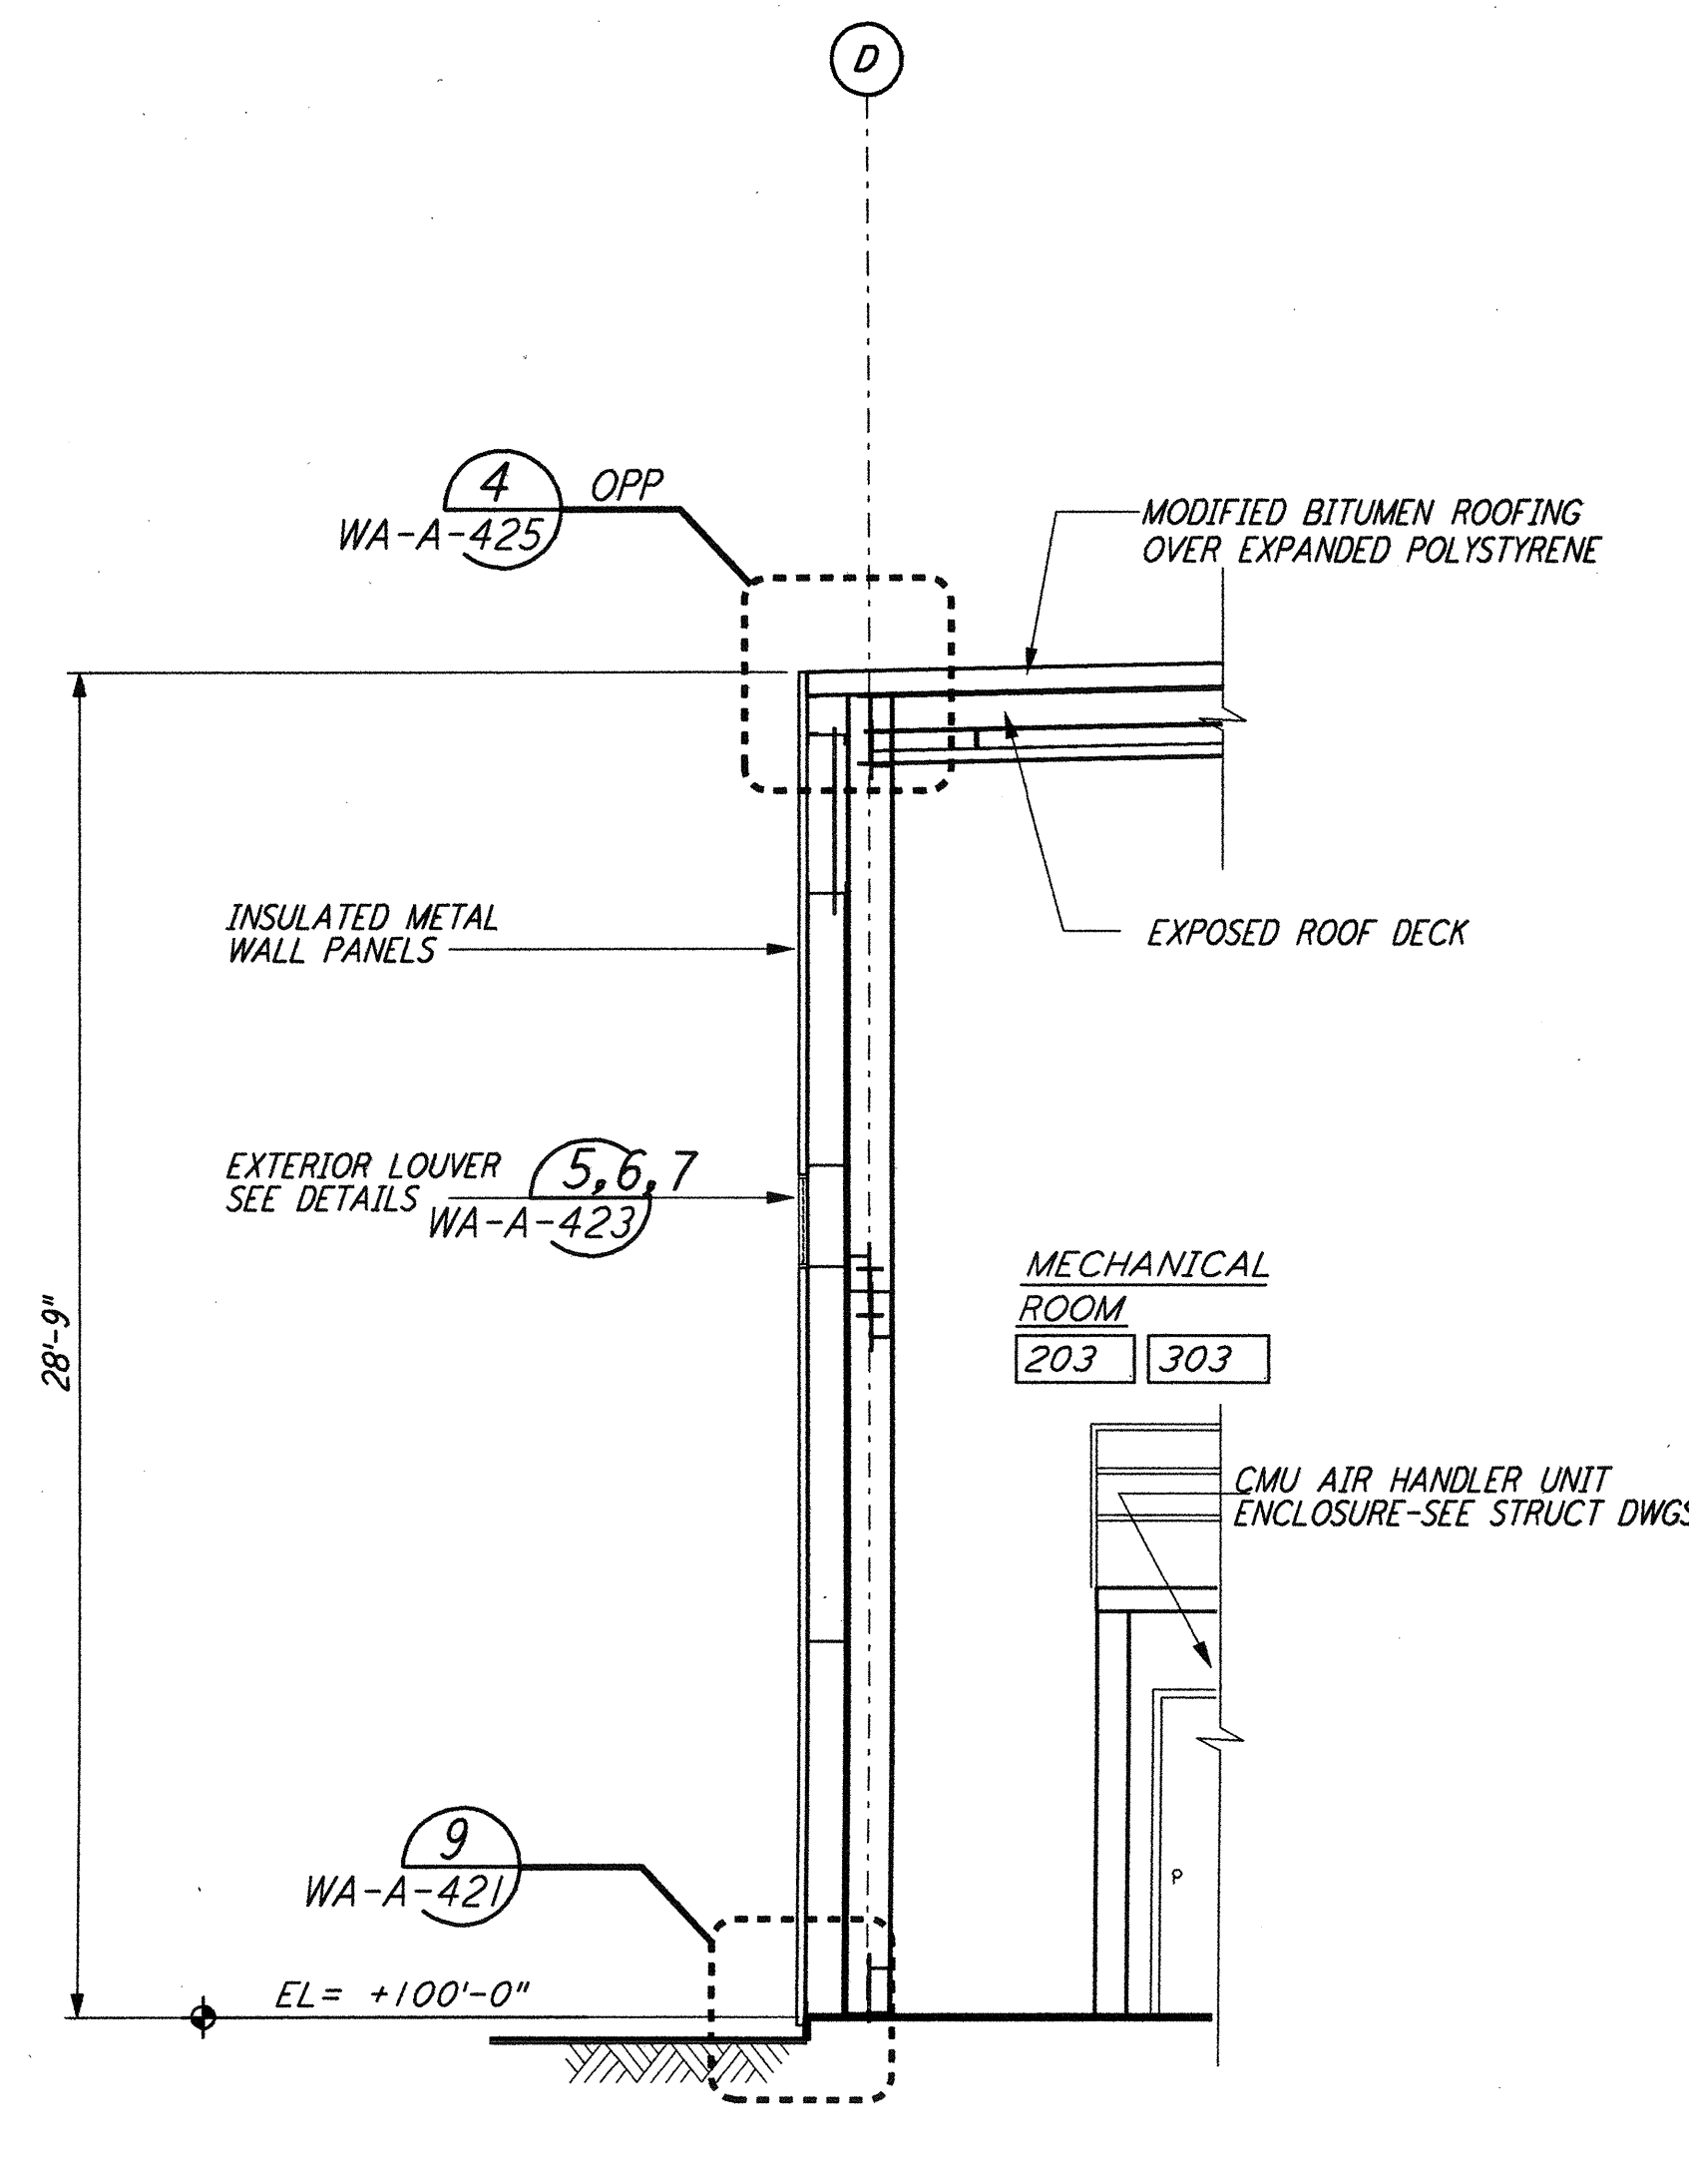


WALL SECTION
 $\frac{1}{4}" = 1'-0"$
 E REF
 WA-A-261 WA-A-251

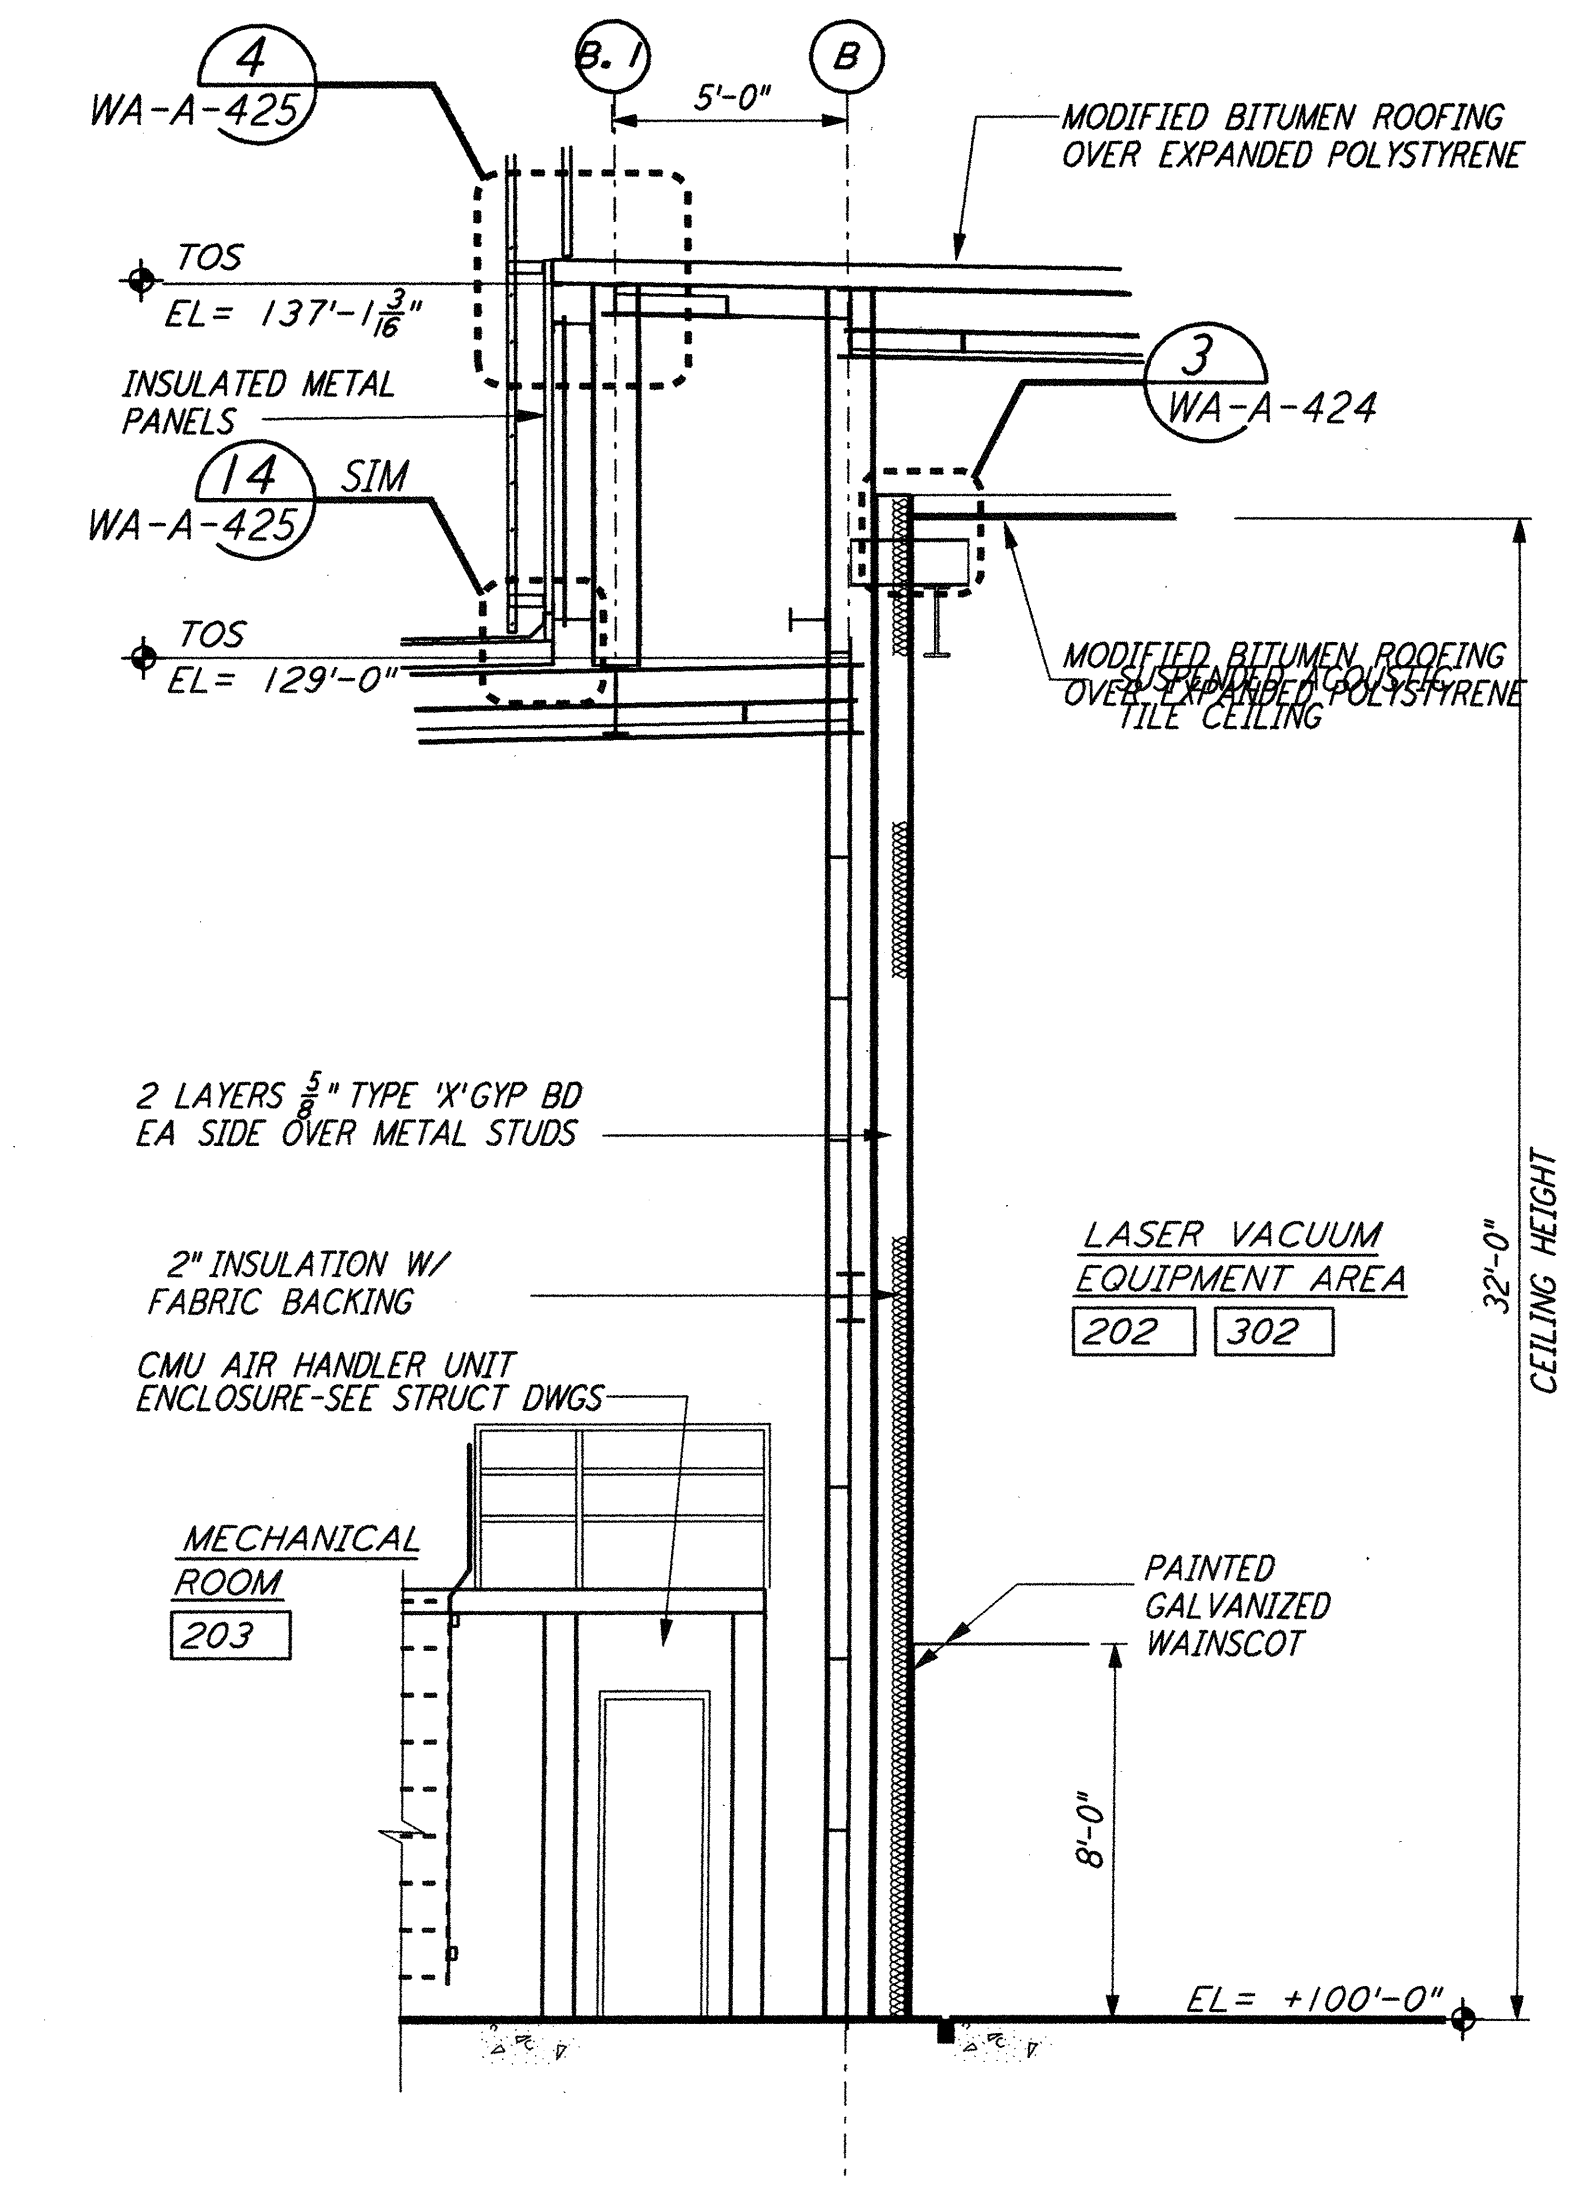


WALL SECTION
 $\frac{1}{4}" = 1'-0"$
 C REF
 WA-A-261 WA-A-251

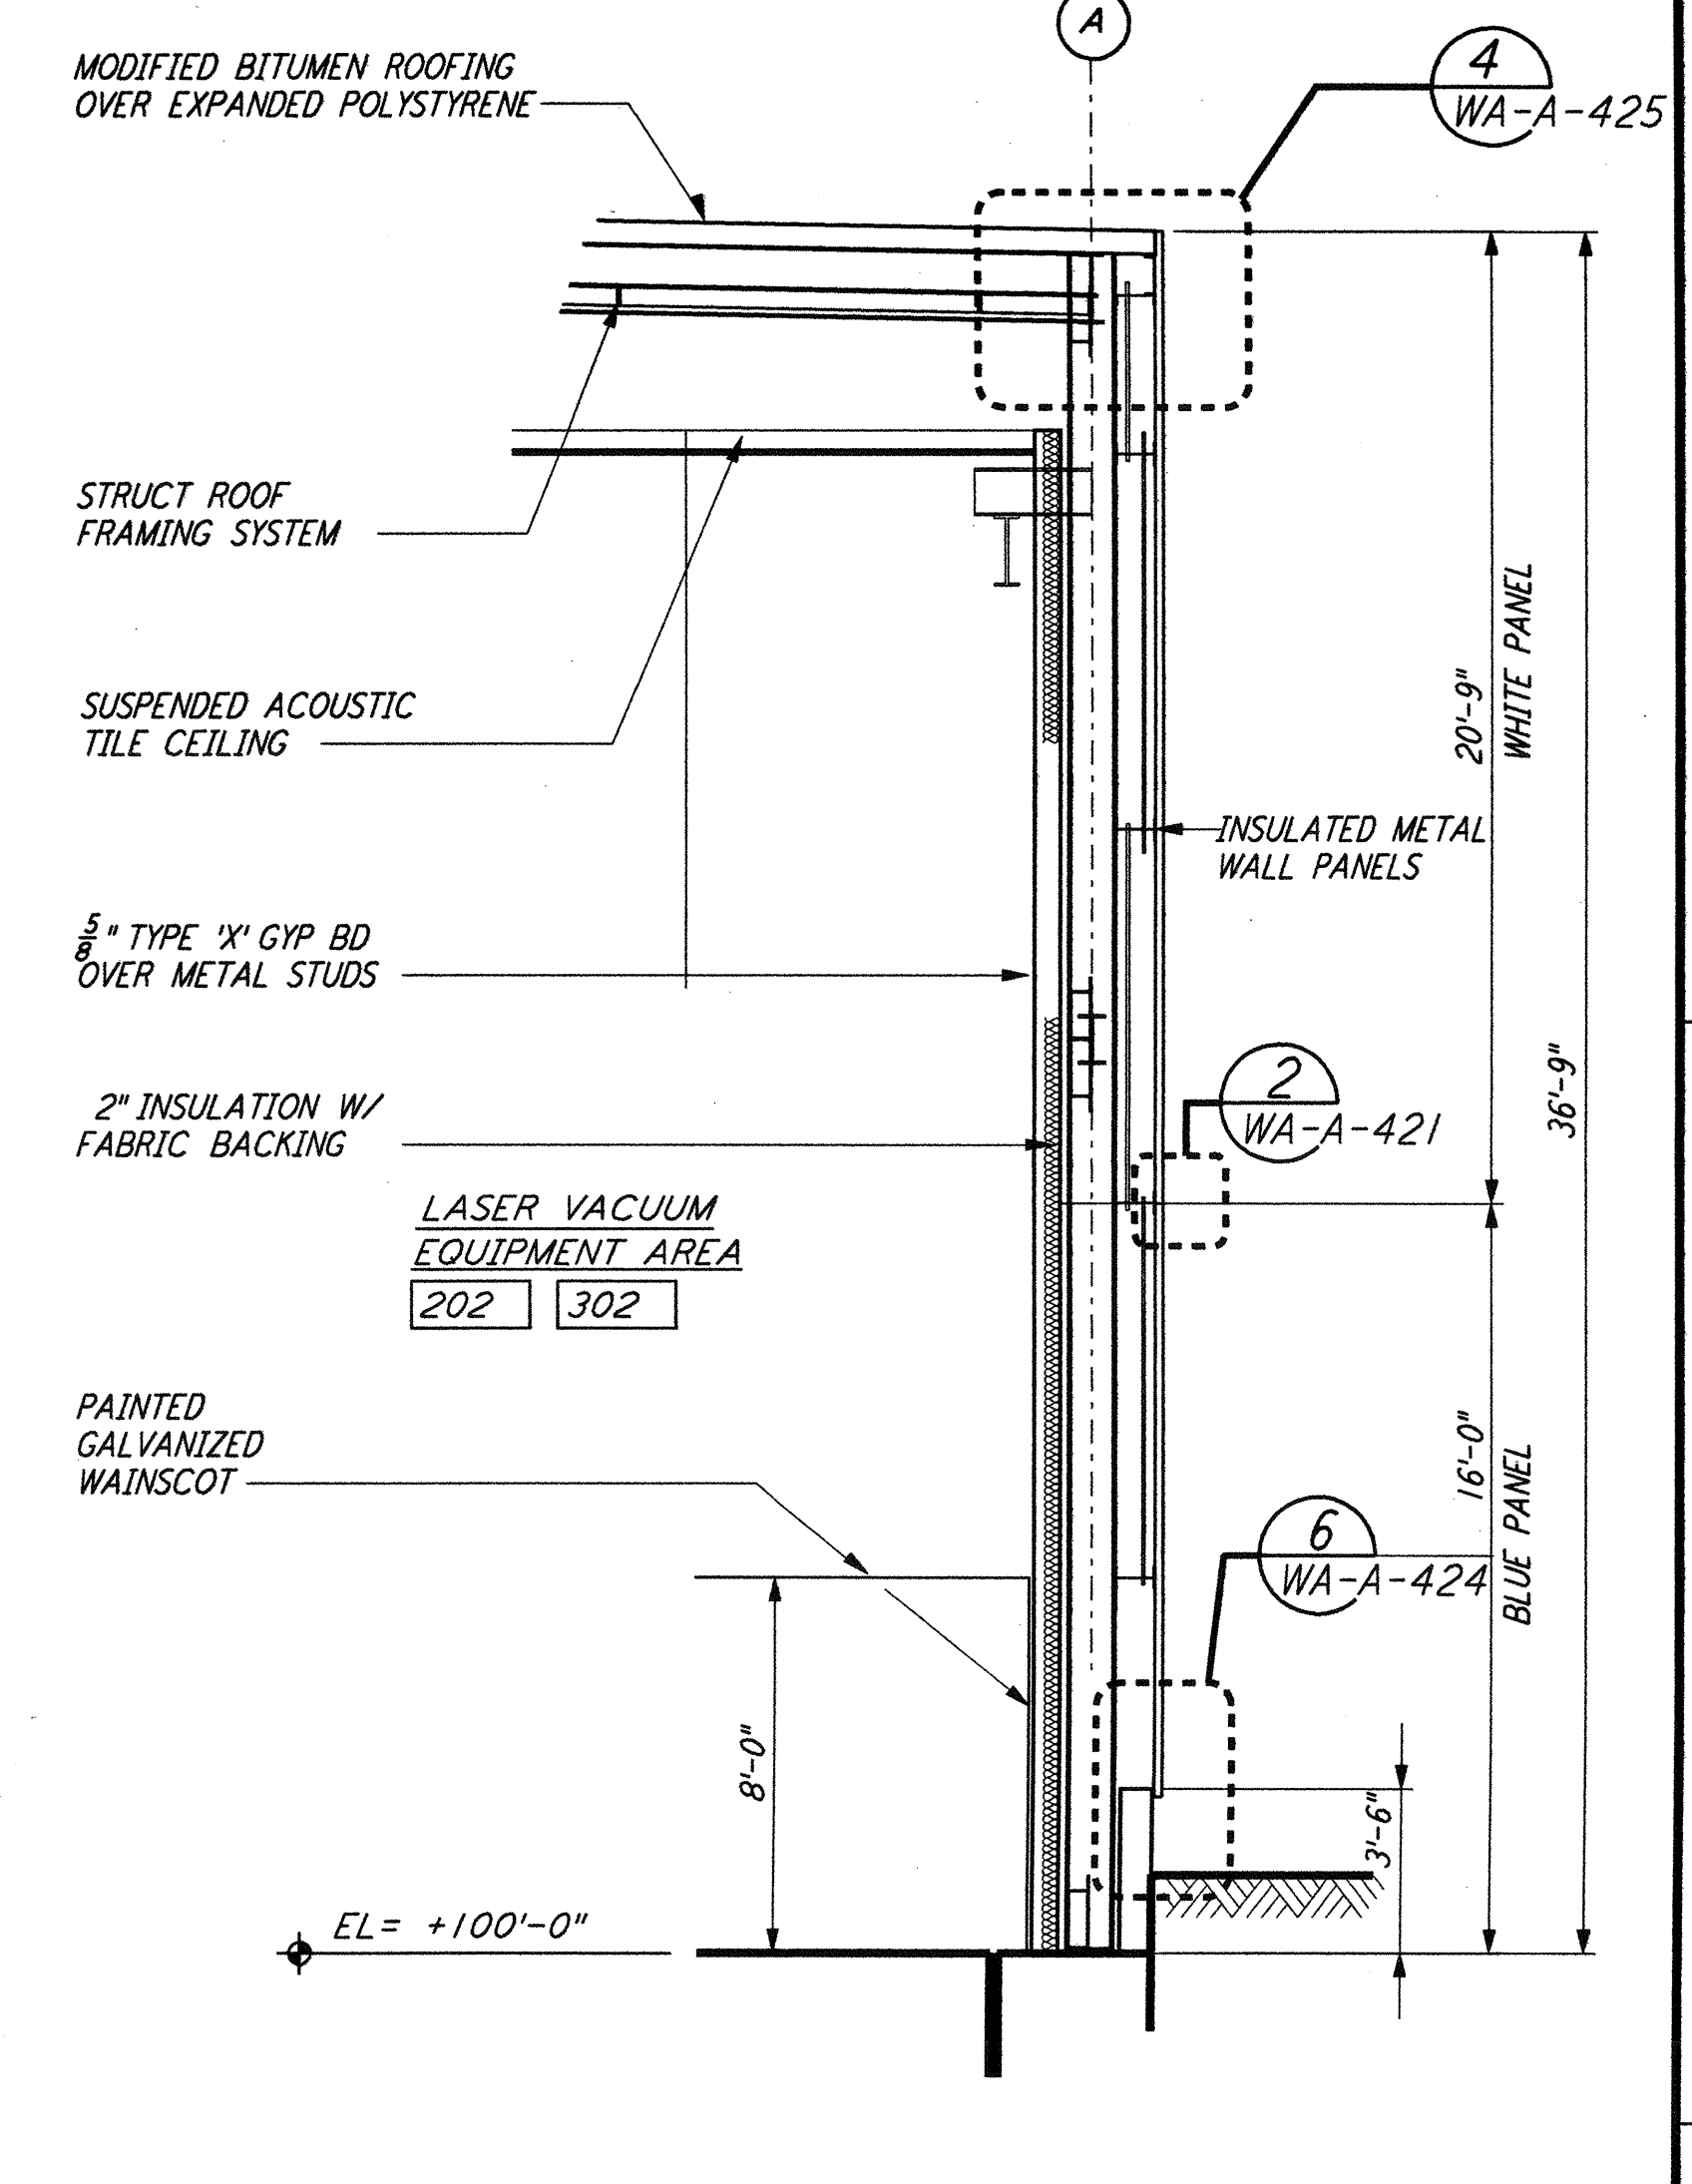


WALL SECTION
 $\frac{1}{4}" = 1'-0"$
 A REF
 WA-A-261 WA-A-251

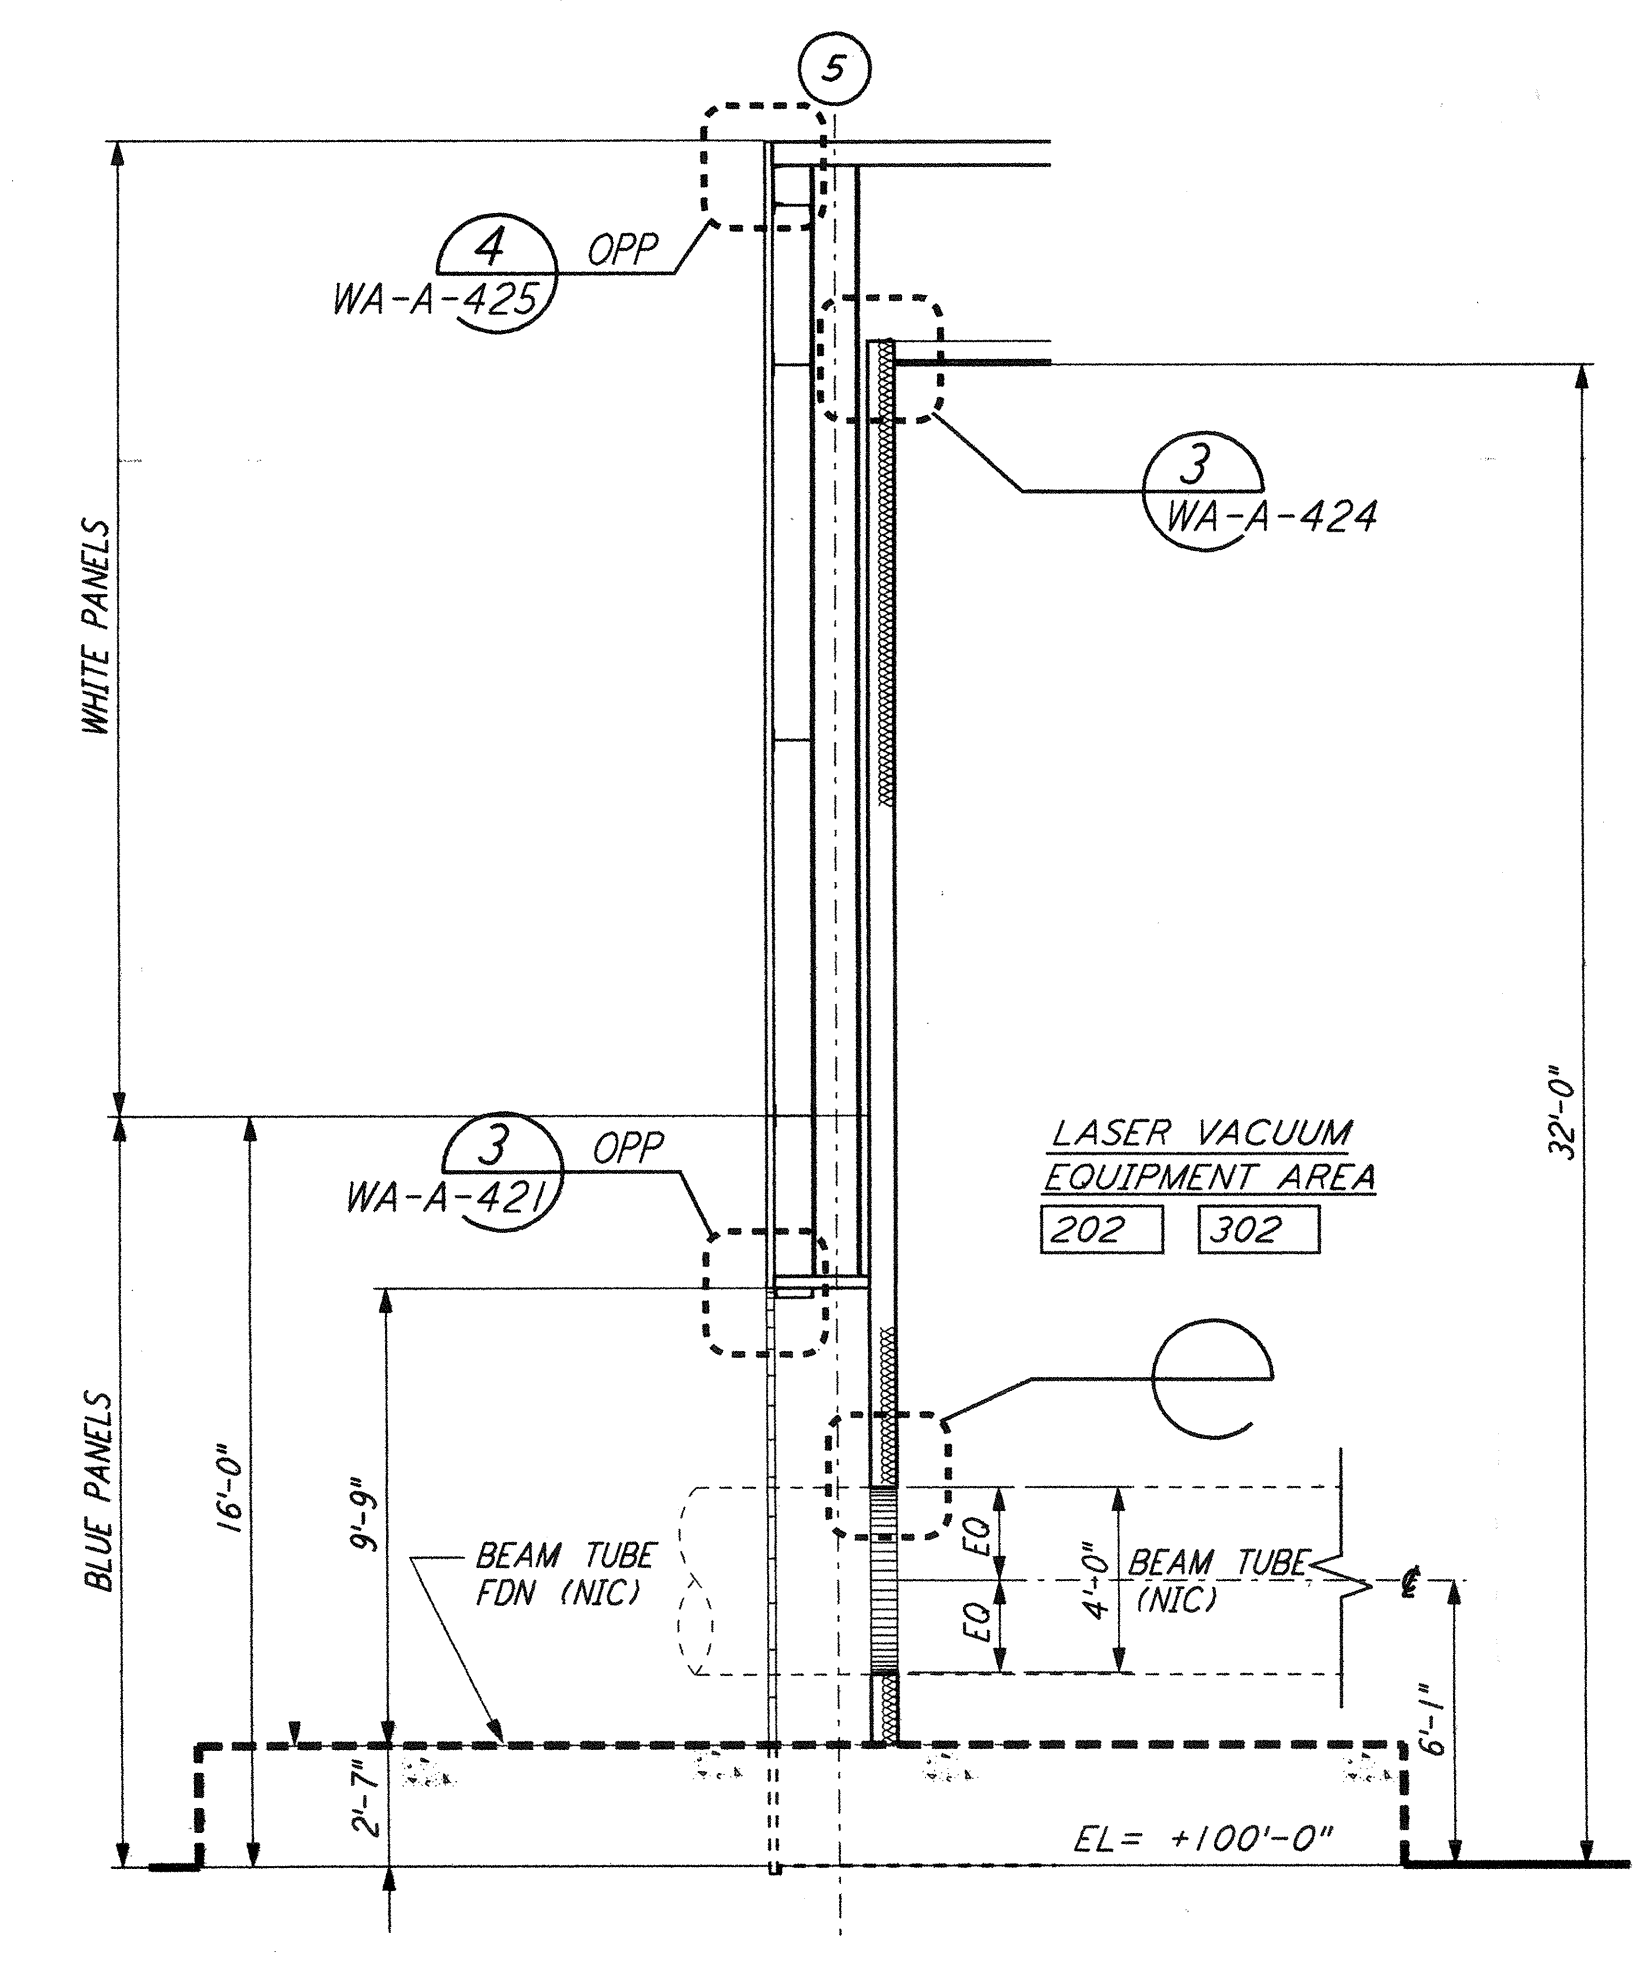


WALL SECTION
 $\frac{1}{4}" = 1'-0"$
 H REF
 WA-A-261 WA-A-201

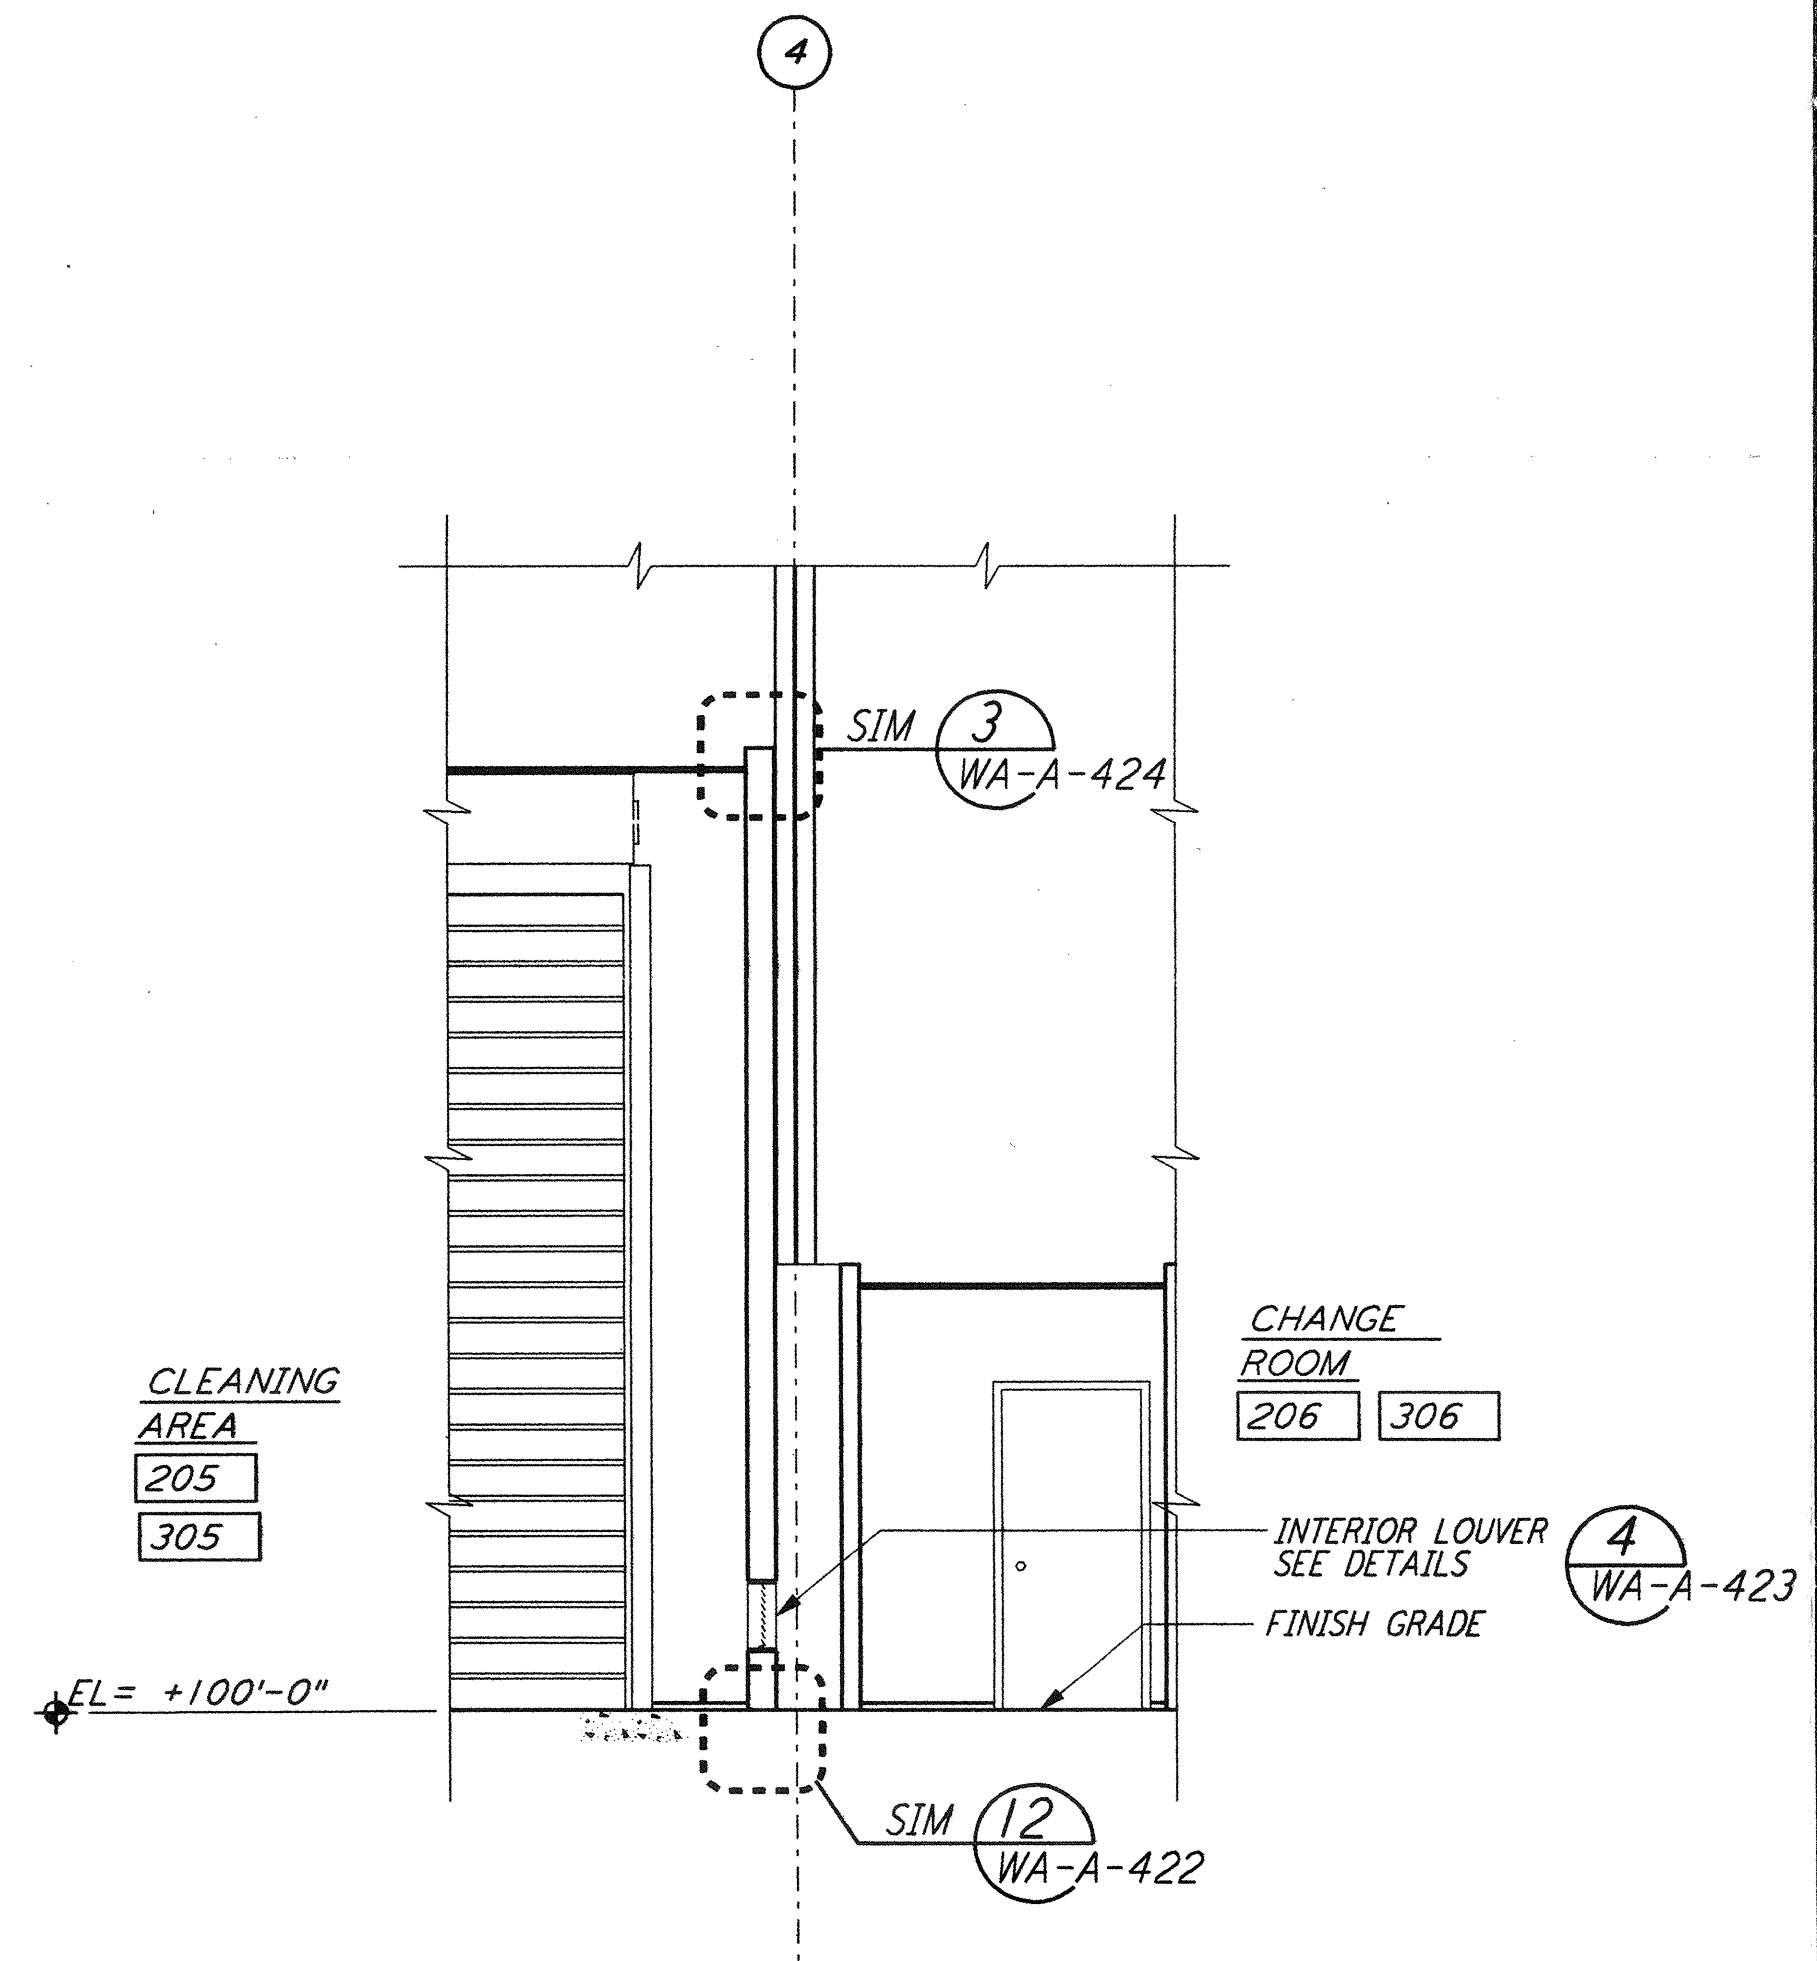

WALL SECTION
 $\frac{1}{4}" = 1'-0"$
 F REF
 WA-A-261 WA-A-251

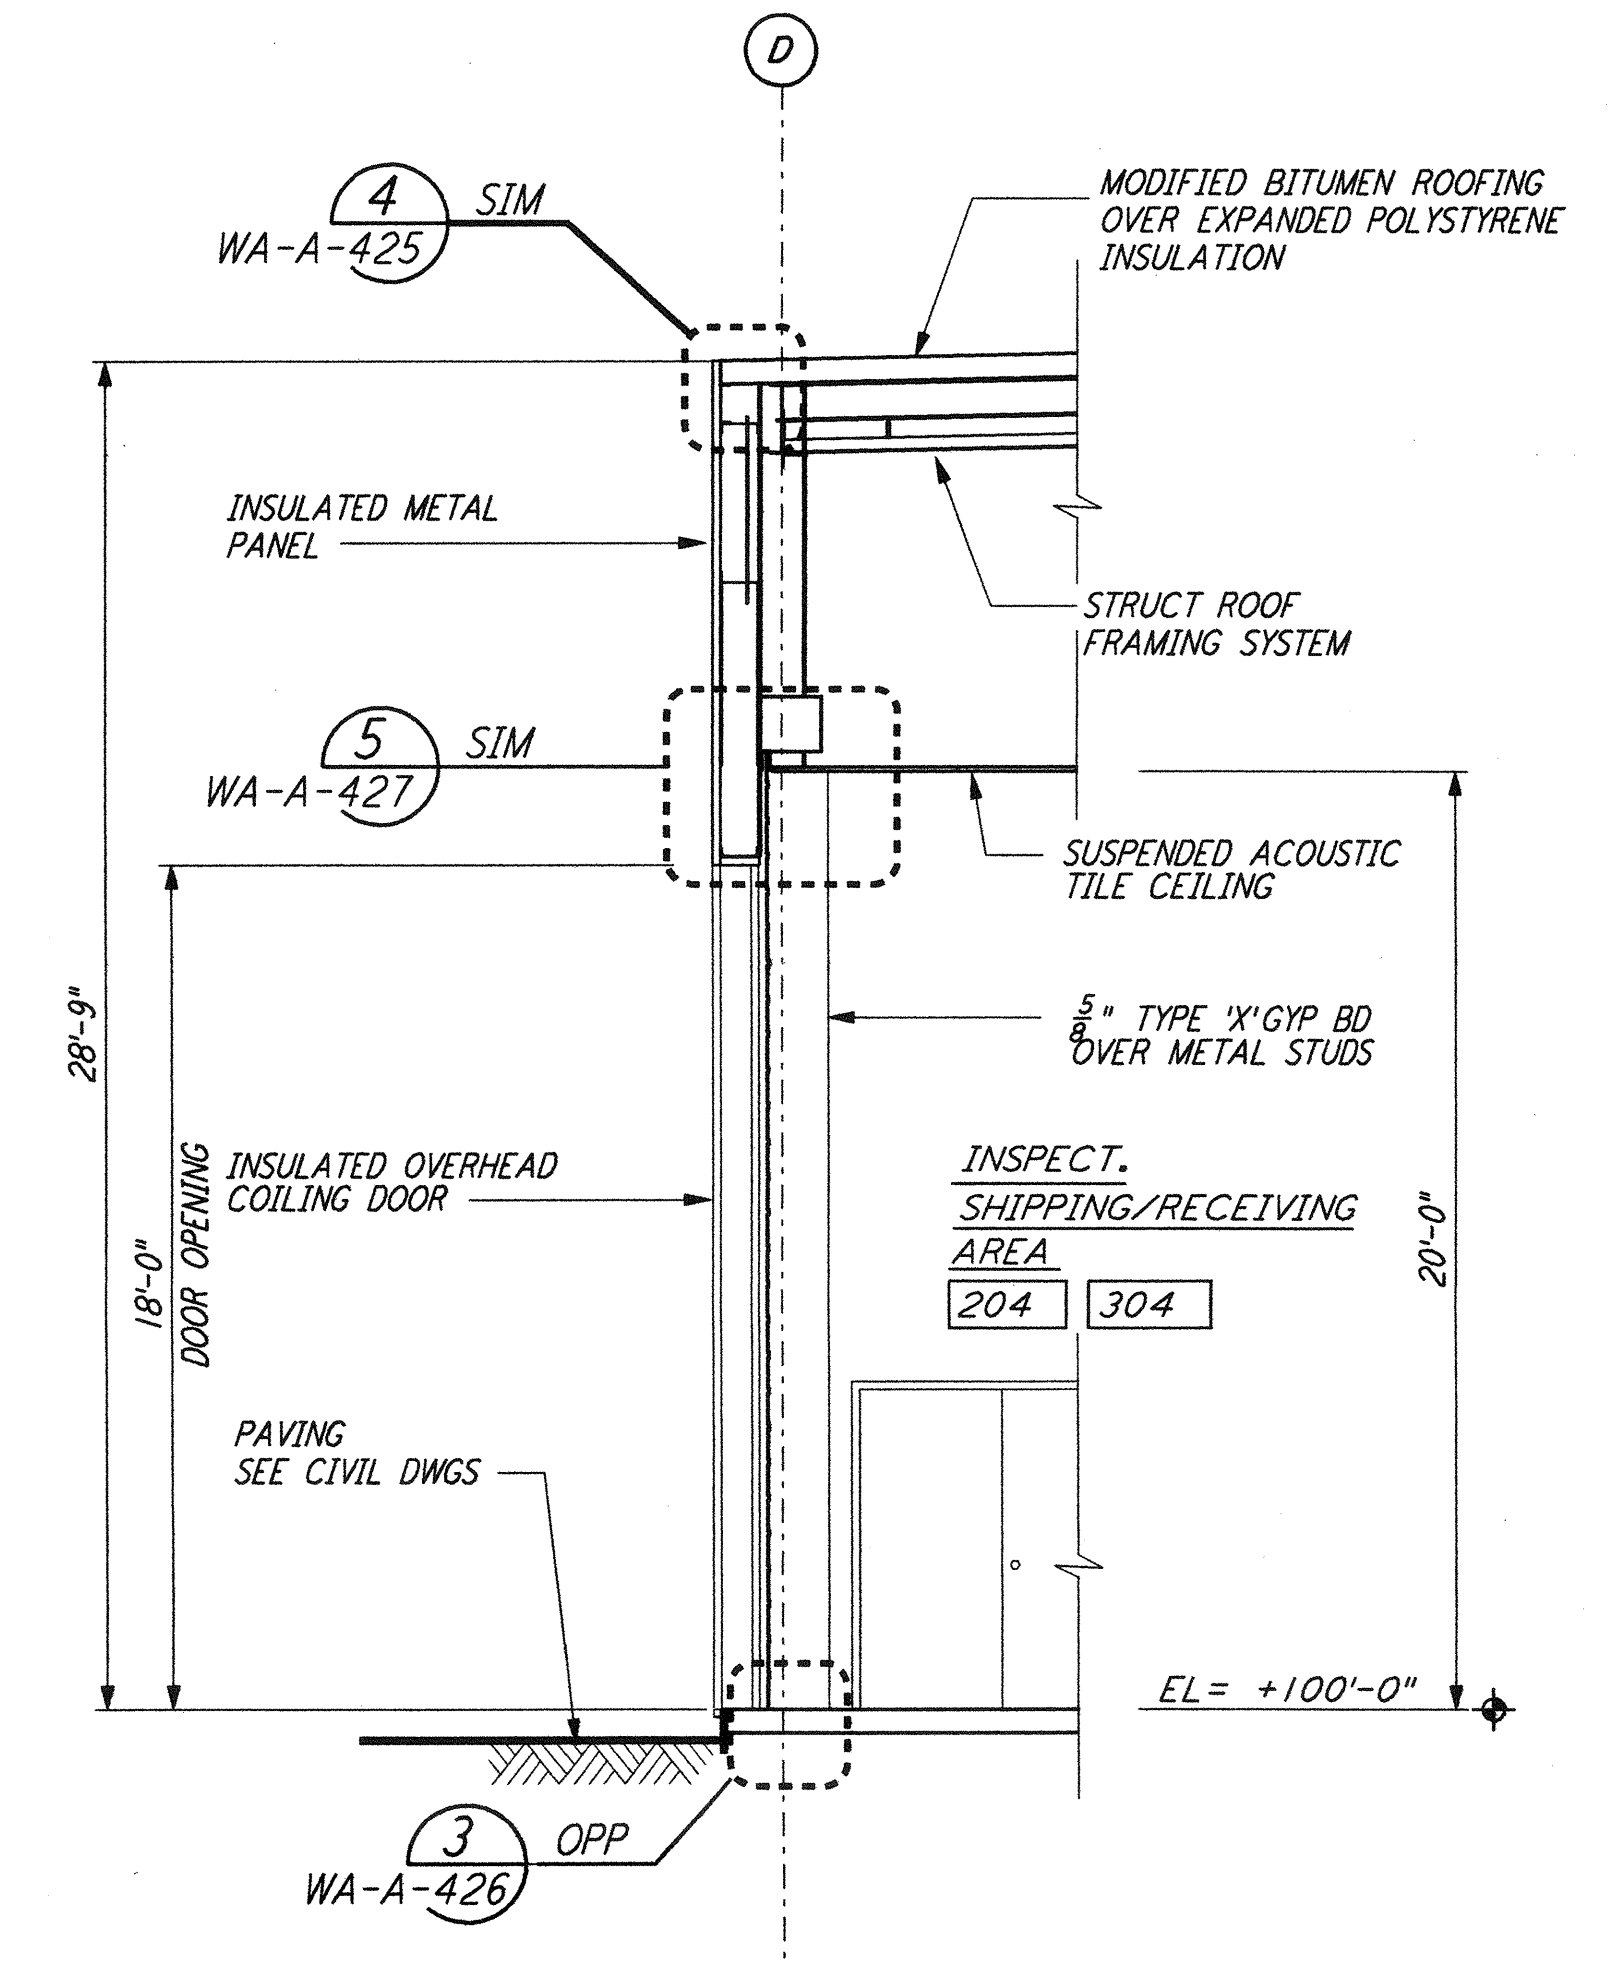

WALL SECTION
 $\frac{1}{4}" = 1'-0"$
 D REF
 WA-A-261 WA-A-251

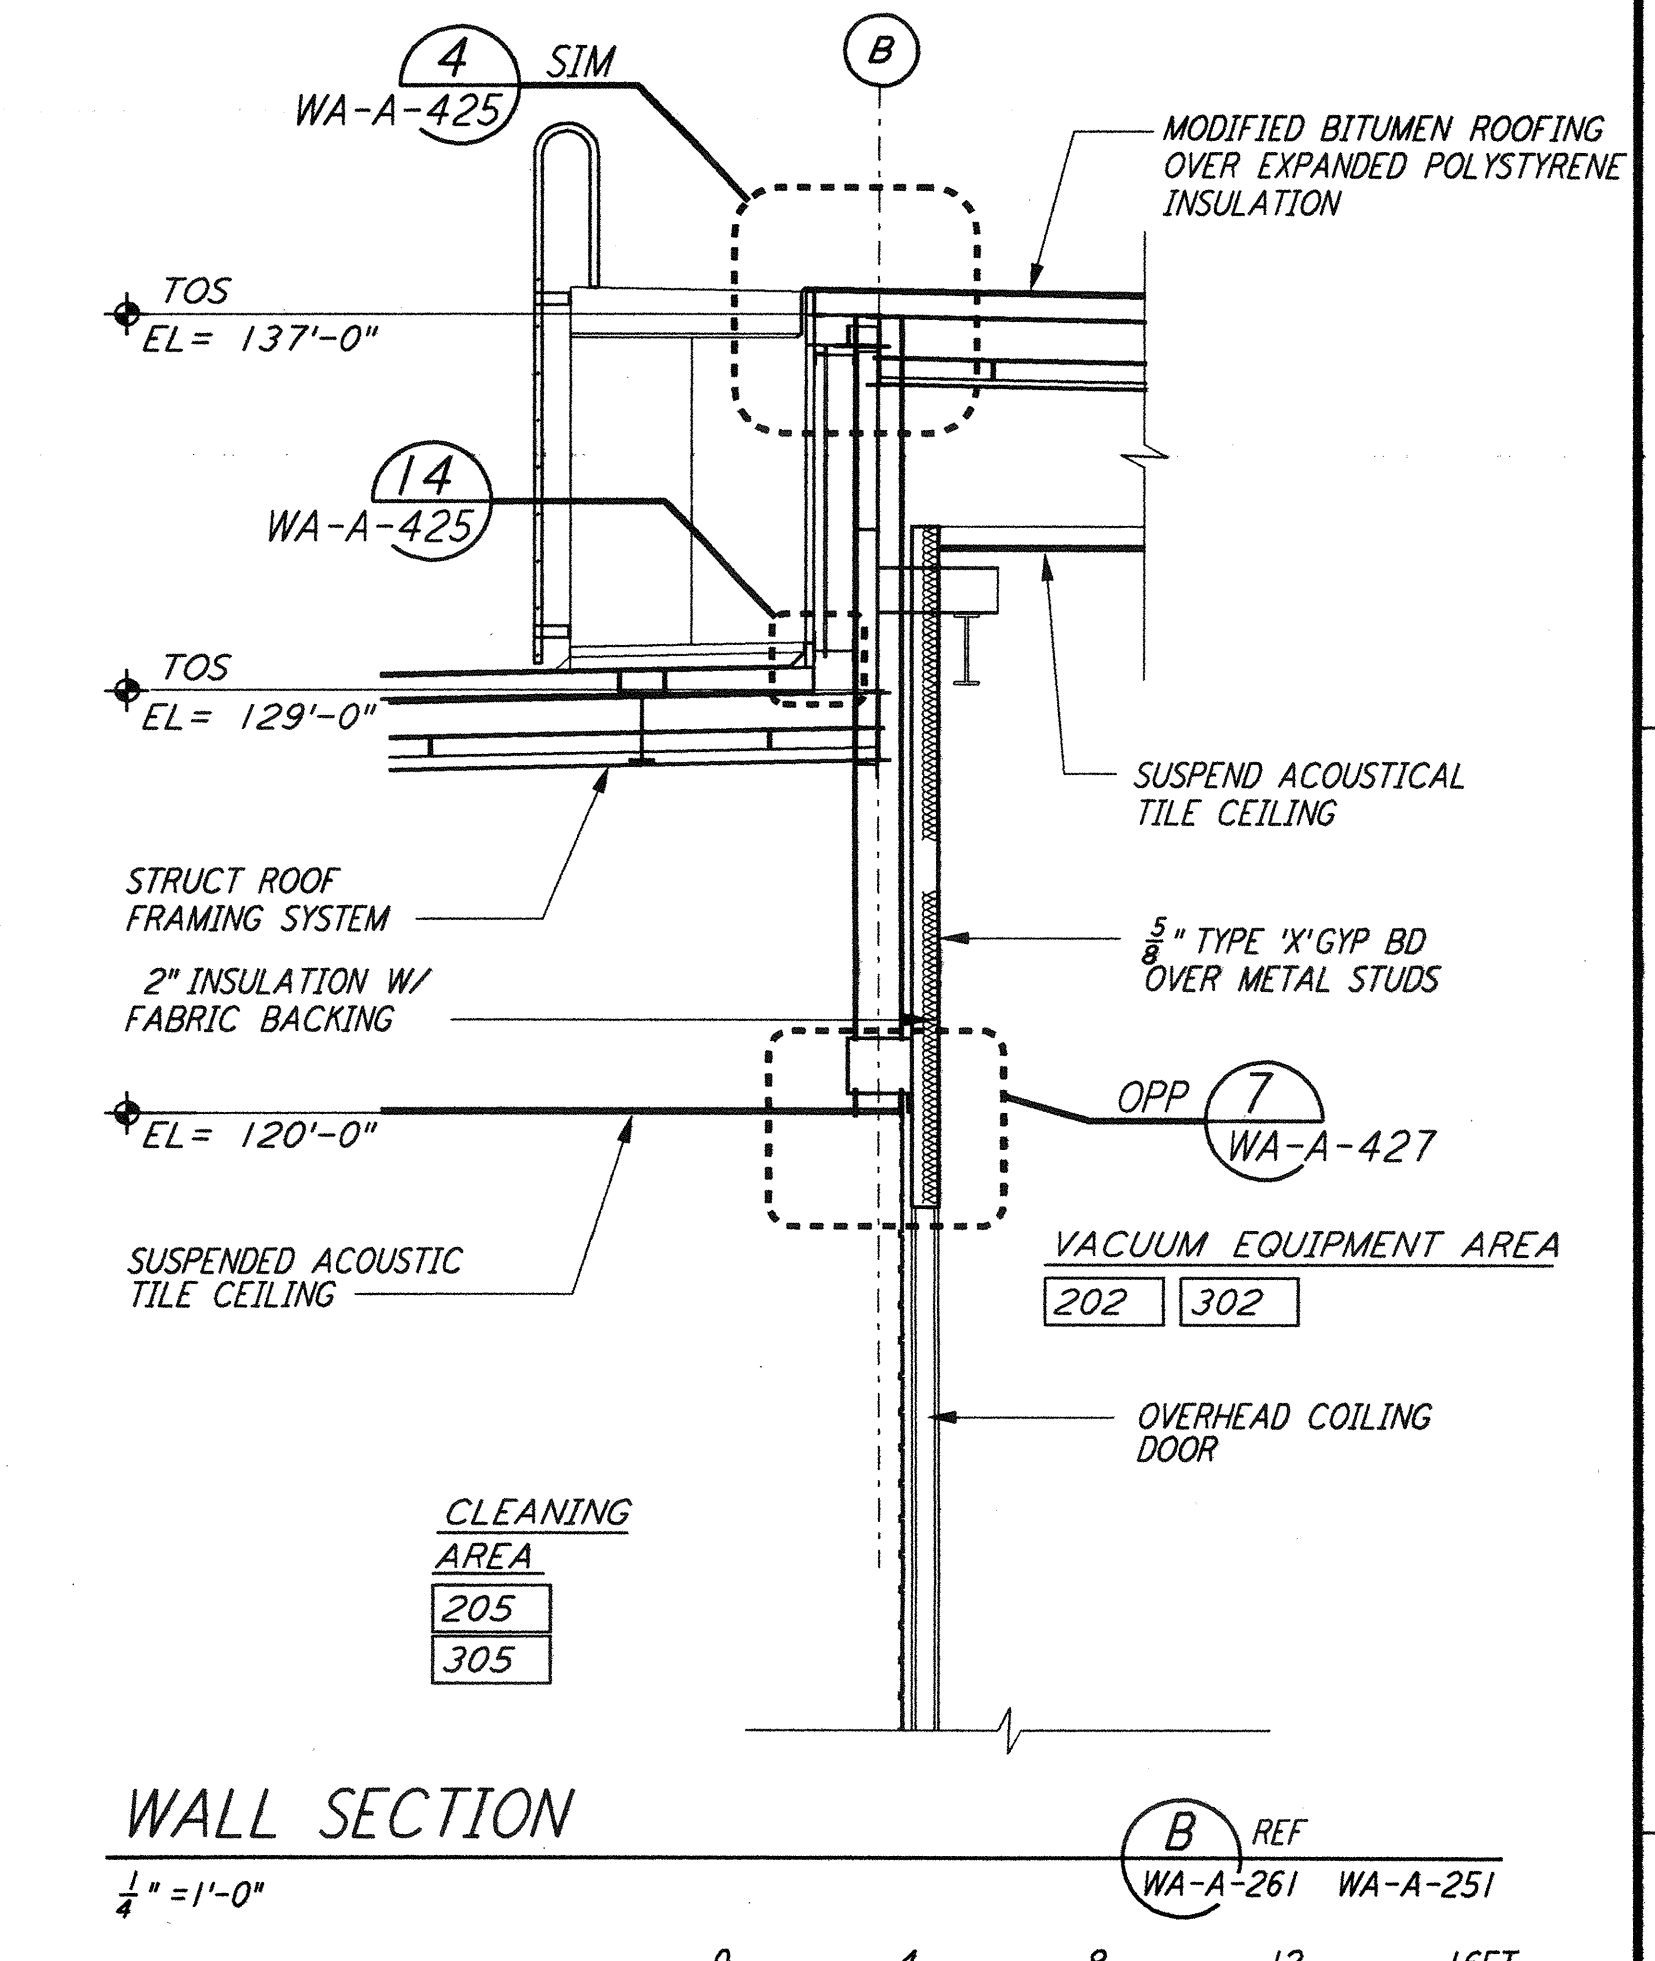

WALL SECTION
 $\frac{1}{4}" = 1'-0"$
 B REF
 WA-A-261 WA-A-251

DATUM POINT EL +100.00 = 531.11' (LVEA)
 DATUM POINT EL +100.00 = 531.11' (OSB)
 DATUM POINT EL +100.00 = 528.07' (MID NORTH)
 DATUM POINT EL +100.00 = 527.05' (END NORTH)
 DATUM POINT EL +100.00 = 532.22' (MID SOUTH WEST)
 DATUM POINT EL +100.00 = 535.26' (END SOUTH WEST)

LIGO-D960264-01-0

NO.	DATE	BY	CHKD	ENGR	PROJ	DESCRIPTION
1	5-15-98	CKT	hkl	all	PF	ISSUED FOR AS-BUILT

ISSUED FOR CONSTRUCTION	DATE
DRAWN	CKT 7-12-96
CHECKED	TB 5-26-96
ENGINEER	bkk 7-12-96
PROJ	MDW 7-12-96

AS-BUILT DRAWINGS

100 WEST WALNUT STREET
 PASADENA, CALIFORNIA

CALIFORNIA INSTITUTE OF TECHNOLOGY
 MASSACHUSETTS INSTITUTE OF TECHNOLOGY

LASER INTERFEROMETER
 GRAVITATIONAL-WAVE OBSERVATORY
 SITE NO. 1 - HANFORD, WASHINGTON

TITLE	SCALE	CONTRACT NUMBER	PROJECT NUMBER
ARCHITECTURAL MID & END STATIONS WALL SECTIONS		PP150969	8094
	SHEET NUMBER	REVISIONS	
	WA-A-261		