




This document and the design it covers are the property of PARSONS. They are loaned only with the borrower's expressed written agreement that they will not be reproduced, copied, loaned, exhibited, or used in any other way, except by written consent from PARSONS to the borrower.

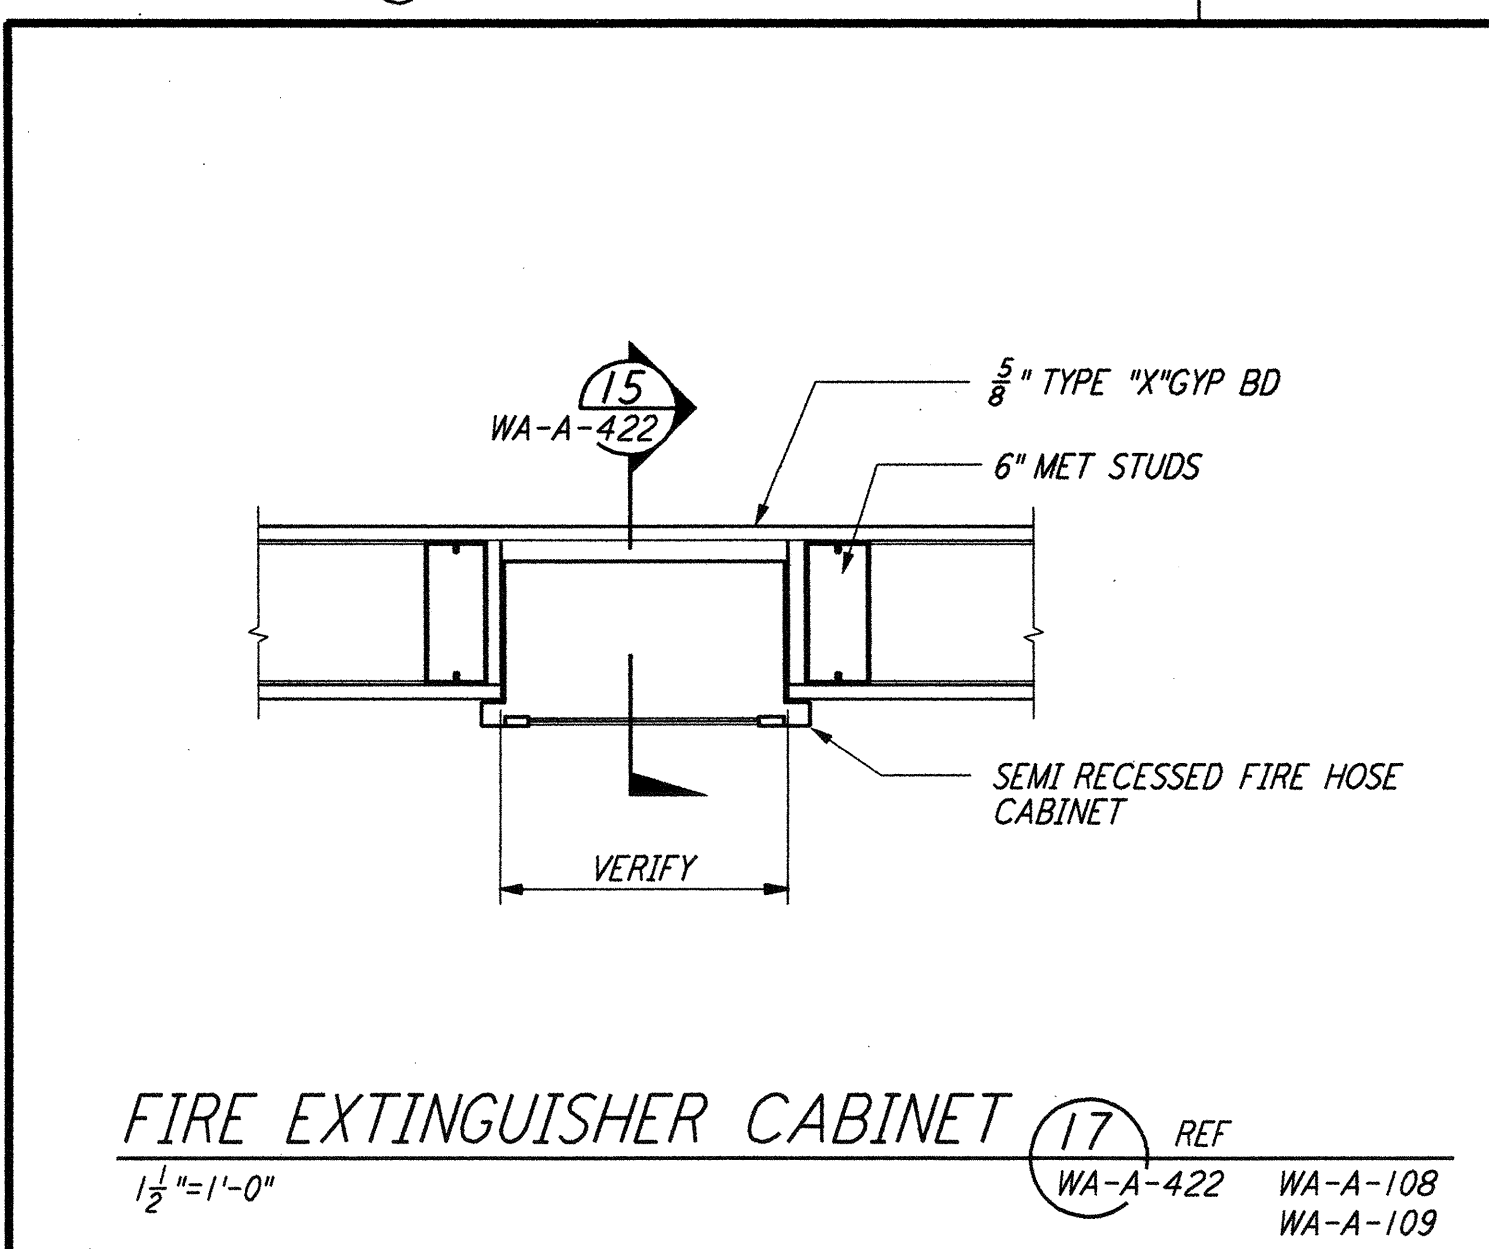


FIRE EXTINGUISHER CABINET (17) REF
 1 1/2" = 1'-0"
 WA-A-422 WA-A-108 WA-A-109

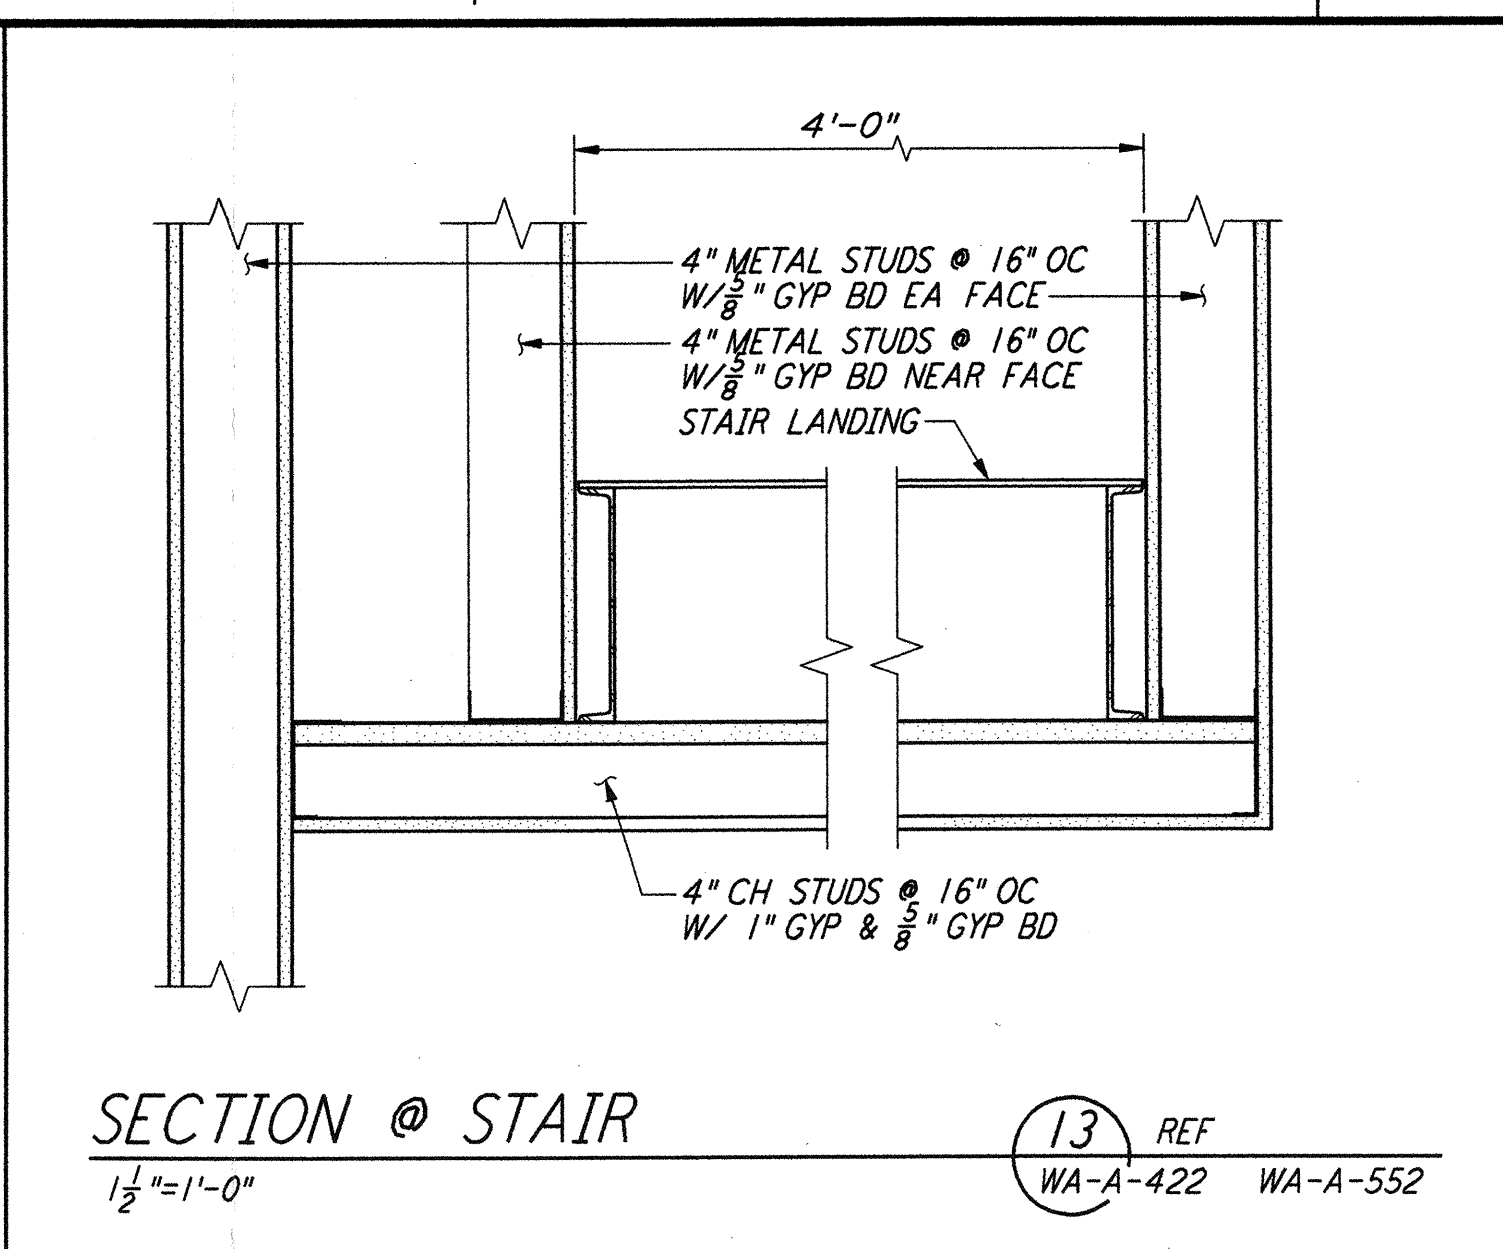


SECTION @ STAIR (13) REF
 1 1/2" = 1'-0"
 WA-A-422 WA-A-552

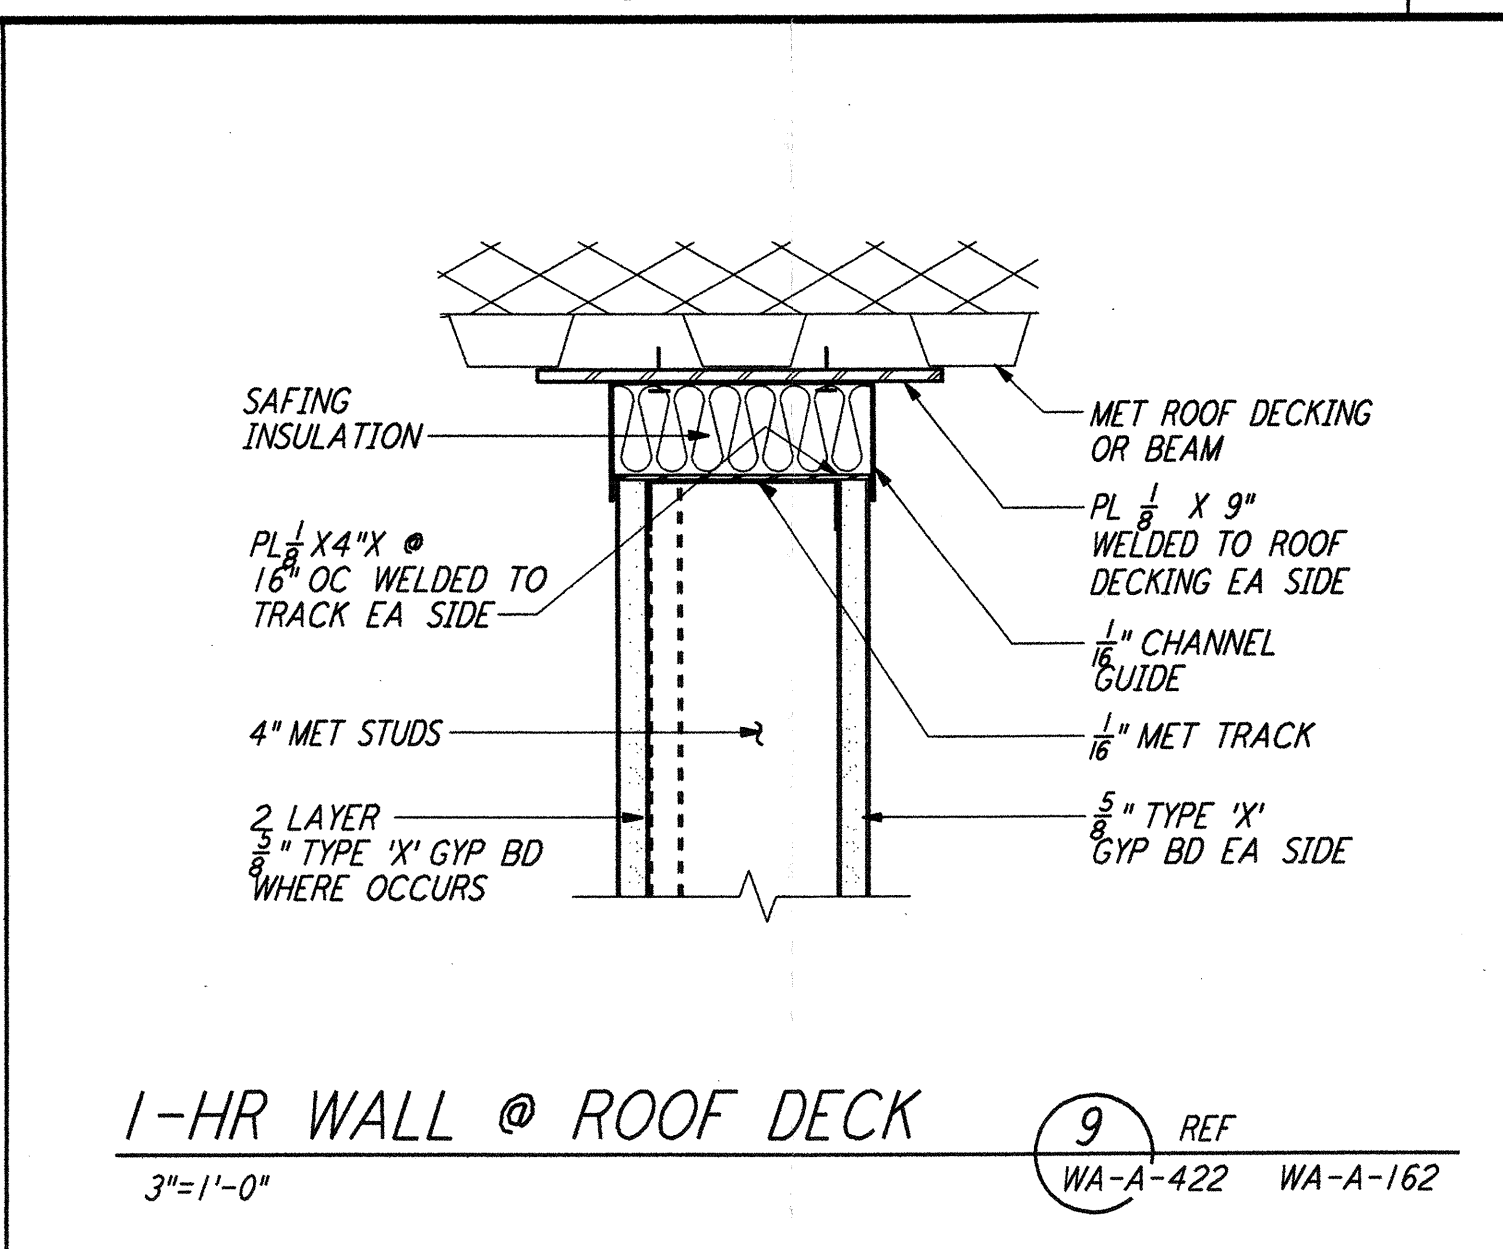


1-HR WALL @ ROOF DECK (9) REF
 3" = 1'-0"
 WA-A-422 WA-A-162

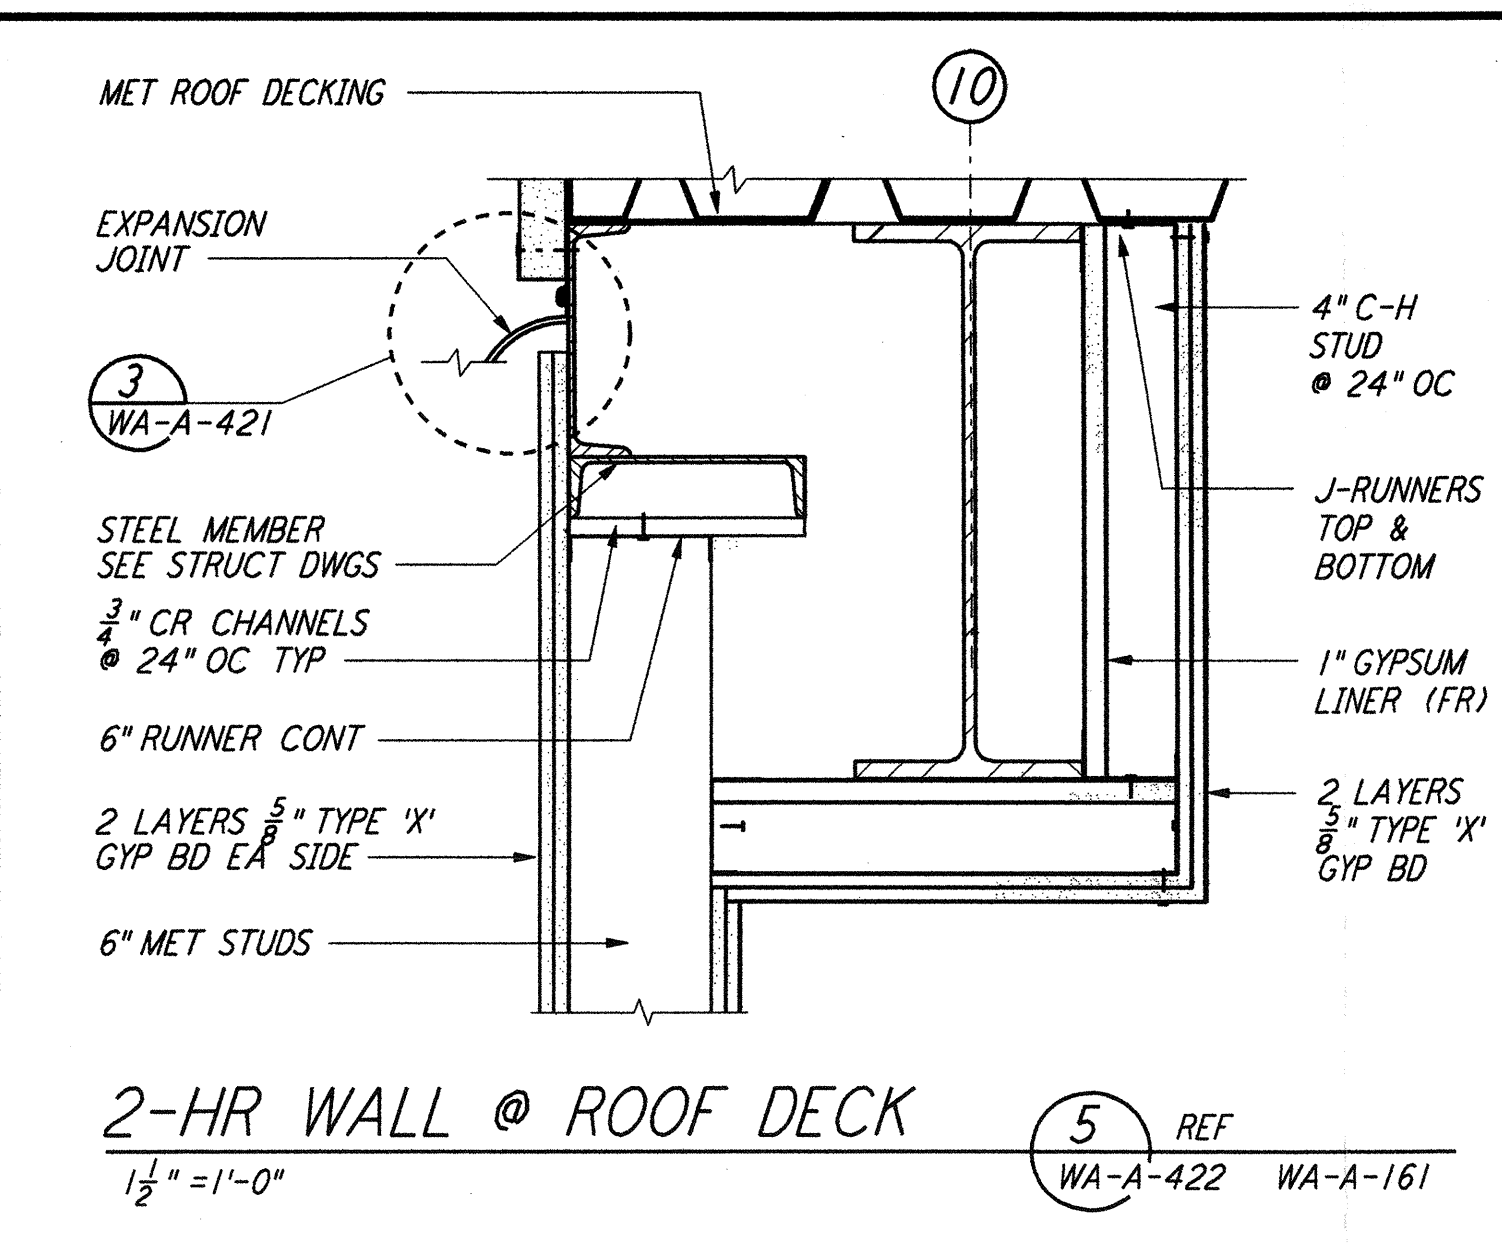


2-HR WALL @ ROOF DECK (5) REF
 1 1/2" = 1'-0"
 WA-A-422 WA-A-161

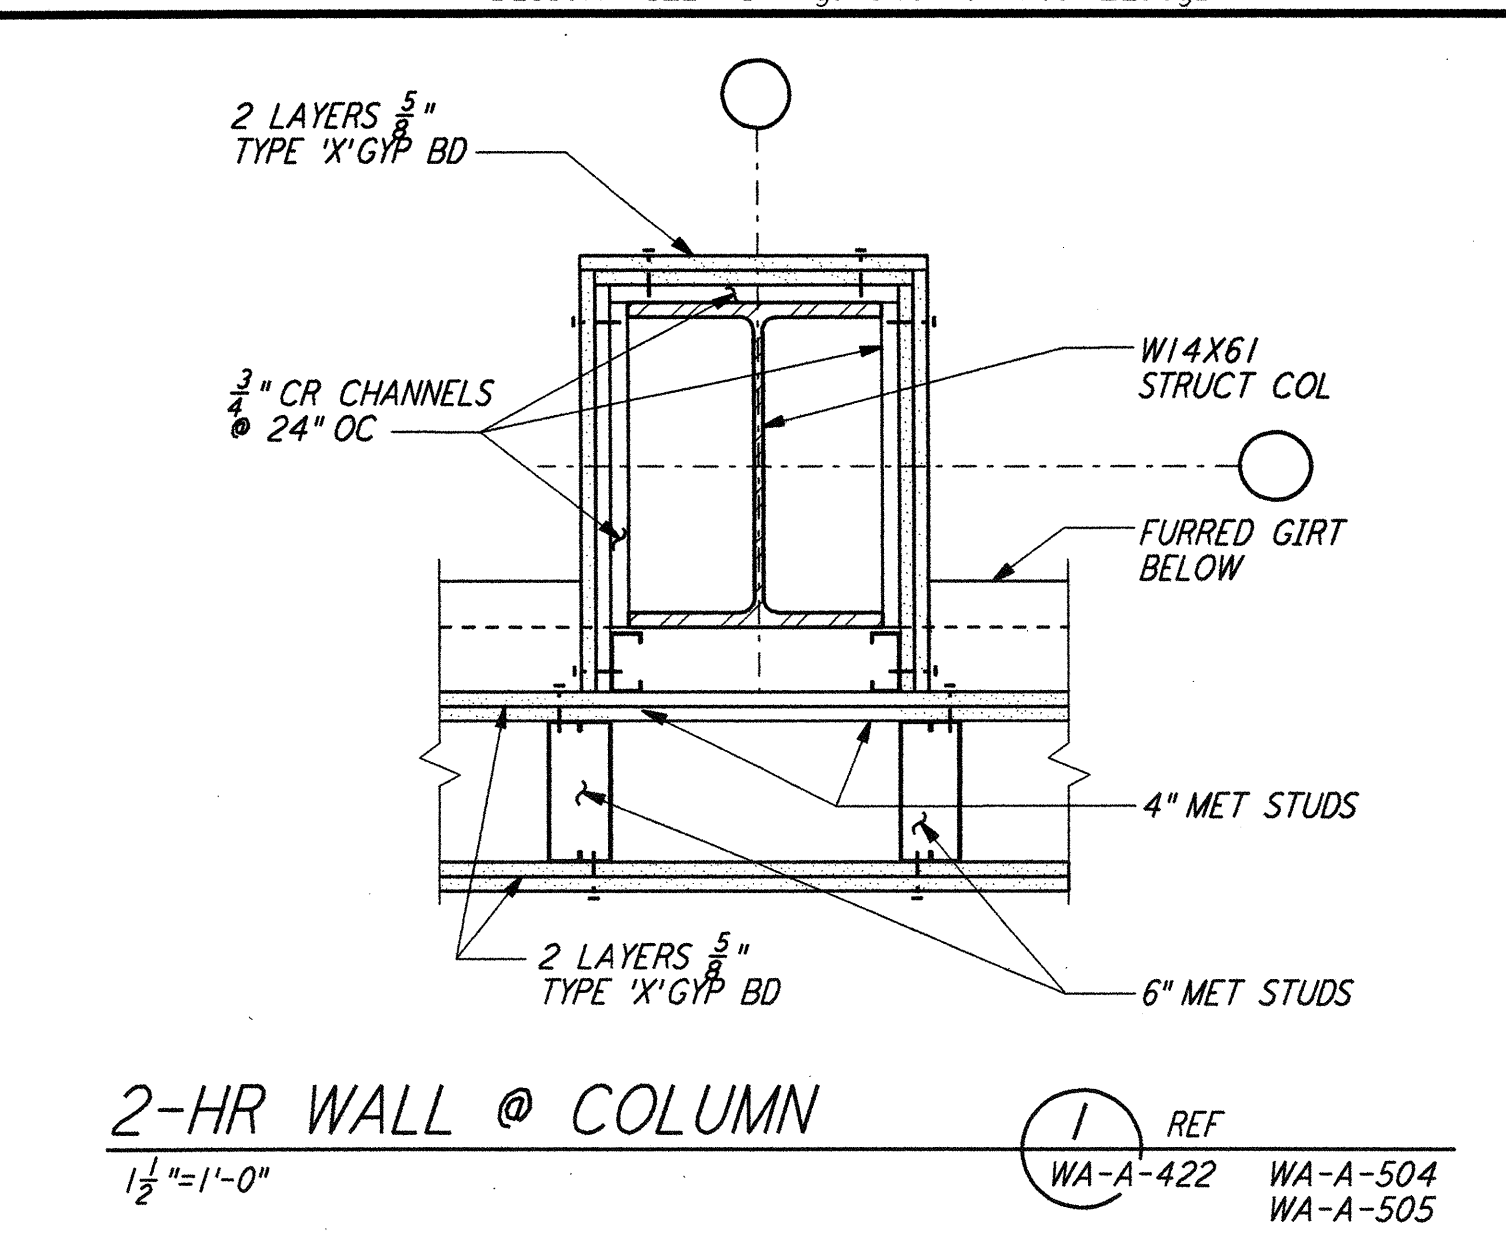


2-HR WALL @ COLUMN (1) REF
 1 1/2" = 1'-0"
 WA-A-422 WA-A-504 WA-A-505

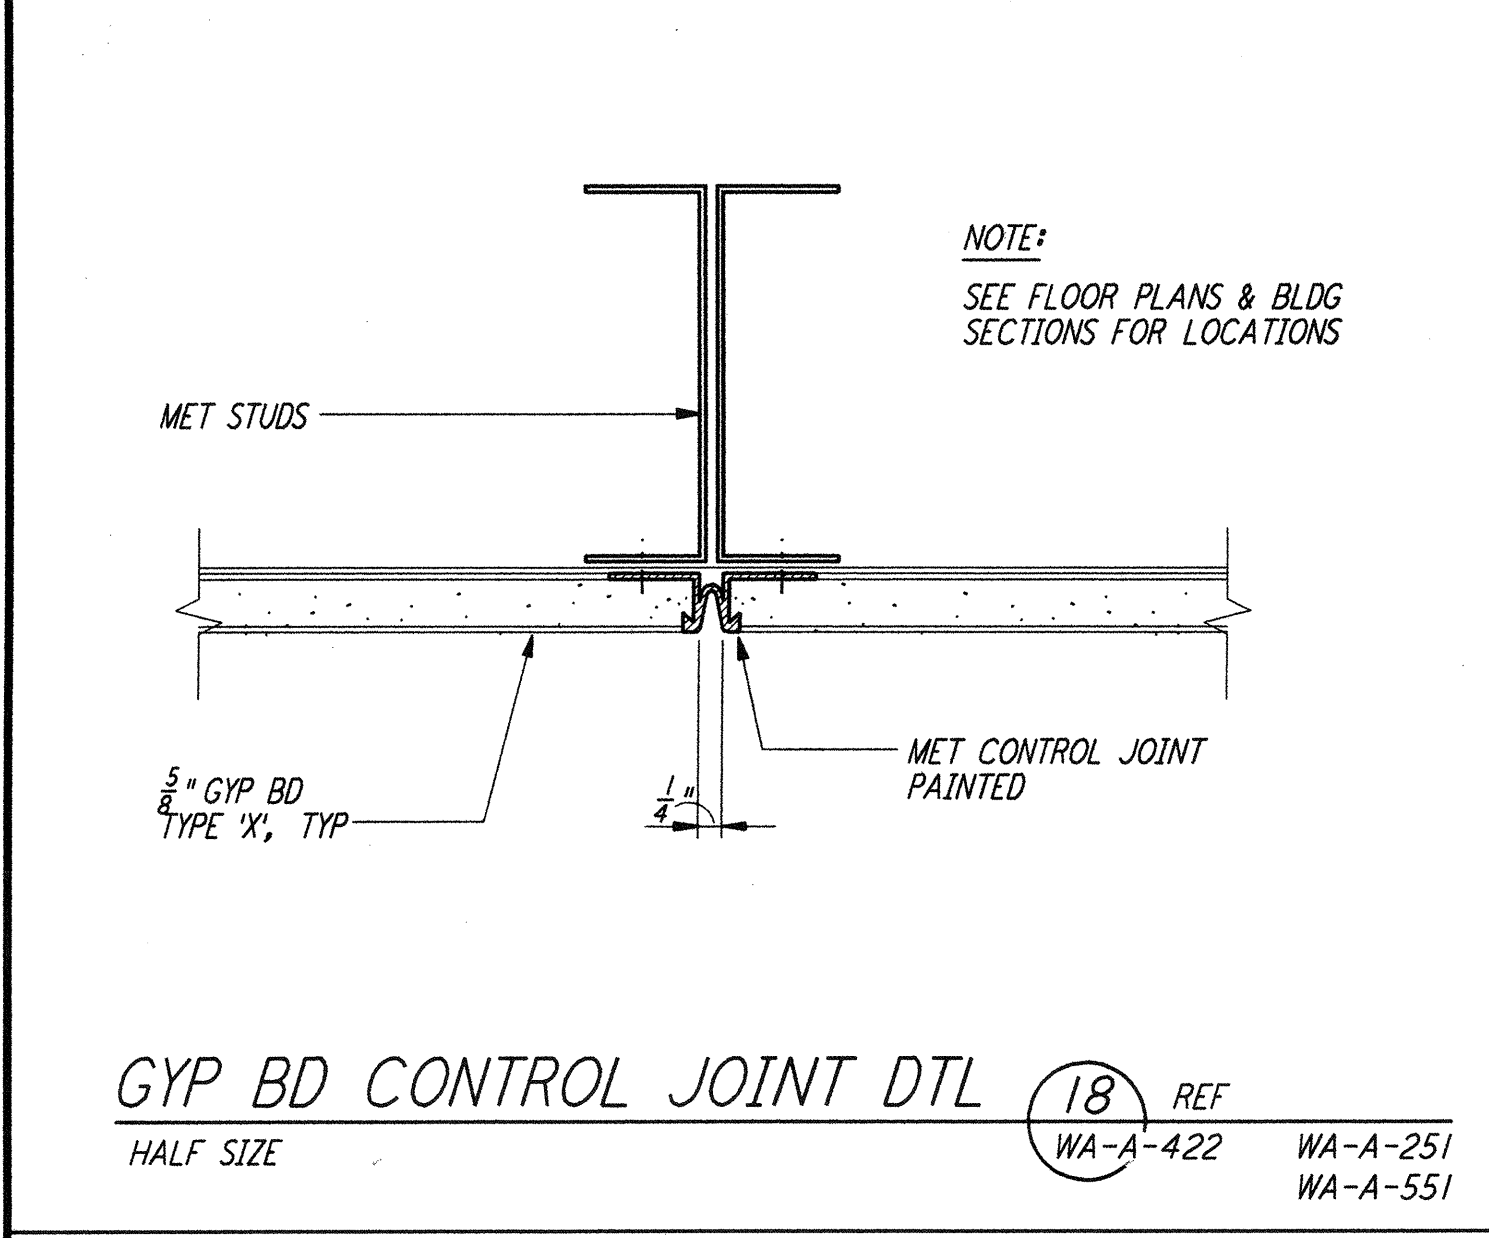


GYP BD CONTROL JOINT DTL (18) REF
 HALF SIZE
 WA-A-422 WA-A-251 WA-A-551

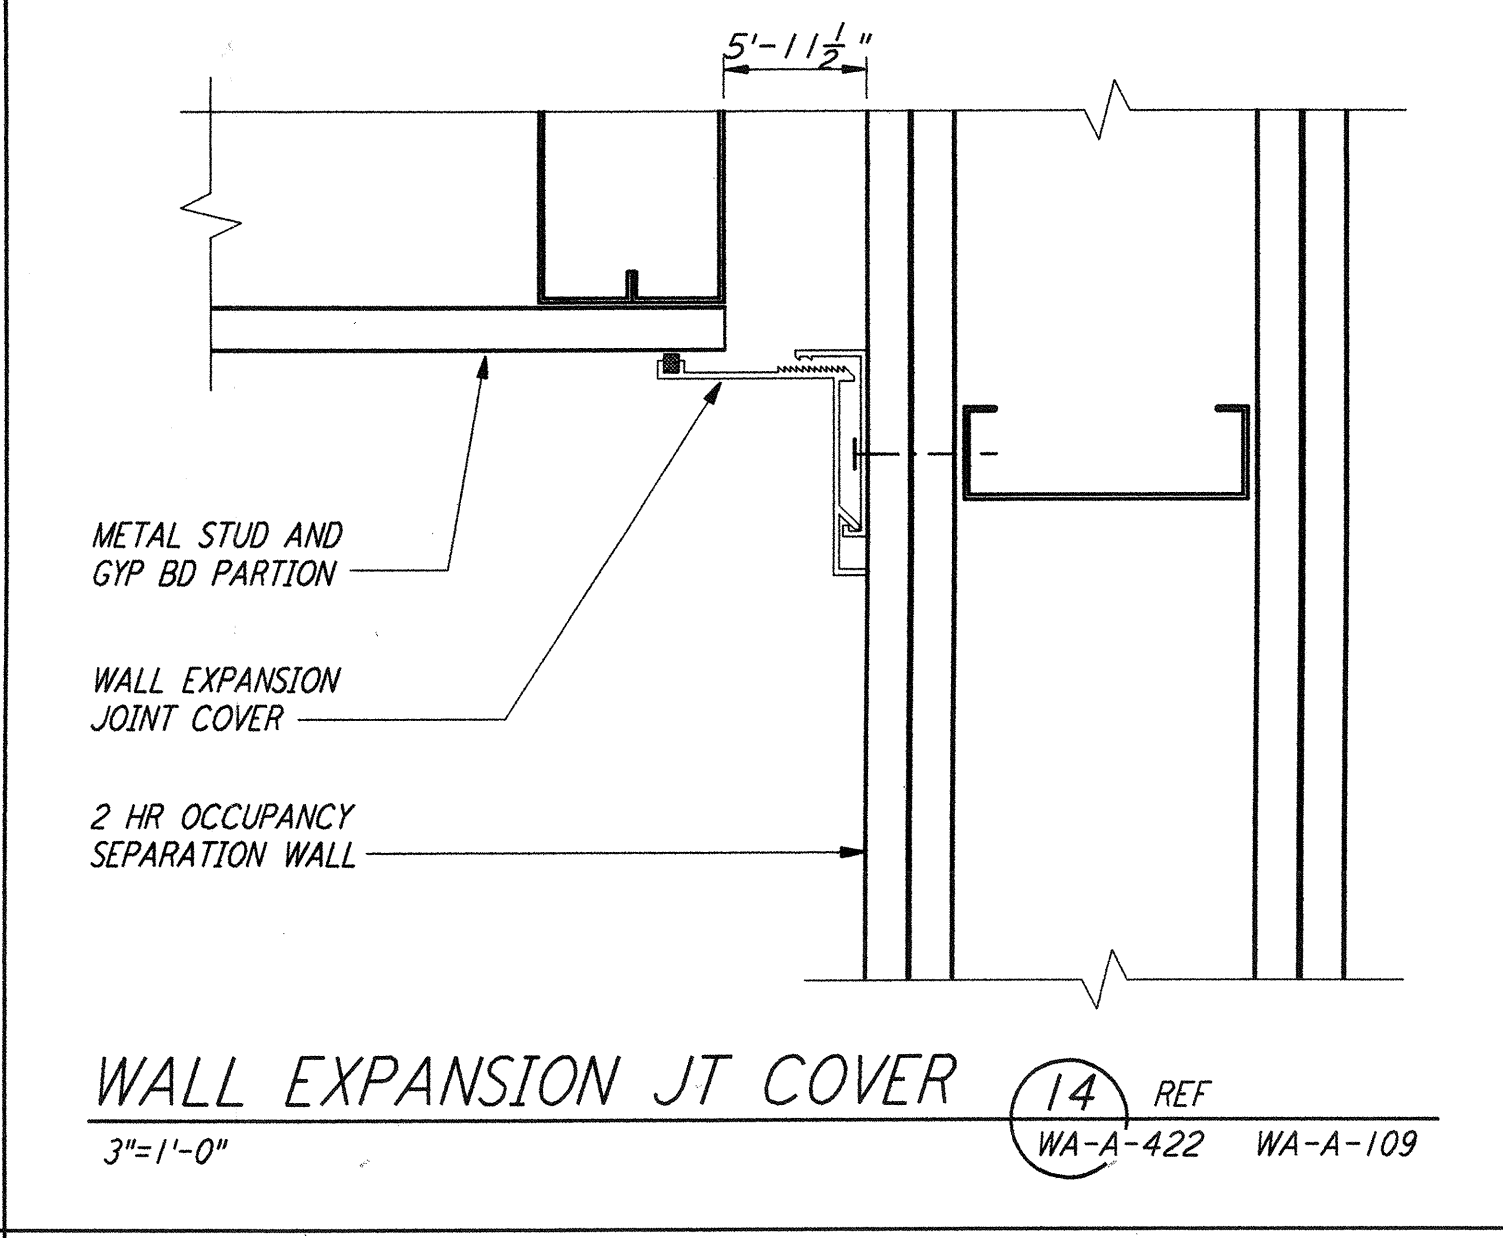


WALL EXPANSION JT COVER (14) REF
 3" = 1'-0"
 WA-A-422 WA-A-109

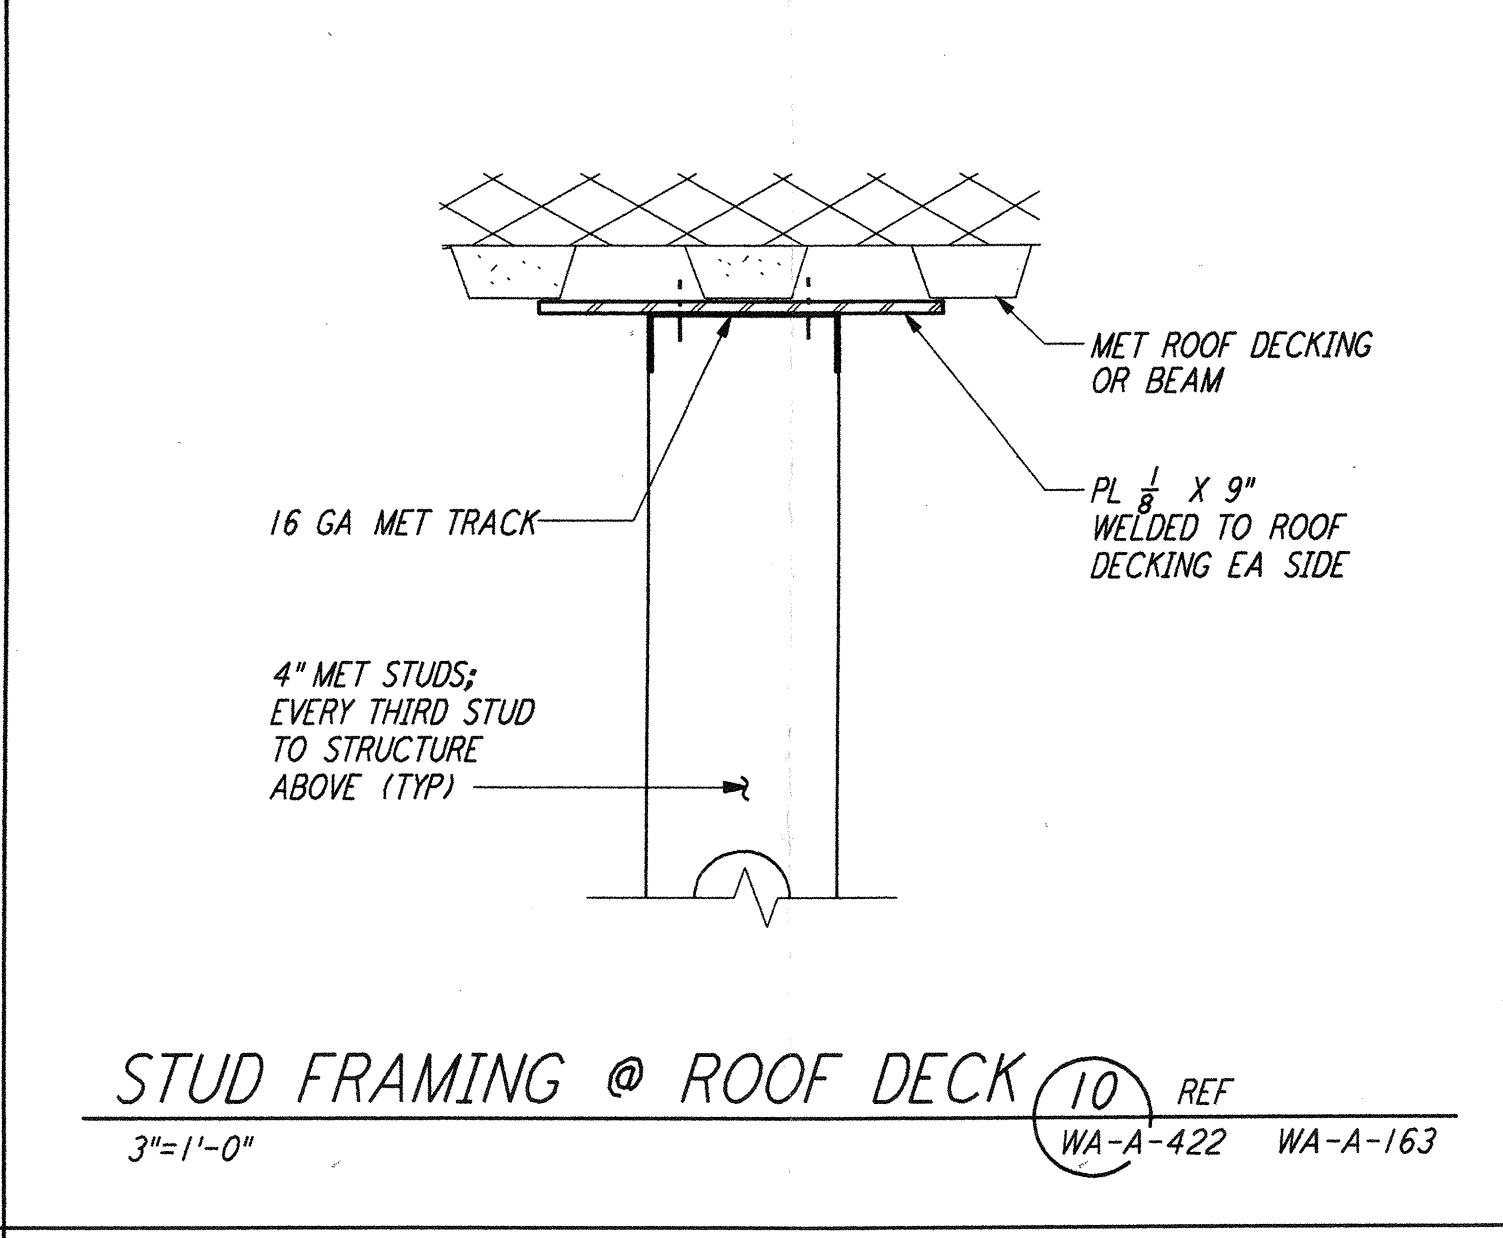


STUD FRAMING @ ROOF DECK (10) REF
 3" = 1'-0"
 WA-A-422 WA-A-163

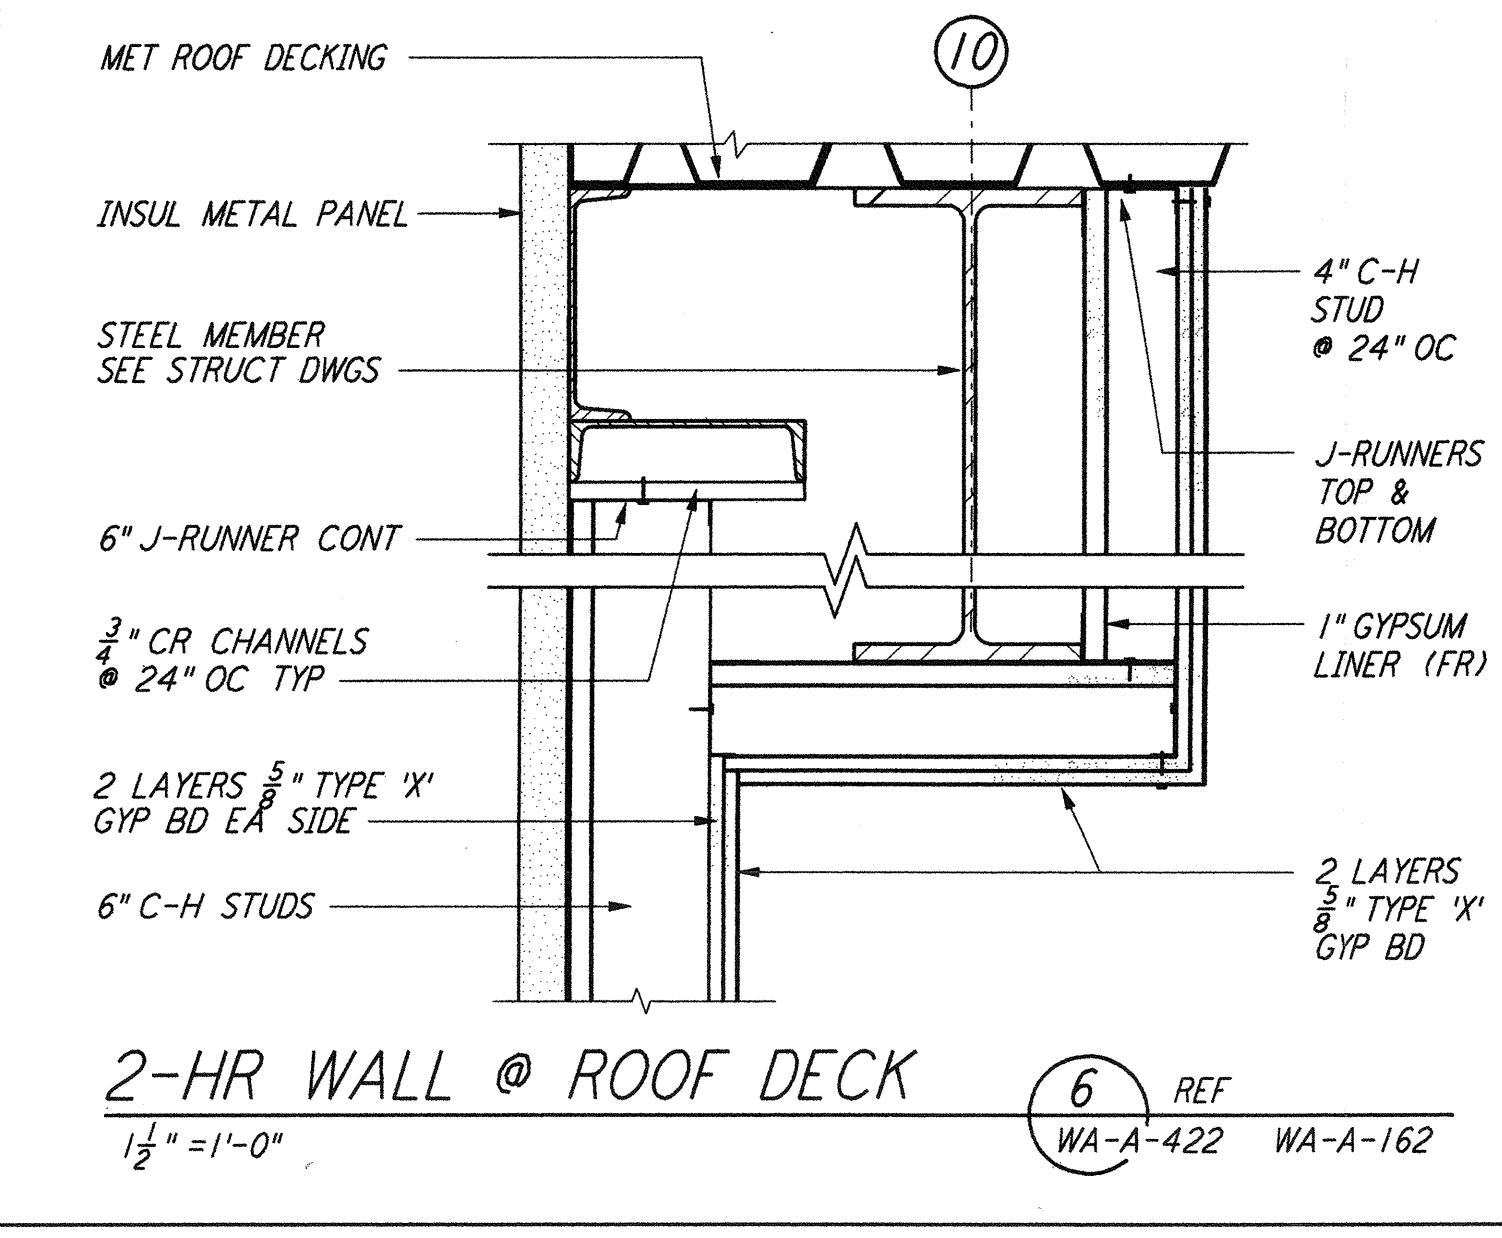


2-HR WALL @ ROOF DECK (6) REF
 1 1/2" = 1'-0"
 WA-A-422 WA-A-162

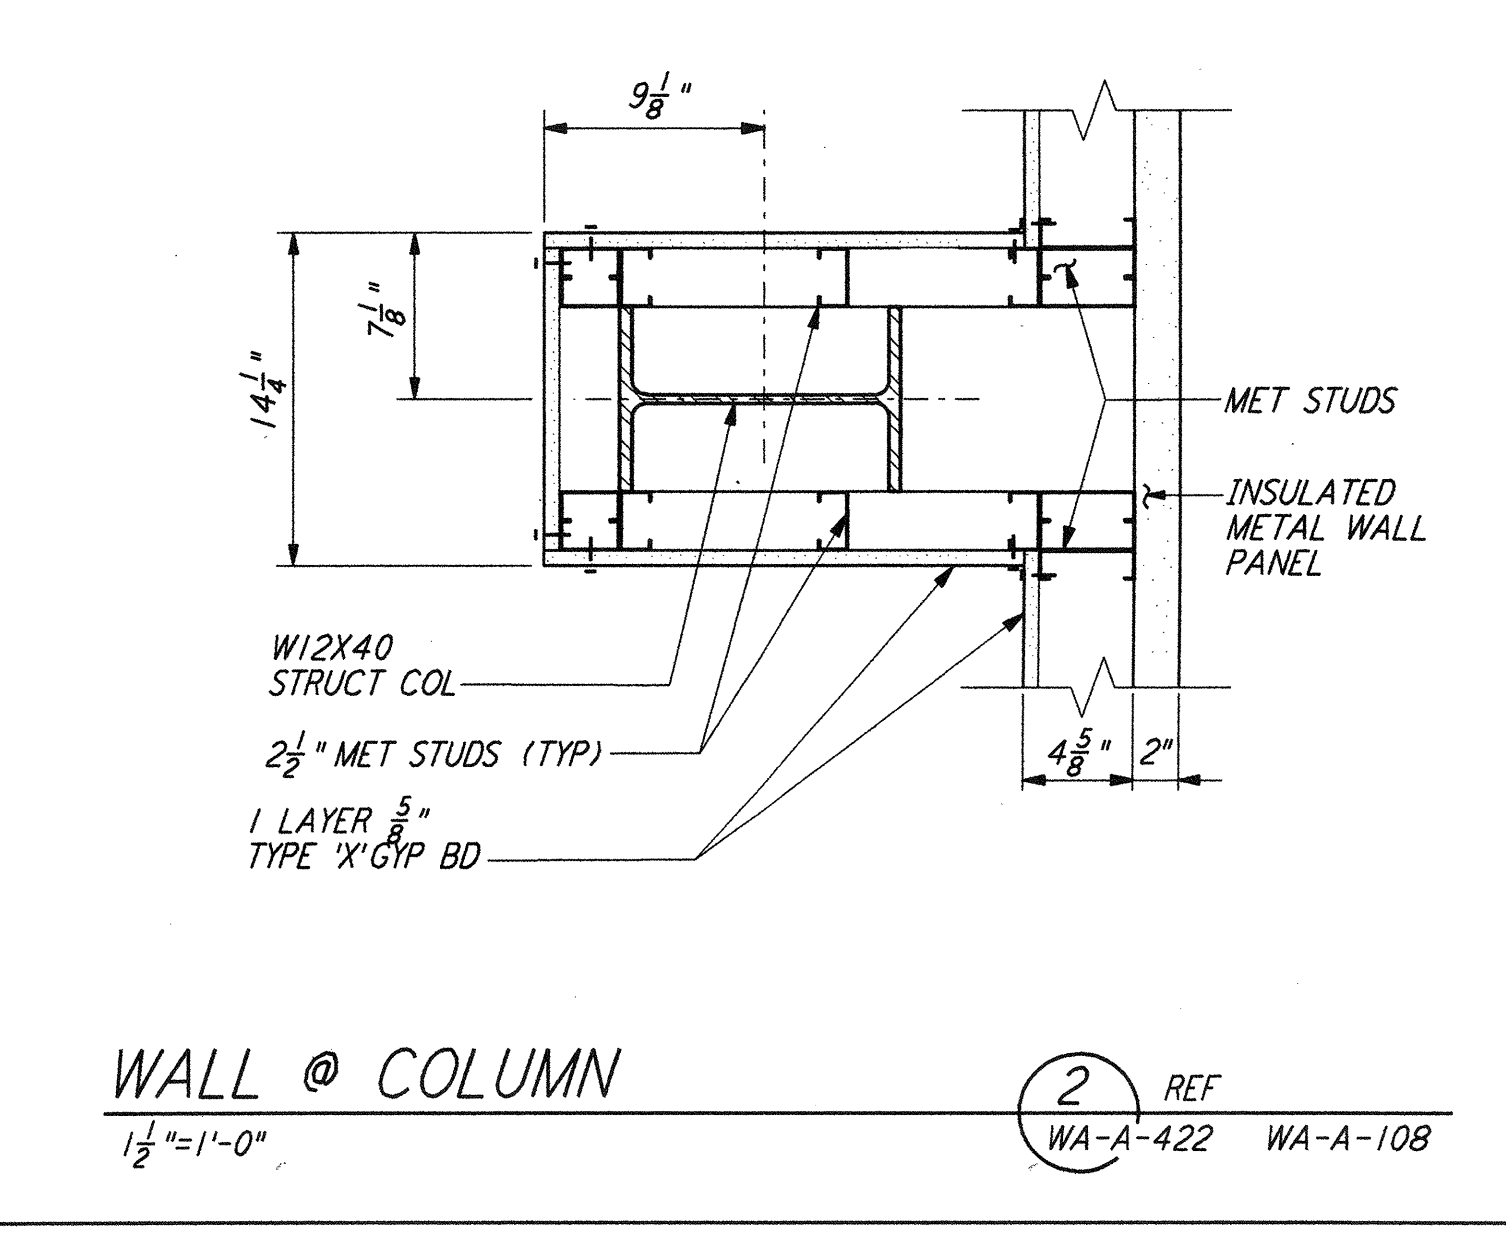


WALL @ COLUMN (2) REF
 1 1/2" = 1'-0"
 WA-A-422 WA-A-108

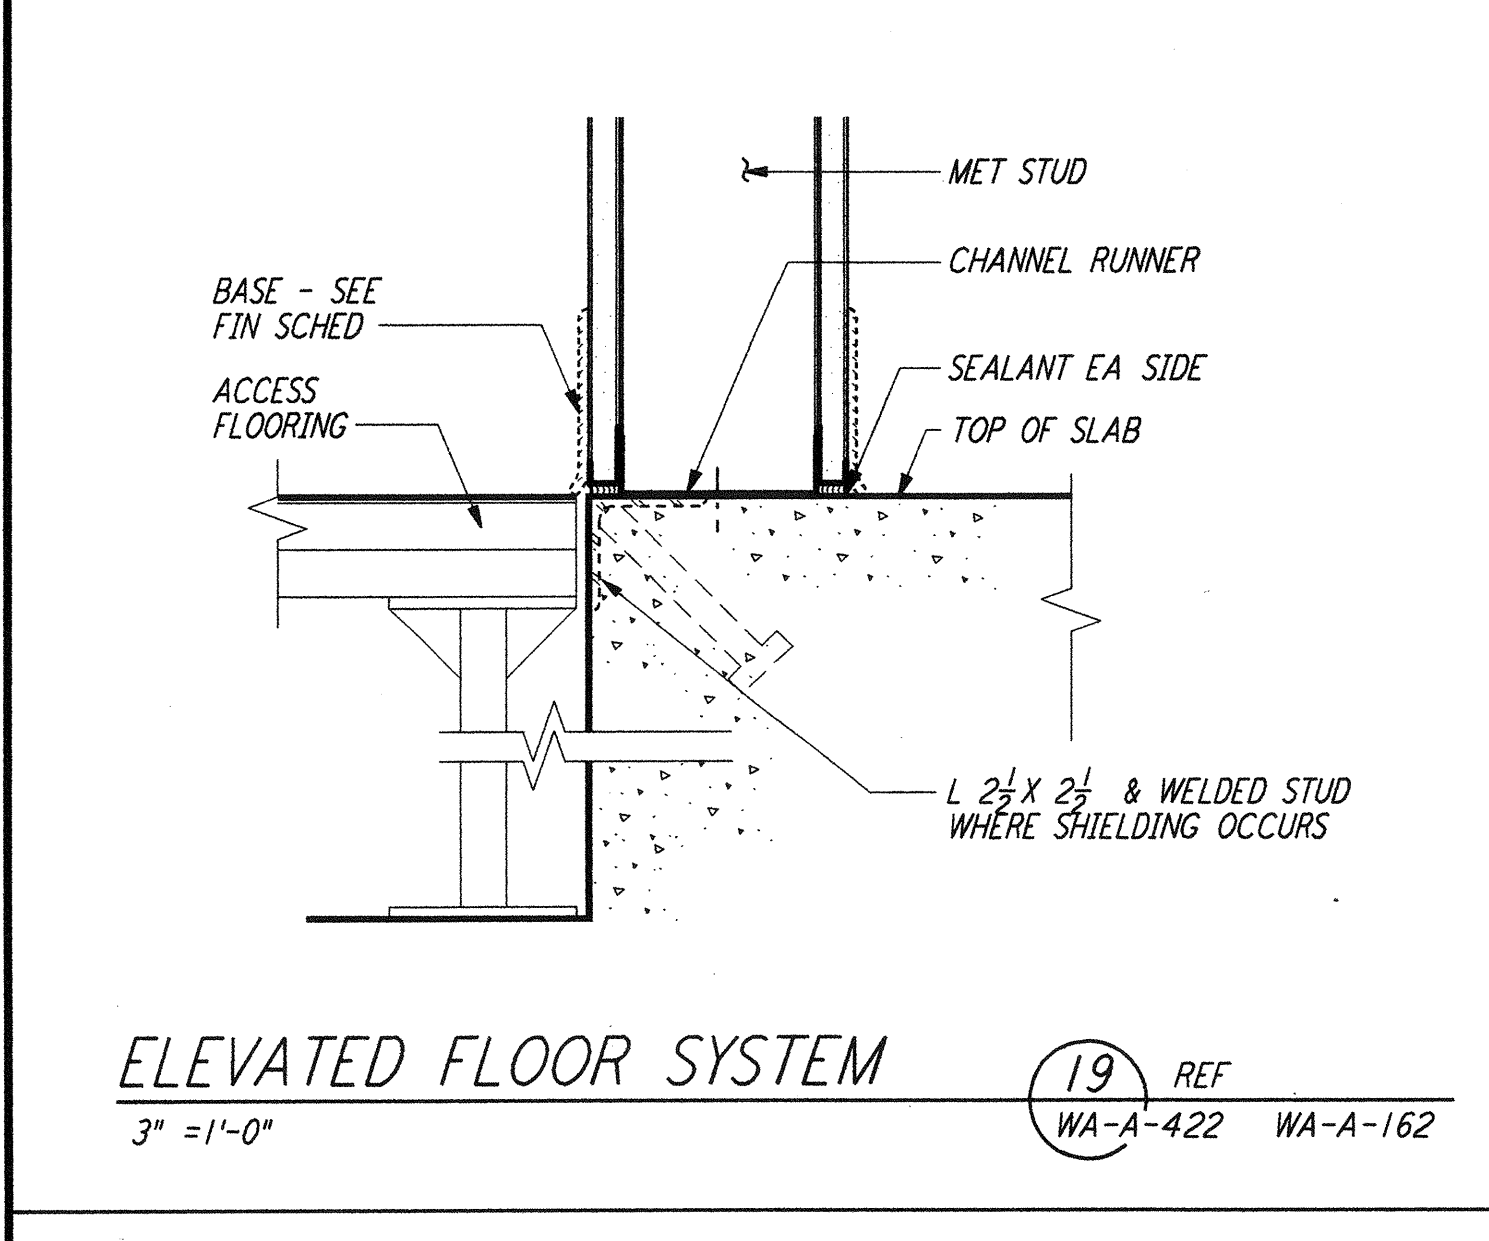


ELEVATED FLOOR SYSTEM (19) REF
 3" = 1'-0"
 WA-A-422 WA-A-162

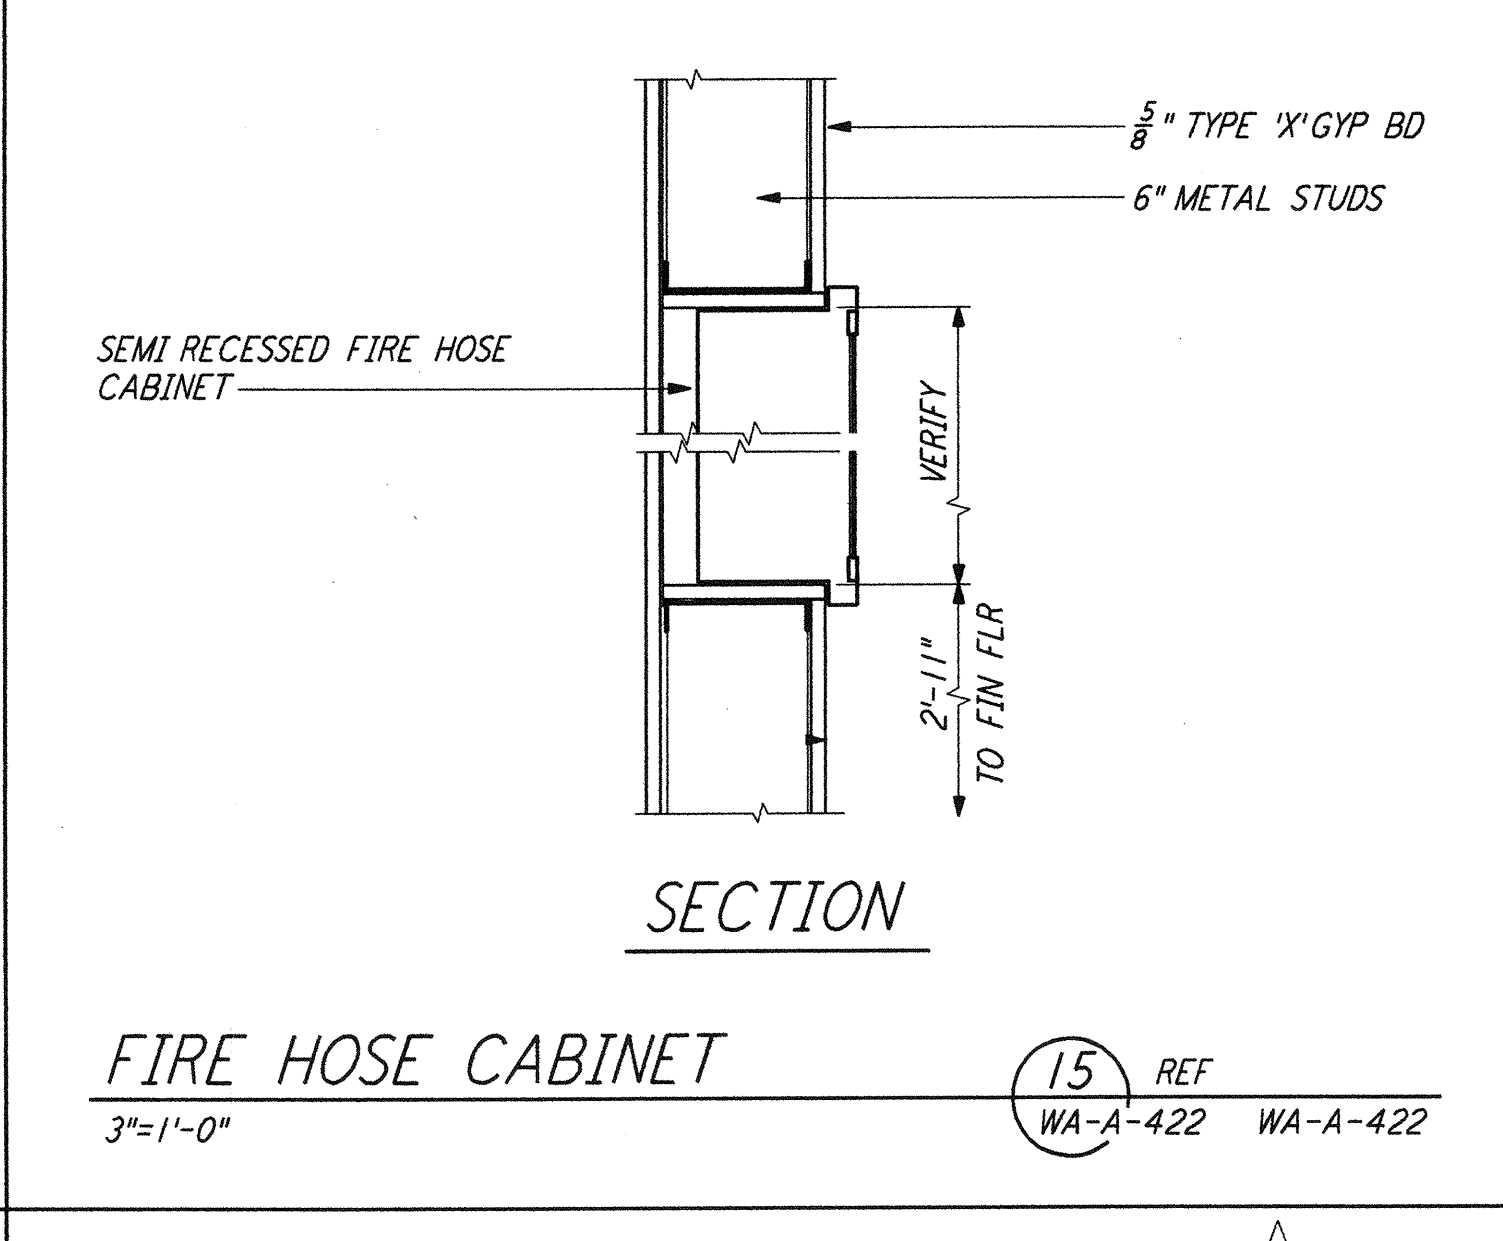


FIRE HOSE CABINET (15) REF
 3" = 1'-0"
 WA-A-422 WA-A-422

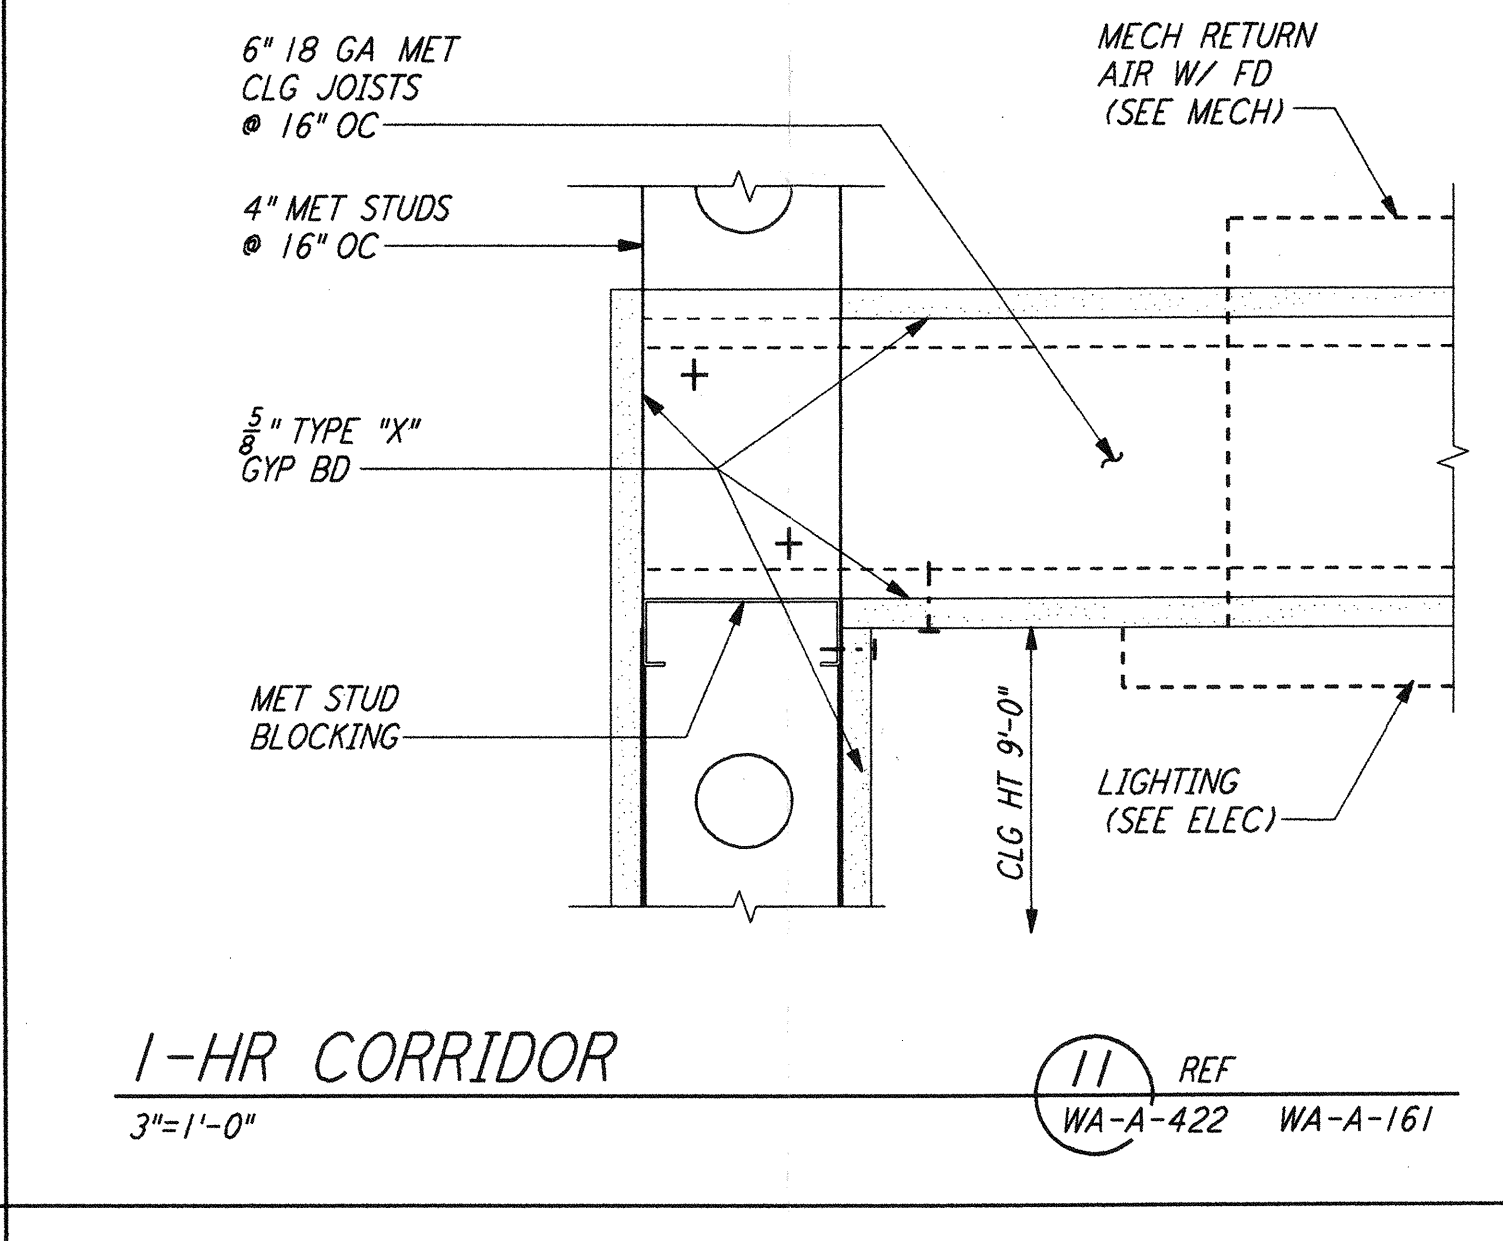


1-HR CORRIDOR (11) REF
 3" = 1'-0"
 WA-A-422 WA-A-161

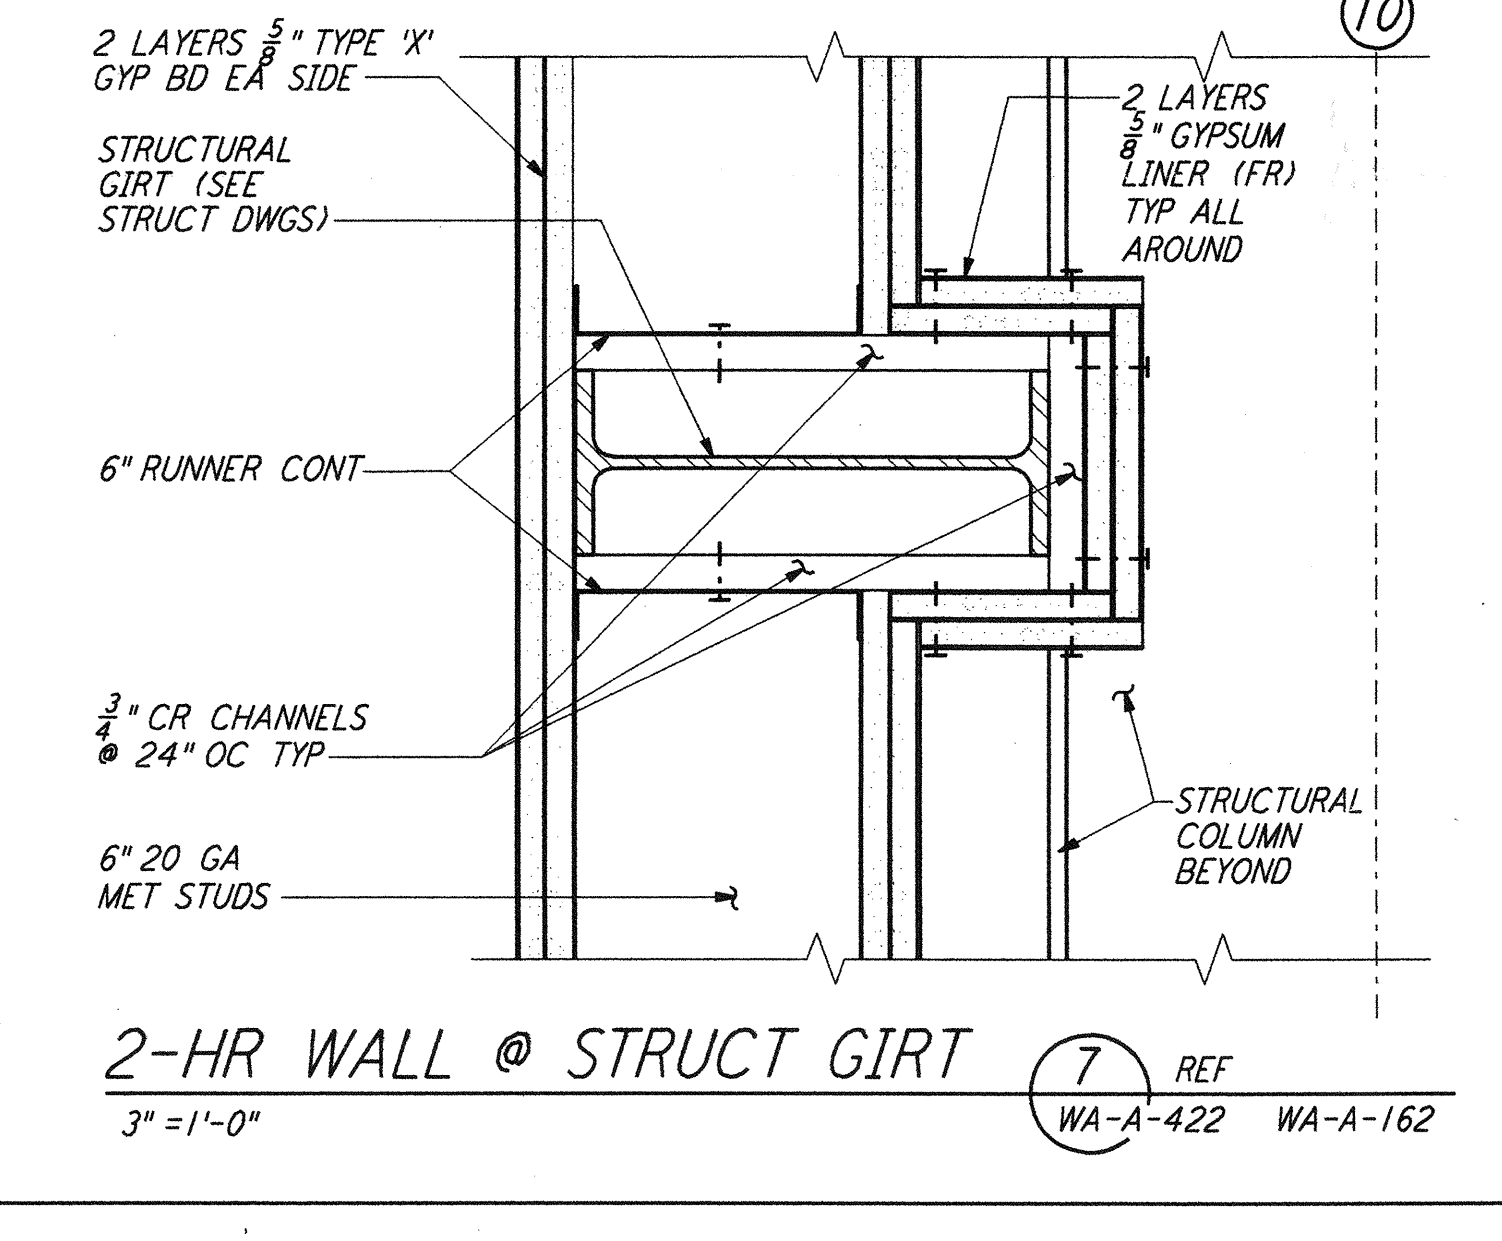


2-HR WALL @ STRUCT GIRT (7) REF
 3" = 1'-0"
 WA-A-422 WA-A-162

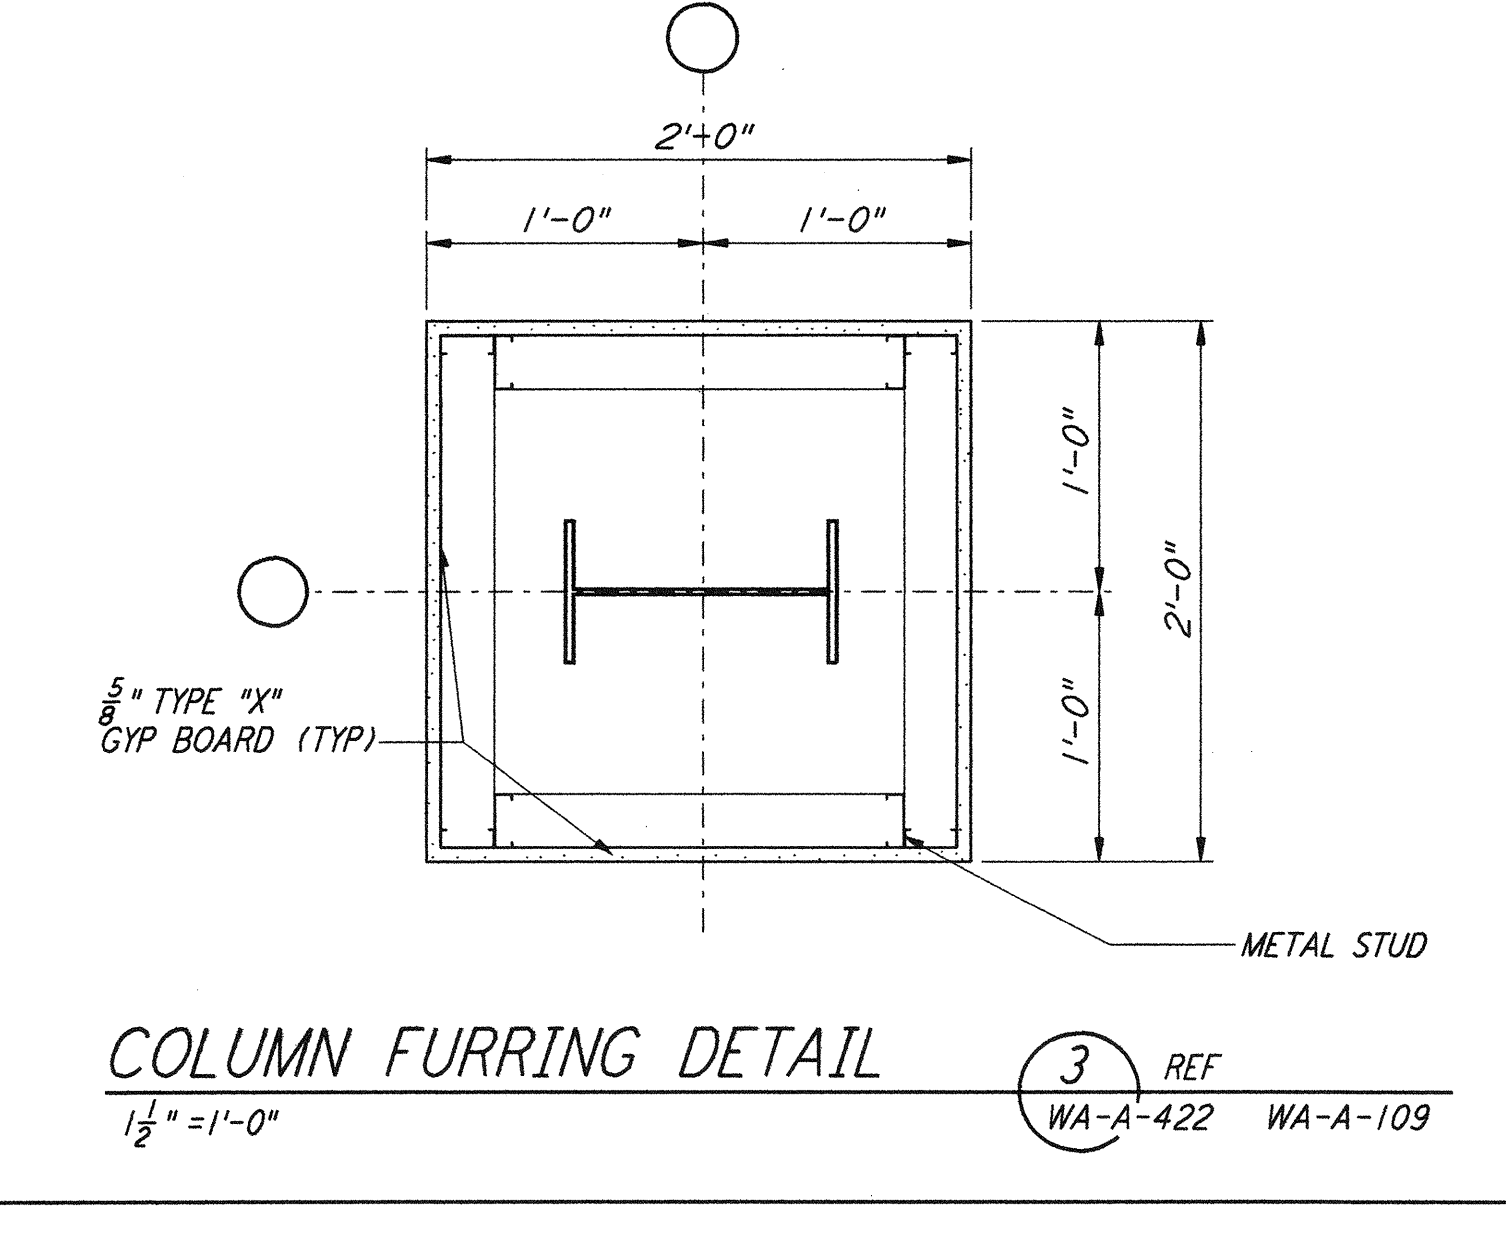


COLUMN FURRING DETAIL (3) REF
 1 1/2" = 1'-0"
 WA-A-422 WA-A-109

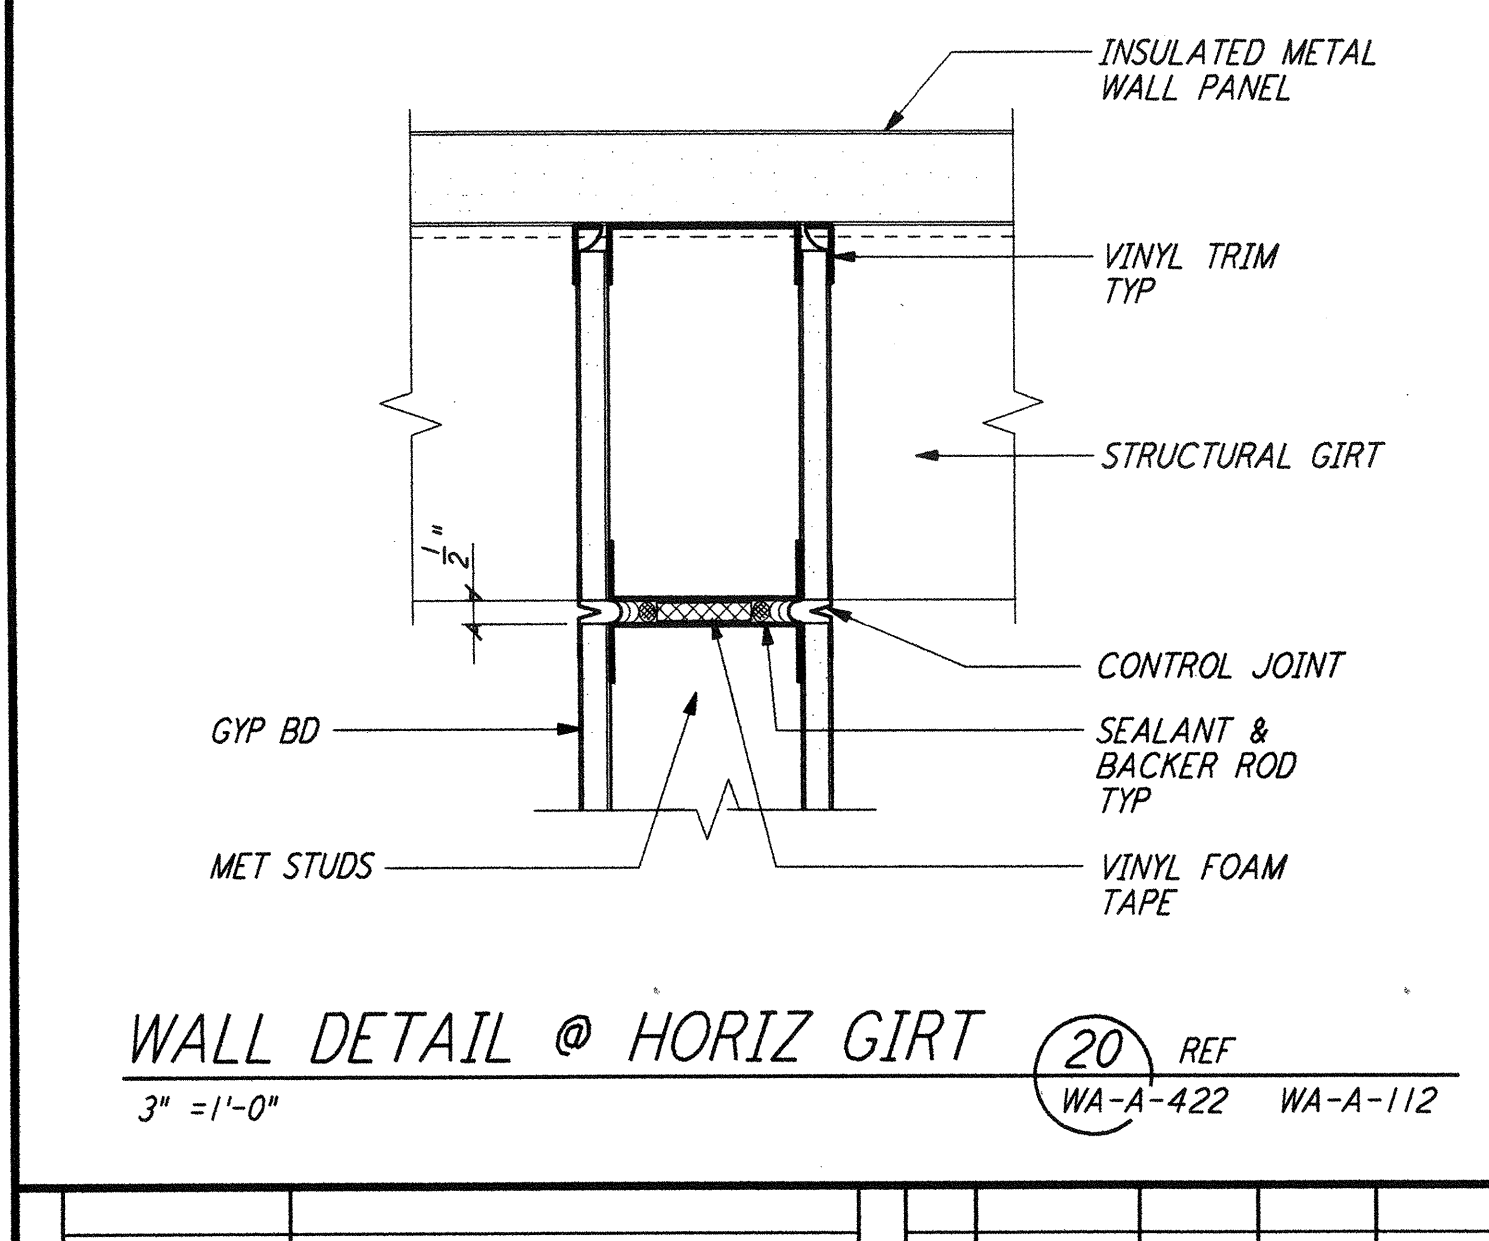


WALL DETAIL @ HORIZ GIRT (20) REF
 3" = 1'-0"
 WA-A-422 WA-A-112

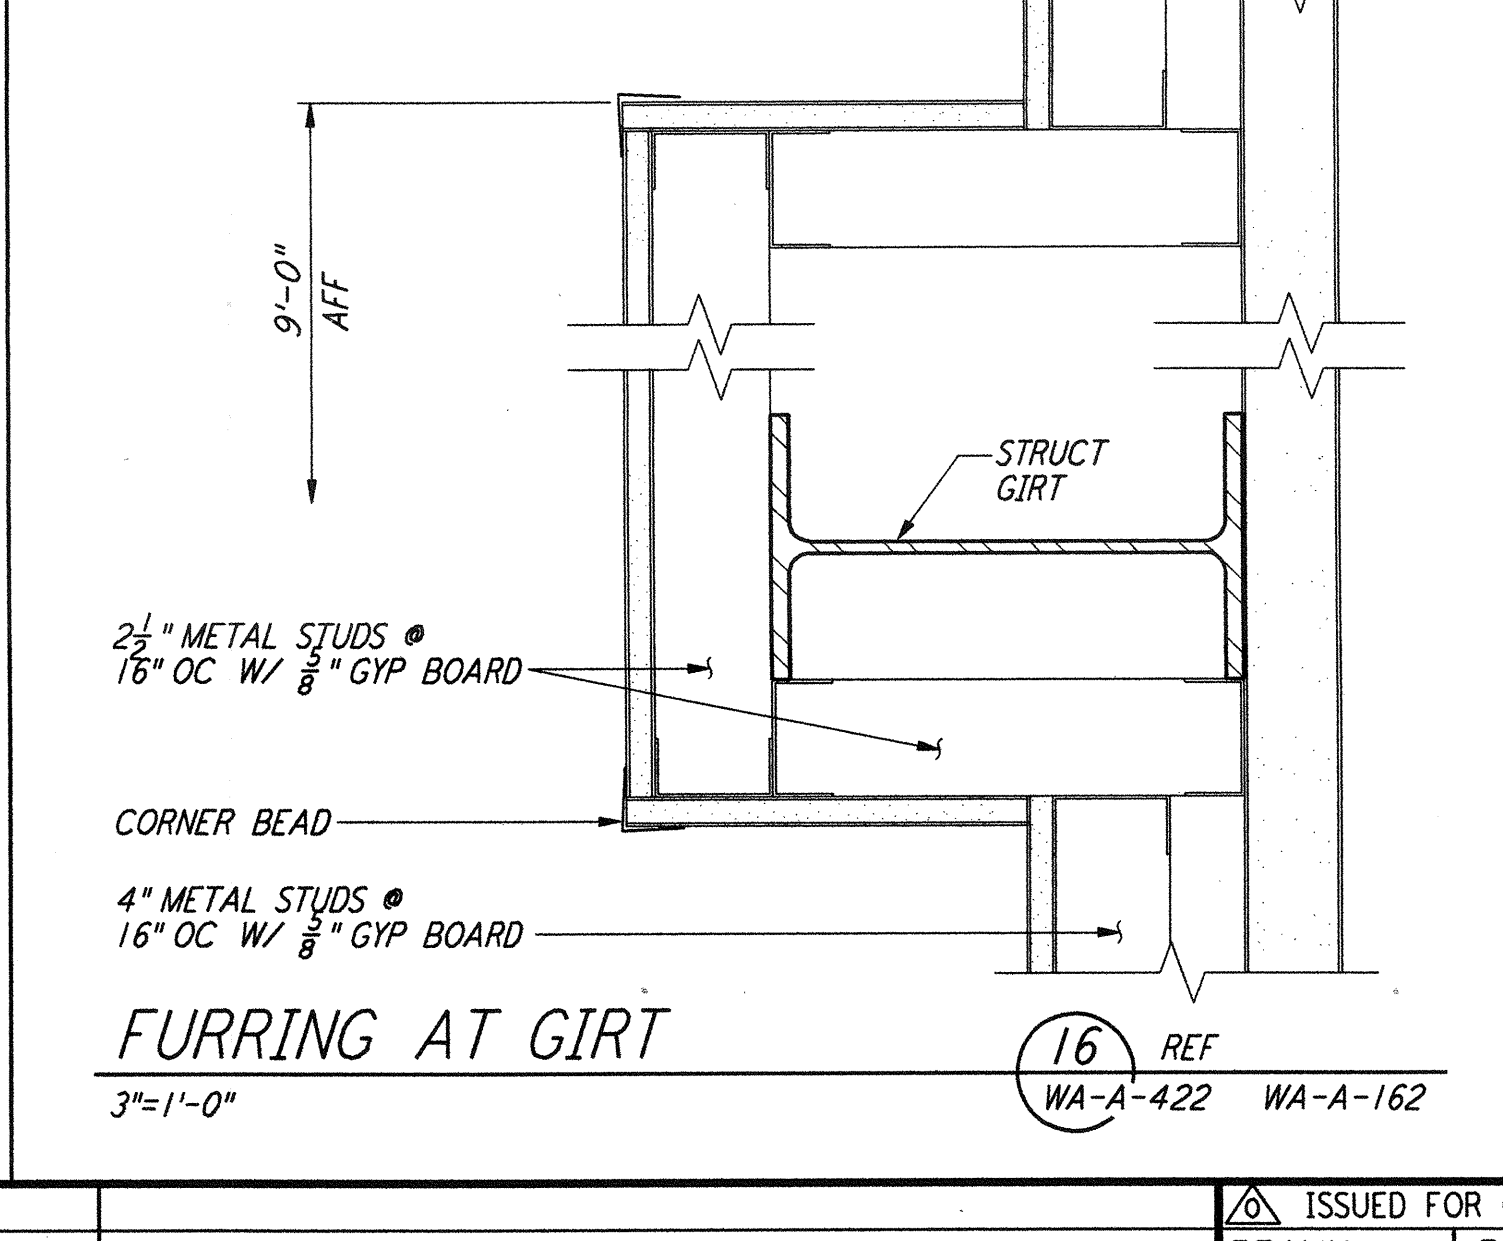

FURRING AT GIRT (16) REF
 3" = 1'-0"
 WA-A-422 WA-A-162

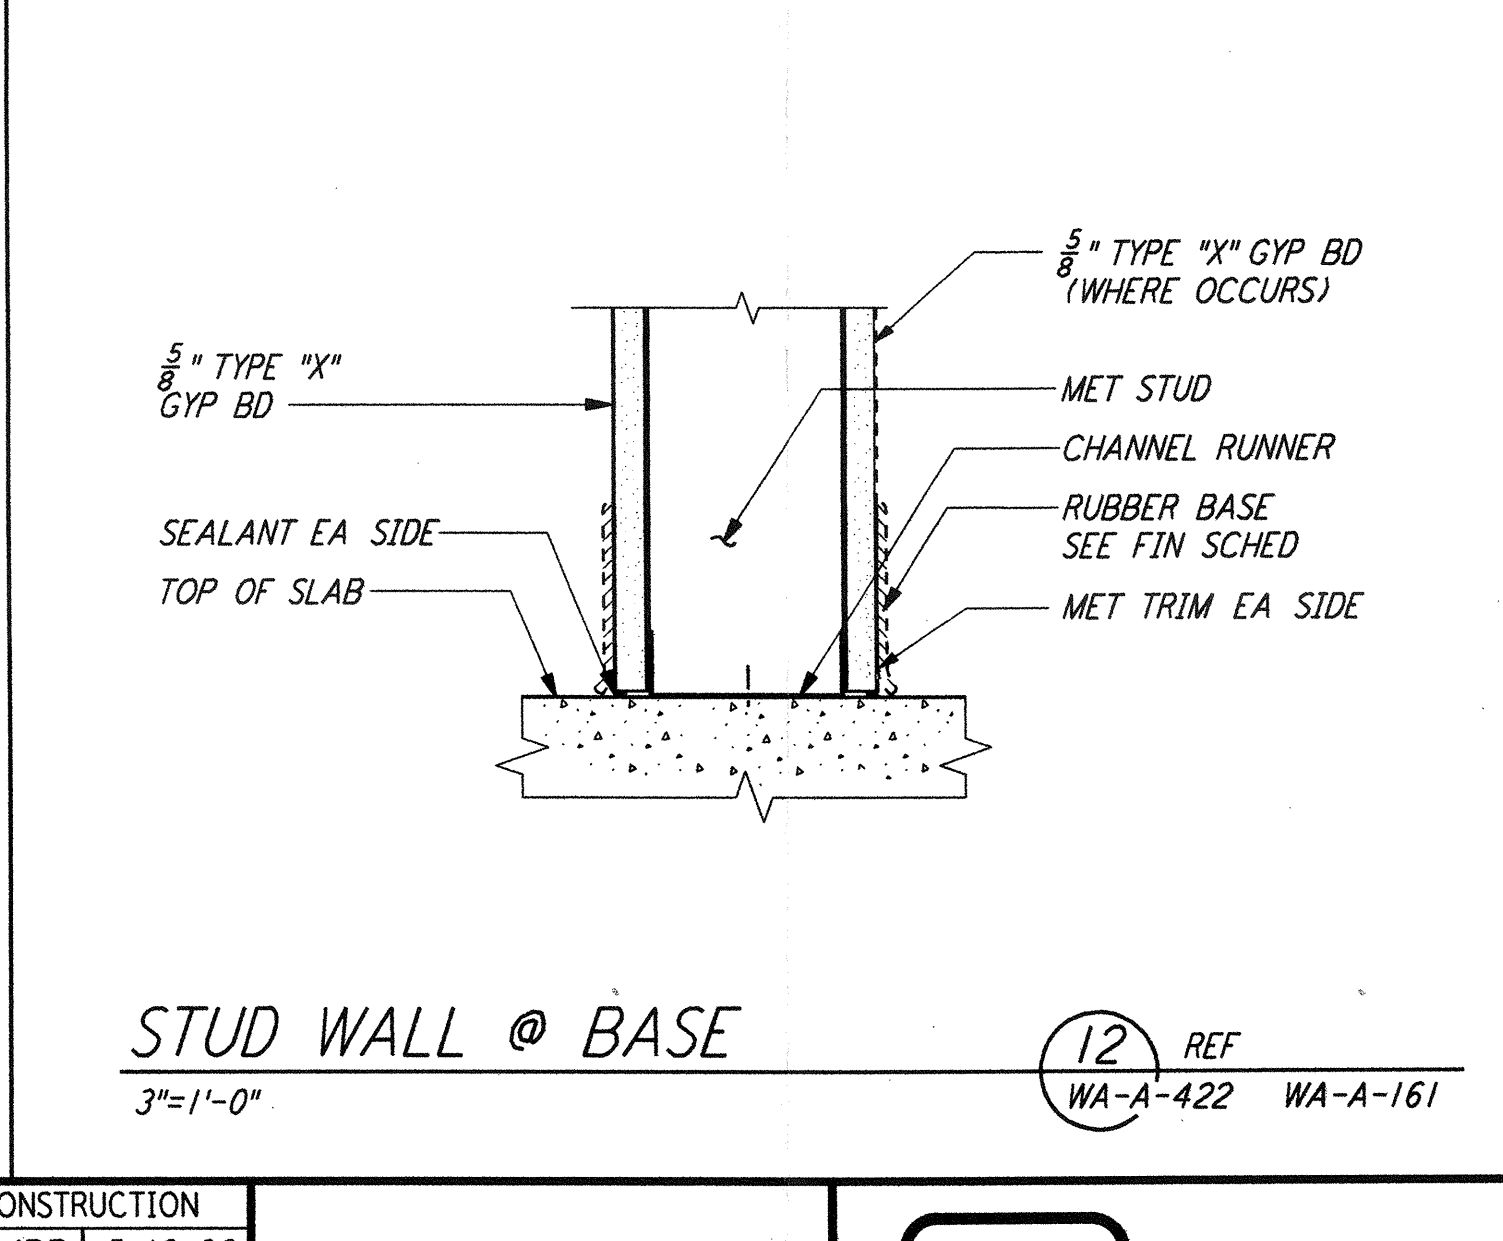

STUD WALL @ BASE (12) REF
 3" = 1'-0"
 WA-A-422 WA-A-161

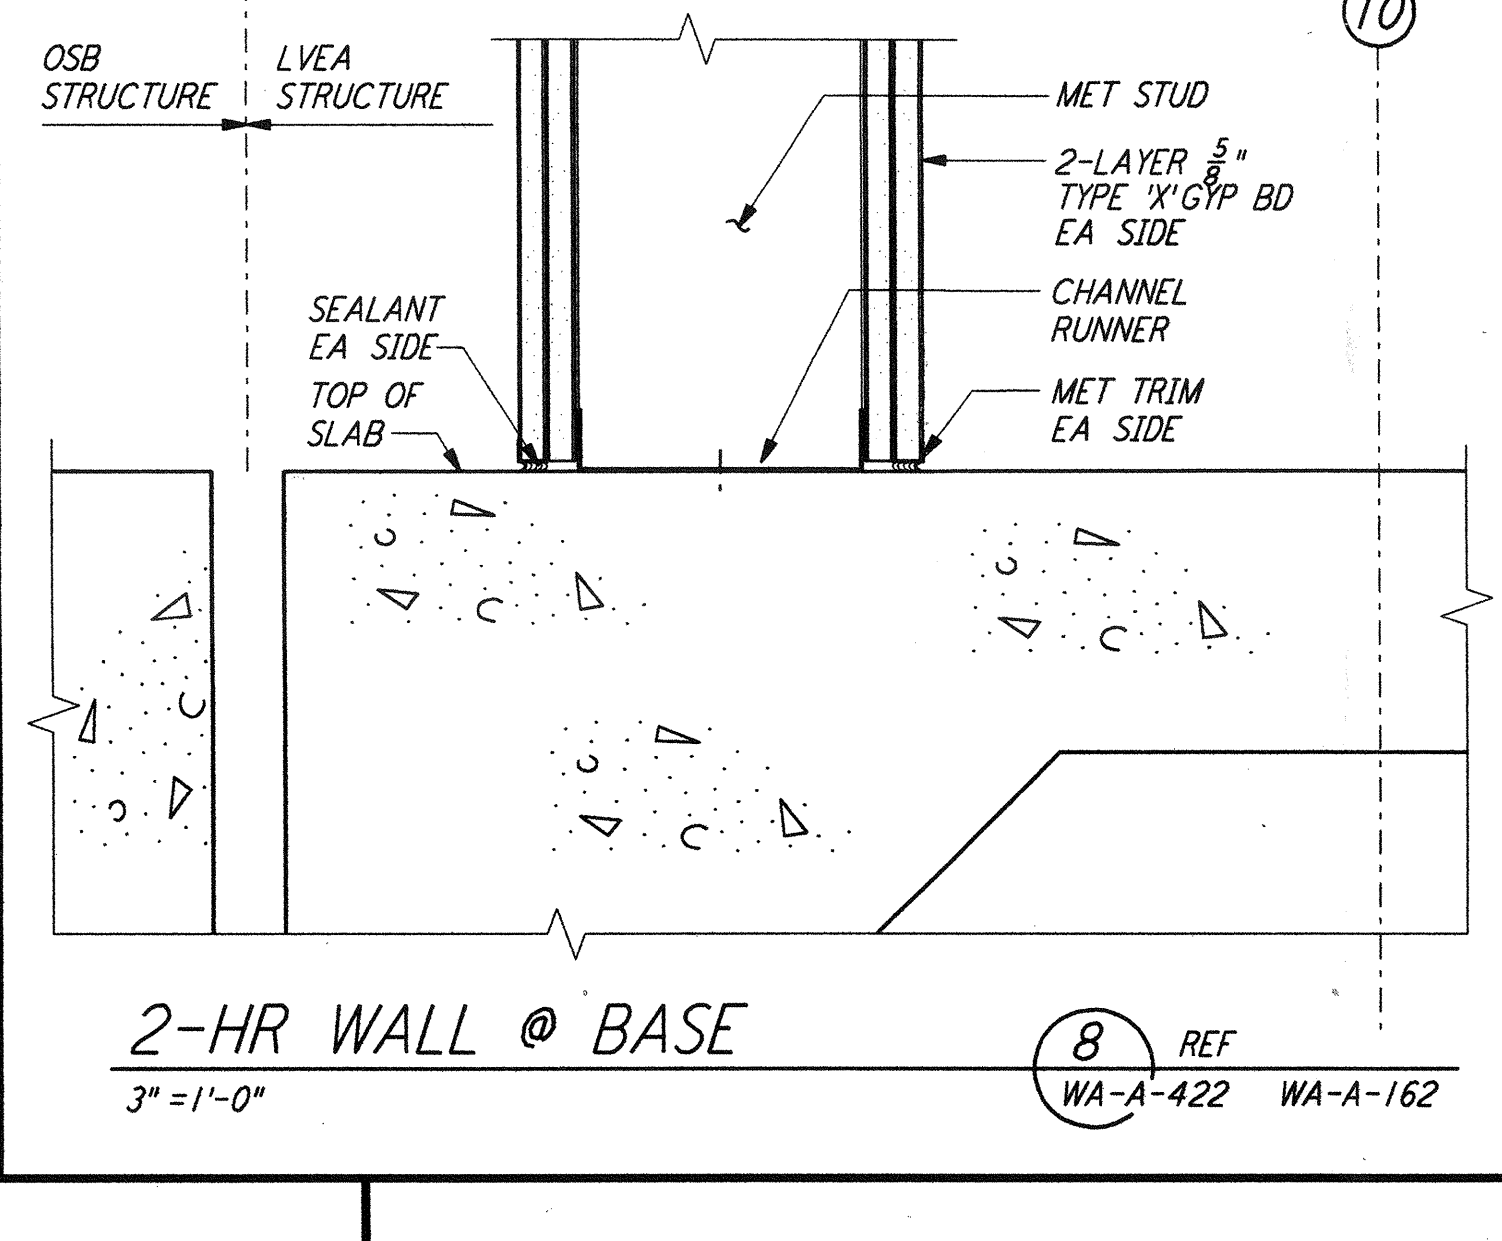

2-HR WALL @ BASE (8) REF
 3" = 1'-0"
 WA-A-422 WA-A-162

NO.	DATE	BY	CHKD	ENGR	PROJ	DESCRIPTION
2	5-15-98	CKT	AK	AK	TDM	ISSUED FOR AS-BUILT
1	2-28-97	CKT	TB	AK	TDM	CORNER STATION VSEA PARTITION

NO.	DATE	BY	CHKD	ENGR	PROJ	DESCRIPTION
1	5-12-96	BK/RR	TB	AK	TDM	ISSUED FOR CONSTRUCTION
1	5-26-96	TB	AK	AK	TDM	CHECKED
1	7-12-96	DKK	AK	AK	TDM	ENGINEER
1	7-12-96	MDW	AK	AK	TDM	PROJ

AS-BUILT DRAWINGS

PARSONS
 100 WEST WALNUT STREET
 PASADENA, CALIFORNIA

LIGO
 CALIFORNIA INSTITUTE OF TECHNOLOGY
 MASSACHUSETTS INSTITUTE OF TECHNOLOGY

LIGO-D960266-02-0
 LASER INTERFEROMETER
 GRAVITATIONAL-WAVE OBSERVATORY
 SITE NO. 1 - HANFORD, WASHINGTON

TITLE	SCALE	CONTRACT NUMBER	PROJECT NUMBER
ARCHITECTURAL INTERIOR WALL DETAILS	1 1/2" = 1'-0"	PPI50969	8094
SHEET NUMBER	REVISIONS		
WA-A-422			

Thu Jun 84 17:44:42 1998 CA\PLOT\QIES9-V6622.DWG 52085 K:\V382C\m422.prf LIGOWAF.BDR