



TOILET PARTITION MOUNTING
 1/2" = 1'-0"

SECTION A
 1/2" = 1'-0"
 12 REF
 WA-A-424 WA-A-111

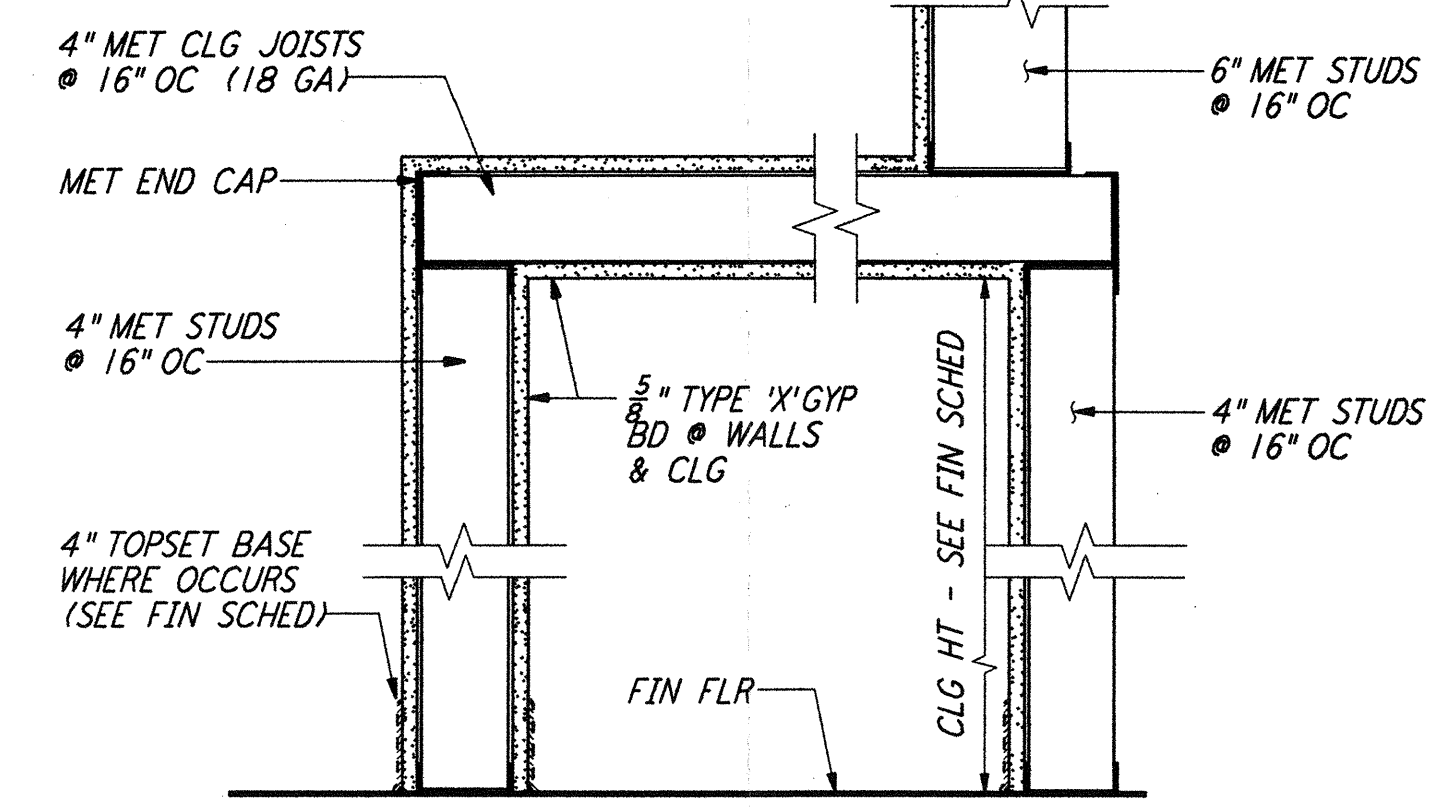


LVEA VESTIBULE
 1/2" = 1'-0"

8 REF
 WA-A-424 WA-A-504

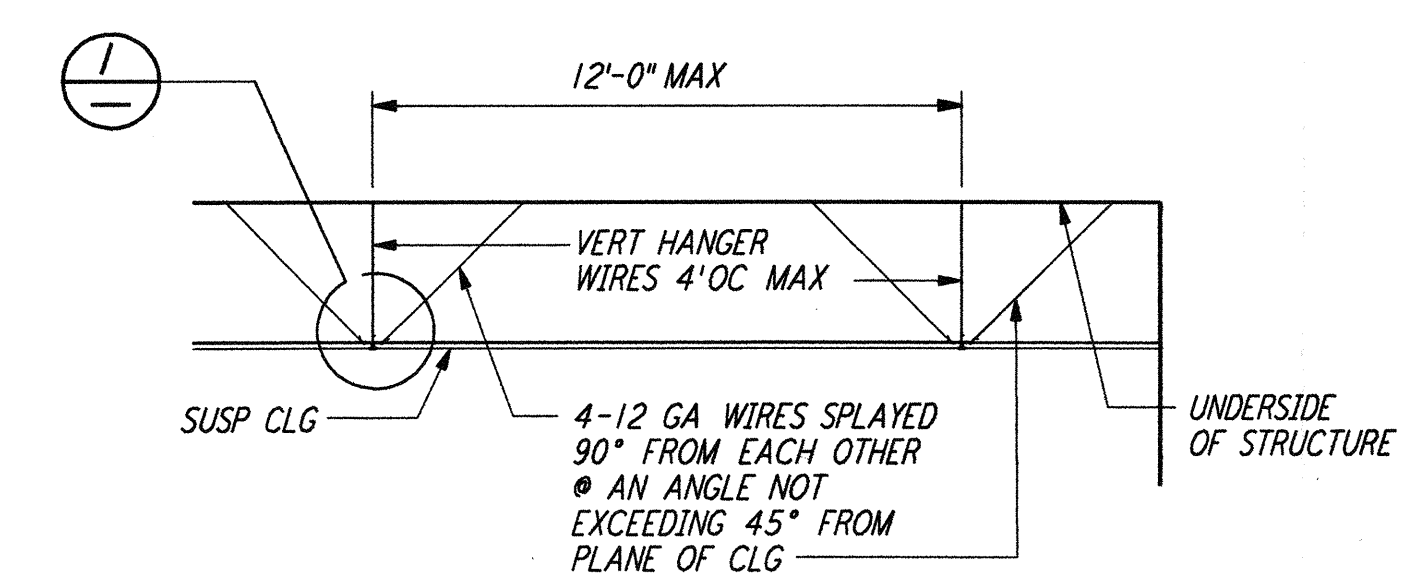


SECTION 1
 1/4" = 1'-0"

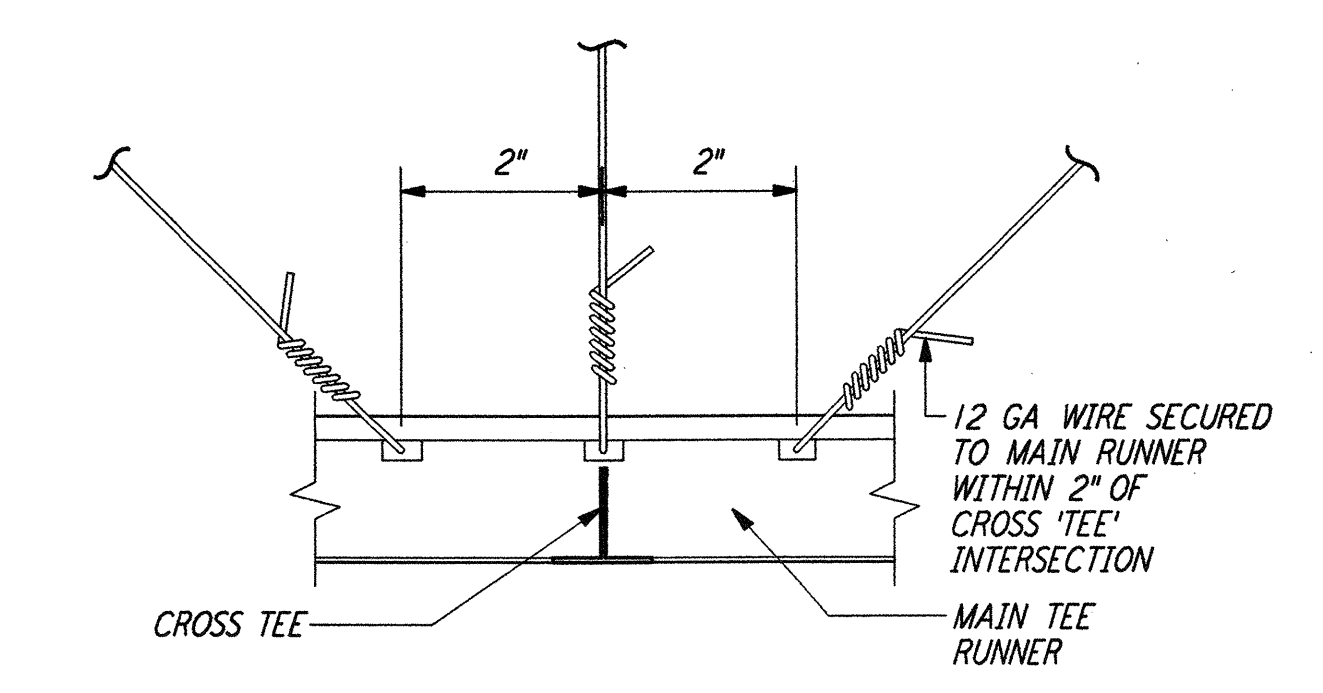


SUSP ACOUSTICAL CLG DET
 3" = 1'-0"

1 REF
 WA-A-424

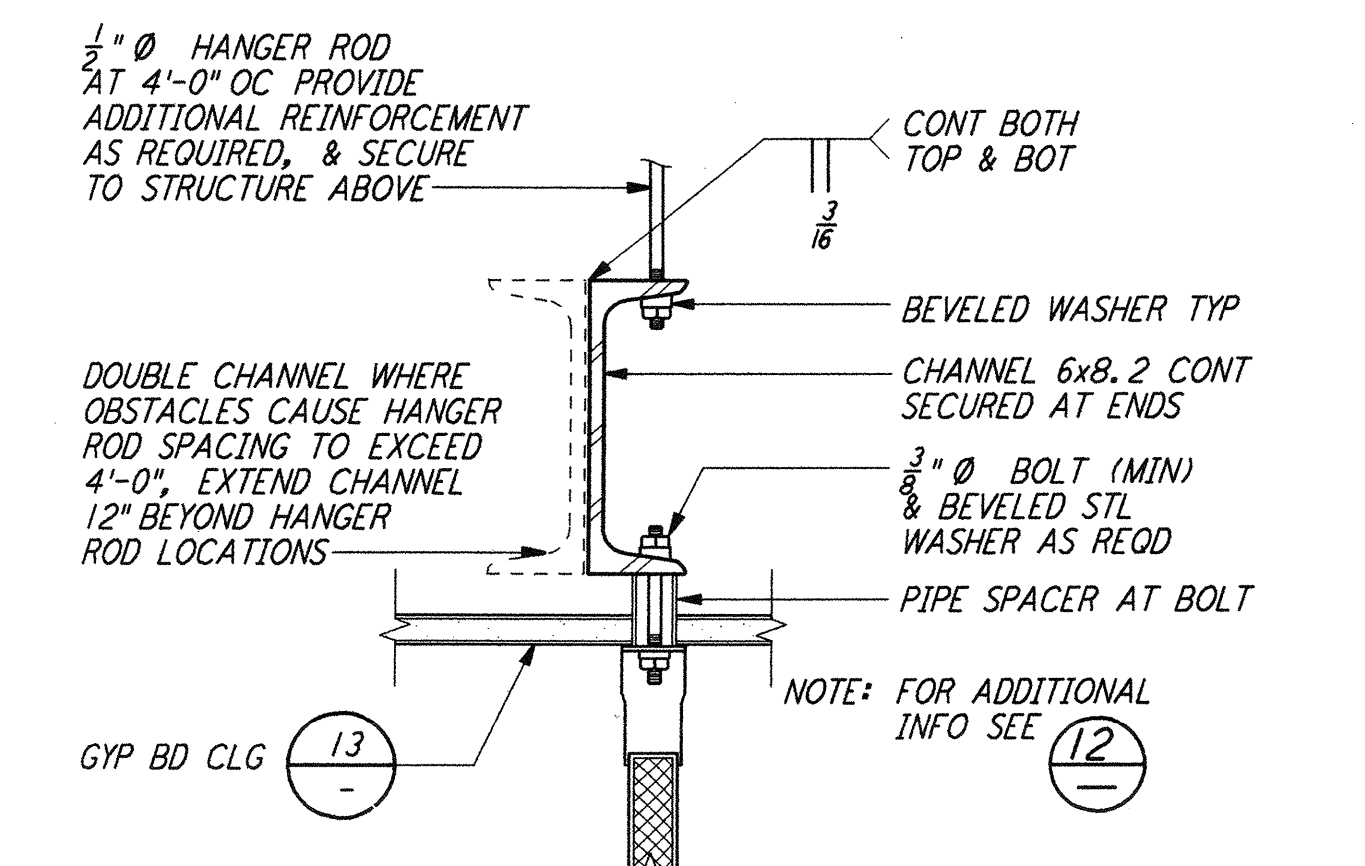


TOILET PARTITION MOUNTING
 3" = 1'-0"

16 REF
 WA-A-424

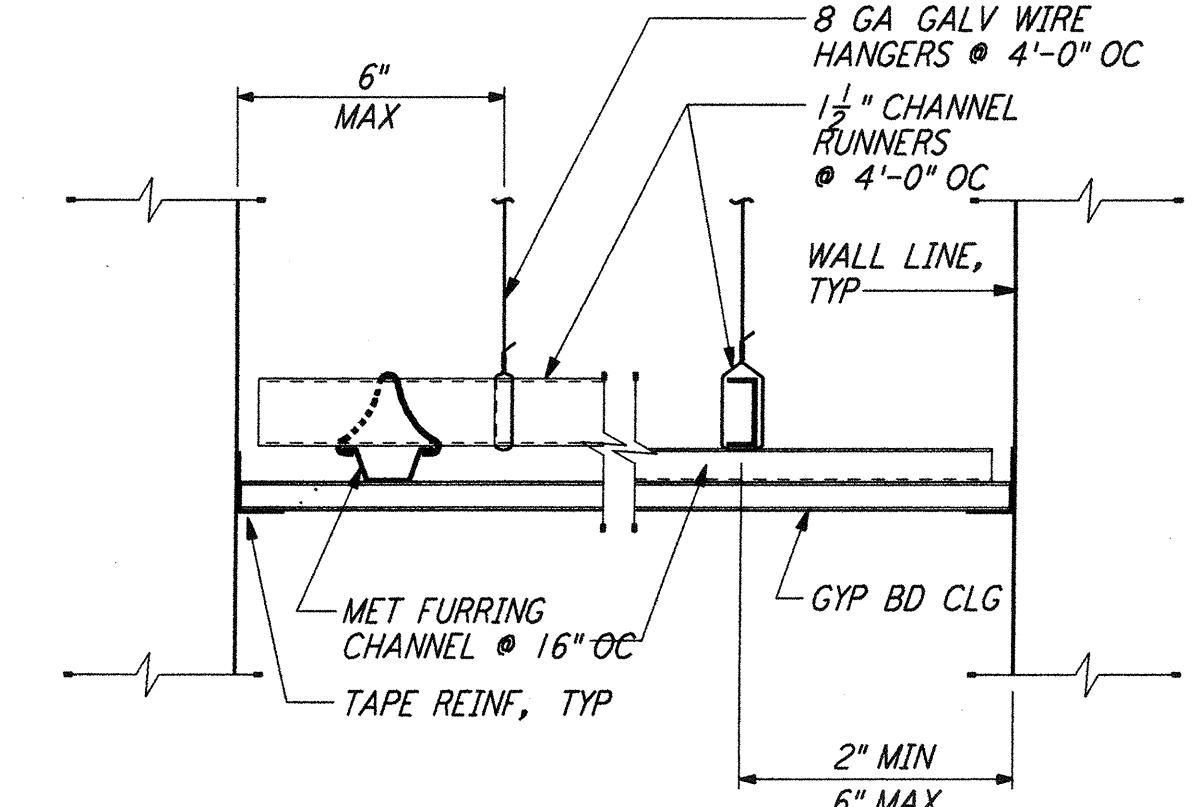


GYPSUM BOARD CEILING
 3" = 1'-0"

13 REF
 WA-A-424 WA-A-521
 WA-A-122

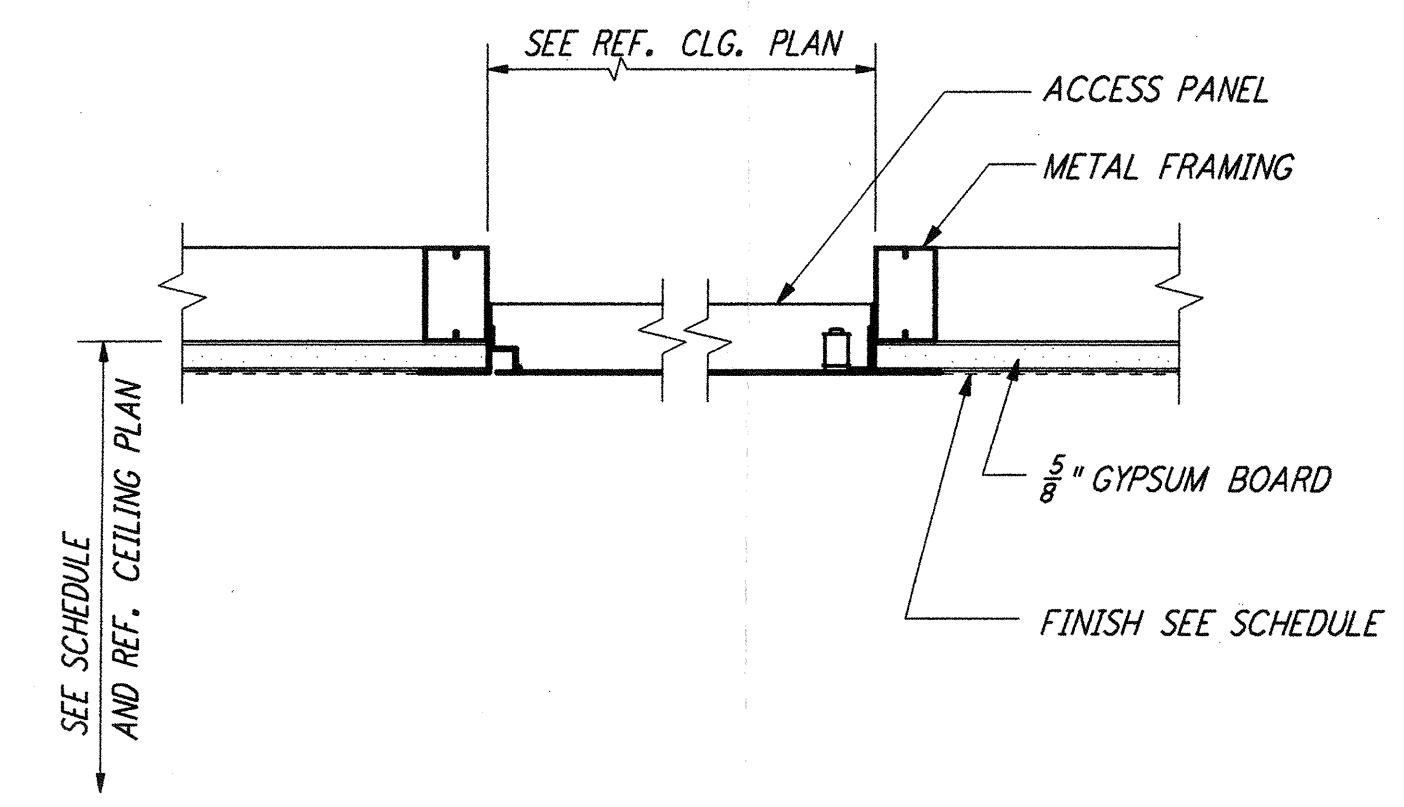


CEILING ACCESS PANEL DET
 3/4" = 1'-0"

9 REF
 WA-A-424

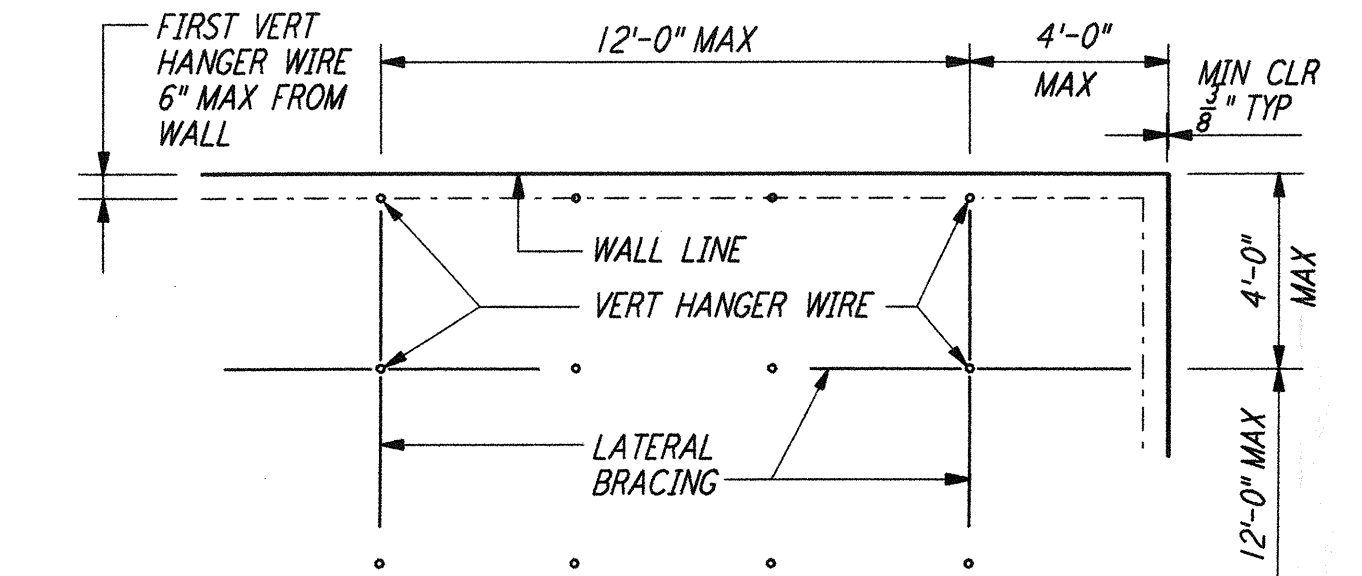


SUSP ACOUSTICAL CLG DET
 SCALE AS NOTED

5 REF
 WA-A-424 WA-A-424

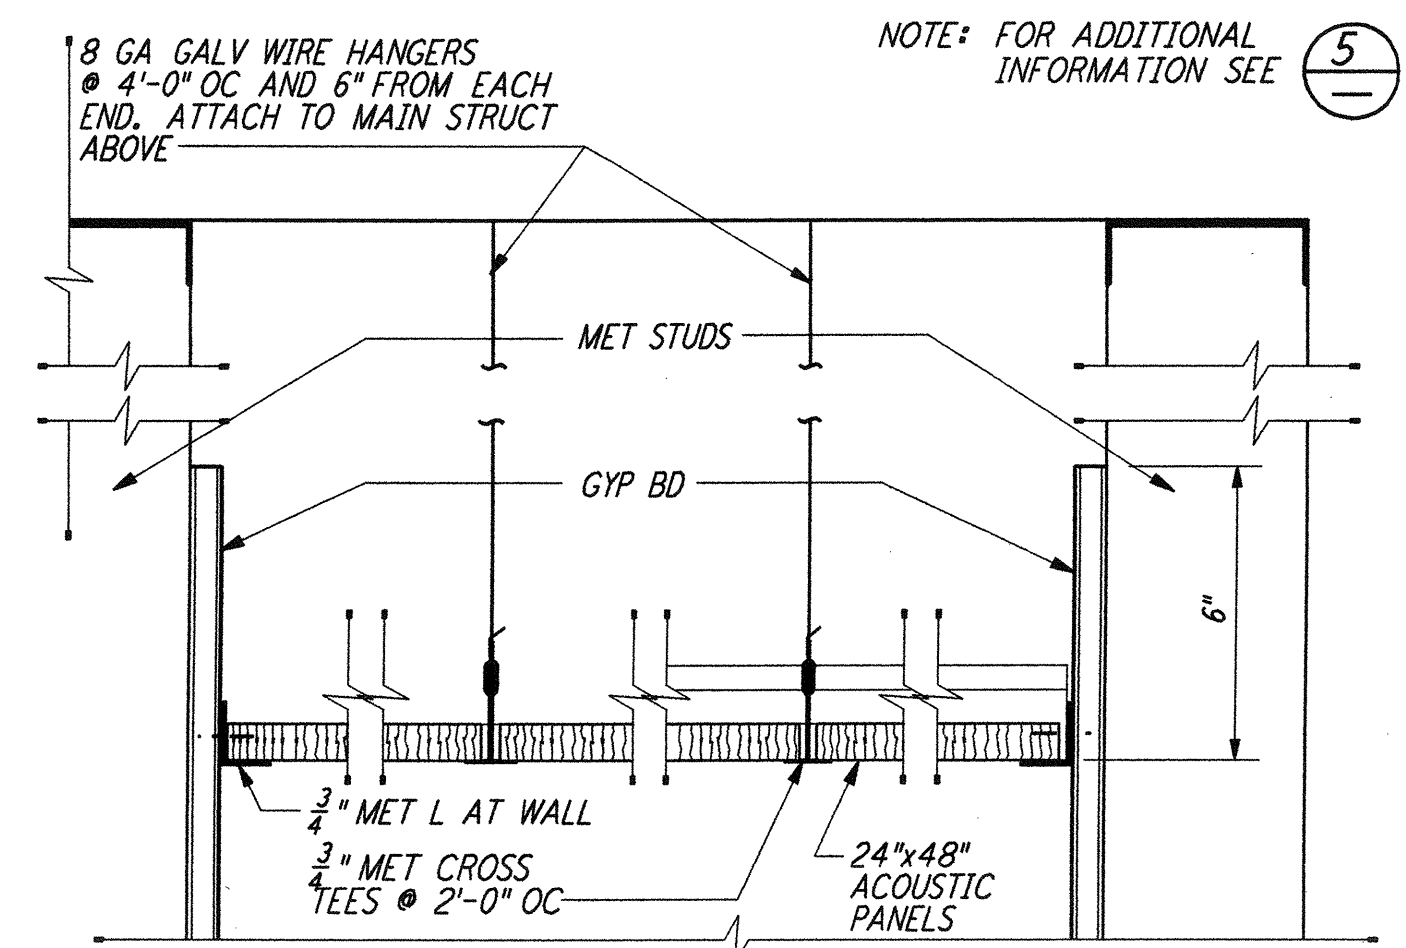


SUSP ACOUSTICAL CLG DET
 3" = 1'-0"

2 REF
 WA-A-424 WA-A-521
 WA-A-122 WA-A-123

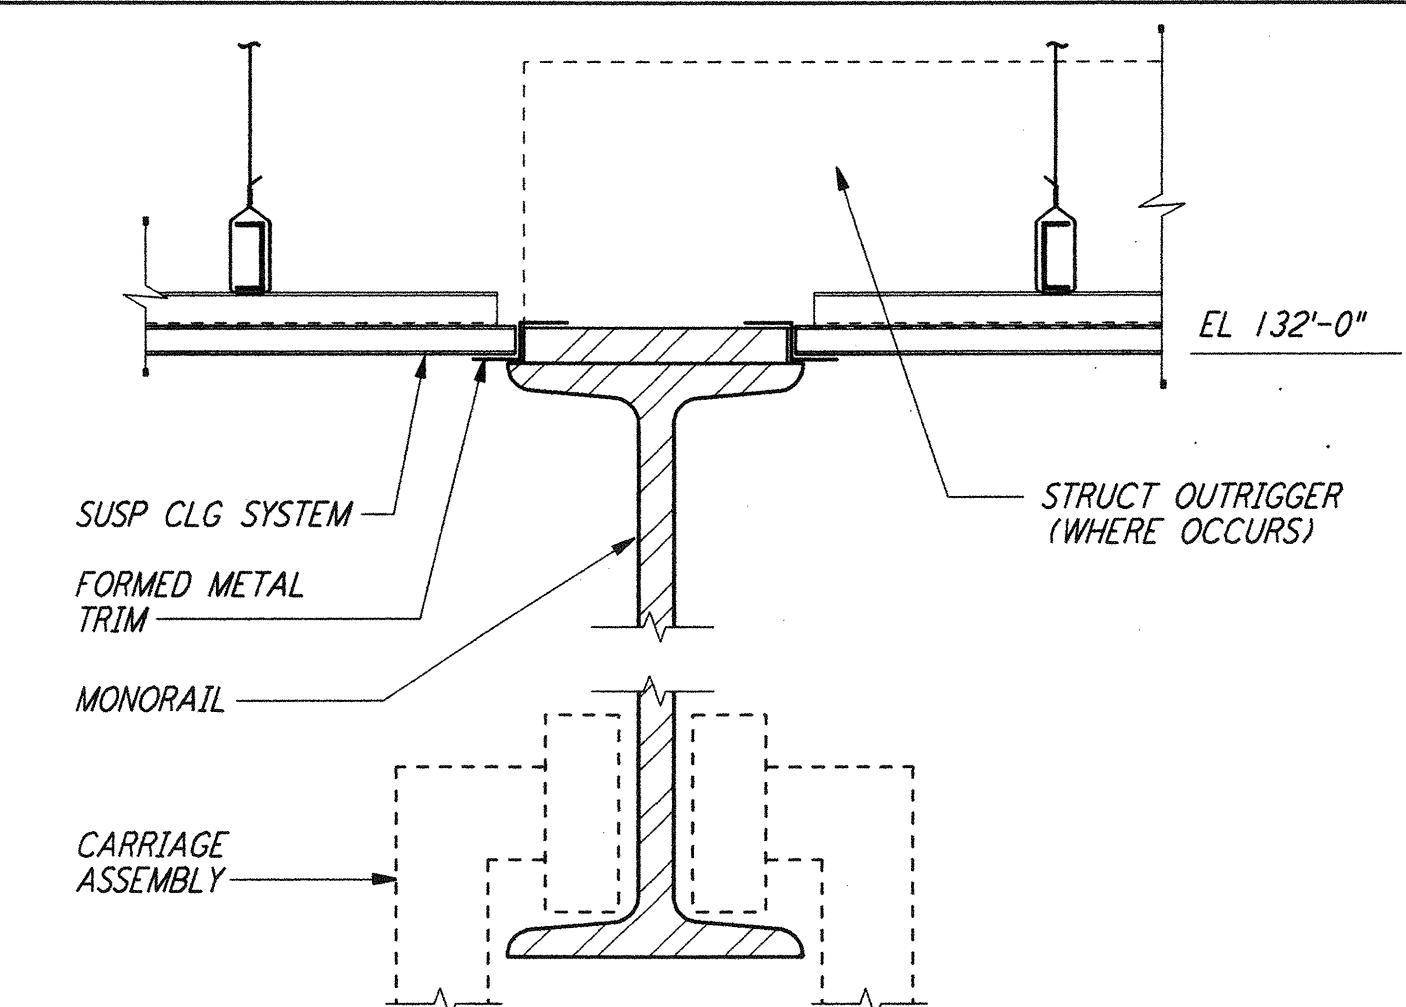


SUSP CLG AT MONORAIL
 3" = 1'-0"

17 REF
 WA-A-424 WA-A-521
 WA-A-551

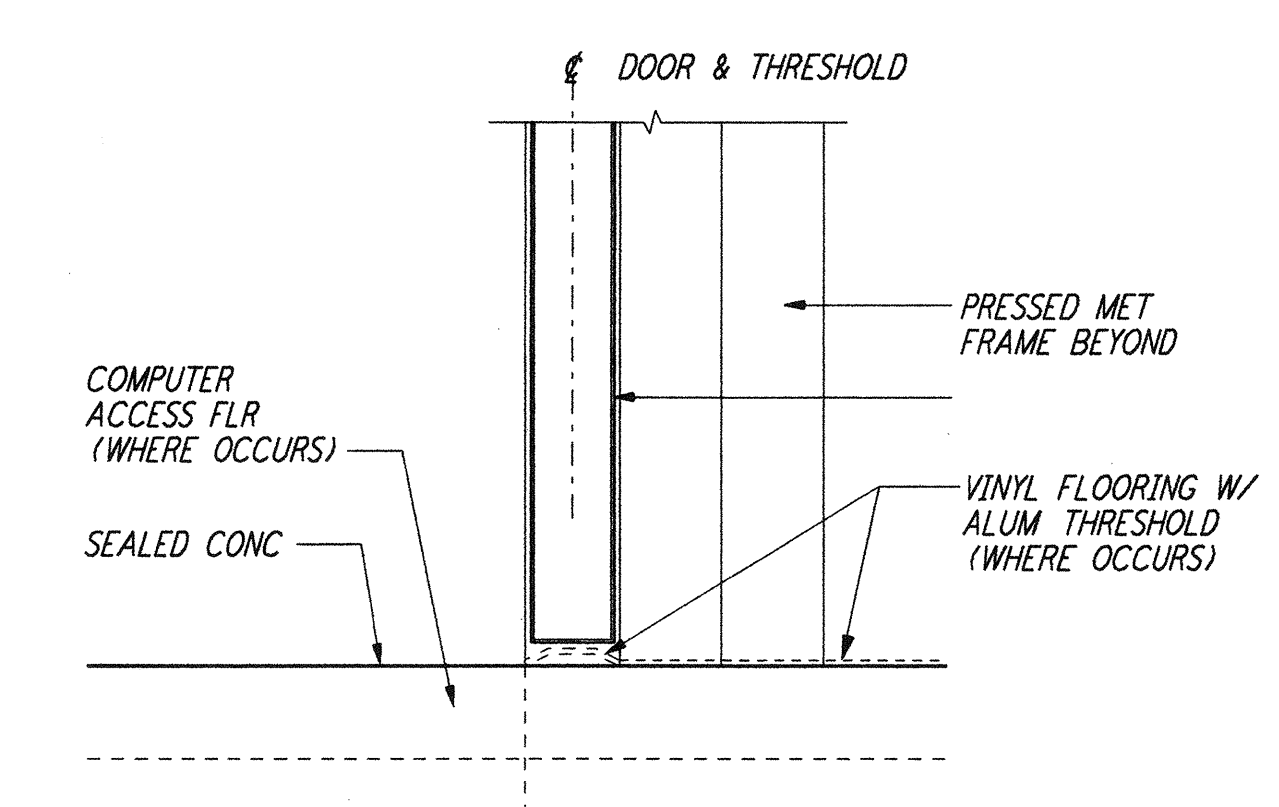


INT THRESHOLD DETAIL
 3" = 1'-0"

14 REF
 WA-A-424

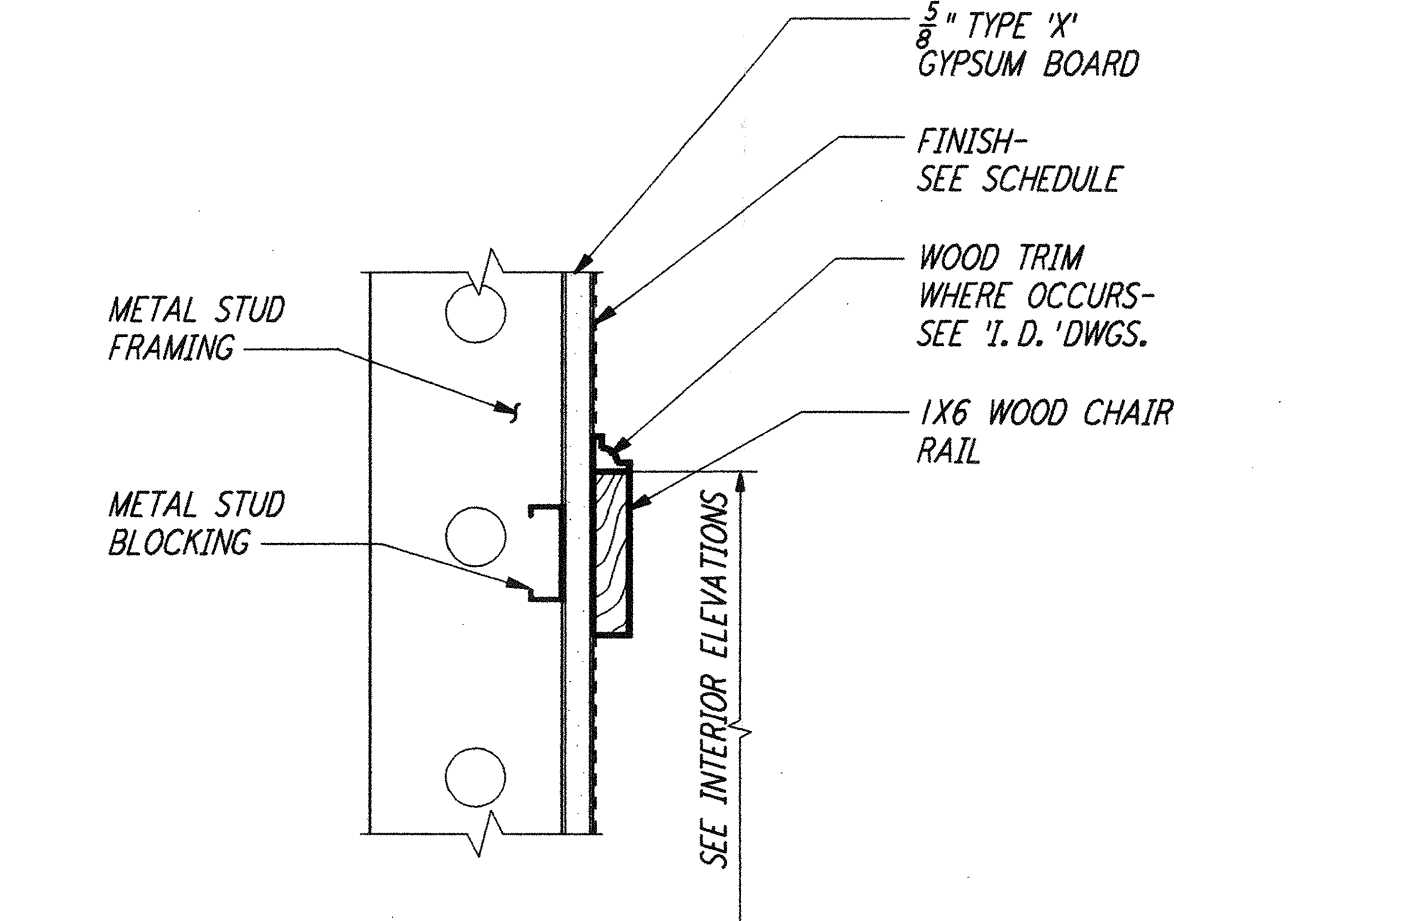


CHAIR RAIL
 3" = 1'-0"

10 REF
 WA-A-424 WA-A-111

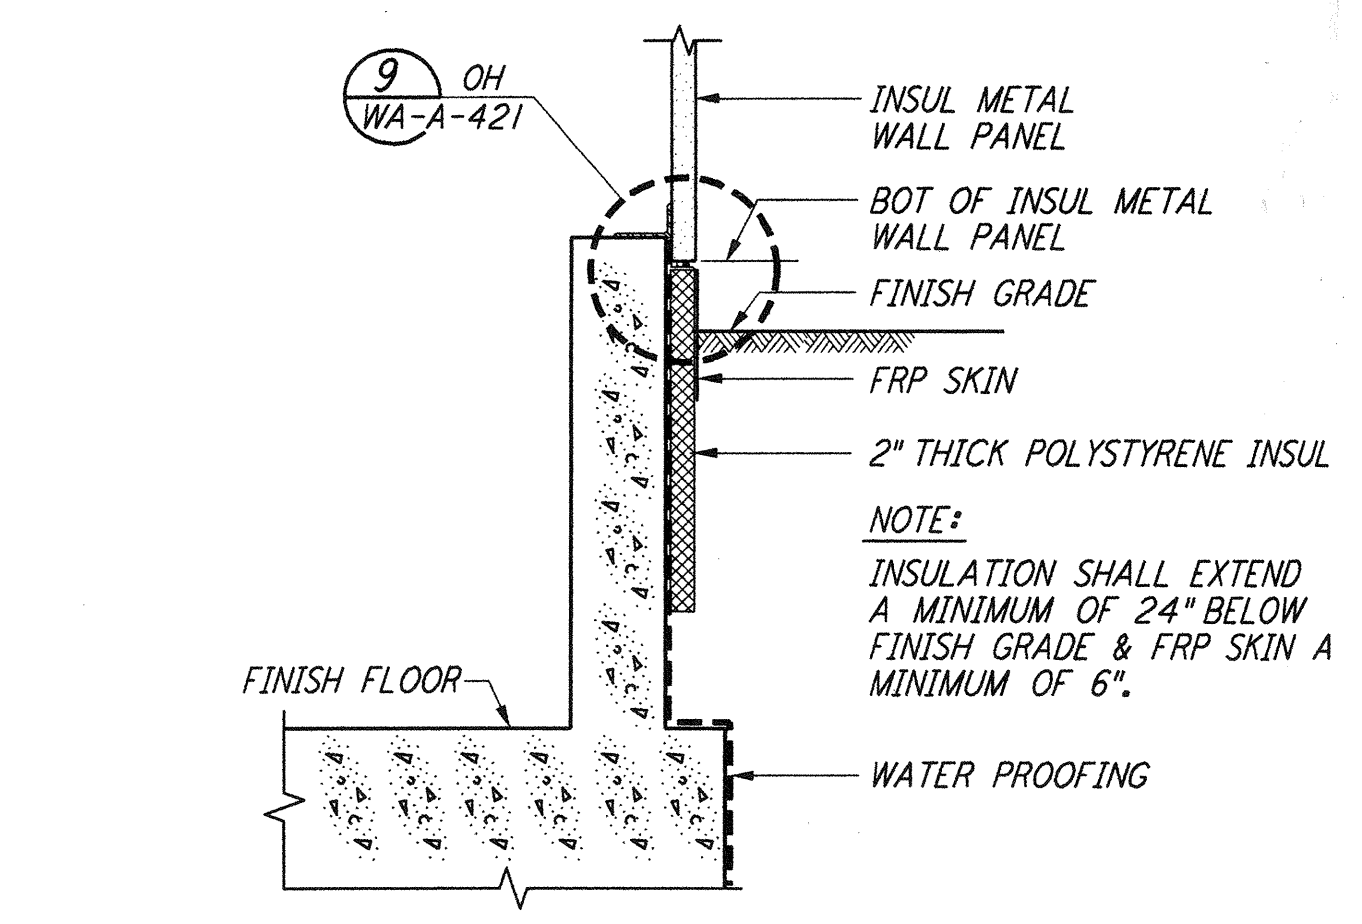


PERIMETER INSUL FOR FDN
 3/4" = 1'-0"

6 REF
 WA-A-424

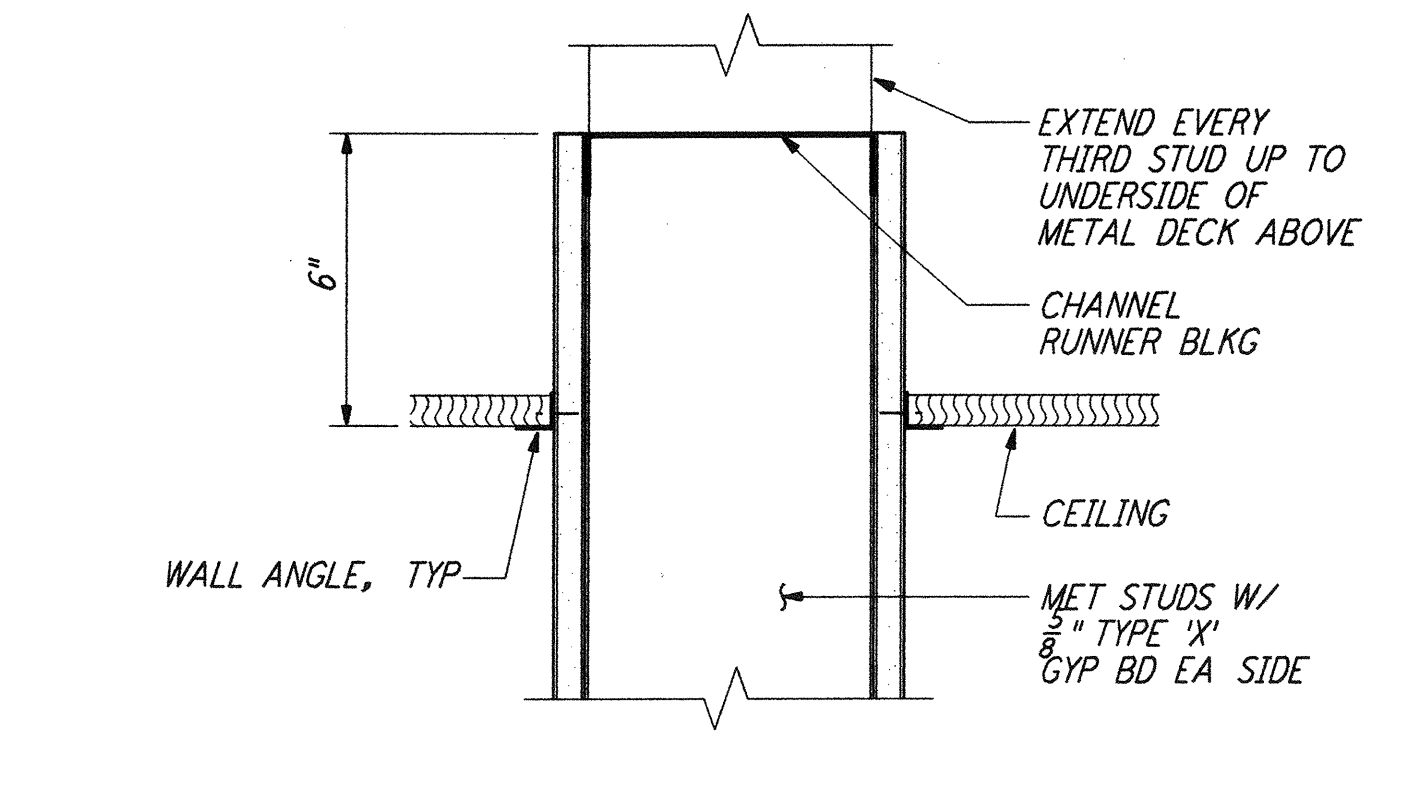


SUSP CLG @ PARTITION DET
 3" = 1'-0"

3 REF
 WA-A-424 WA-A-161
 WA-A-162

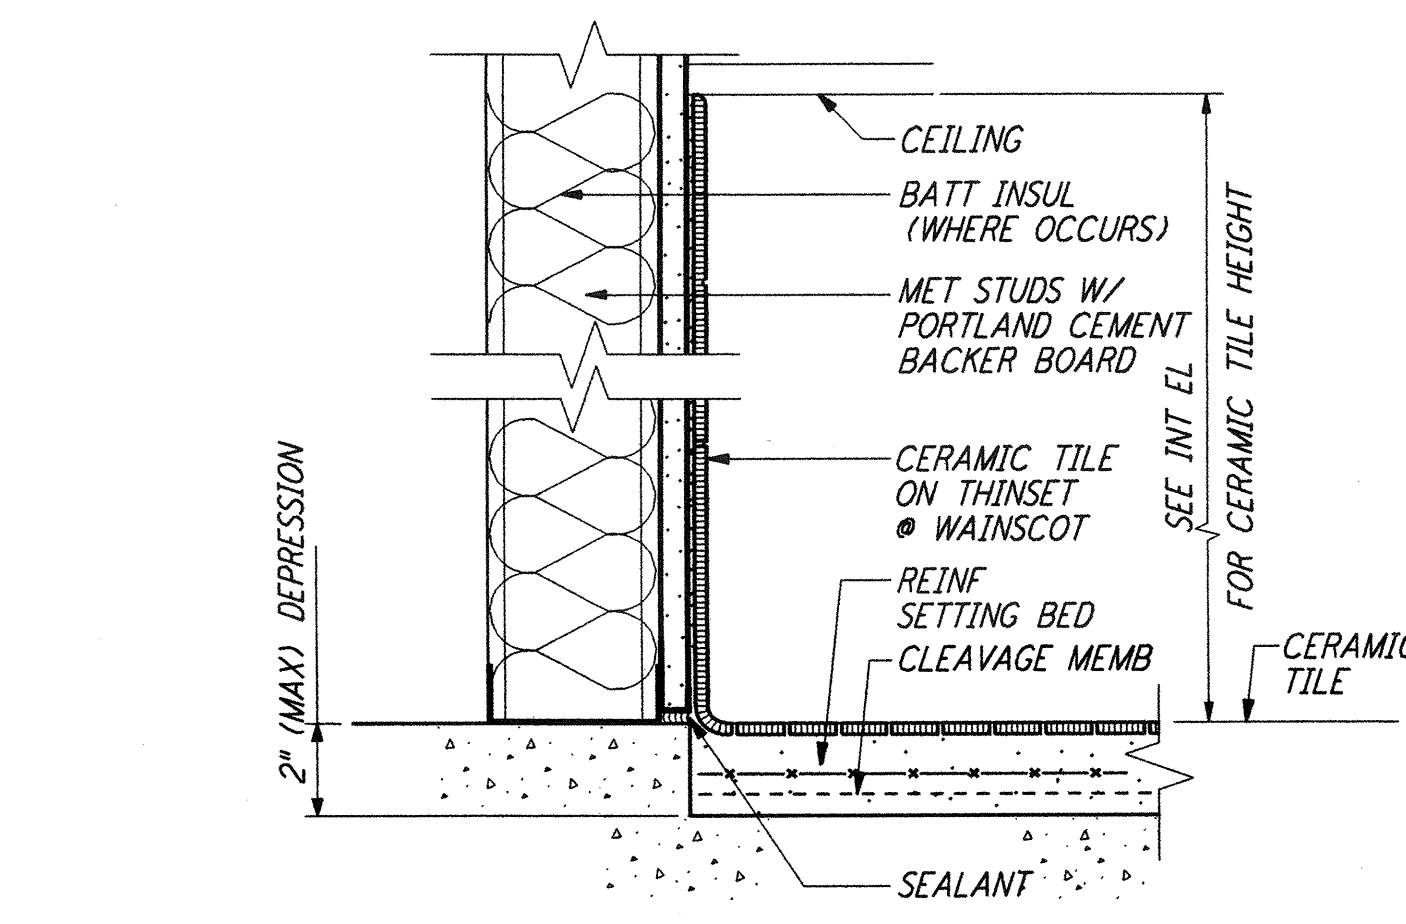


WAINSCOT DETAIL
 3" = 1'-0"

18 REF
 WA-A-424

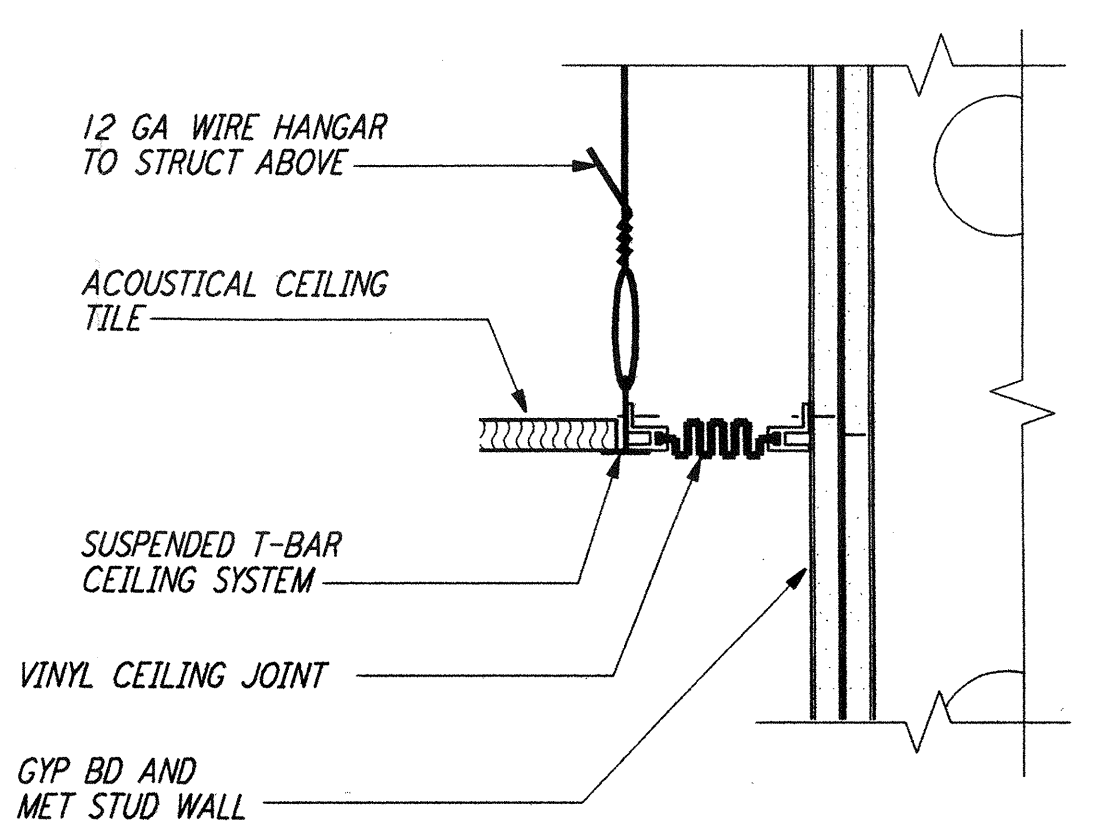


INT CEILING EXPANSION JT
 3" = 1'-0"

15 REF
 WA-A-424 WA-A-163

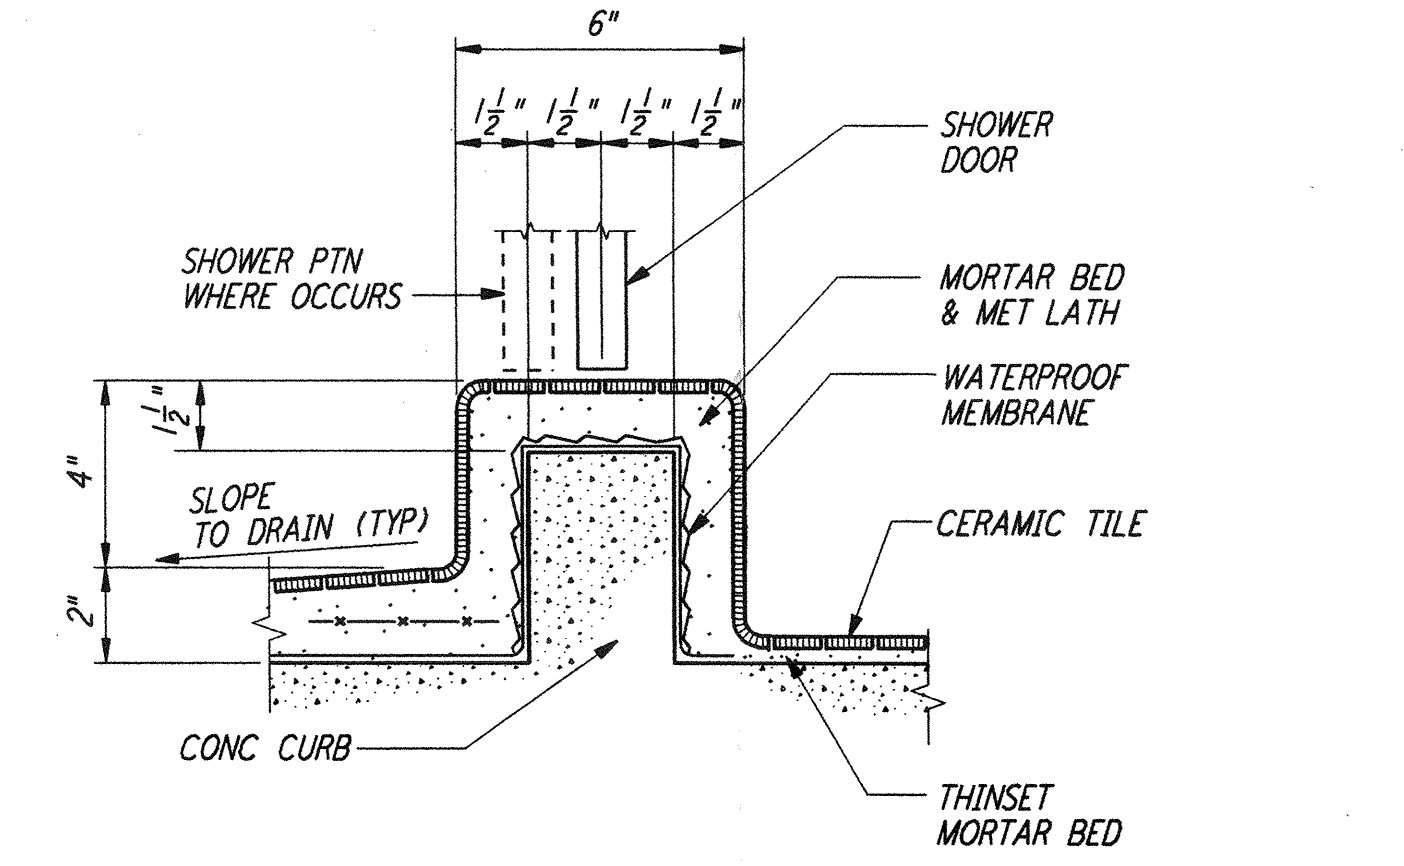


SHOWER CURB DETAIL
 3" = 1'-0"

11 REF
 WA-A-424 WA-A-111

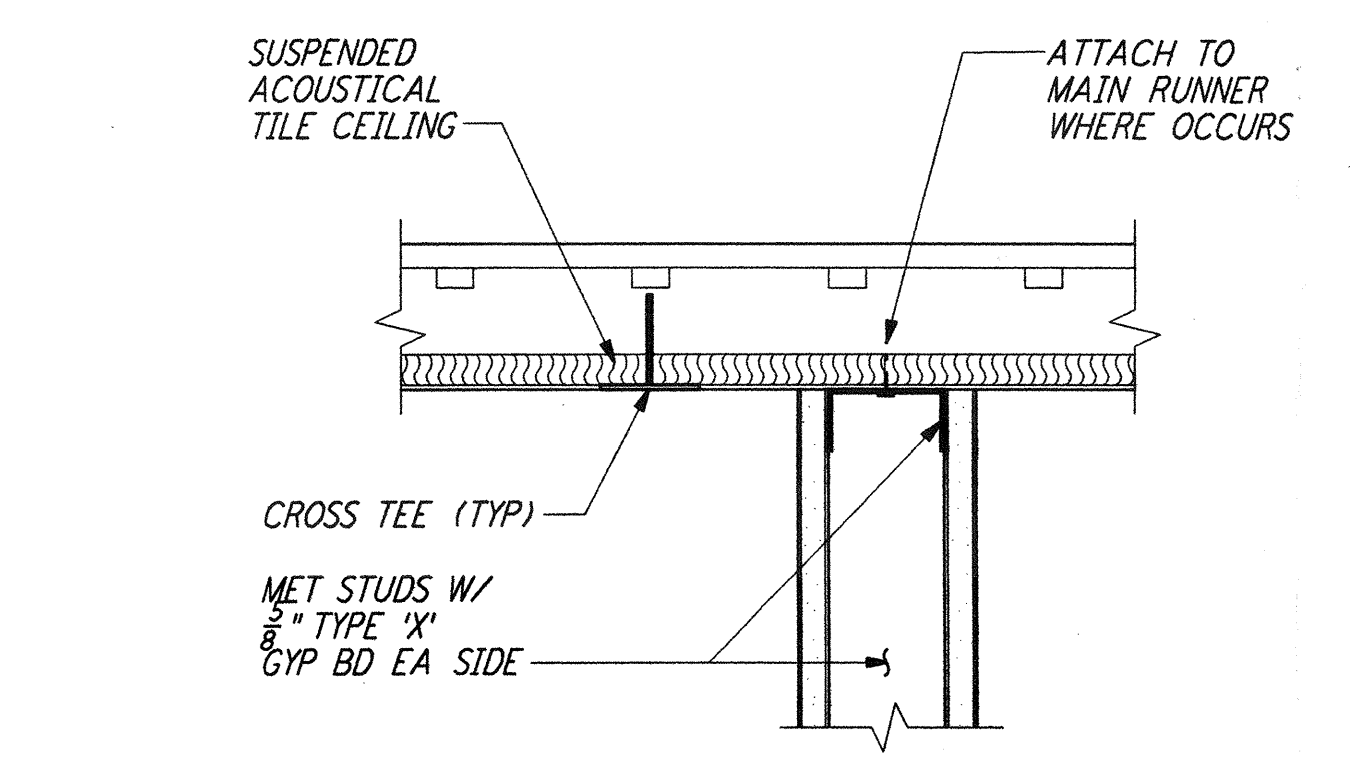

STUD WALL TO CLG DETAIL
 1" = 1'-0"

7 REF
 WA-A-424 WA-A-552
 WA-A-553

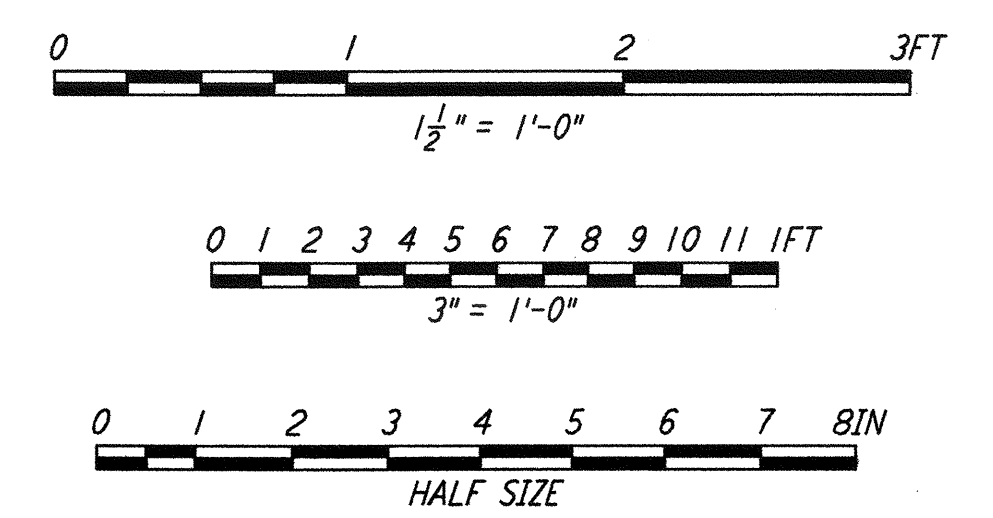

LIGO-D960268-01-0

This document and the design it covers are the property of PARSONS. They are loaned only with the borrower's expressed written agreement that they will not be reproduced, copied, loaned, exhibited, or used in any other way, except by written consent from PARSONS to the borrower.

REFERENCES	REVISIONS	DRAWN	SH/RR	7-12-96				
		CHECKED	TB	5-26-96				
		ENGINEER	bkk	7-12-96				
		PROJ	MWD	7-12-96				
		AS-BUILT DRAWINGS						
		ISSUED FOR AS BUILT						
DRAWING NO.	DESCRIPTION	NO.	DATE	BY	CHKD	ENGR	PROJ	DESCRIPTION
		1	5-15-98	CKT	MM	MM	DL	ISSUED FOR AS BUILT

PARSONS
 100 WEST WALNUT STREET
 PASADENA, CALIFORNIA

LIGO
 CALIFORNIA INSTITUTE OF TECHNOLOGY
 MASSACHUSETTS INSTITUTE OF TECHNOLOGY

LASER INTERFEROMETER
 GRAVITATIONAL-WAVE OBSERVATORY
 SITE NO. 1 - HANFORD, WASHINGTON

ARCHITECTURAL
 CEILING & MISCELLANEOUS
 INTERIOR DETAILS

AS NOTED
 PP150969
 8094

WA-A-424

Thu Jun 04 17:45:43 1998 C:\PLOT\IGOS33\9802\001F 52085 K:\V3862\ar424.prf LIGOWAF.BDR