




This document and the design it covers are the property of PARSONS. They are loaned only with the borrower's expressed written agreement that they will not be reproduced, copied, loaned, exhibited, or used in any other way, except by written consent from PARSONS to the borrower.

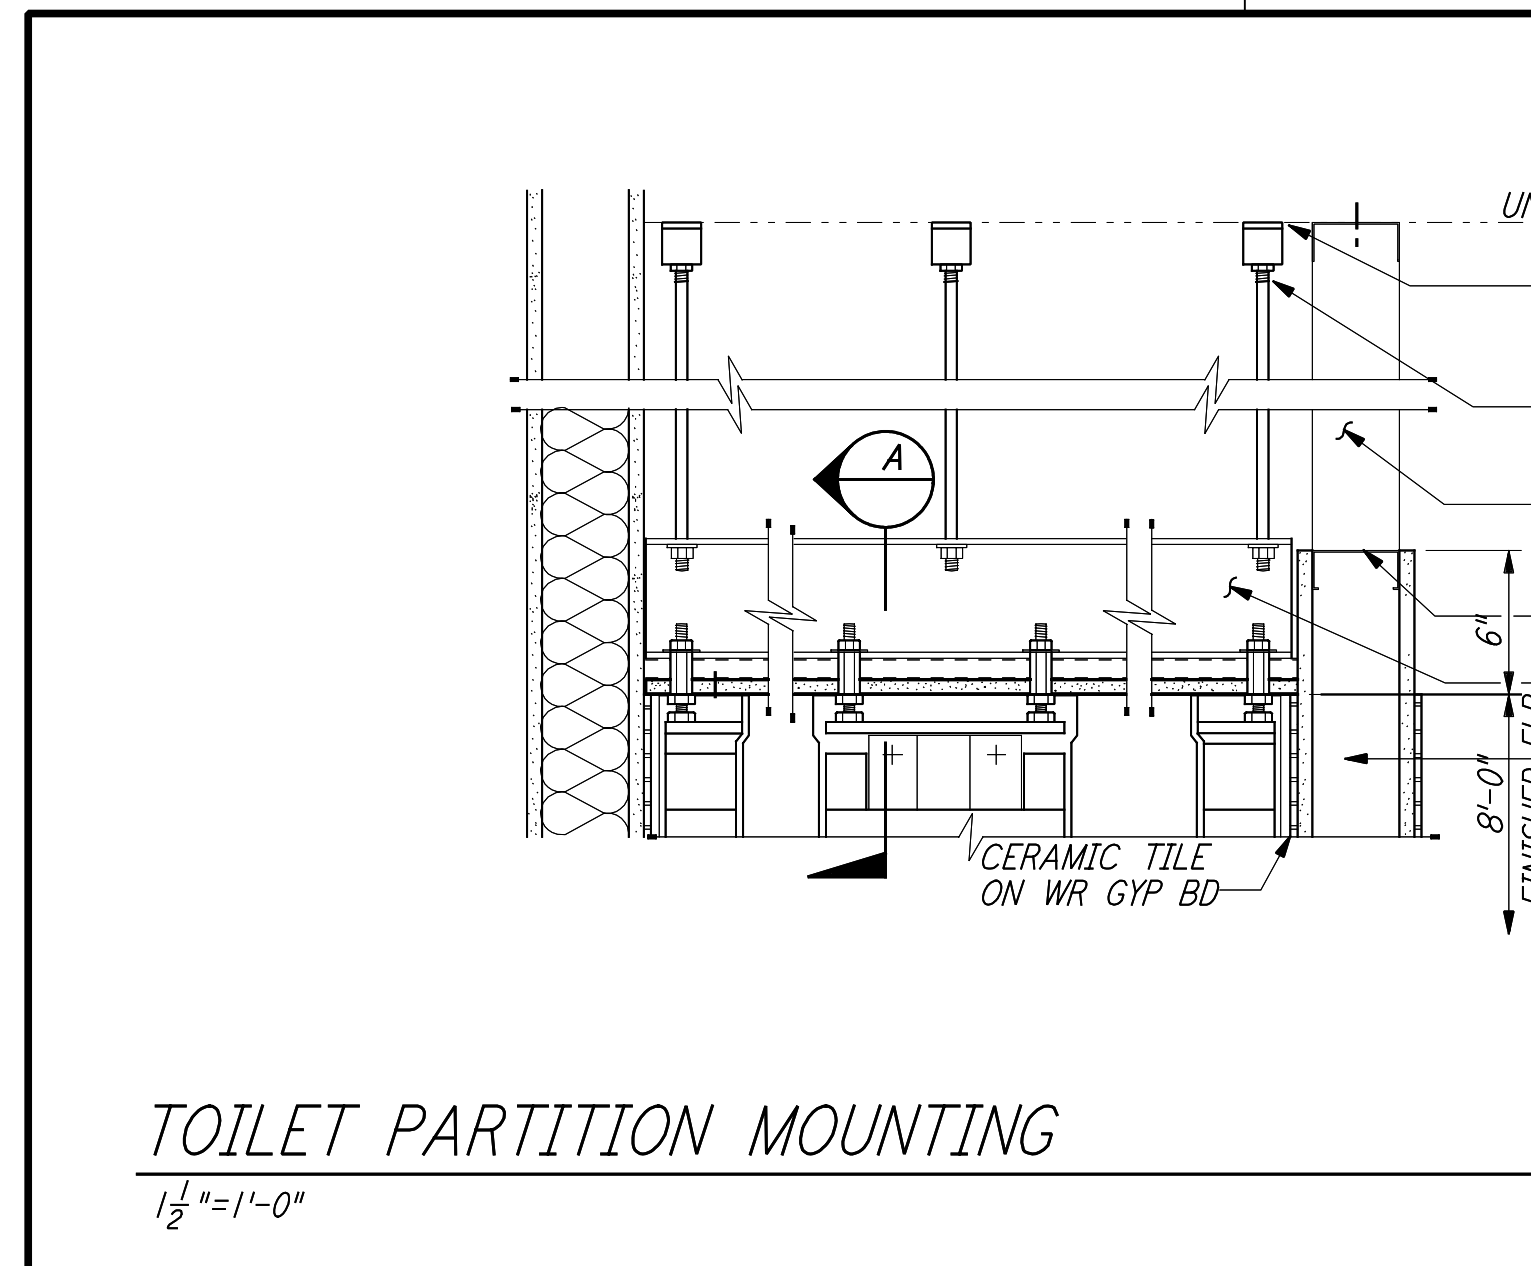


**TOILET PARTITION MOUNTING**  
 1 1/2" = 1'-0"

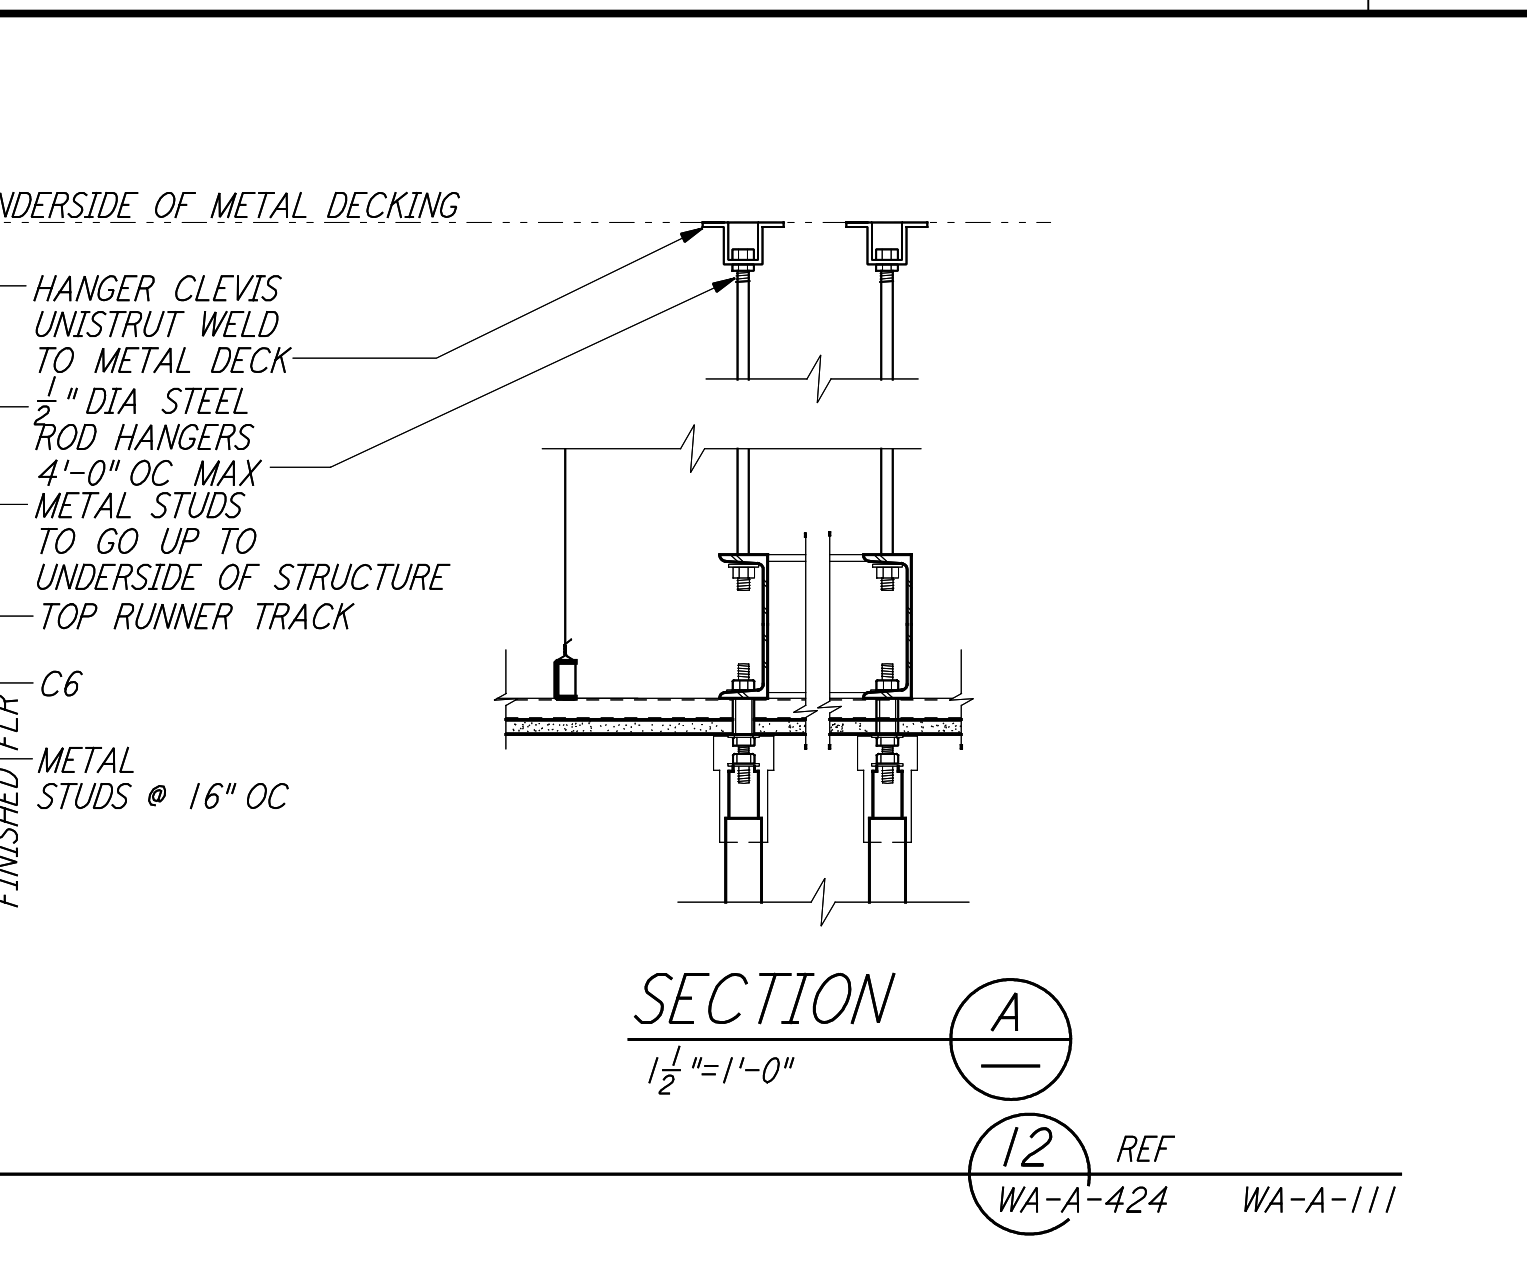


**LVEA VESTIBULE**  
 1 1/2" = 1'-0"

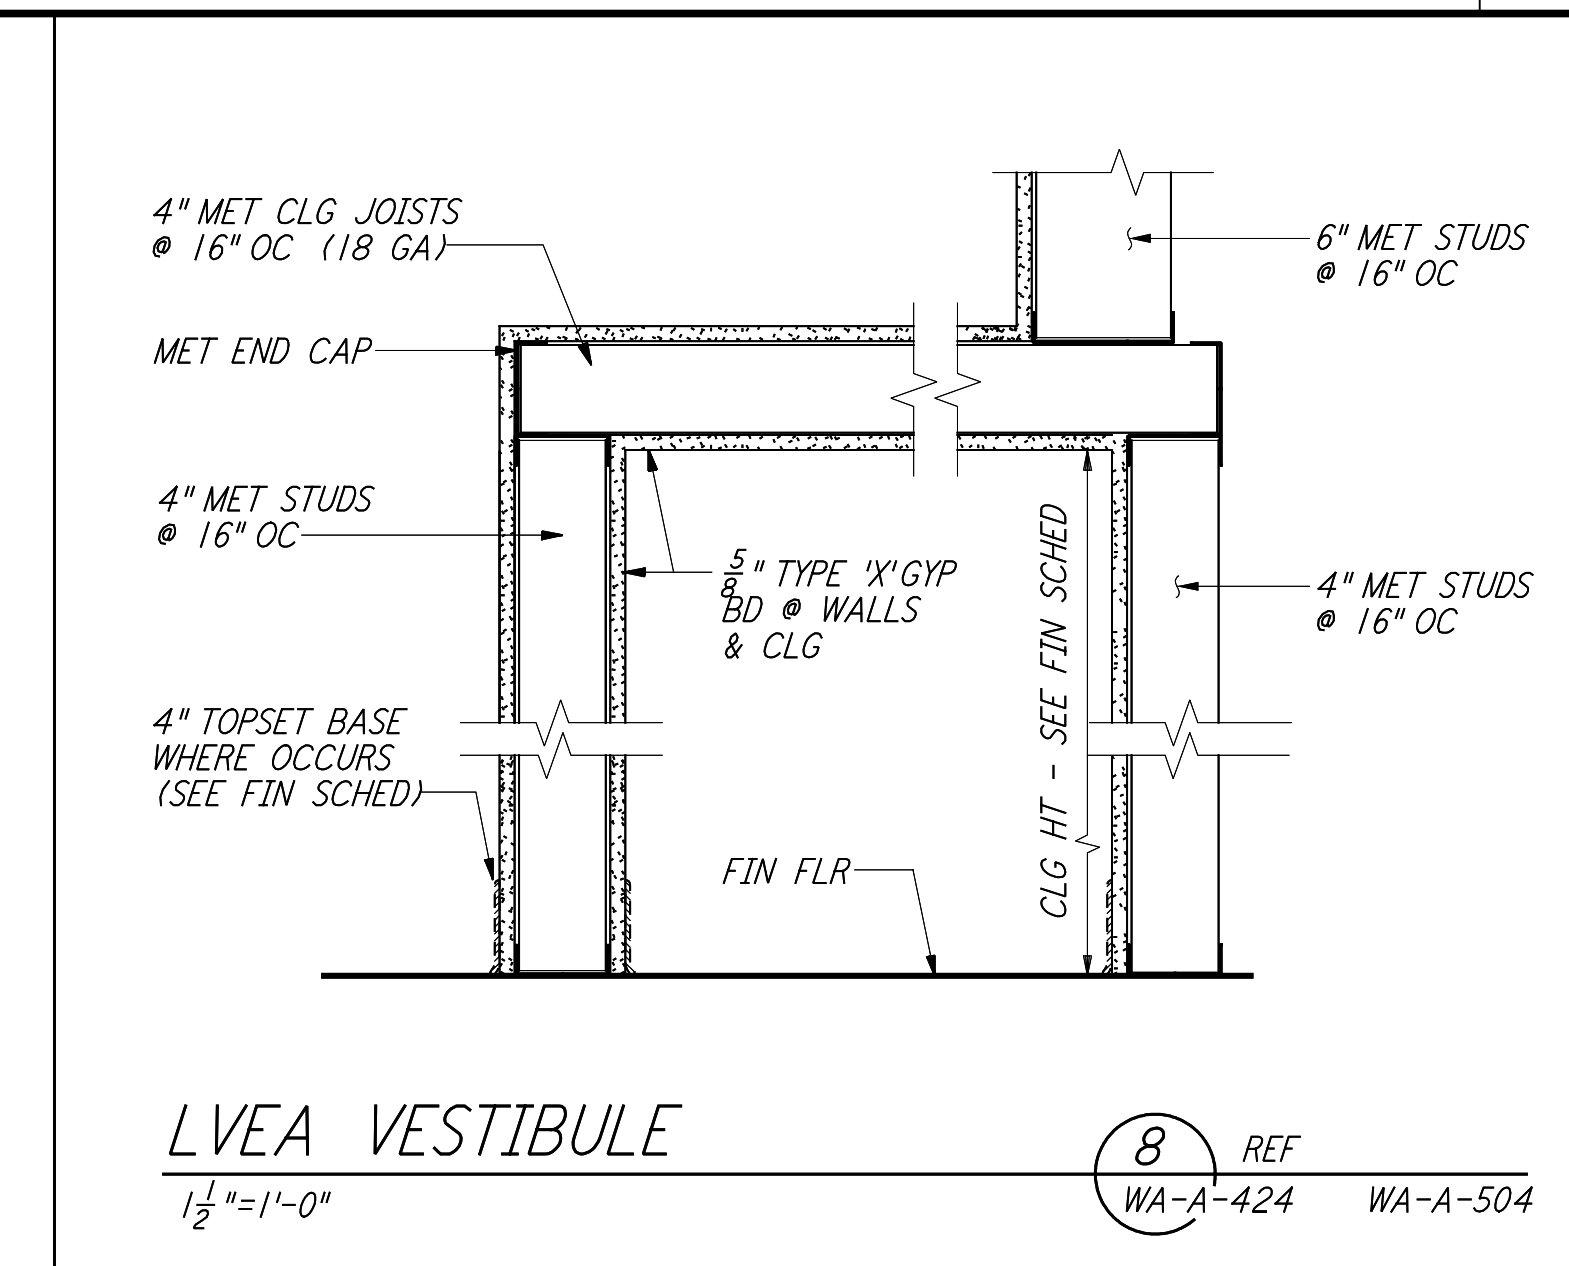


**SUSP ACOUSTICAL CLG DET**  
 3" = 1'-0"

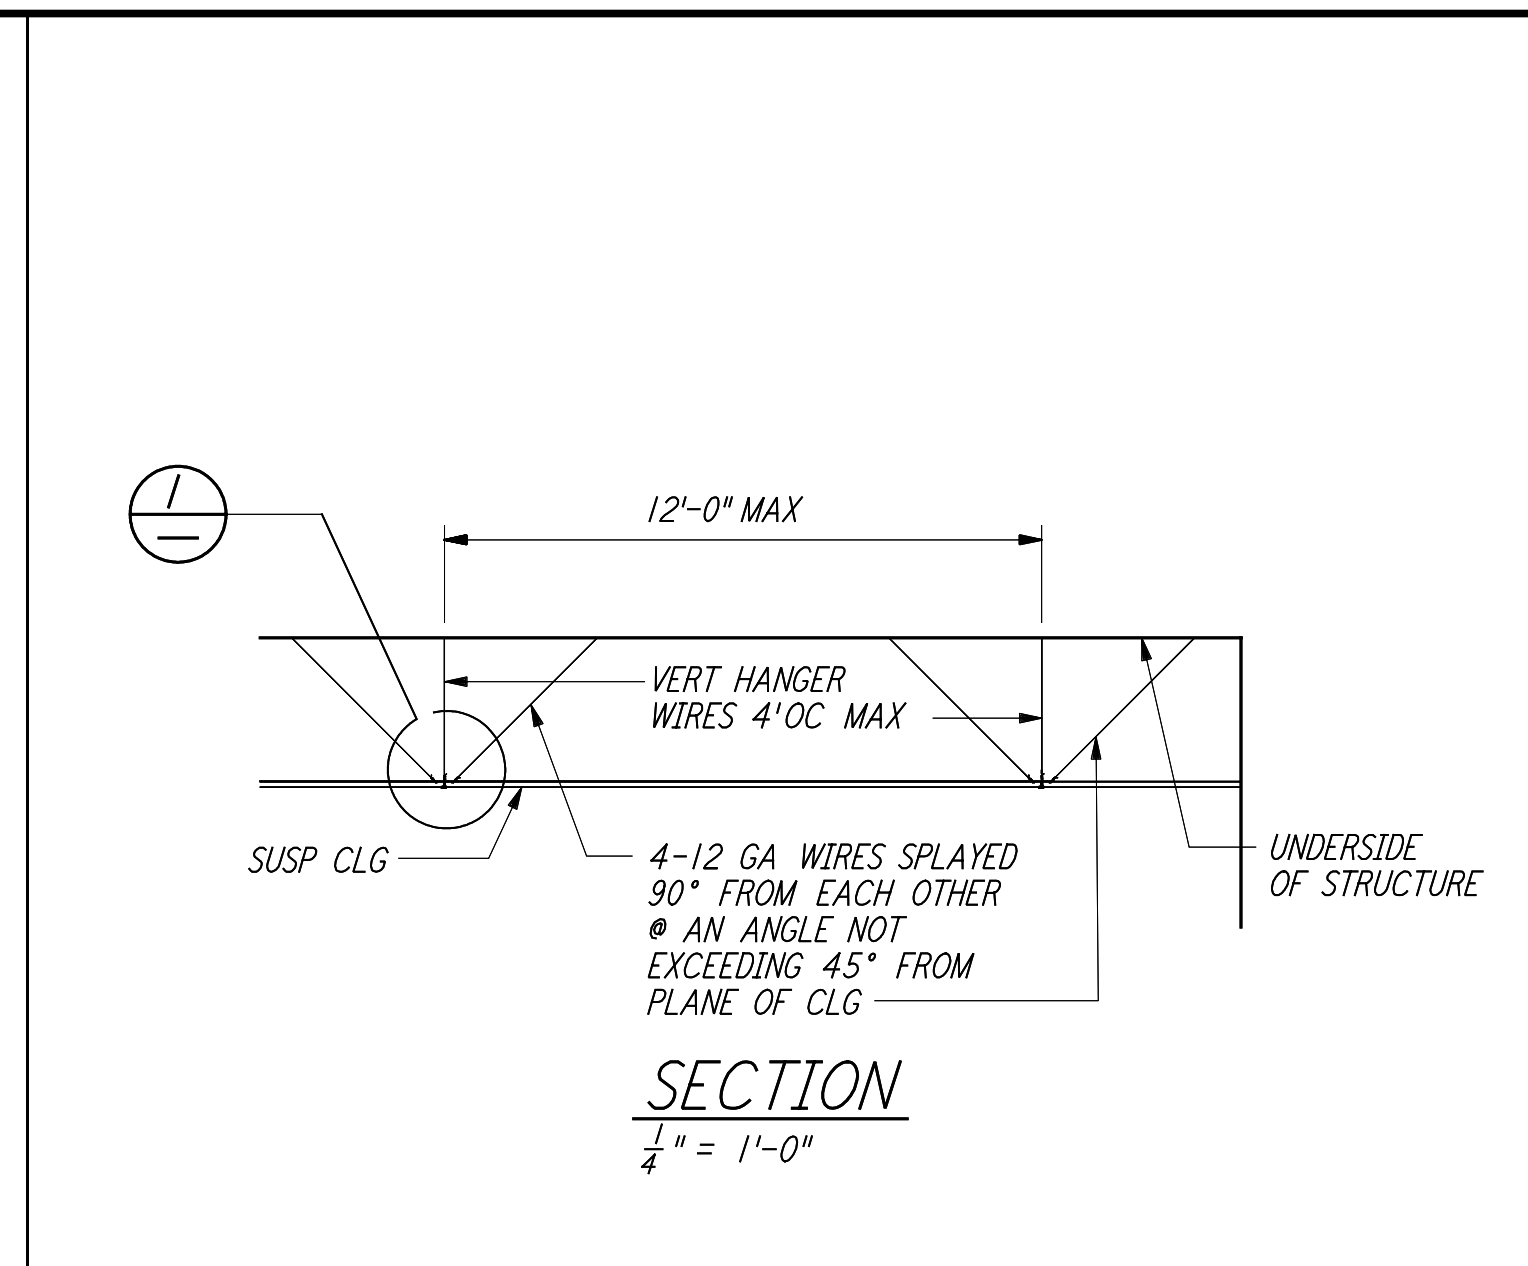


**TOILET PARTITION MOUNTING**  
 3" = 1'-0"

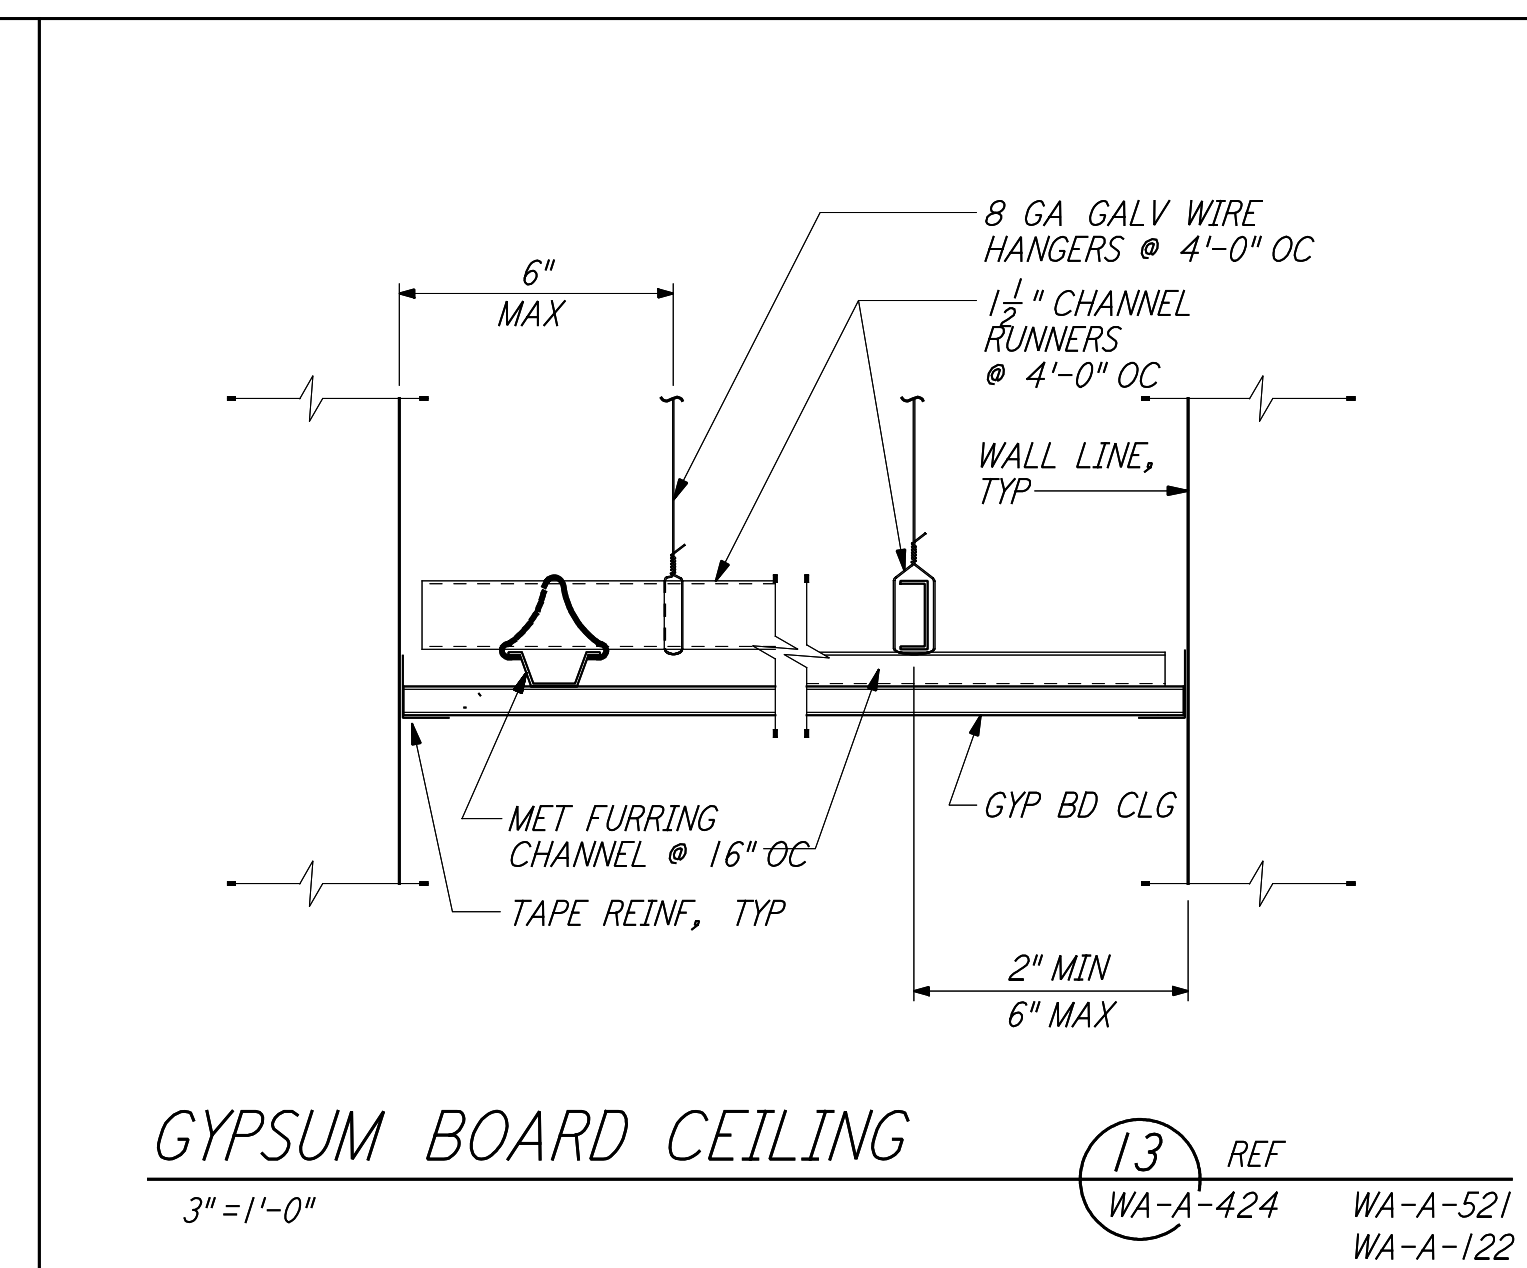


**GYPSUM BOARD CEILING**  
 3" = 1'-0"

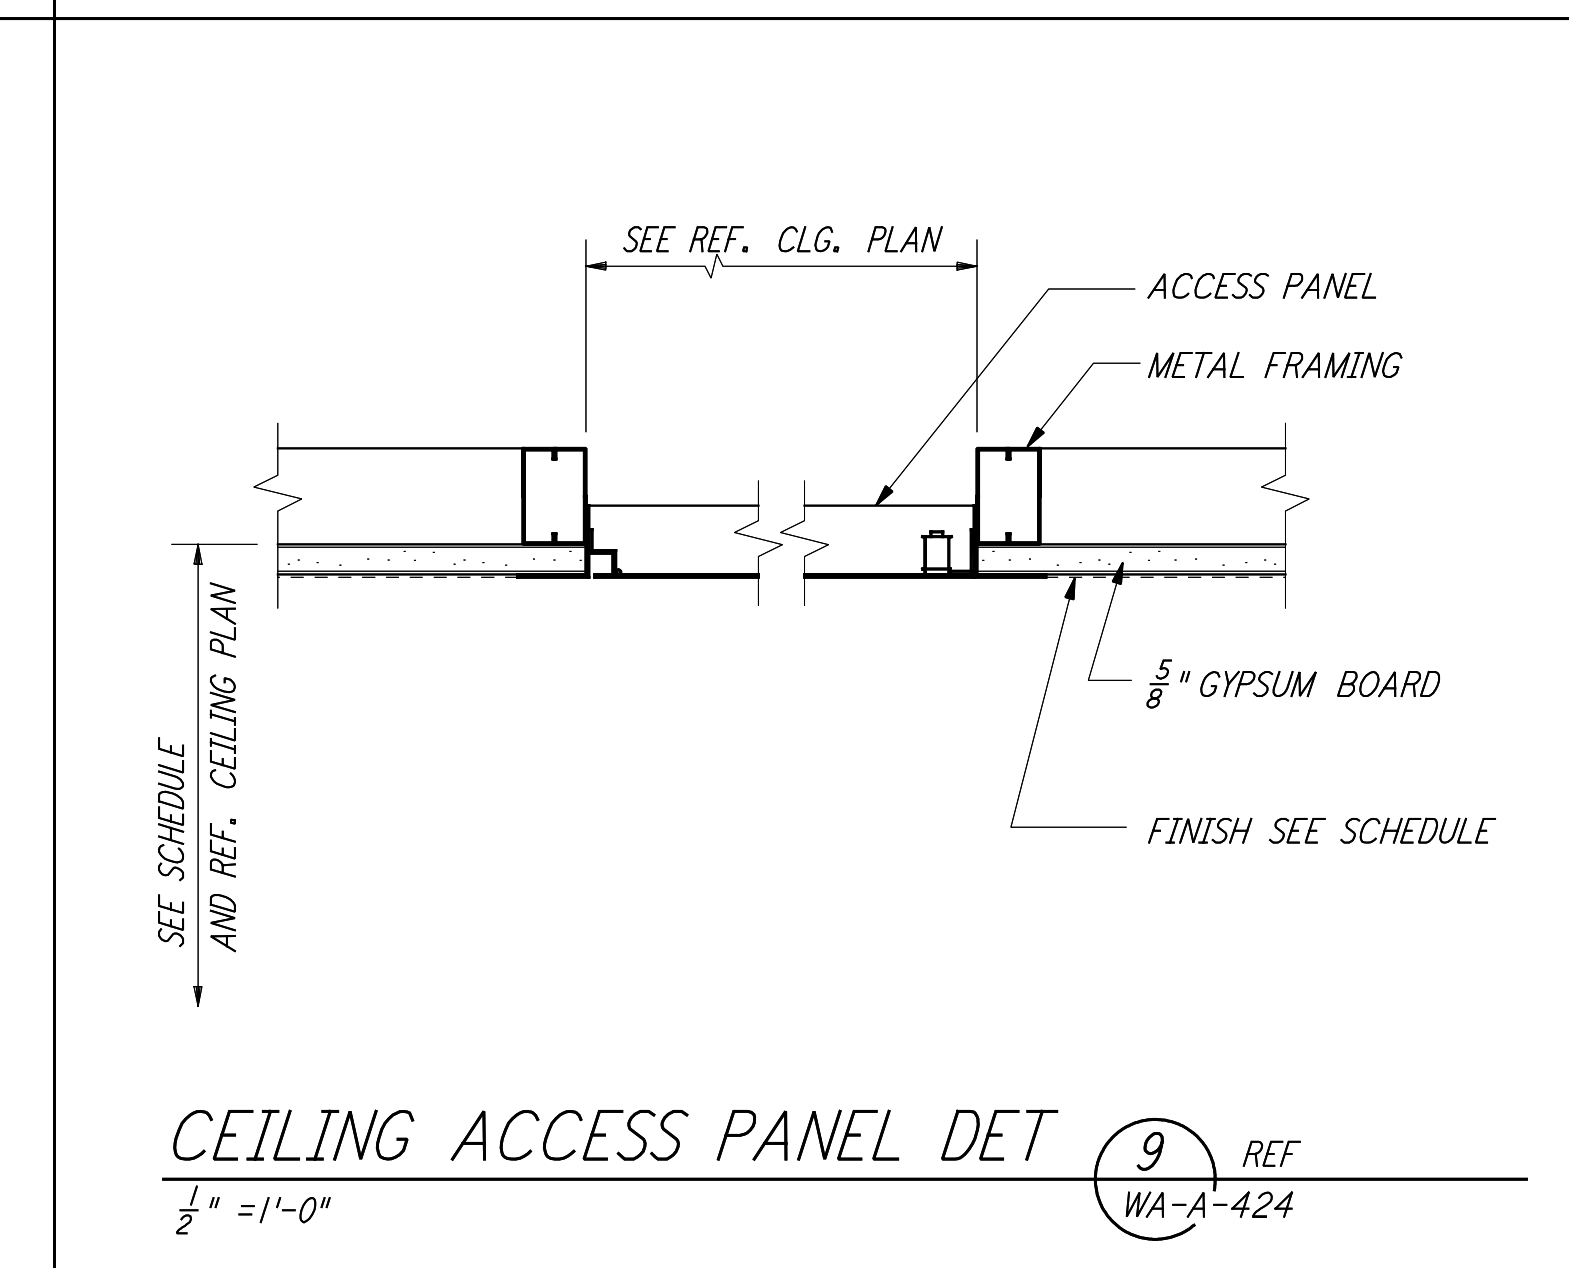


**CEILING ACCESS PANEL DET**  
 1/2" = 1'-0"

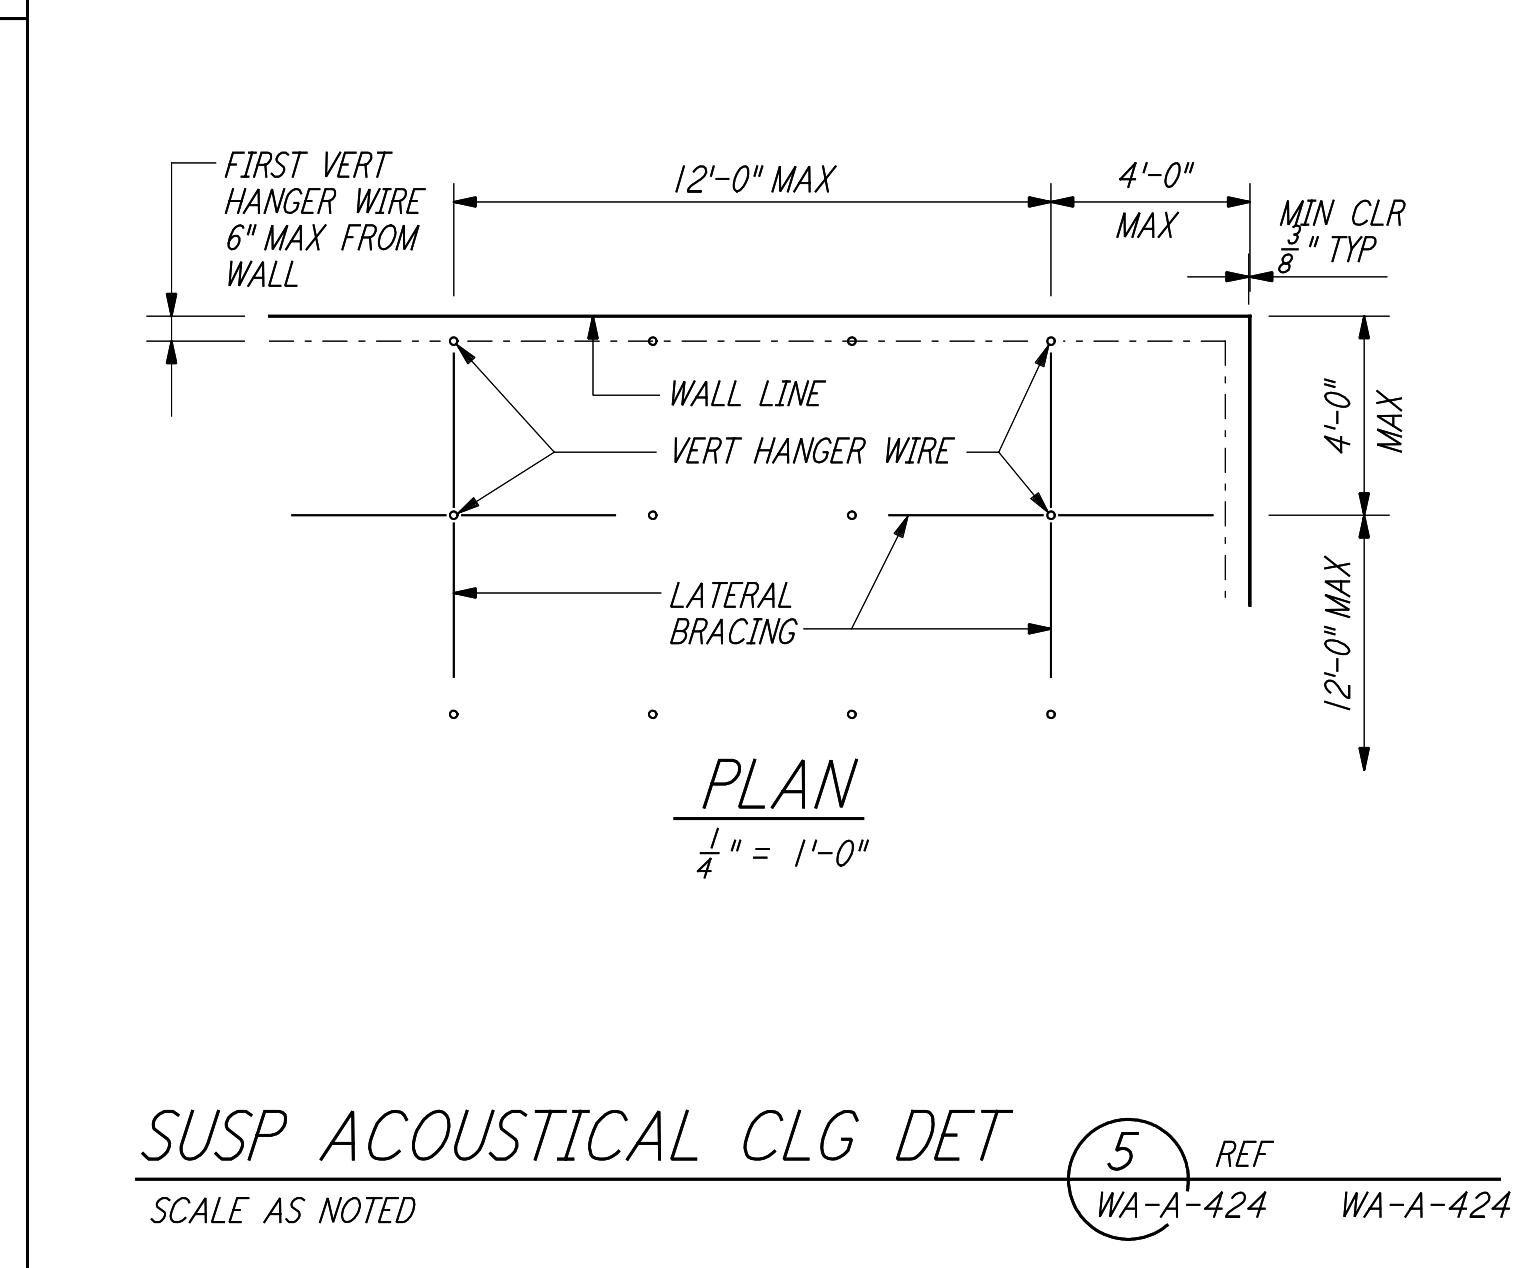


**SUSP ACOUSTICAL CLG DET**  
 SCALE AS NOTED

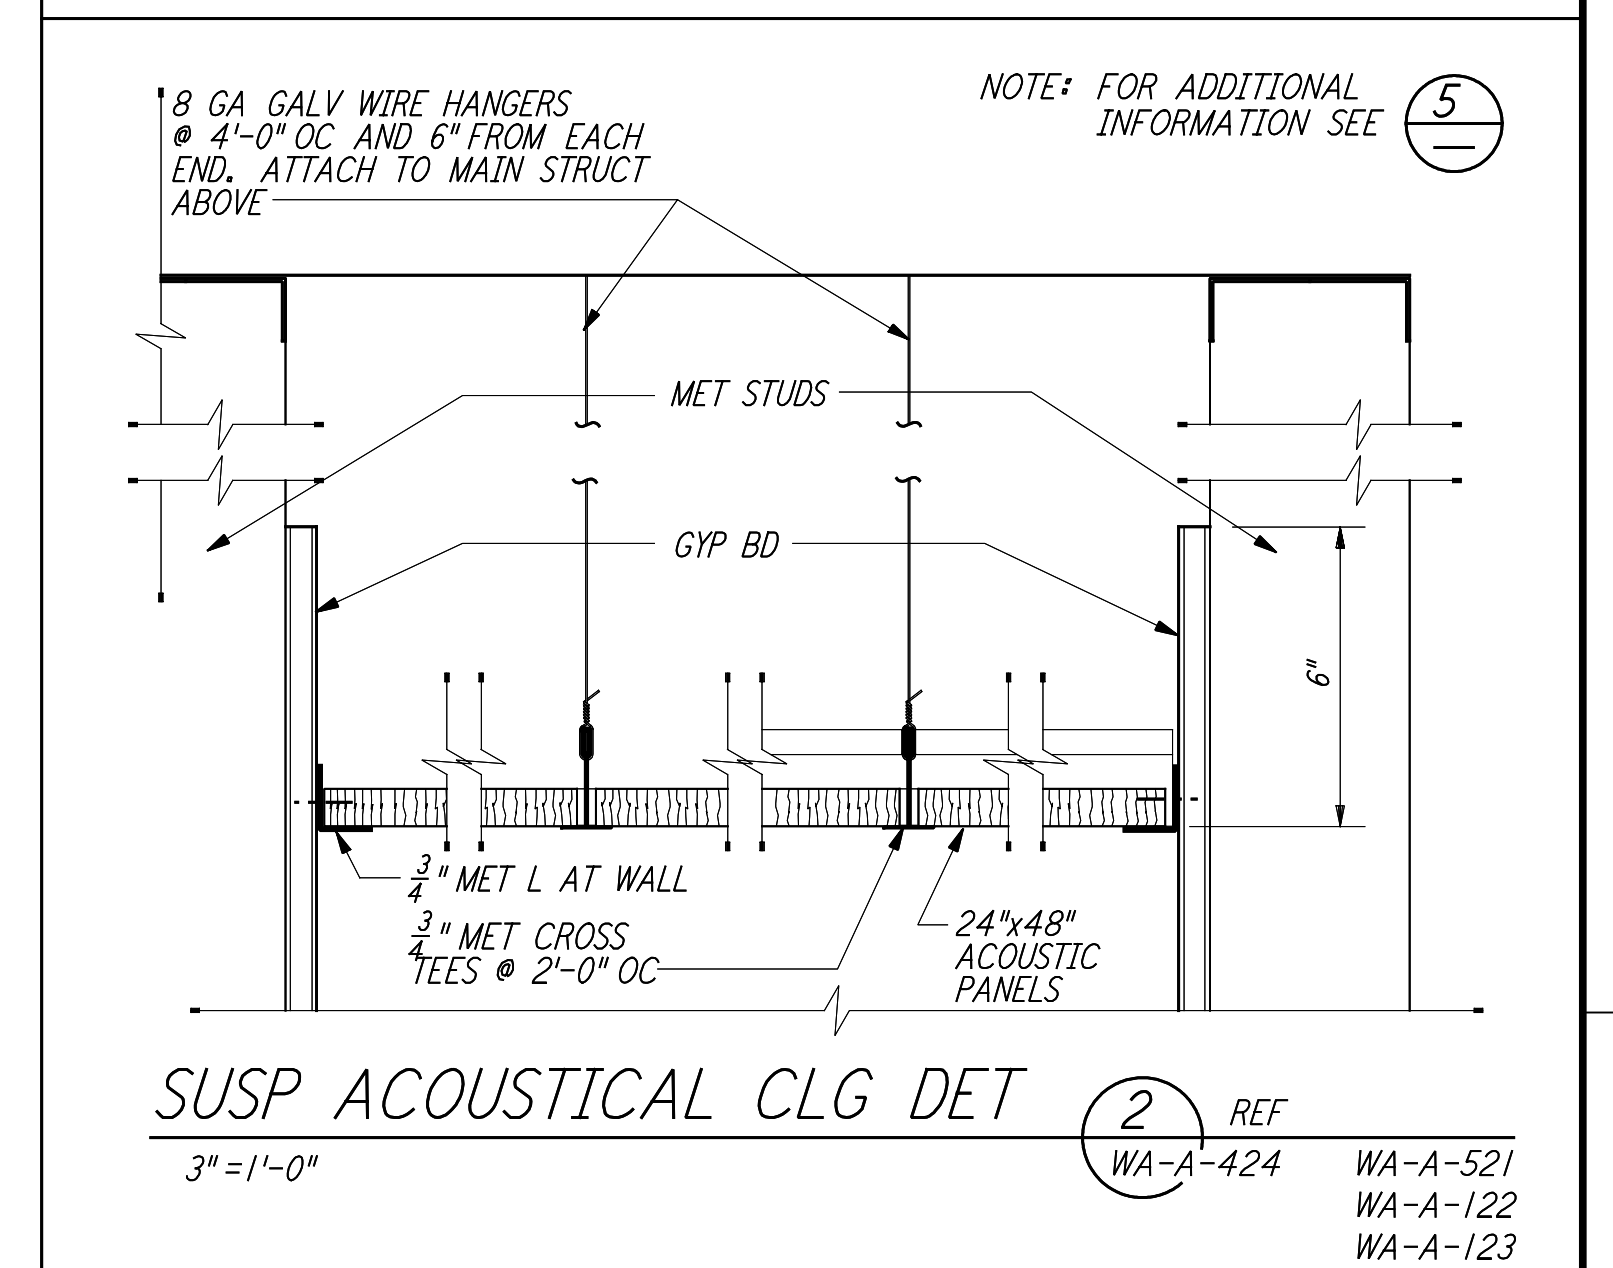


**SUSP ACOUSTICAL CLG DET**  
 3" = 1'-0"

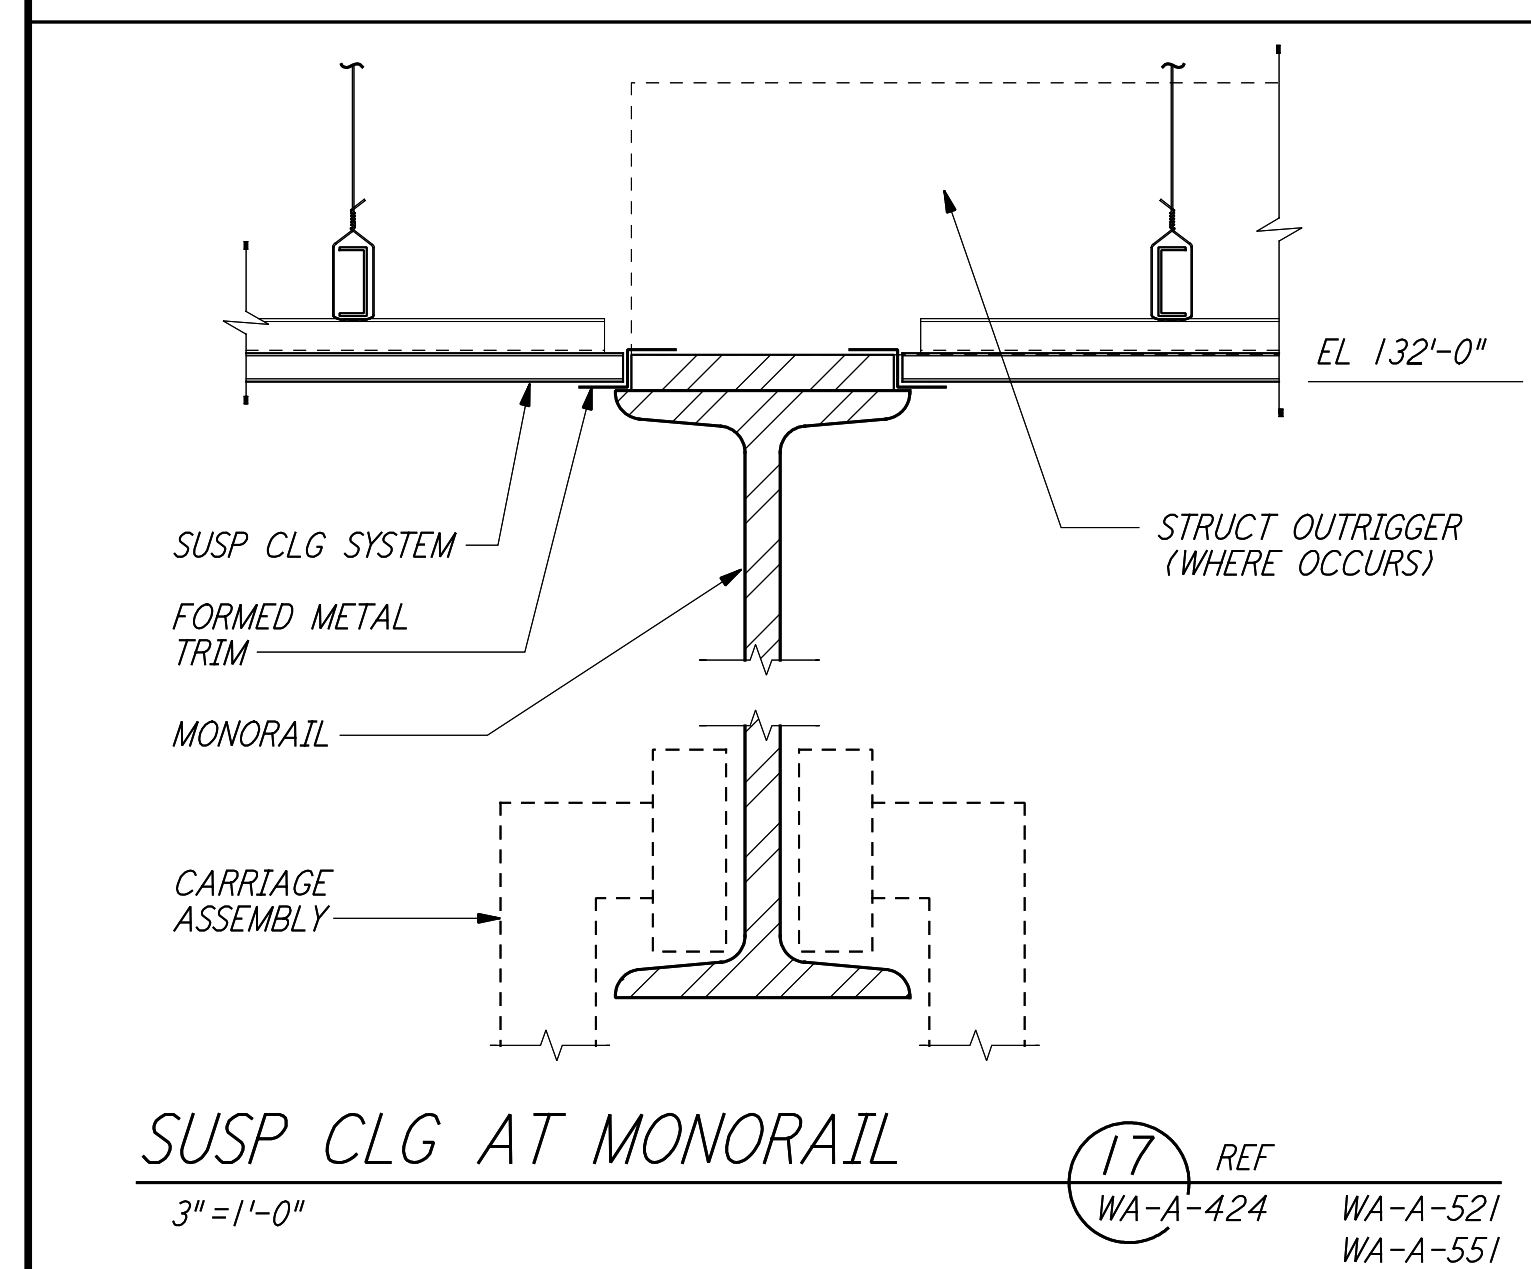


**SUSP CLG AT MONORAIL**  
 3" = 1'-0"

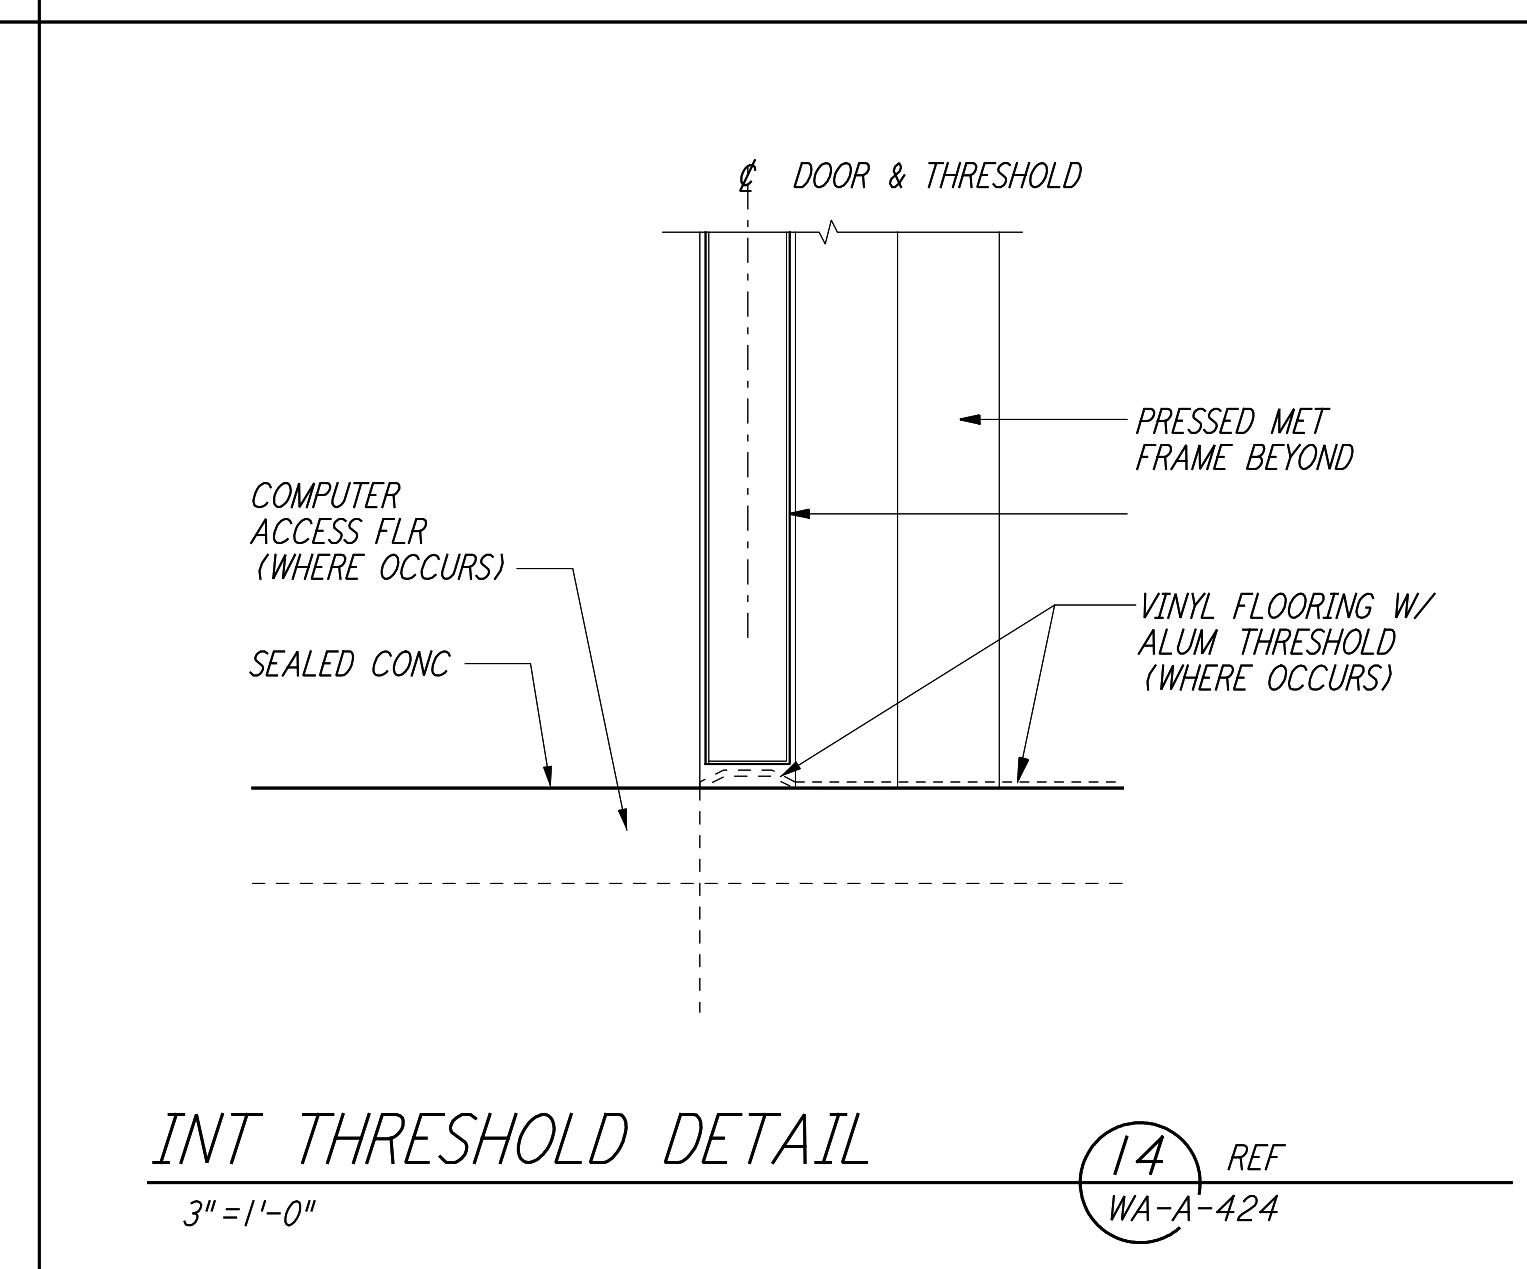


**INT THRESHOLD DETAIL**  
 3" = 1'-0"

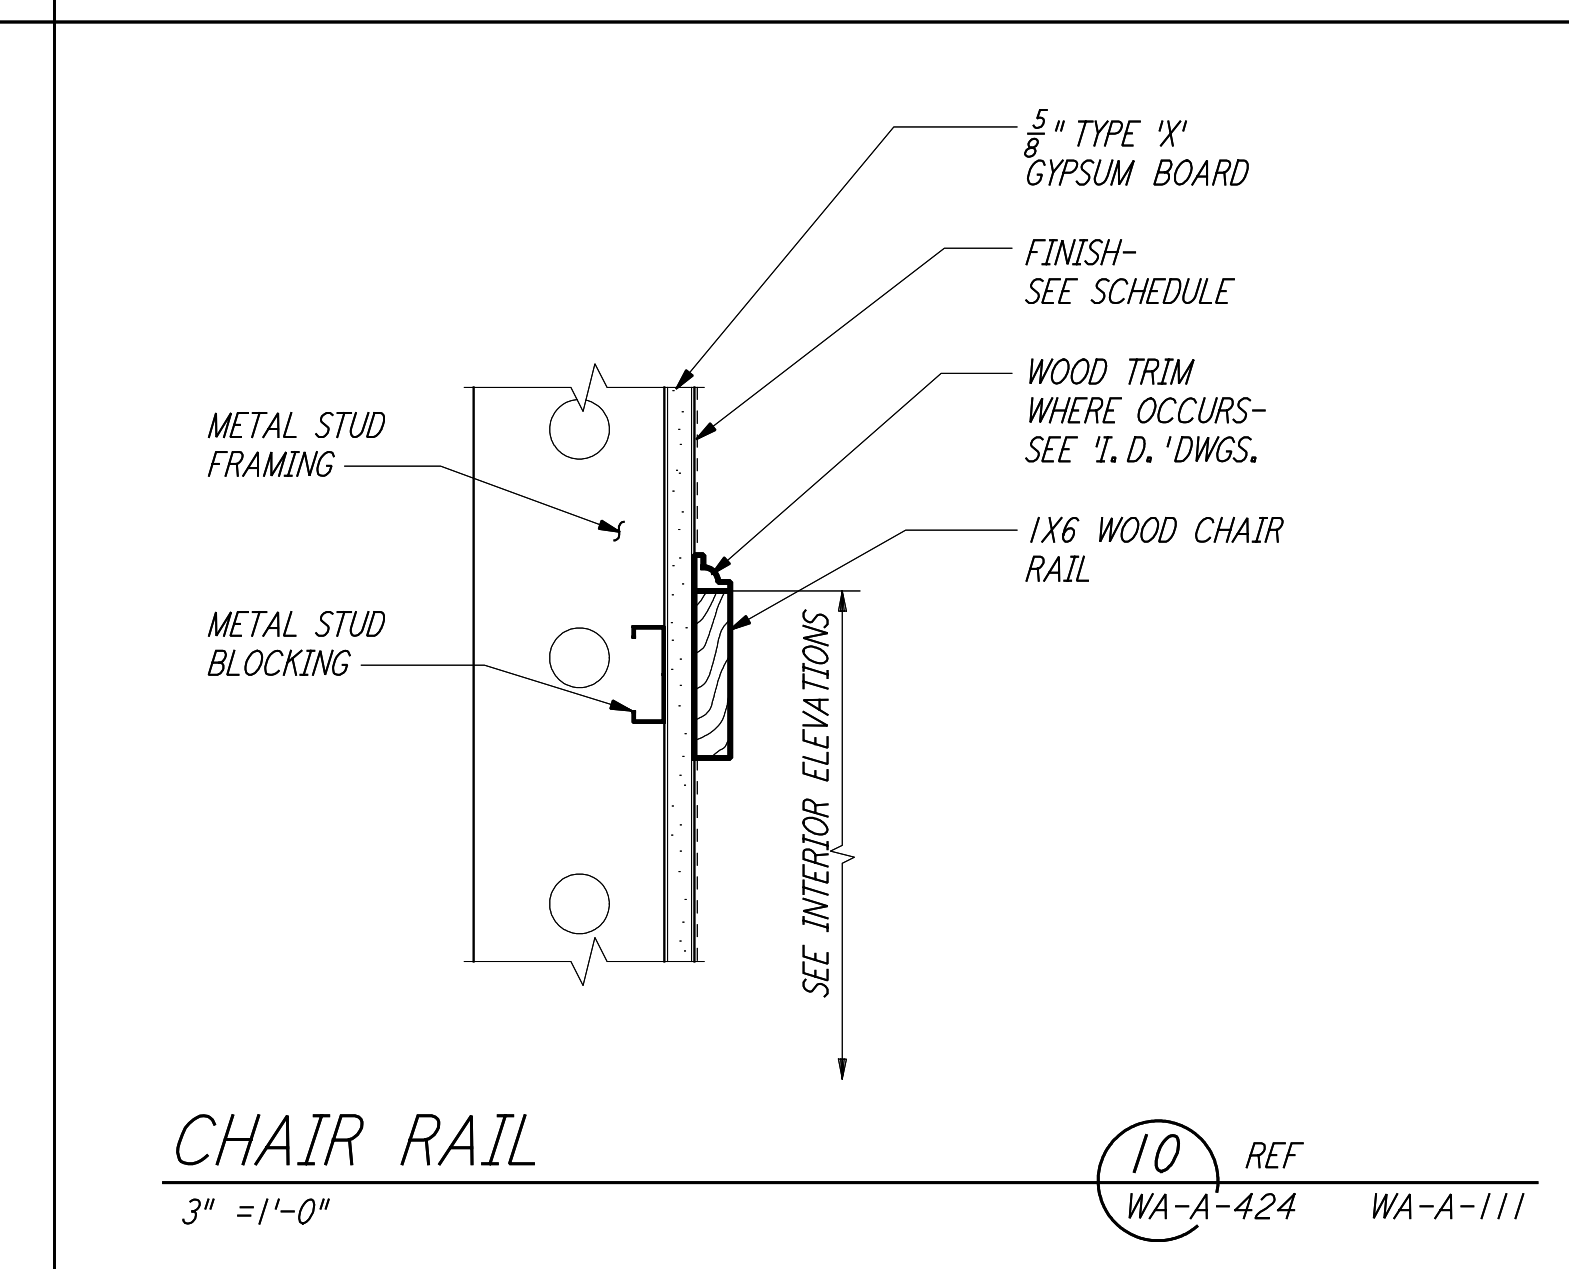


**CHAIR RAIL**  
 3" = 1'-0"

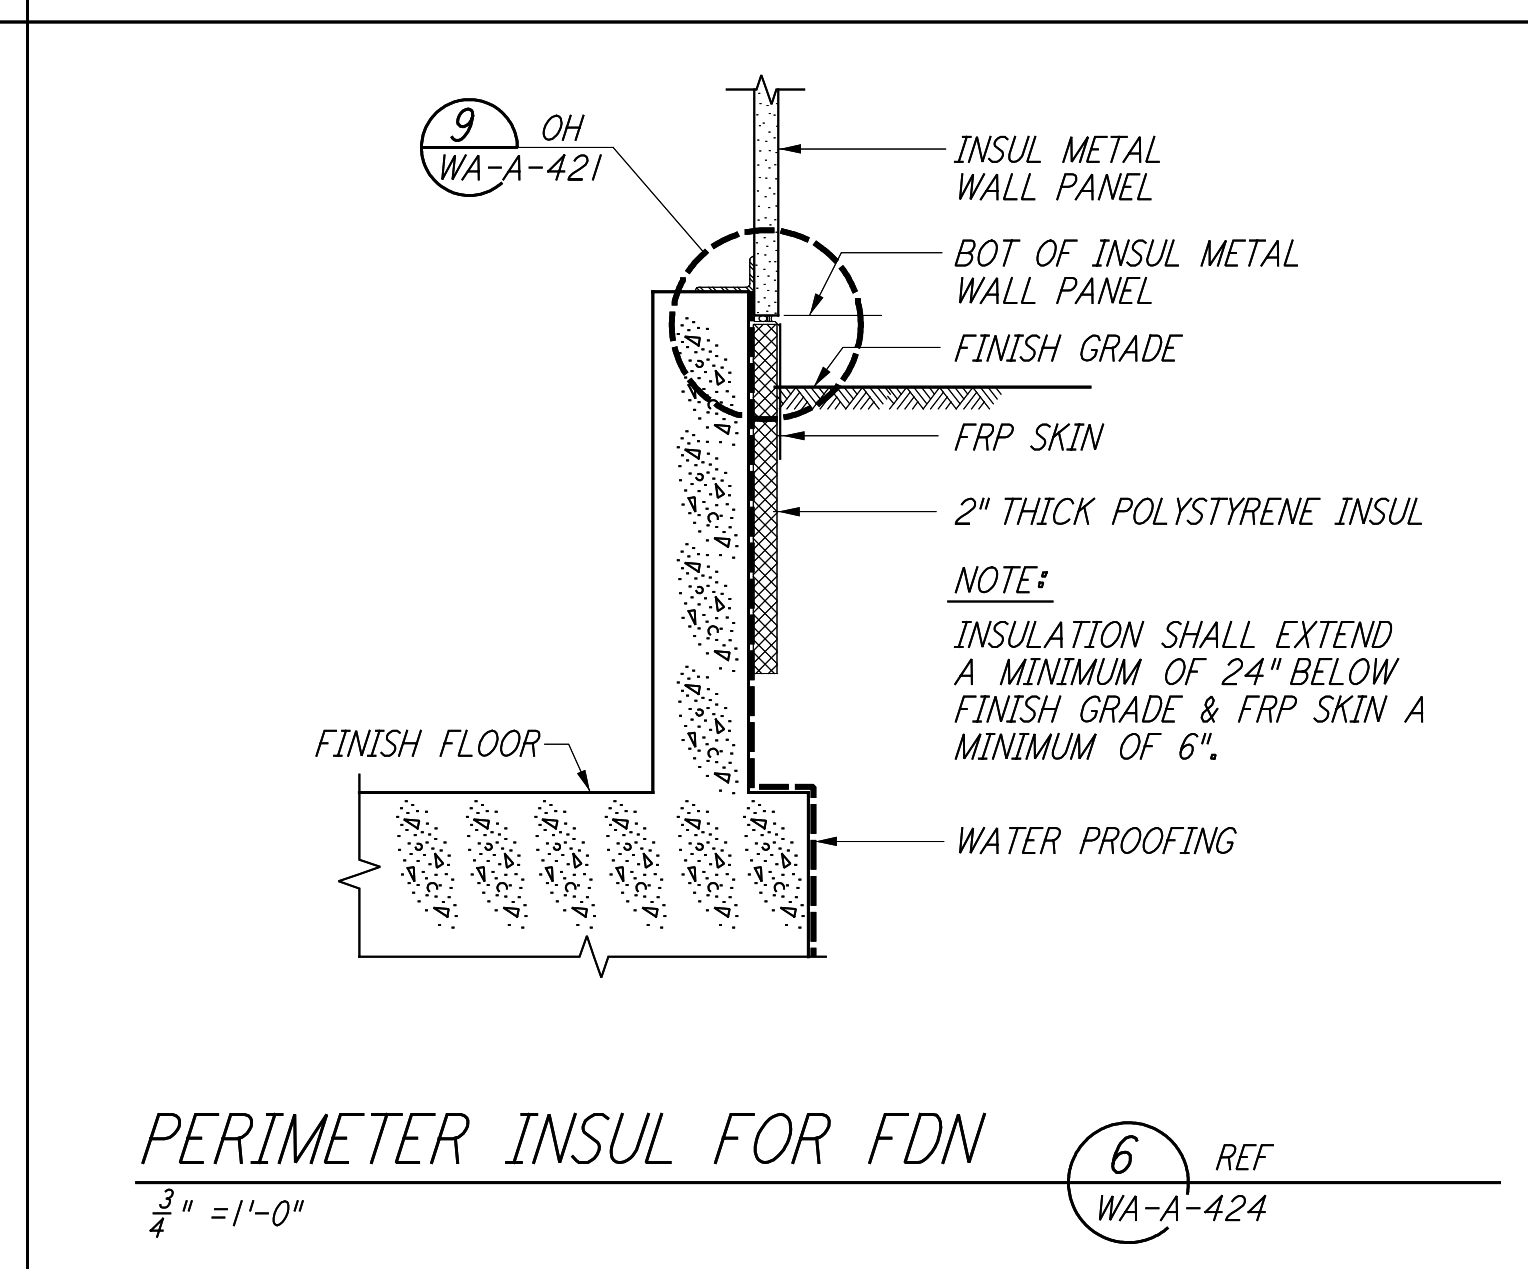


**PERIMETER INSUL FOR FDN**  
 3/4" = 1'-0"

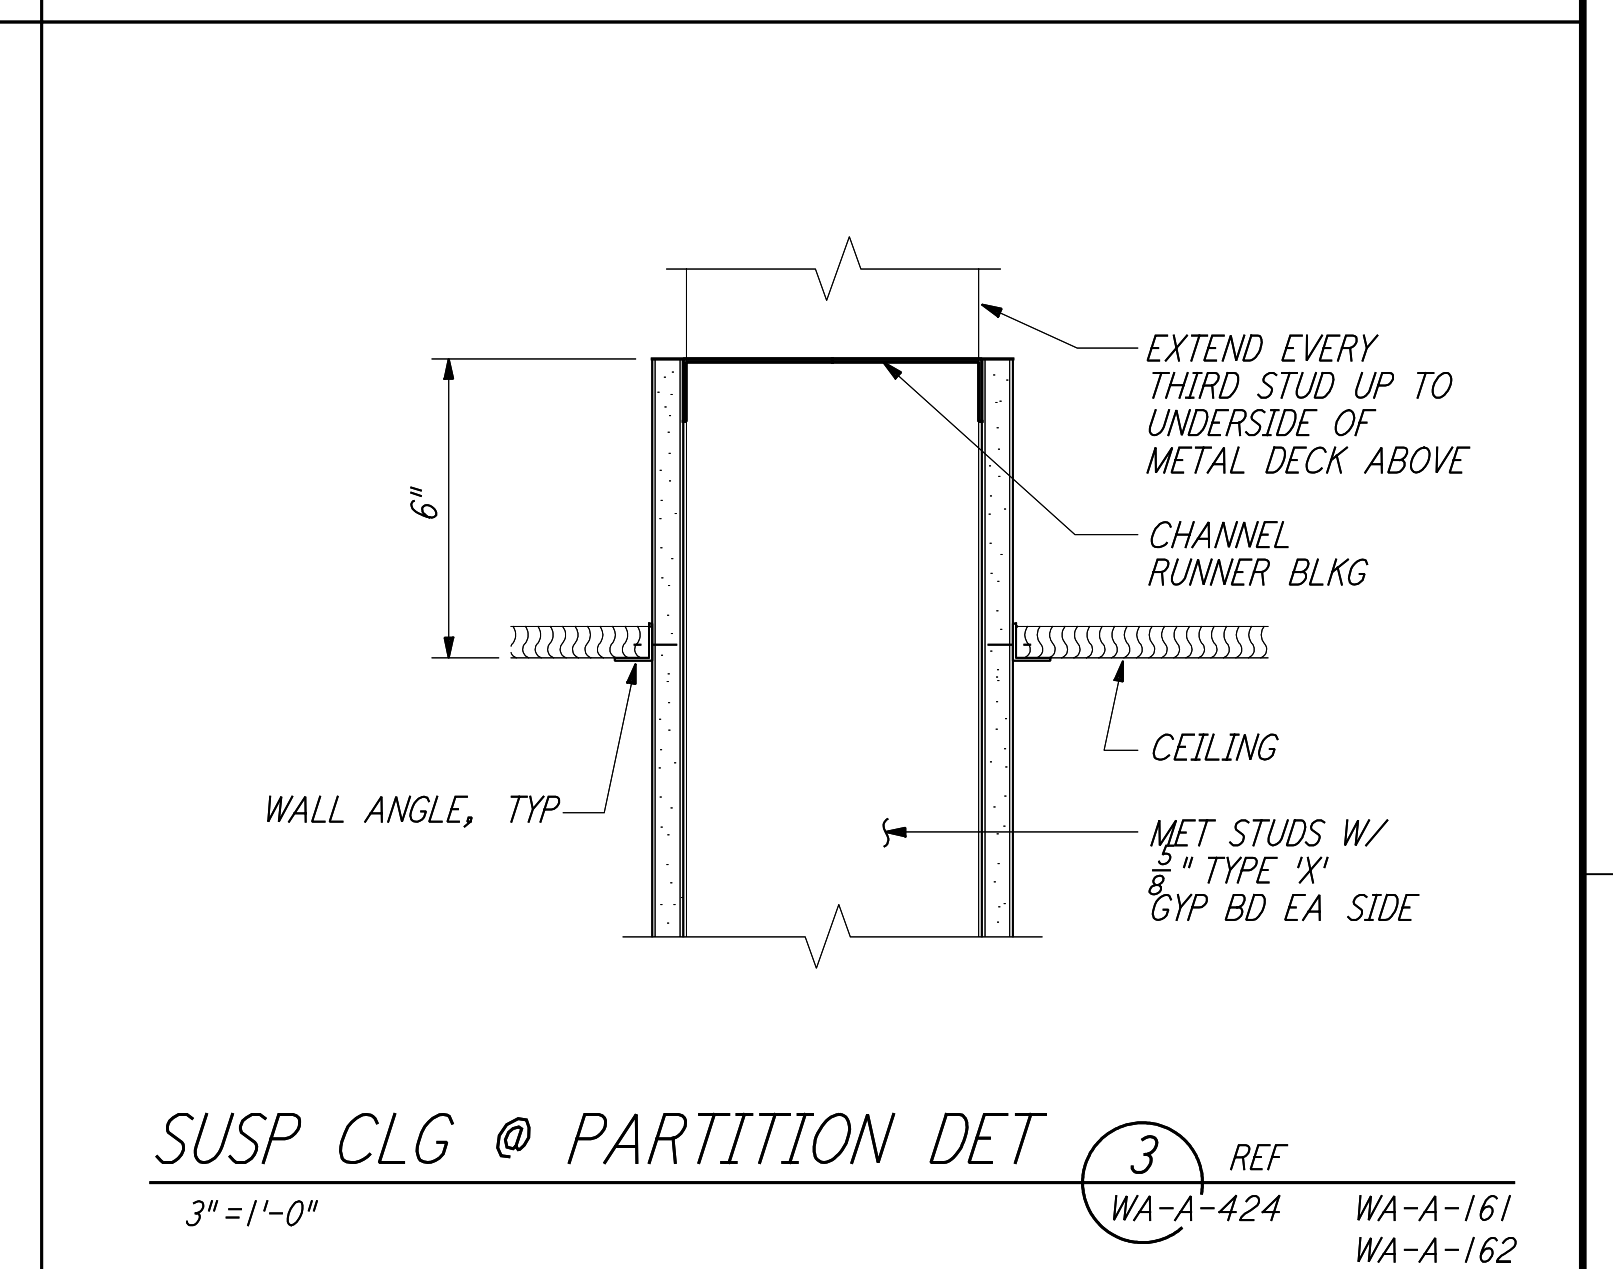


**SUSP CLG @ PARTITION DET**  
 3" = 1'-0"

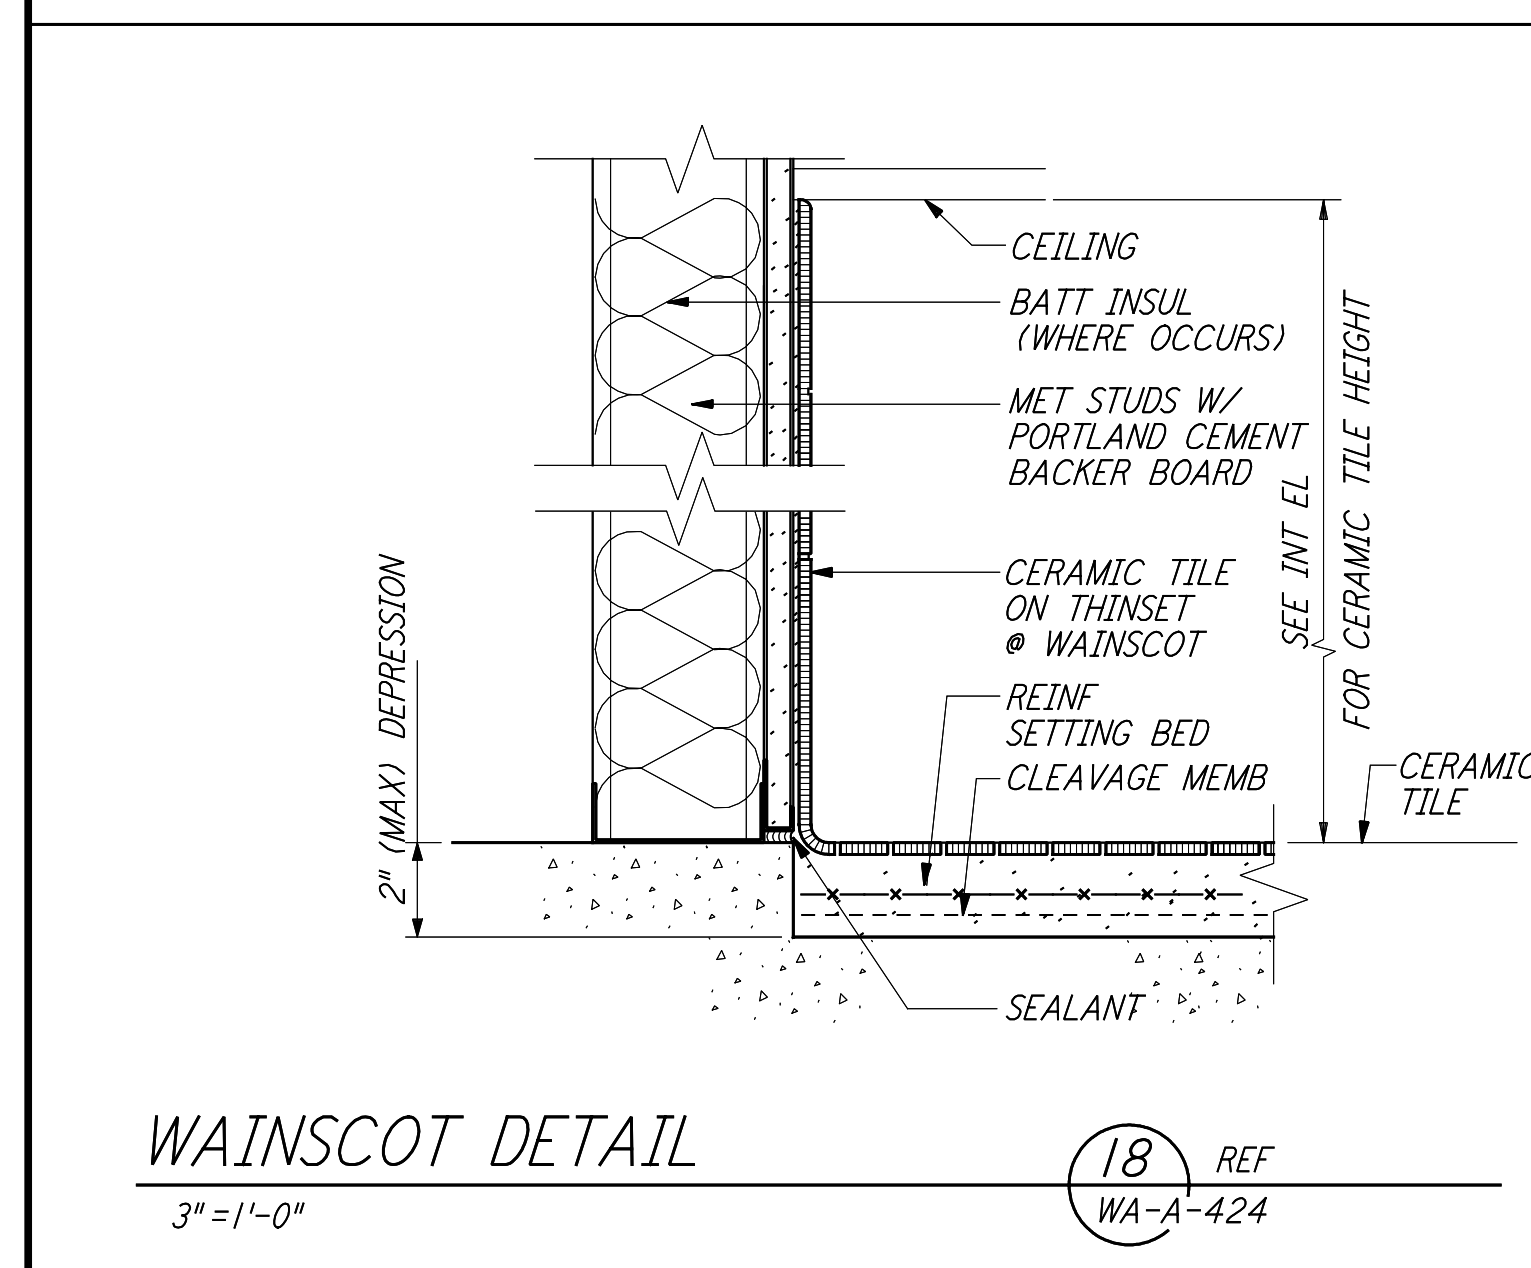


**WAINSCOT DETAIL**  
 3" = 1'-0"

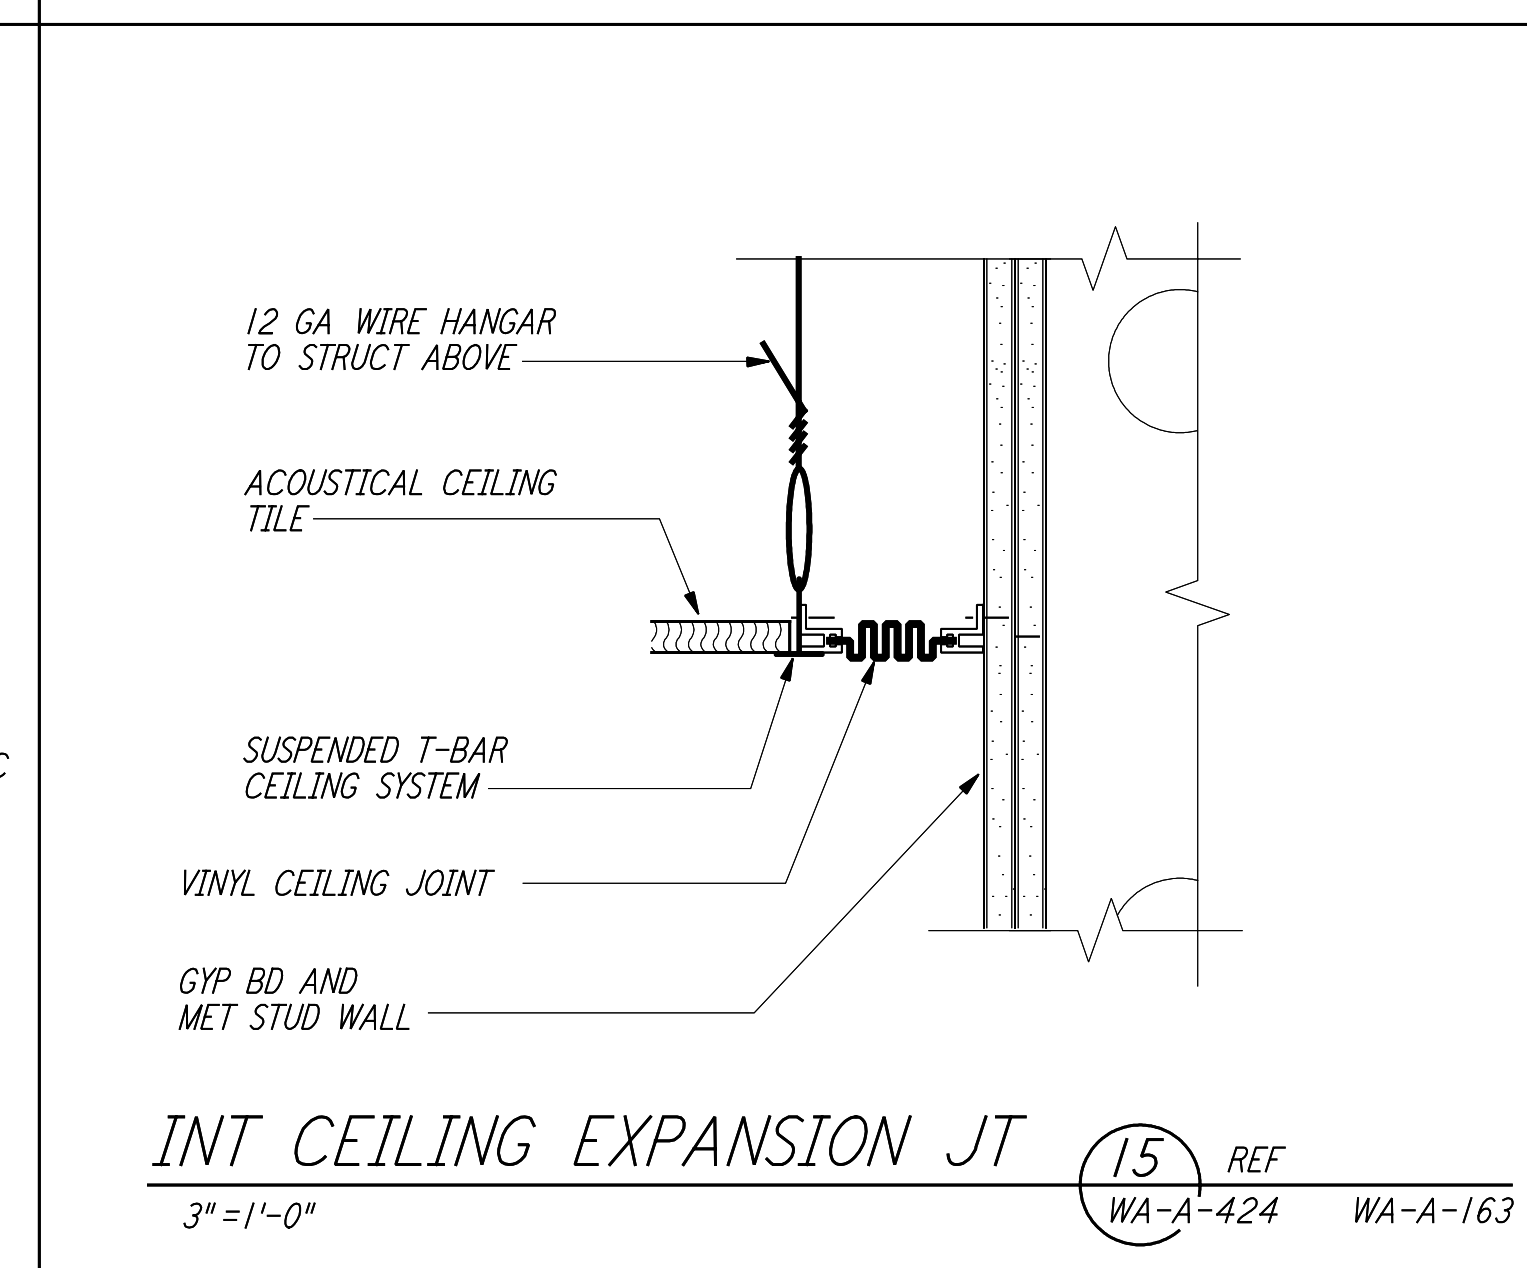


**INT CEILING EXPANSION JT**  
 3" = 1'-0"

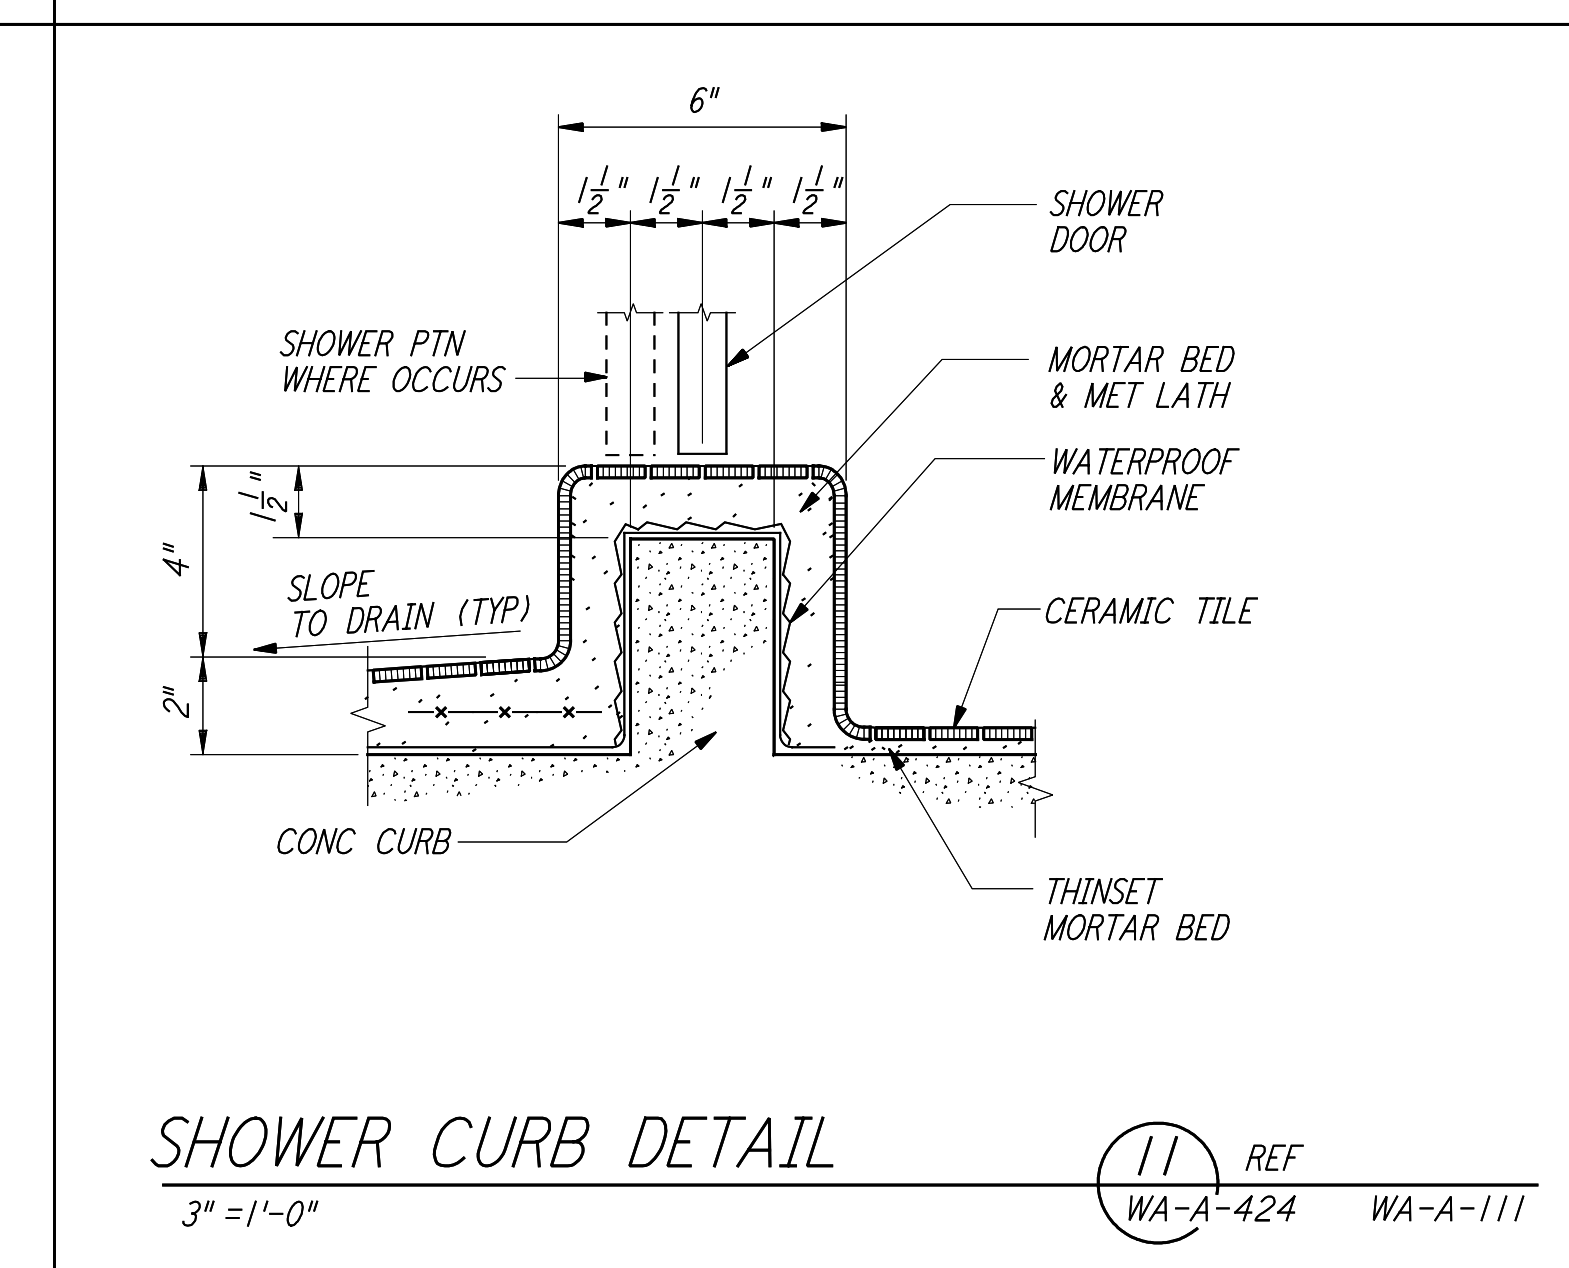

**SHOWER CURB DETAIL**  
 3" = 1'-0"

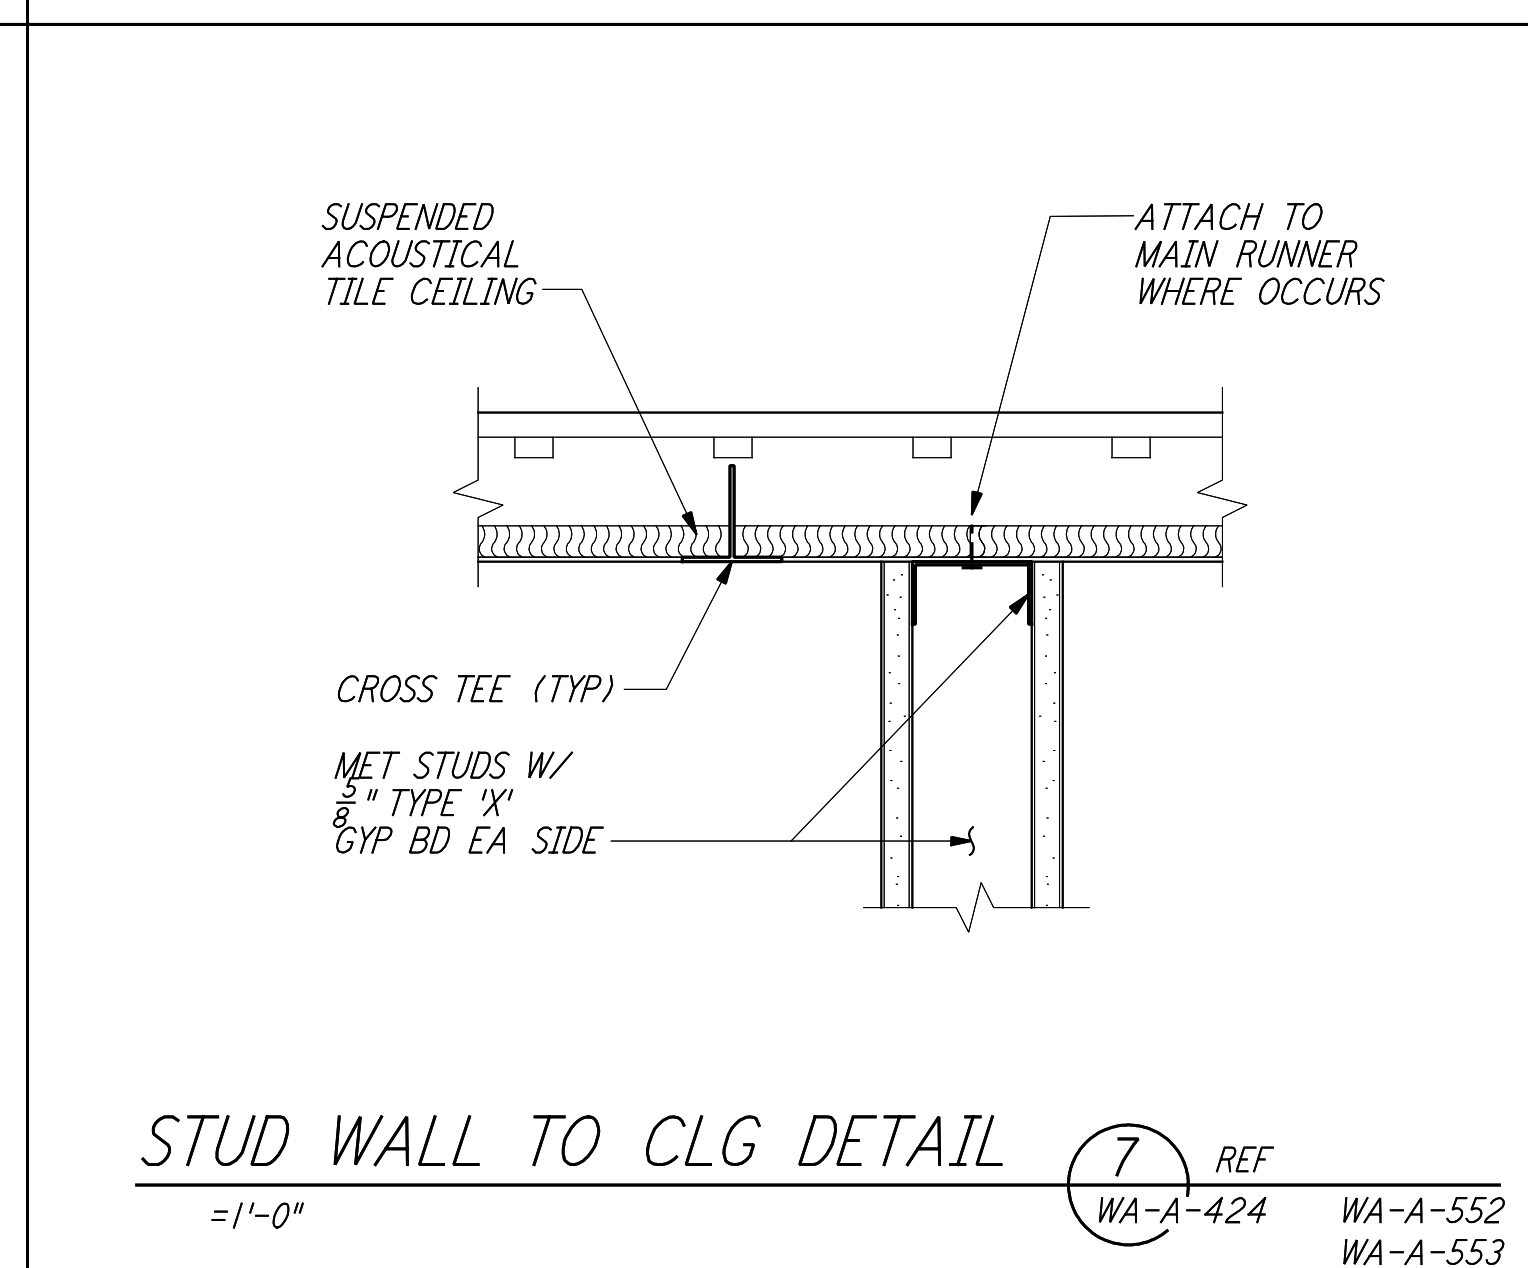

**STUD WALL TO CLG DETAIL**  
 = 1'-0"

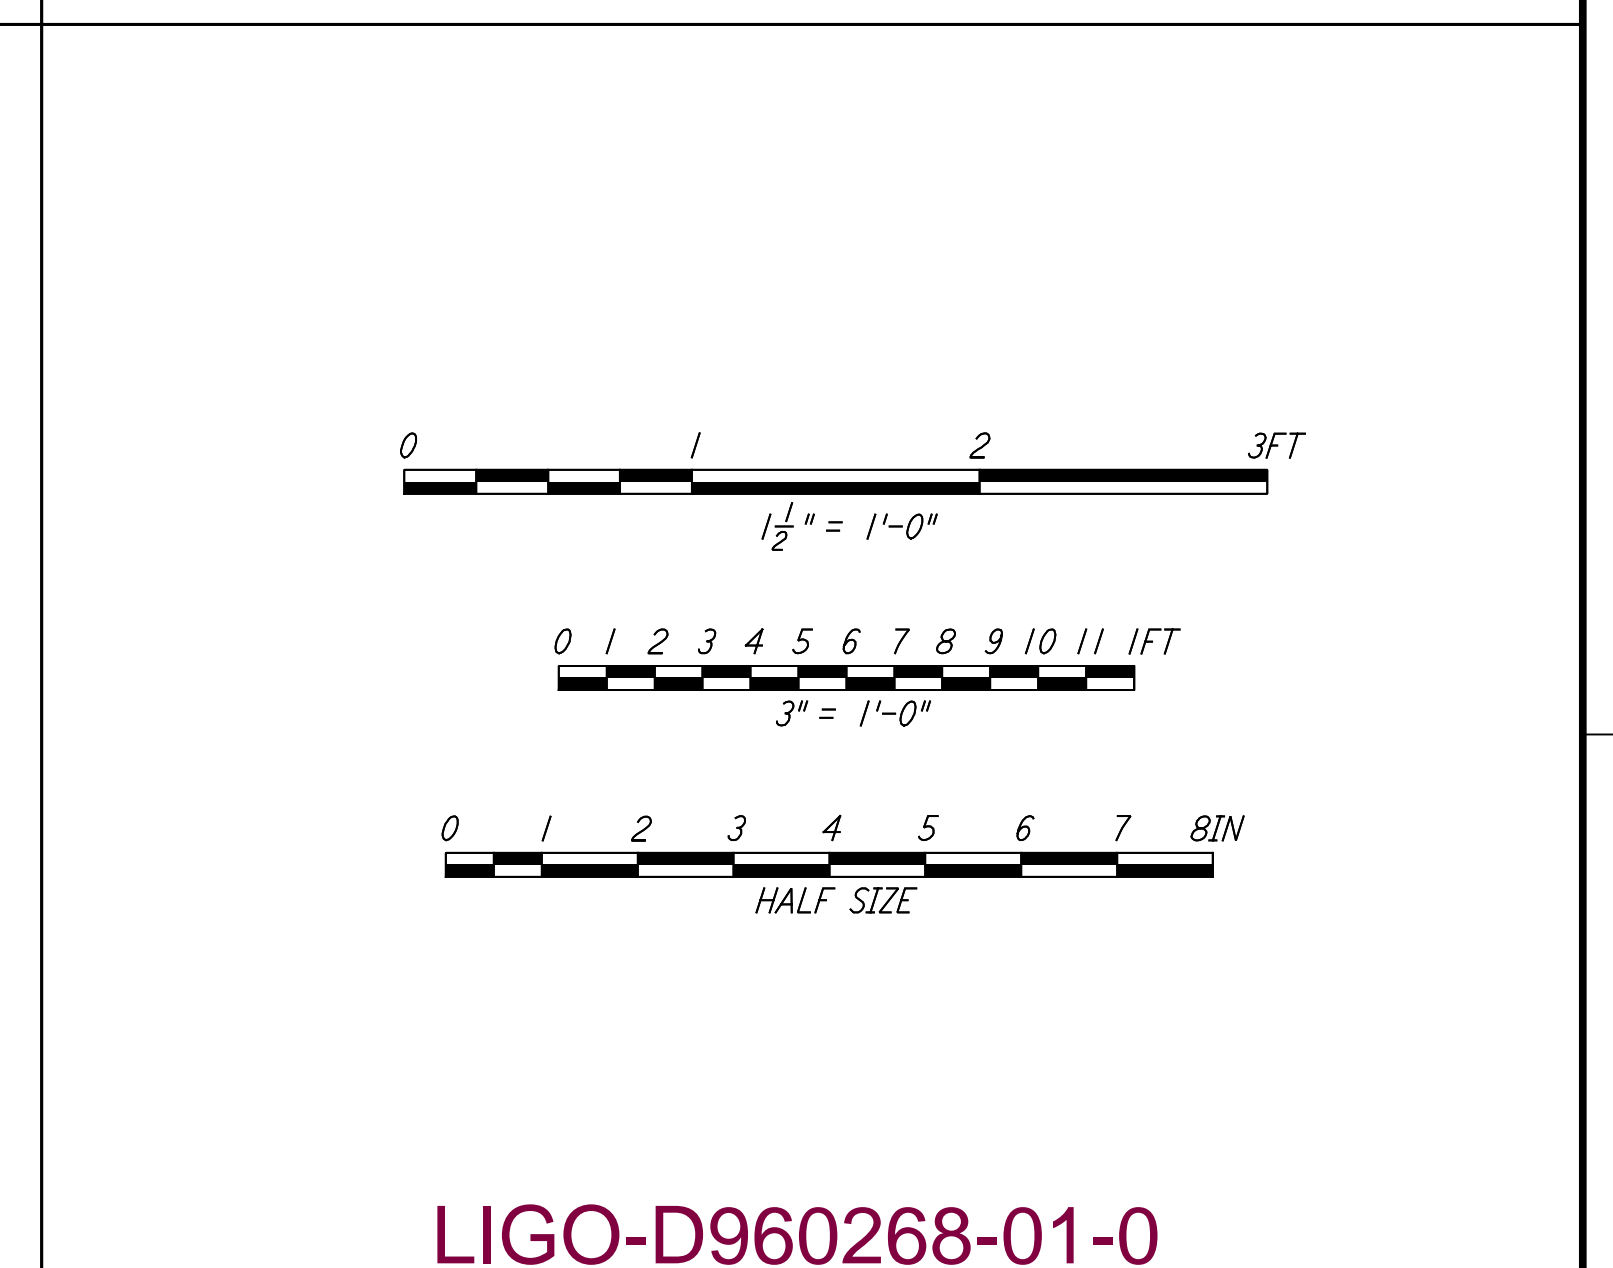

**LIGO-D960268-01-0**

NO.	DATE	BY	CHKD	ENGR	PROJ	DESCRIPTION
1	5-15-98	CKT				ISSUED FOR AS BUILT

NO.	DATE	BY	CHKD	ENGR	PROJ	DESCRIPTION

NO.	DATE	BY	CHKD	ENGR	PROJ	DESCRIPTION

**PARSONS**  
 100 WEST WALNUT STREET  
 PASADENA, CALIFORNIA

**LIGO**  
 CALIFORNIA INSTITUTE OF TECHNOLOGY  
 MASSACHUSETTS INSTITUTE OF TECHNOLOGY

**LASER INTERFEROMETER  
 GRAVITATIONAL-WAVE OBSERVATORY  
 SITE NO. 1 - HANFORD, WASHINGTON**

TITLE	ARCHITECTURAL CEILING & MISCELLANEOUS INTERIOR DETAILS	SCALE	AS NOTED	PROJECT NUMBER	PP150969	8094
SHEET NUMBER	<b>WA-A-424</b>	REVISIONS				

*Note 1, Linda L Turner, 04/14/99 02:49:21 PM*  
LIGO-D960268-01-0