

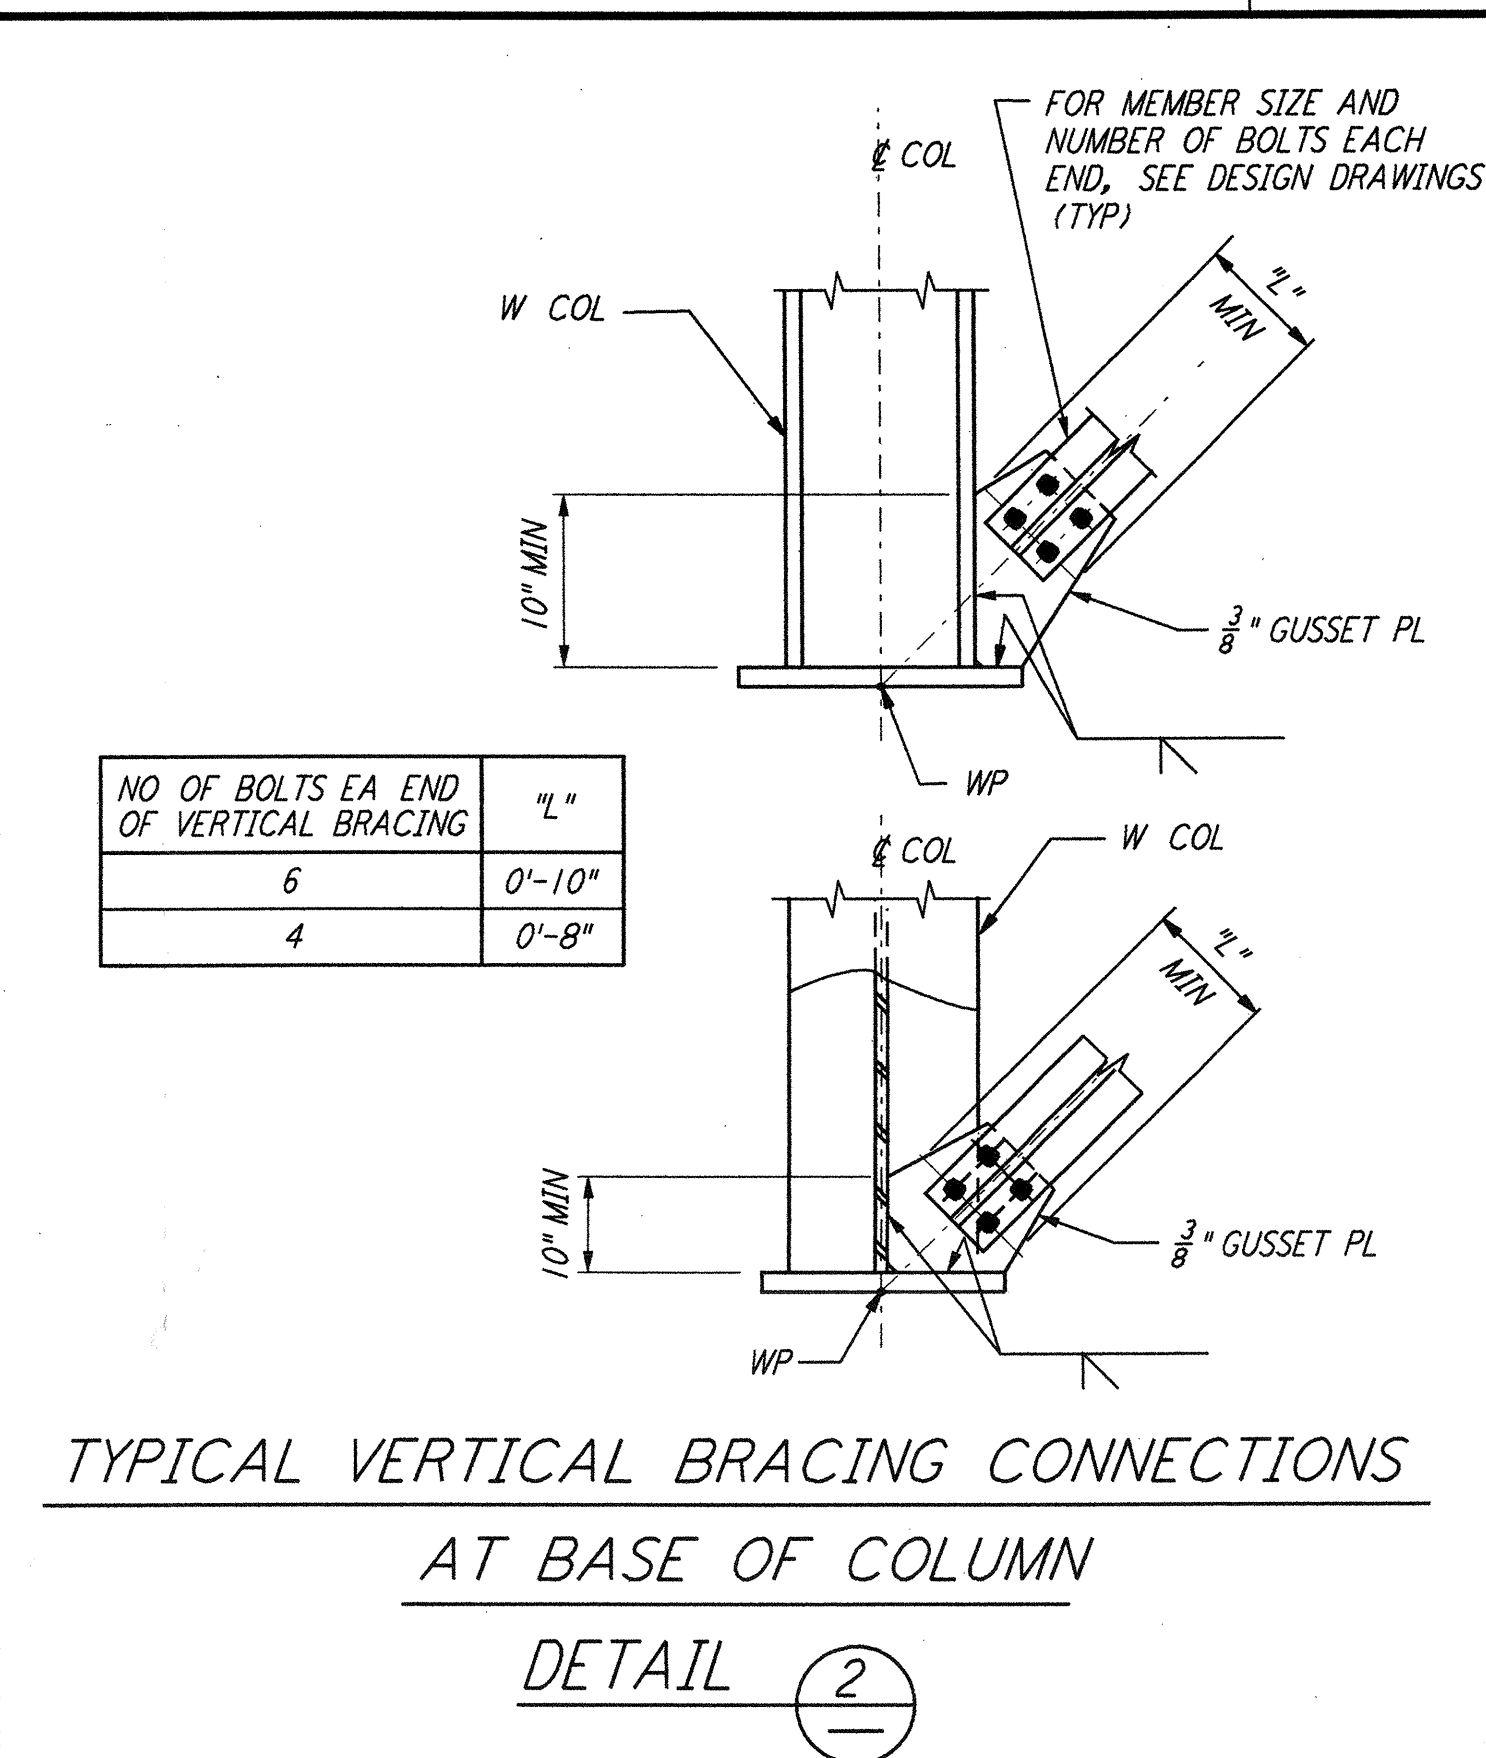
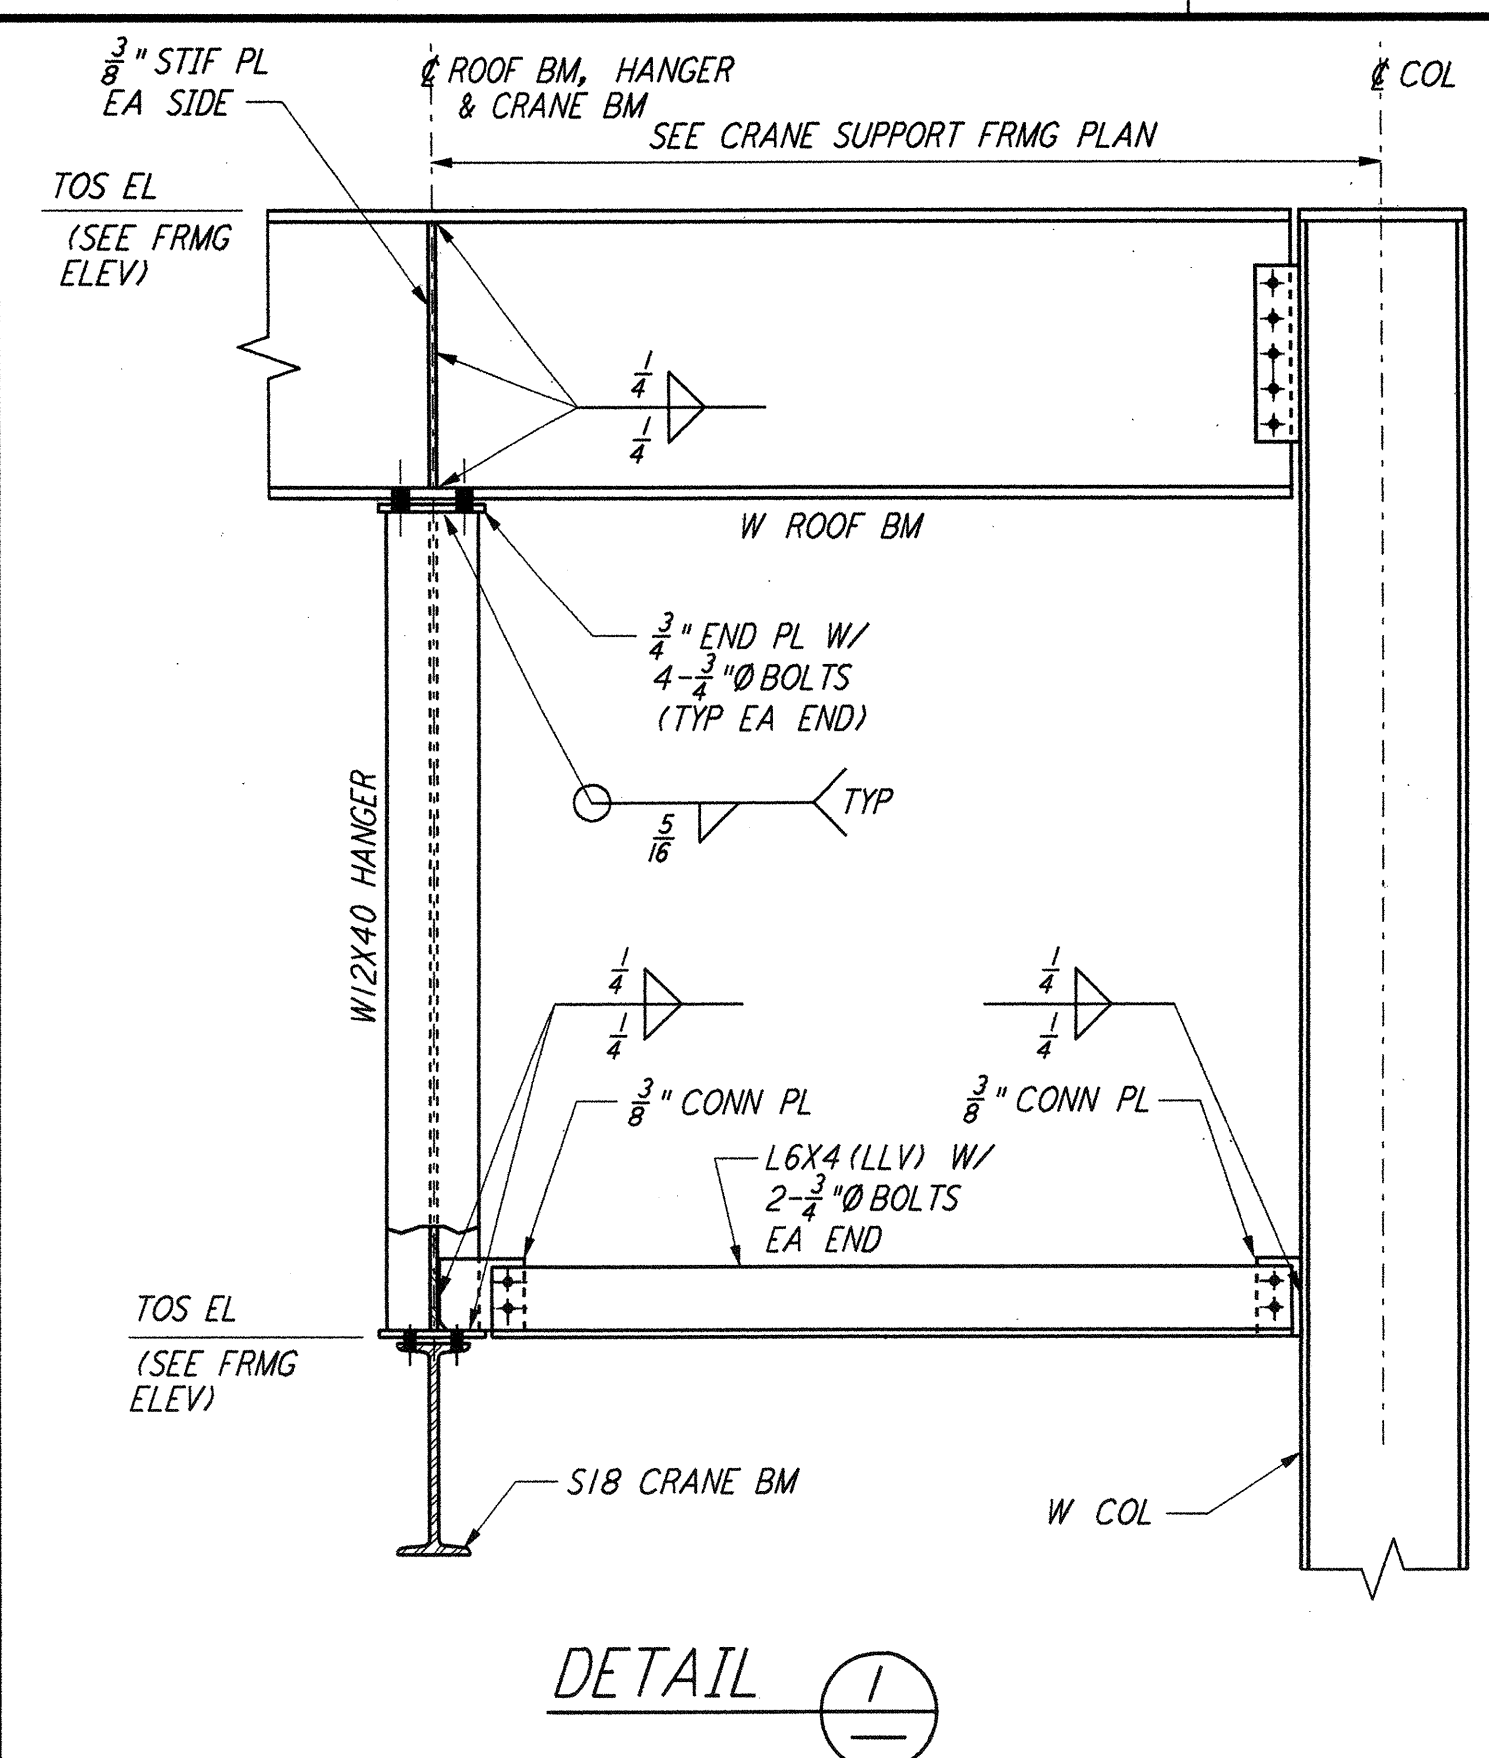
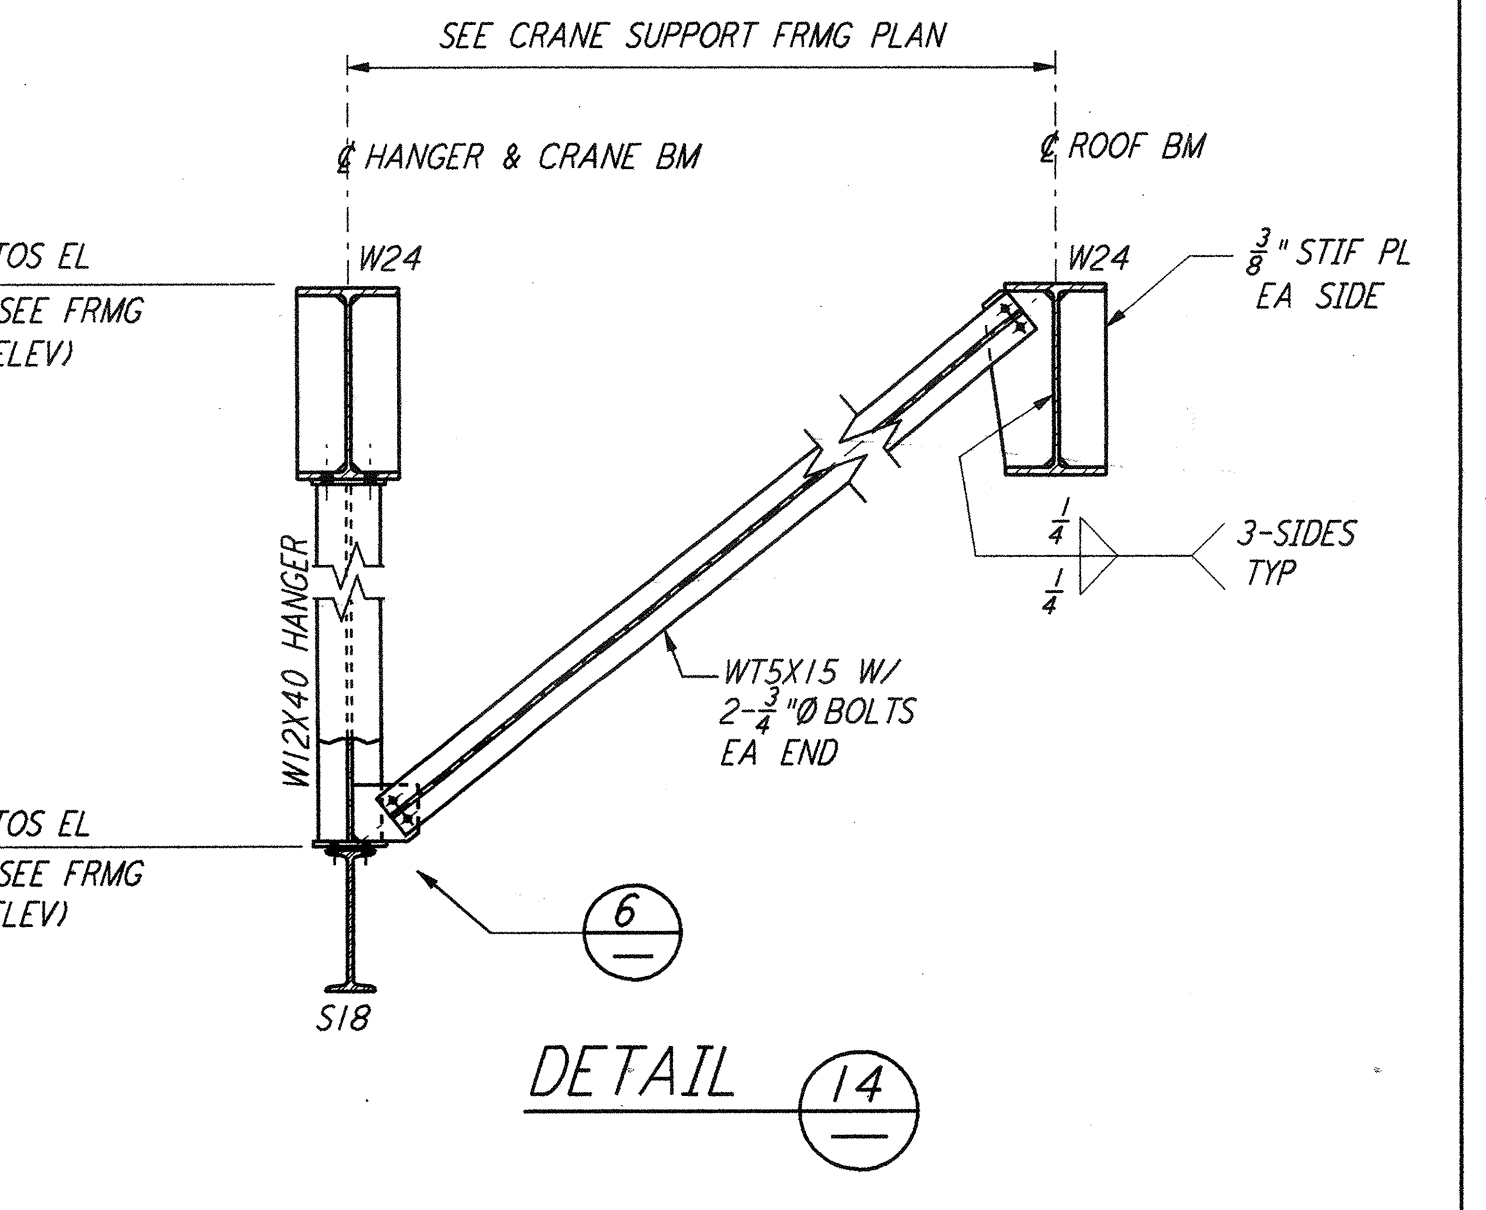
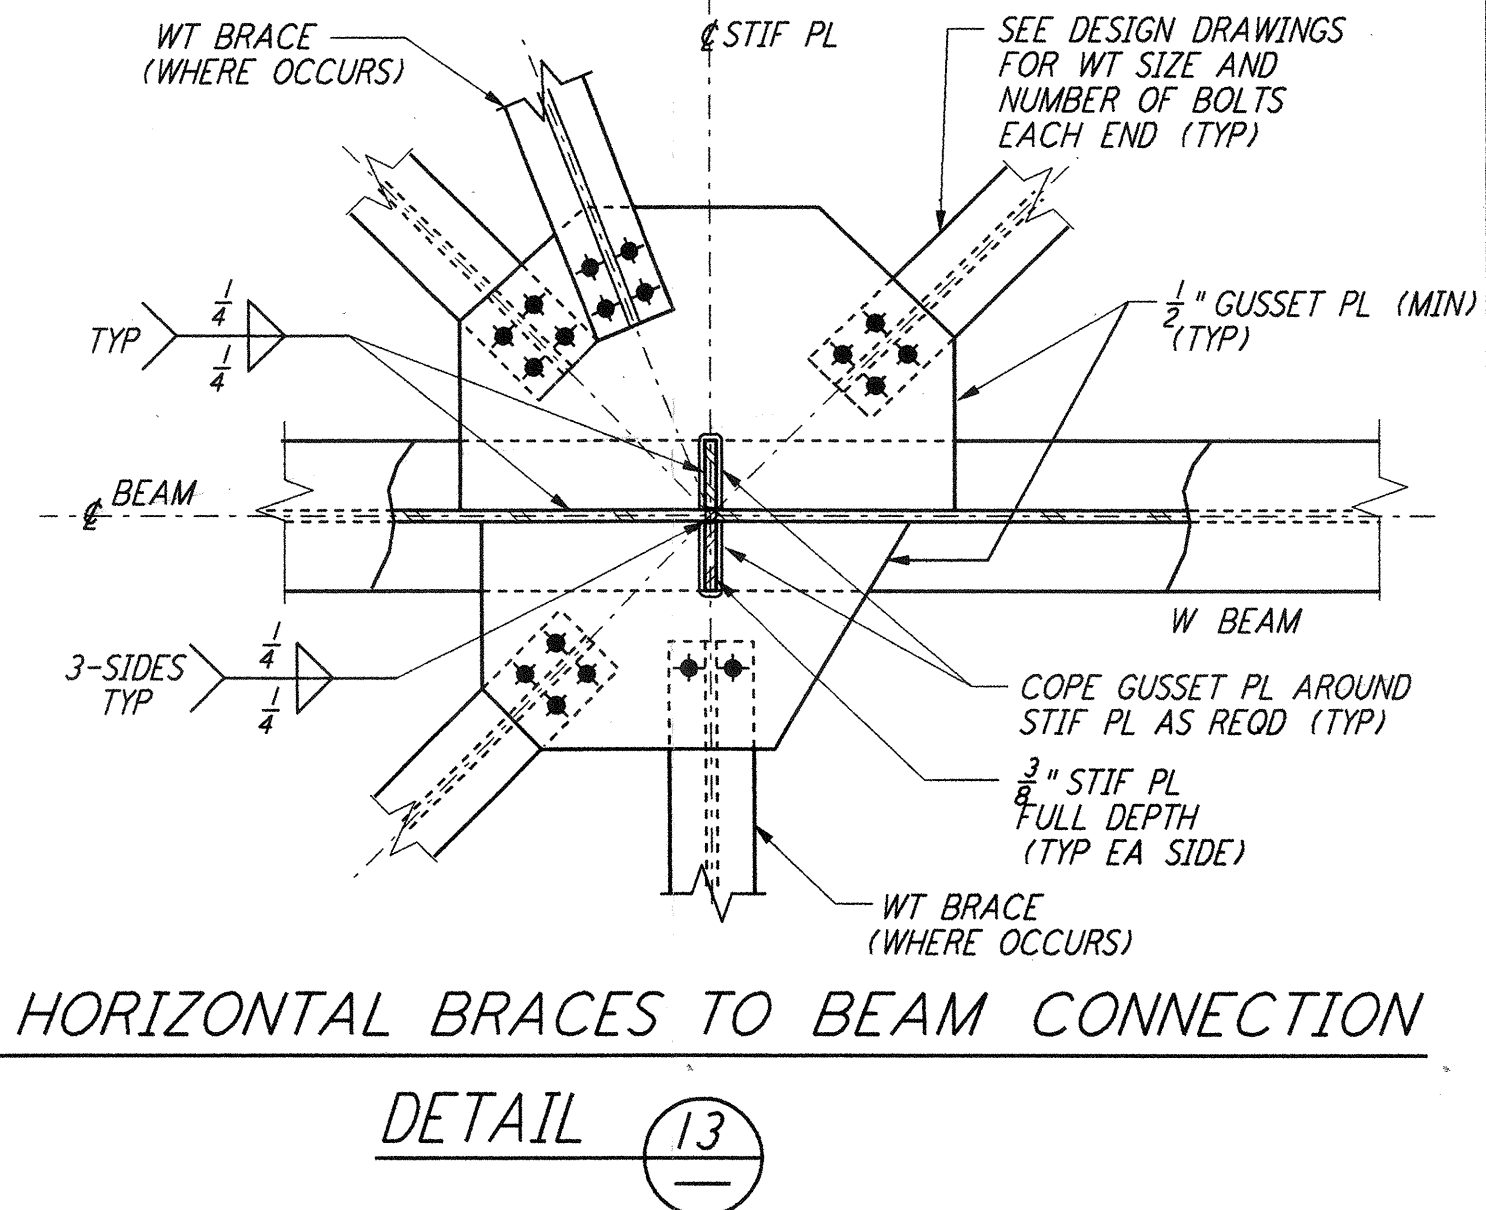
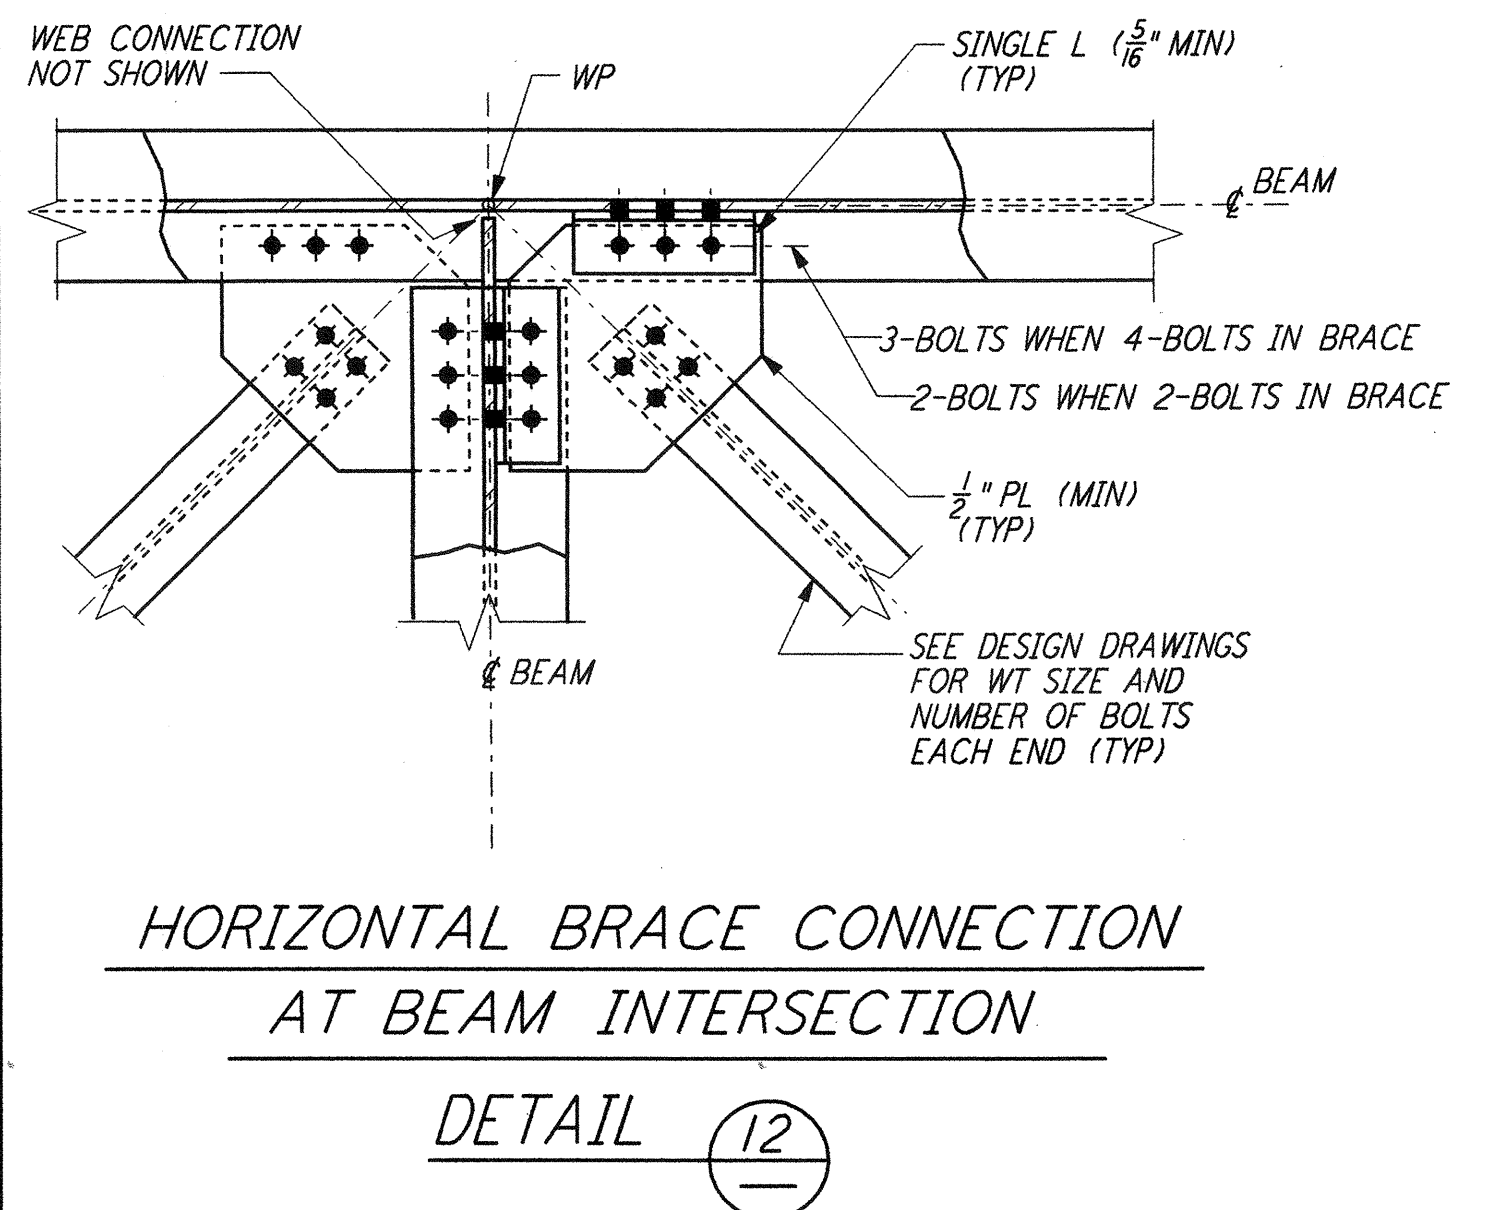
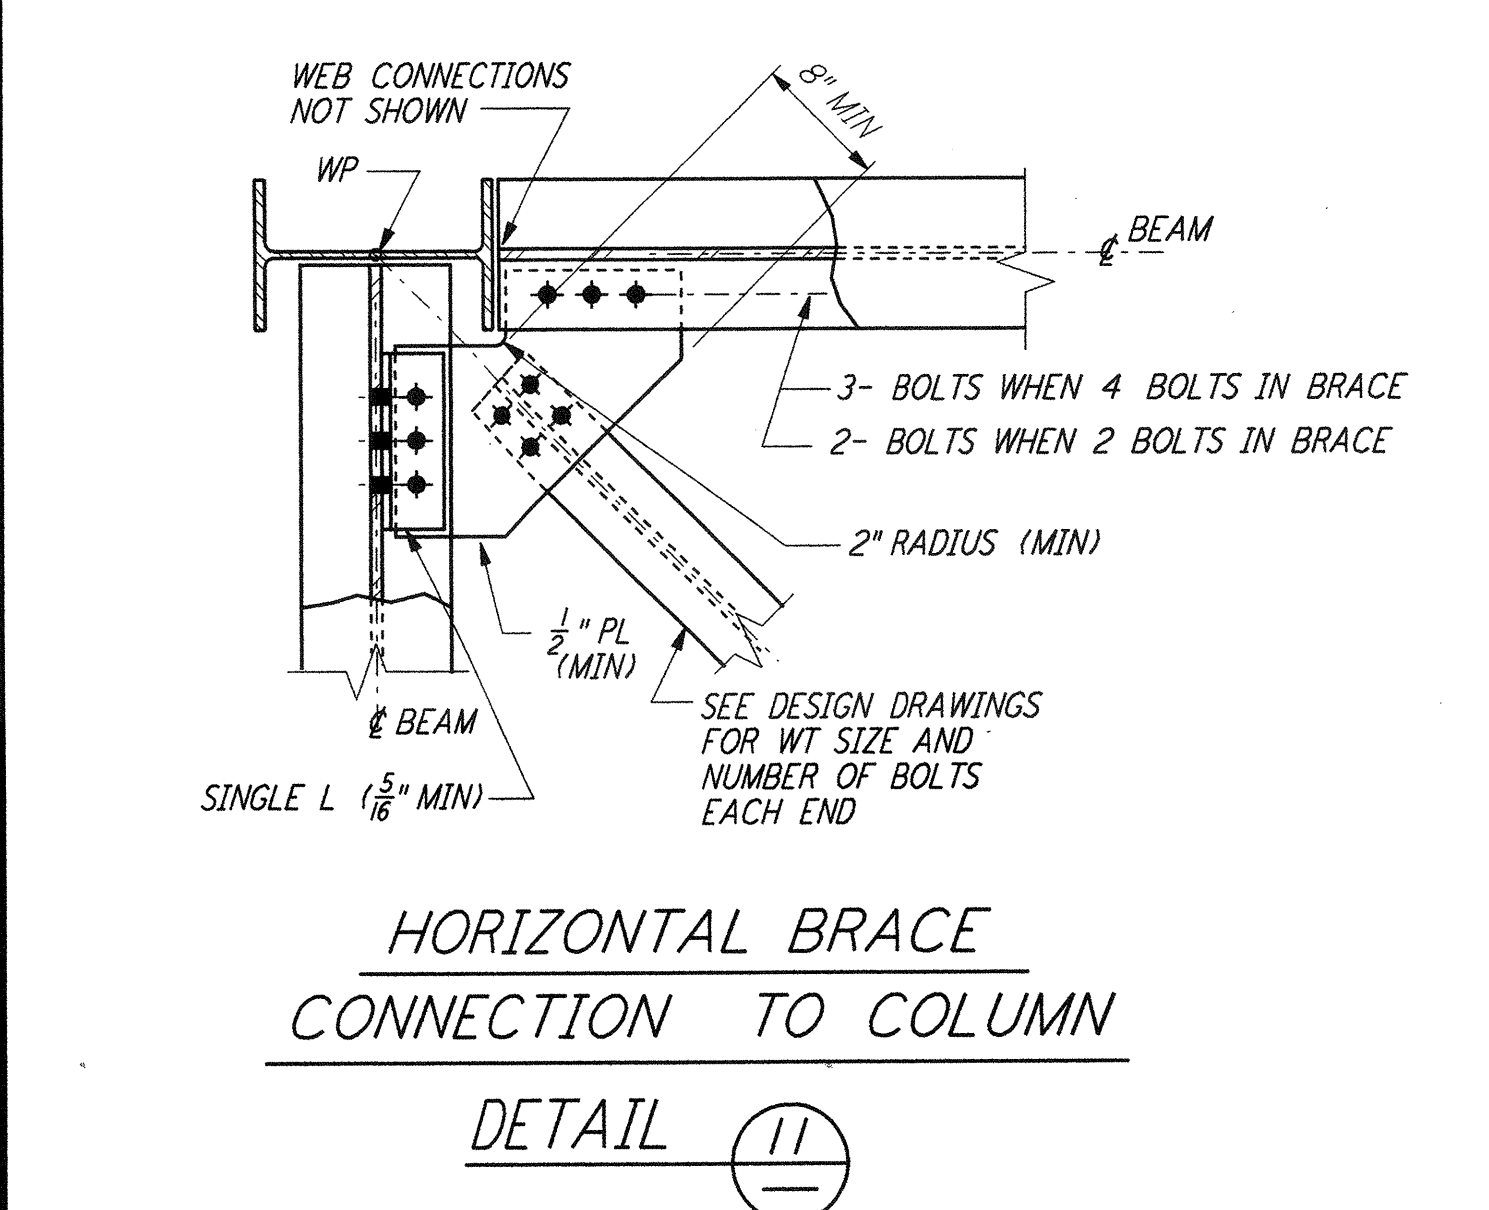
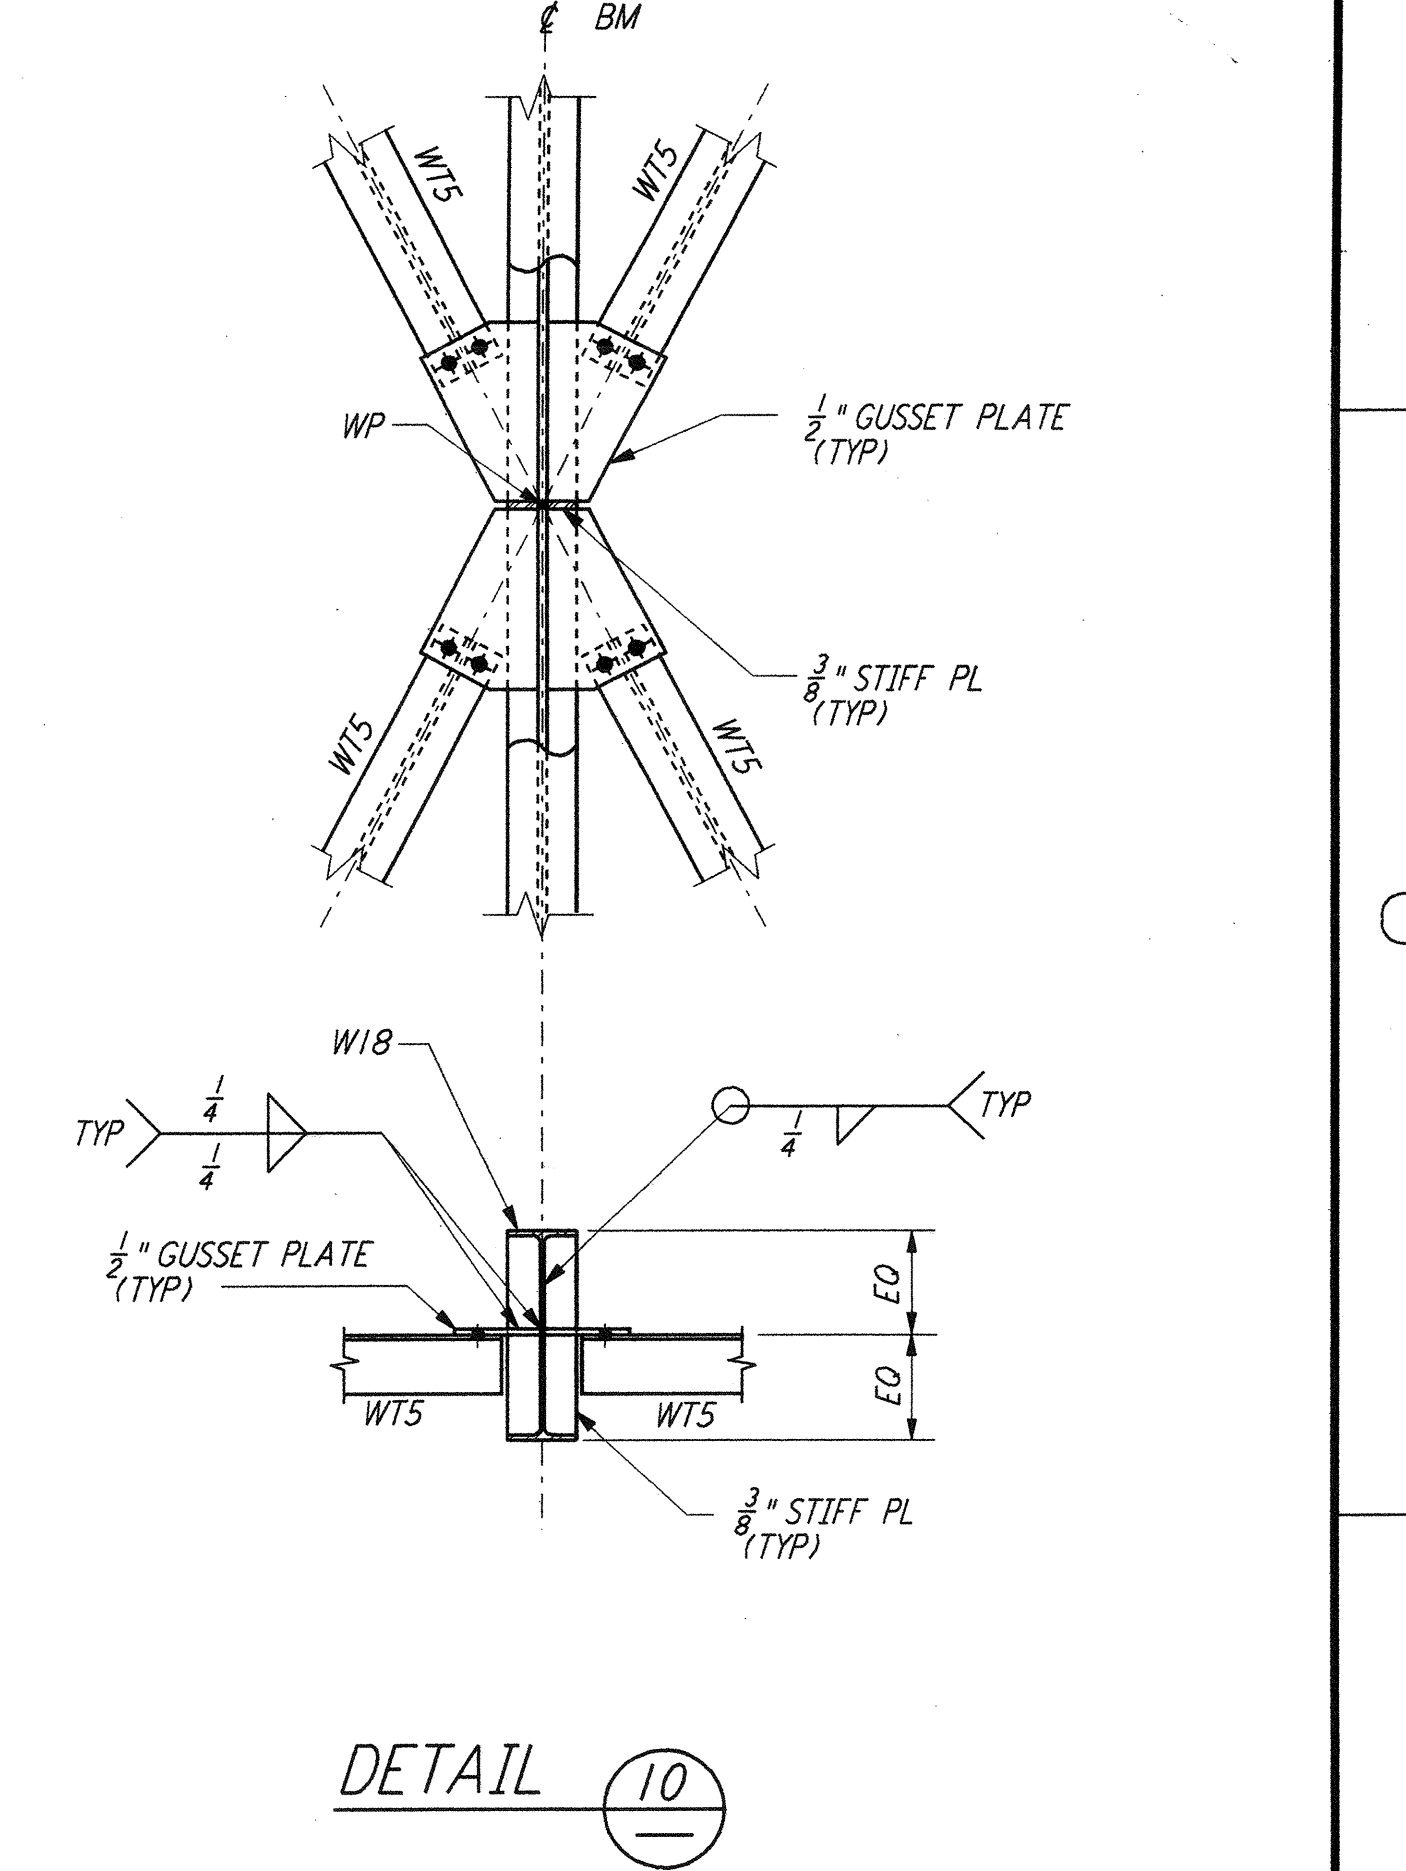
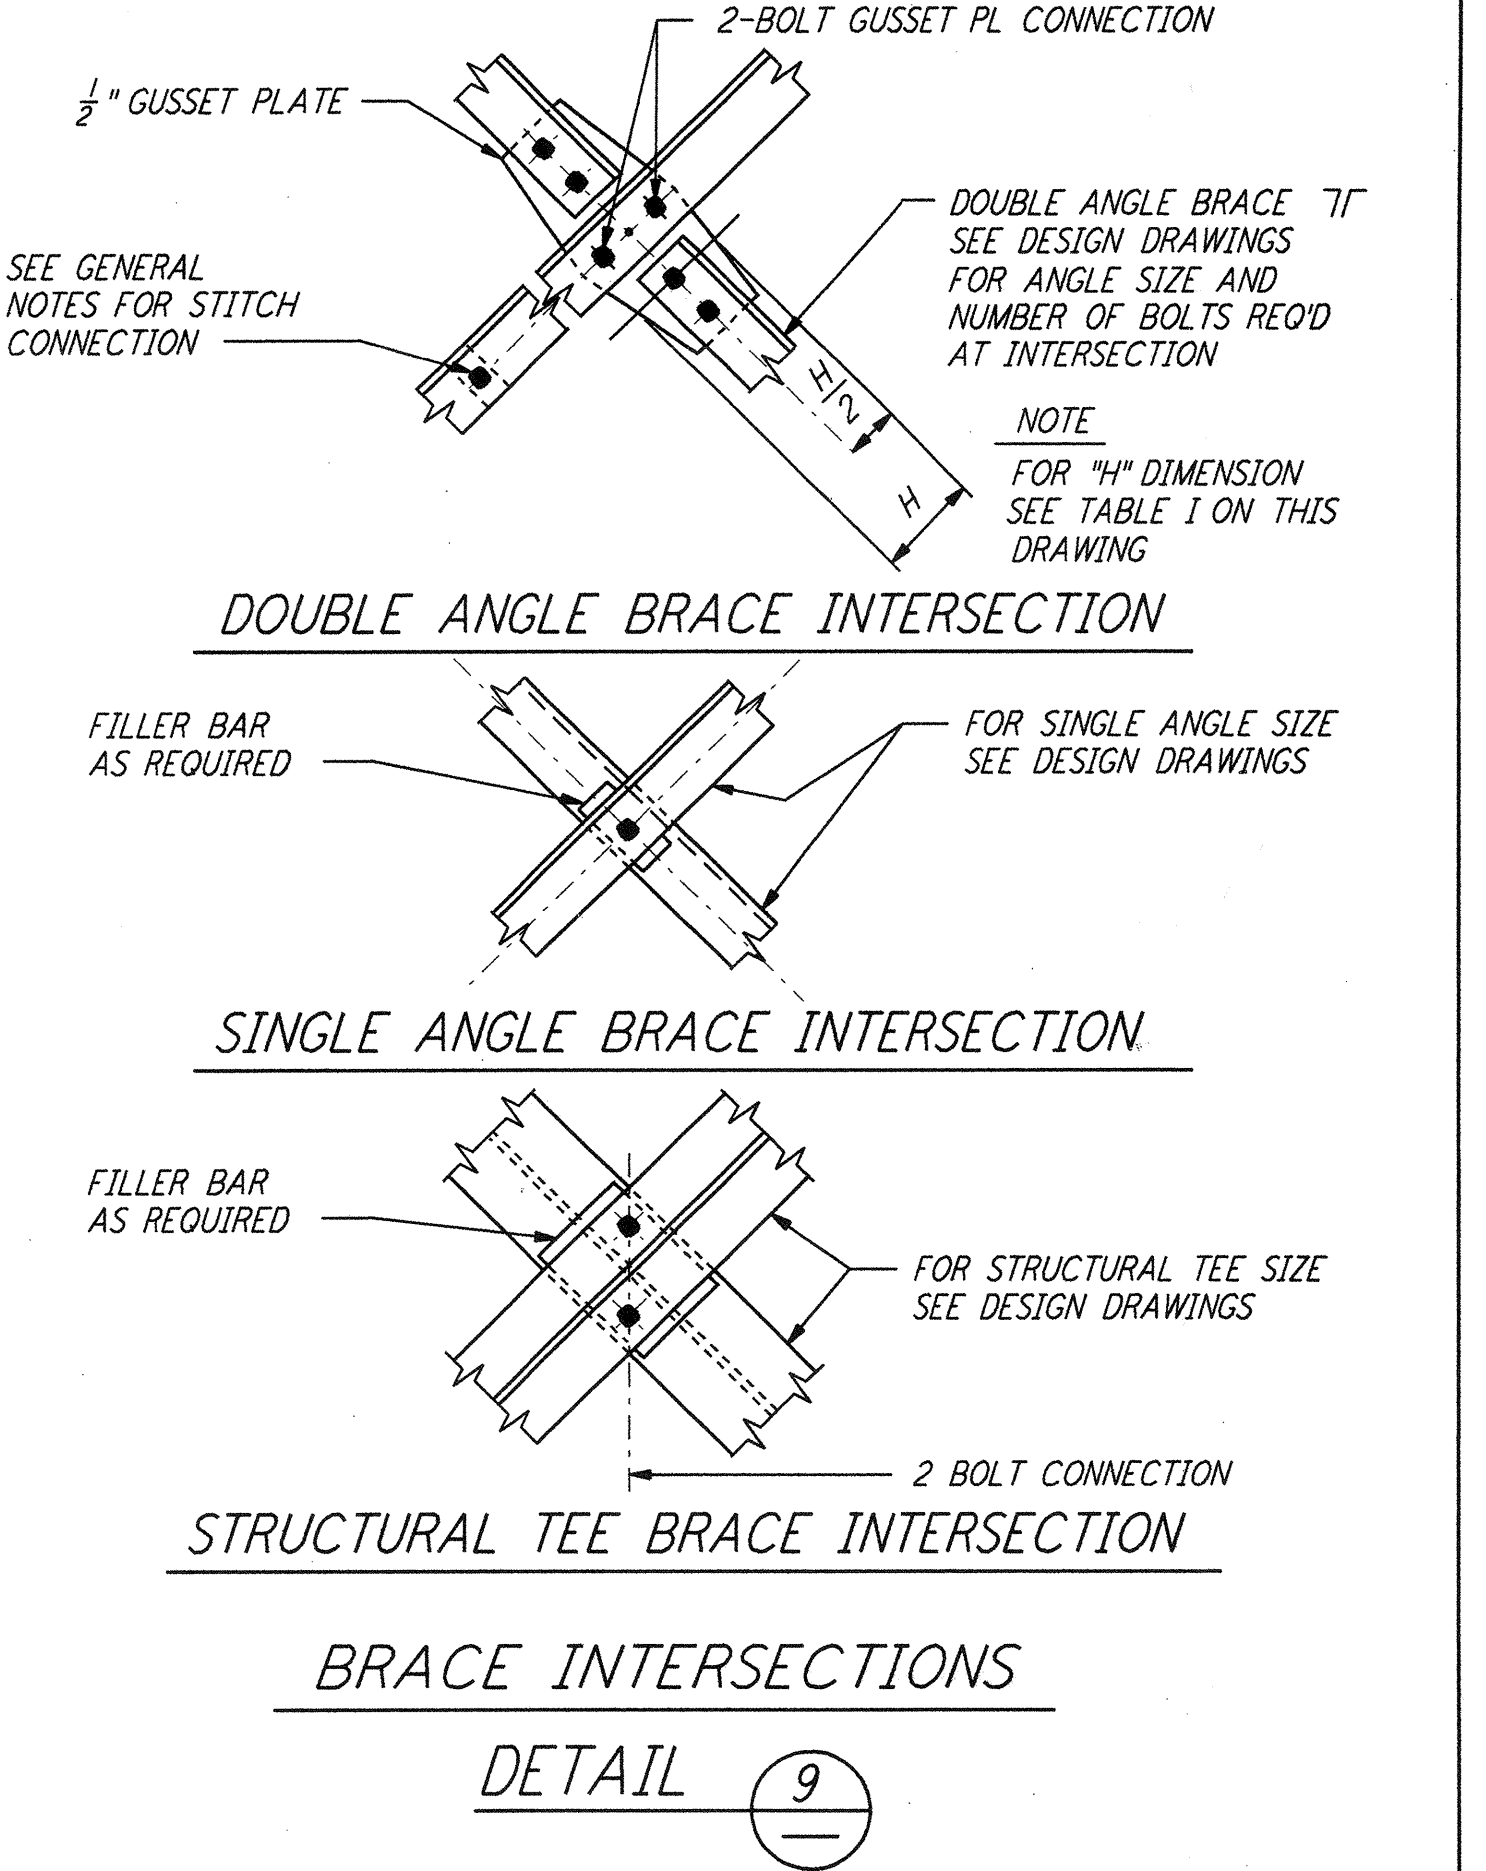
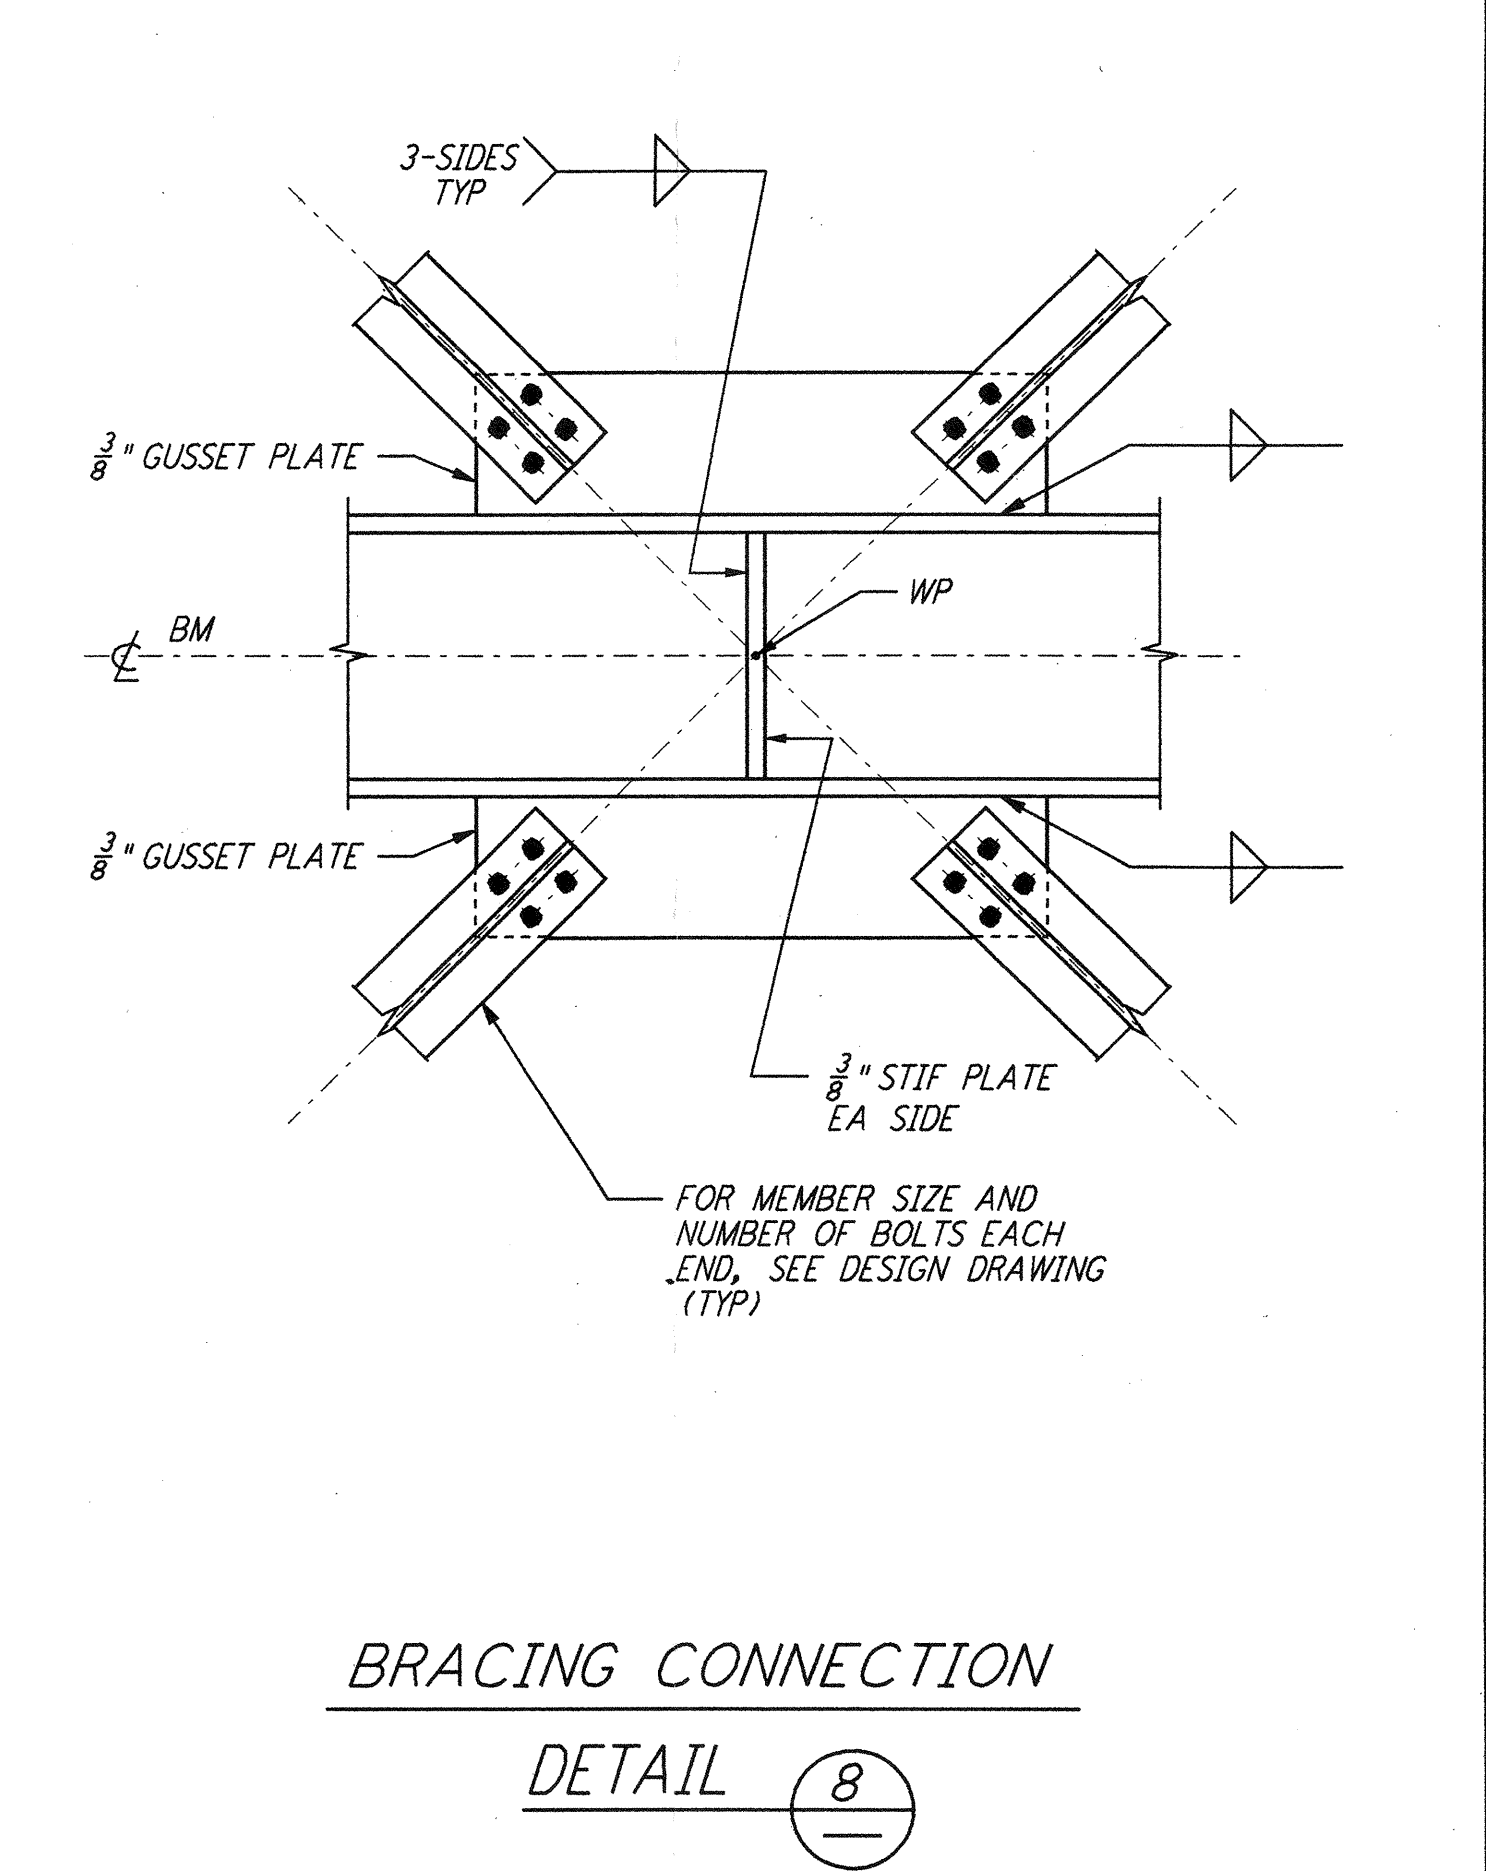
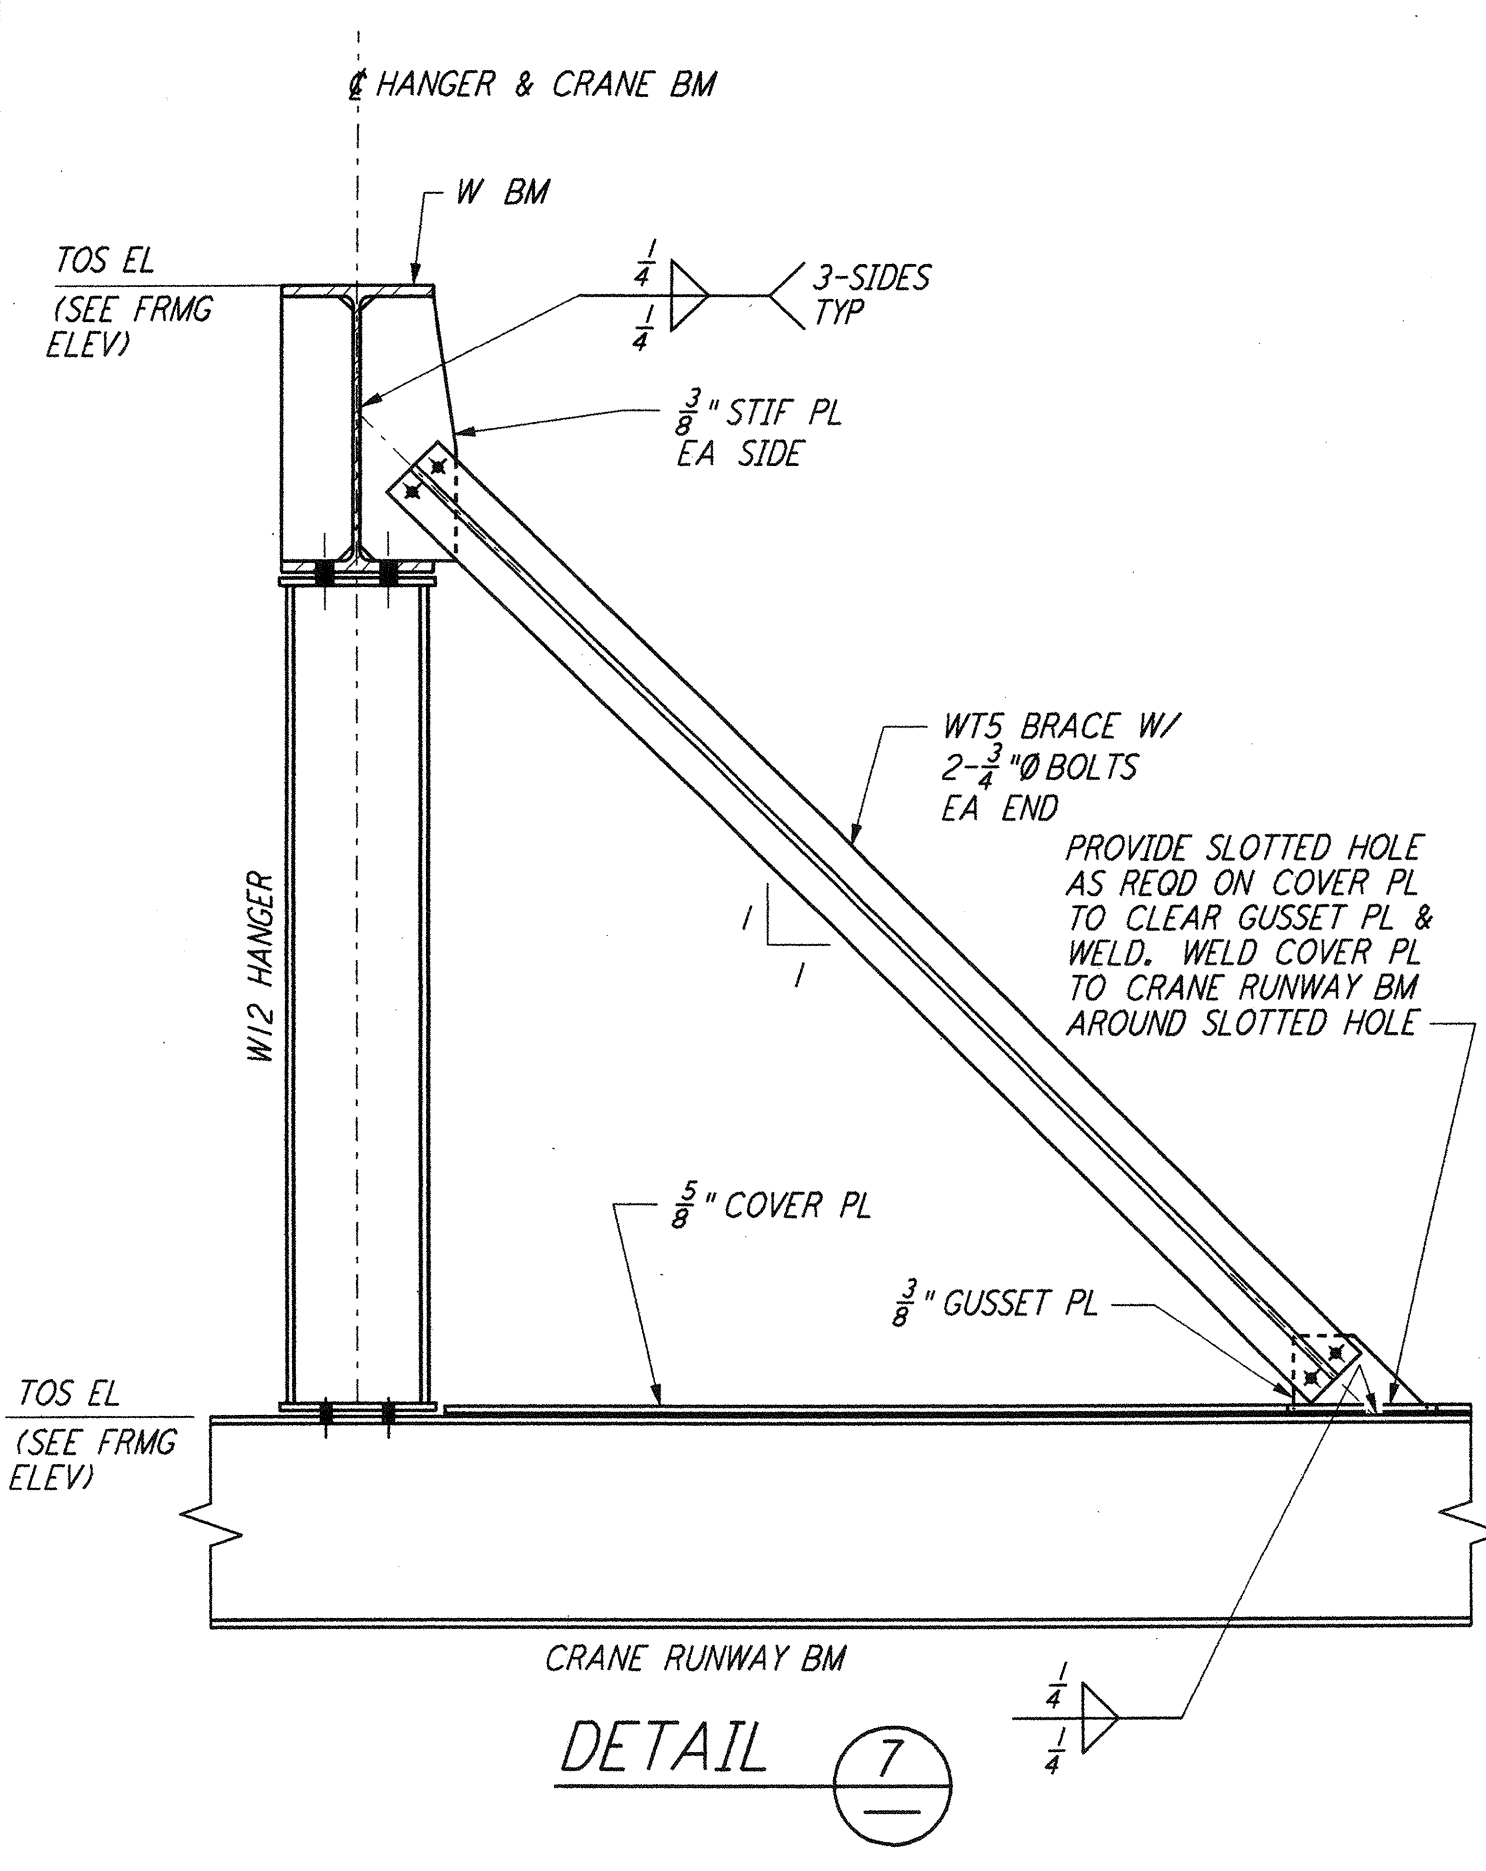
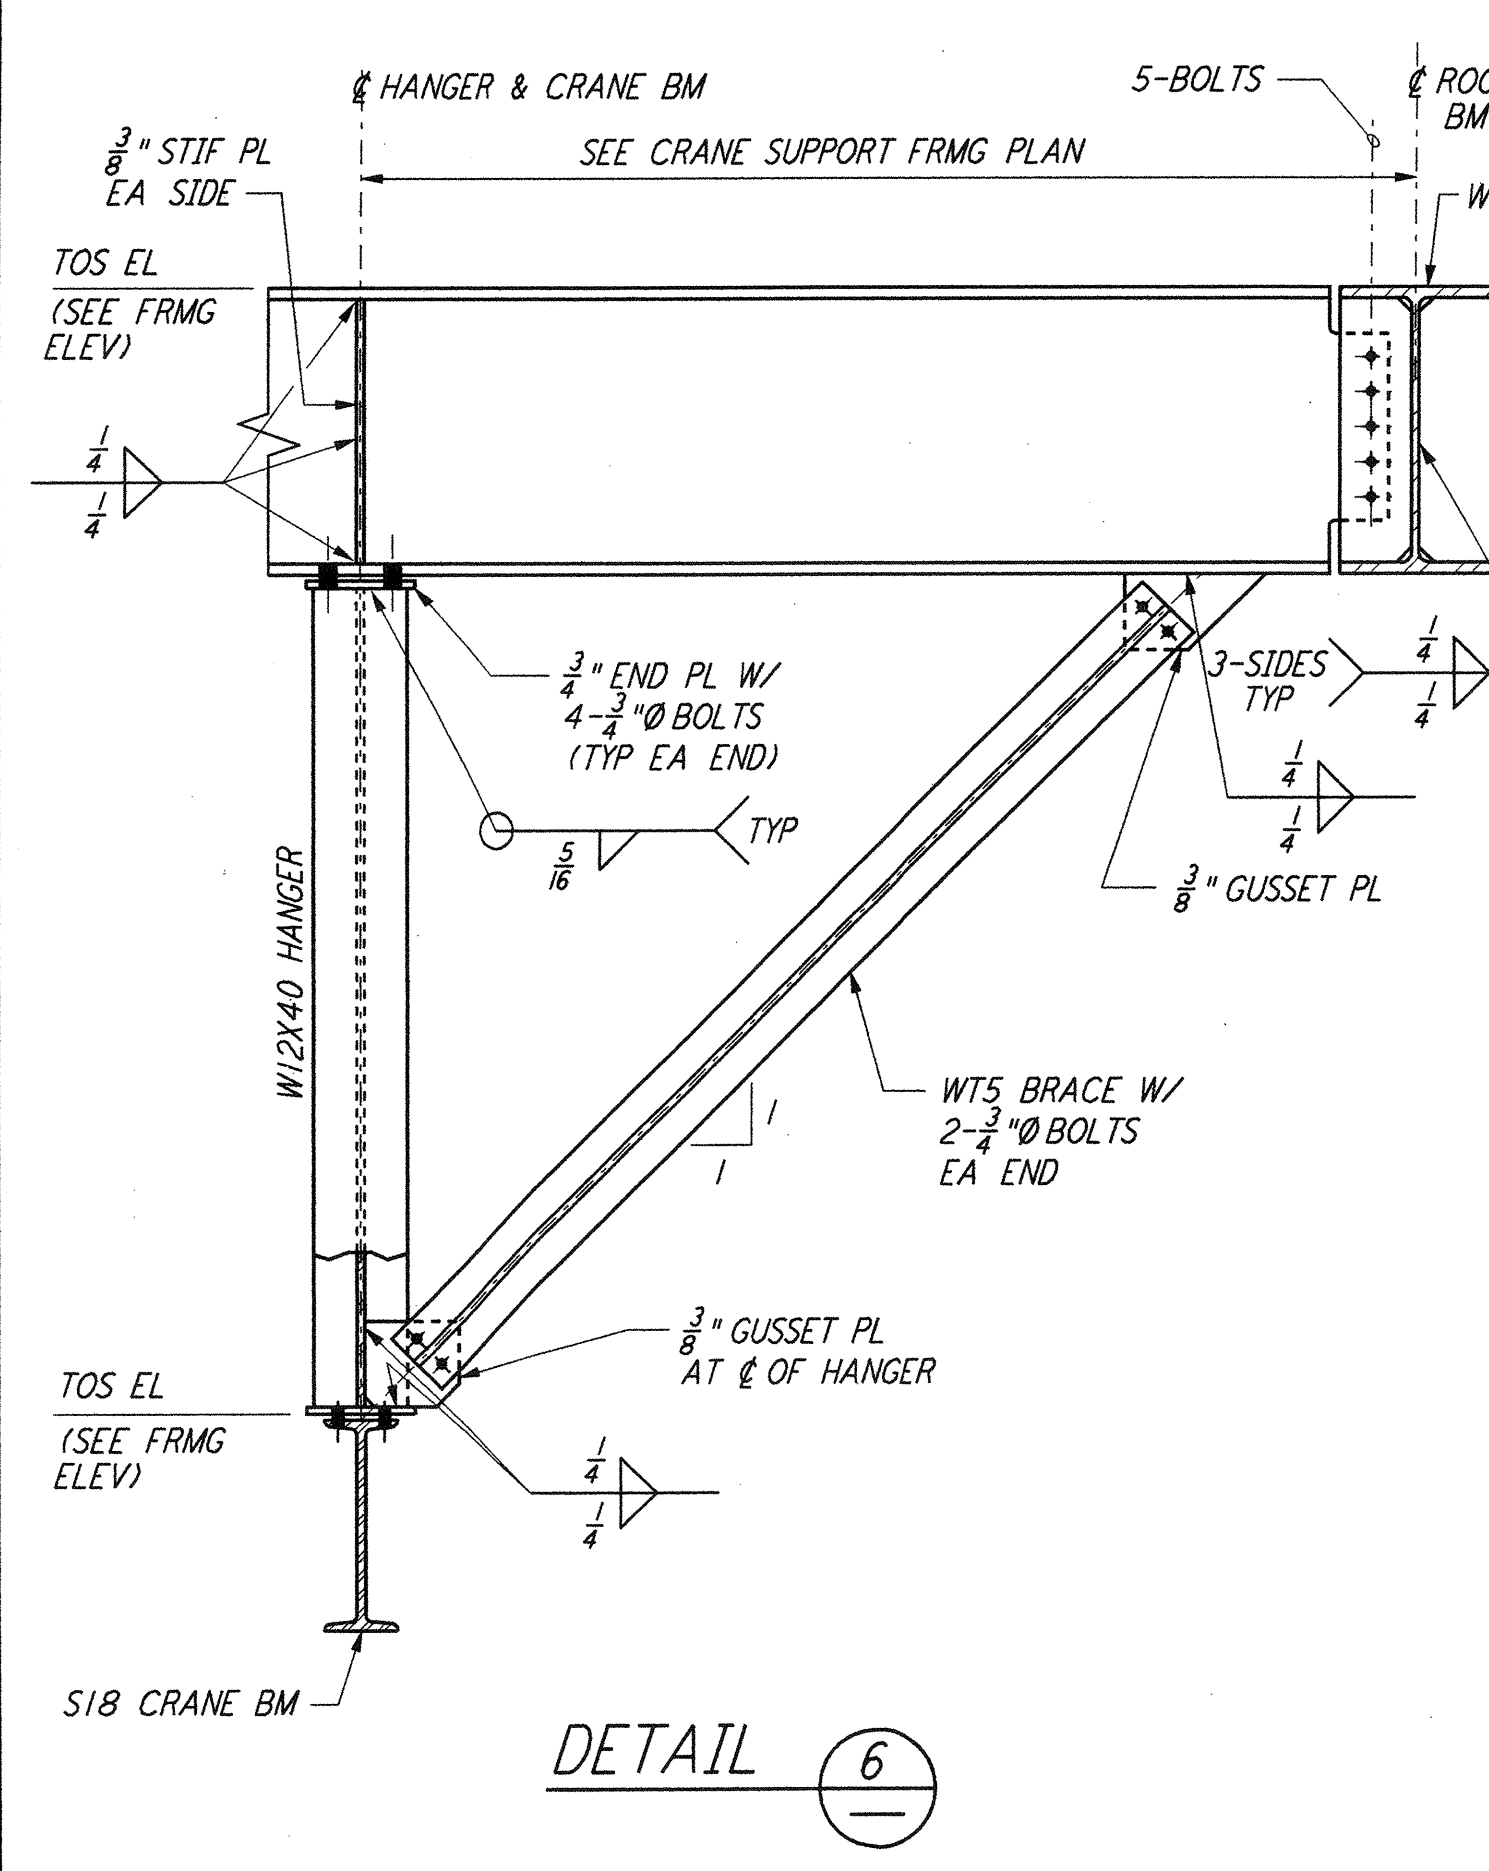
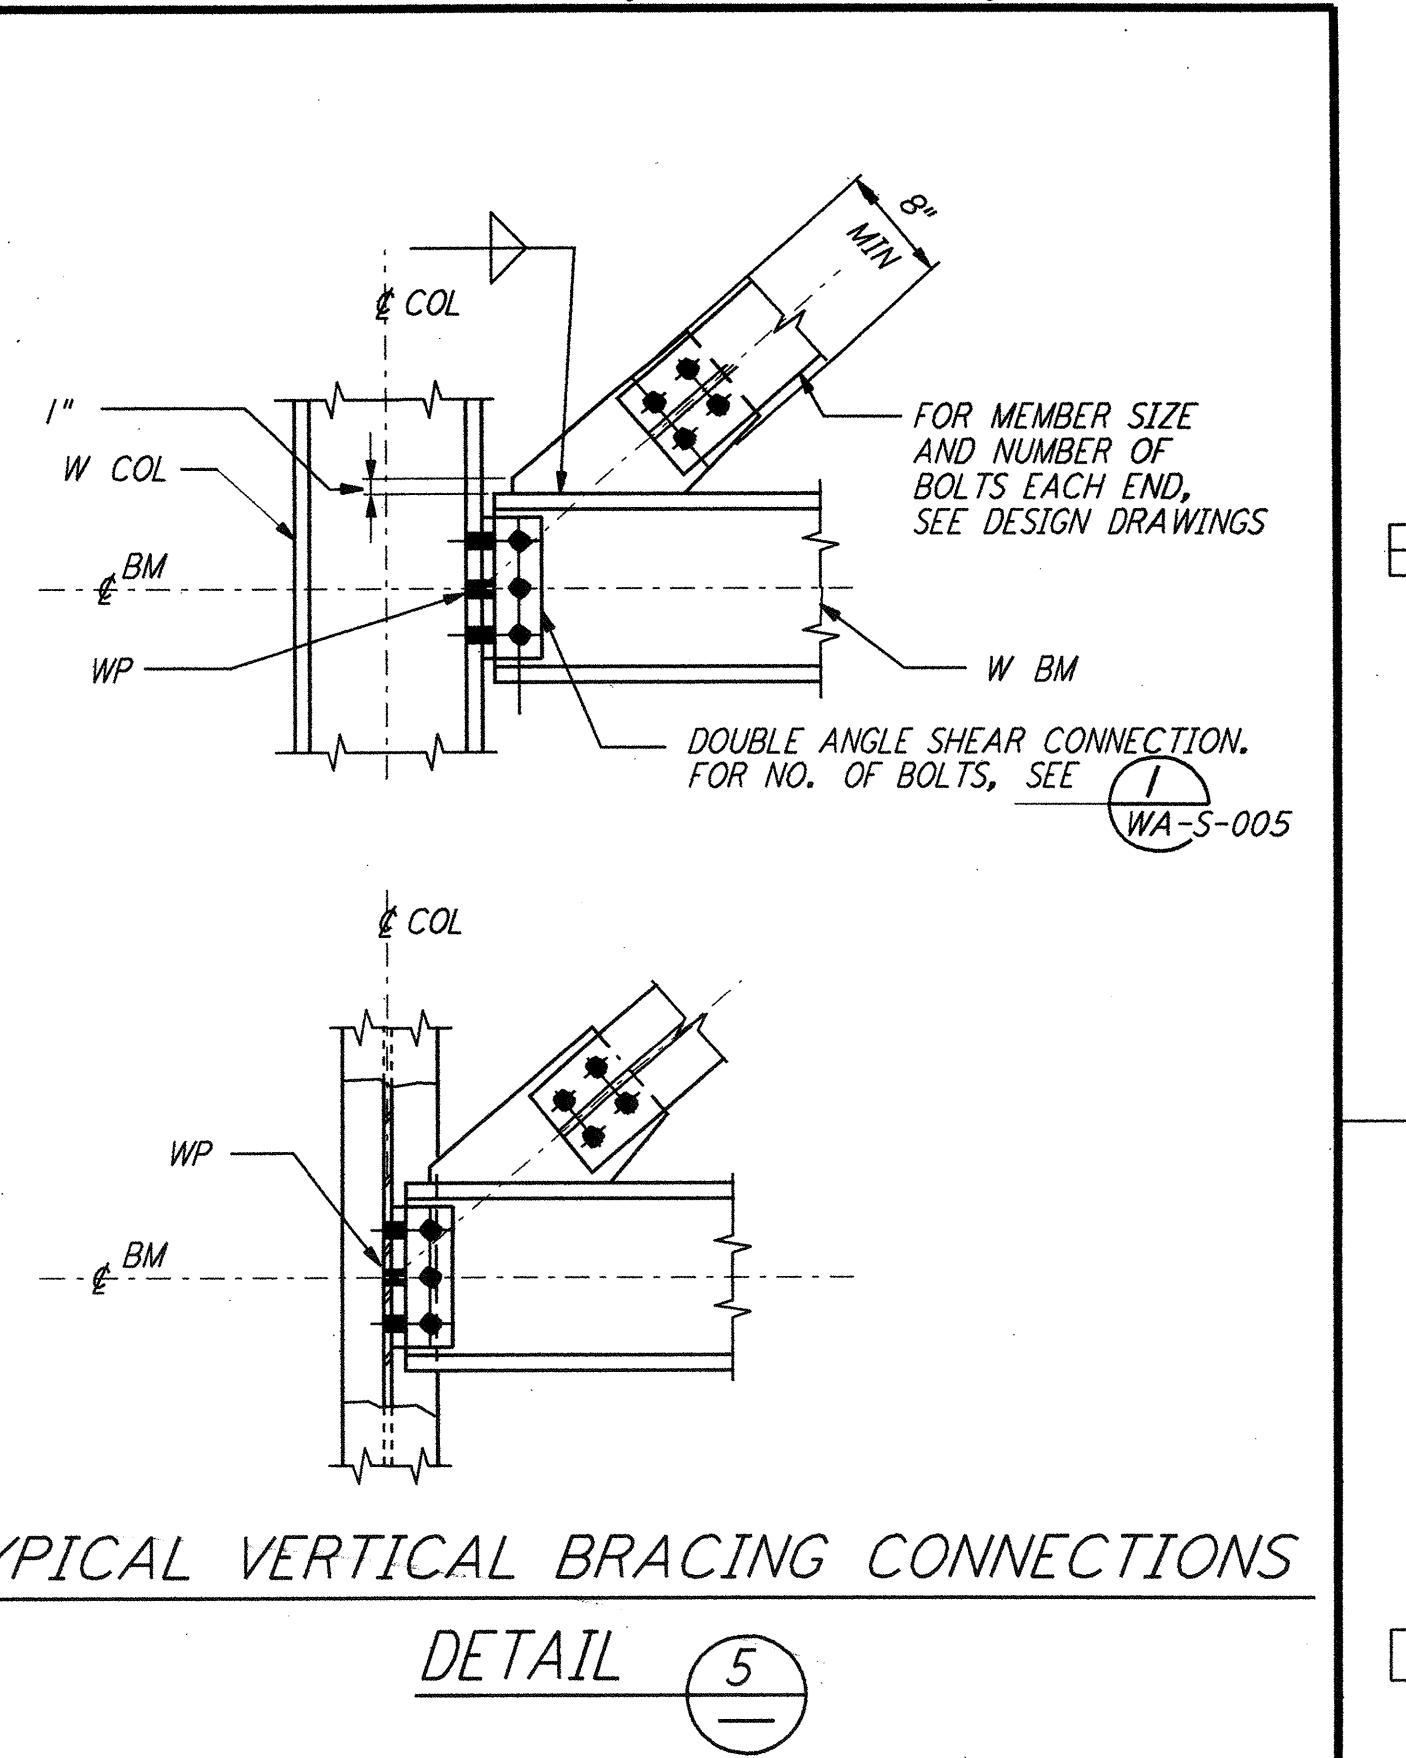


This document and the design it covers are the property of PARSONS. They are loaned only with the borrower's expressed written agreement that they will not be reproduced, copied, loaned, exhibited, or used in any other way, except by written consent from PARSONS to the borrower.

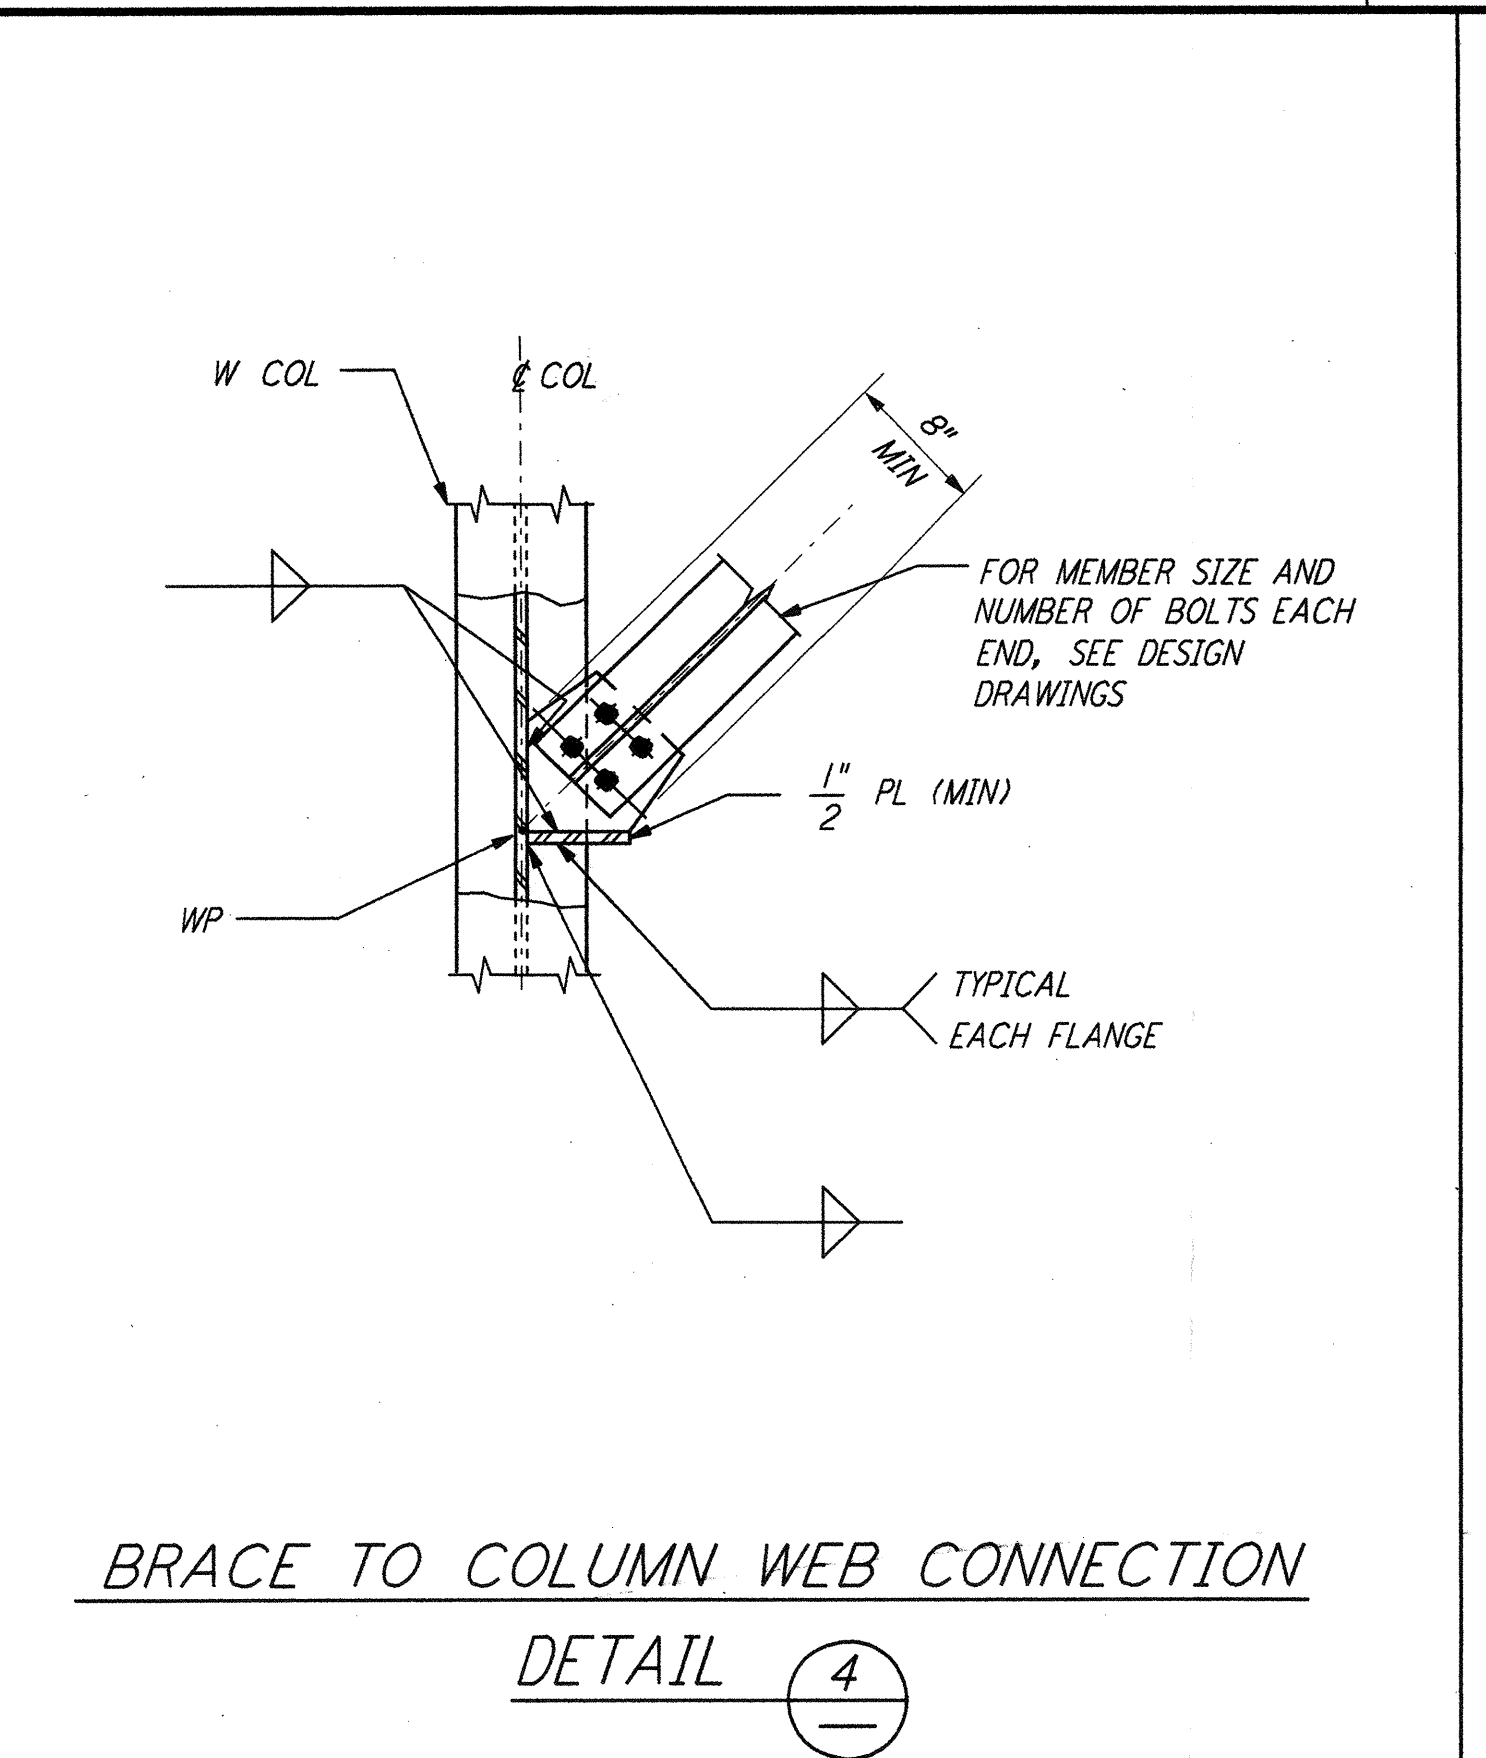

NO OF BOLTS EA END OF VERTICAL BRACING	"L"
6	0'-10"
4	0'-8"

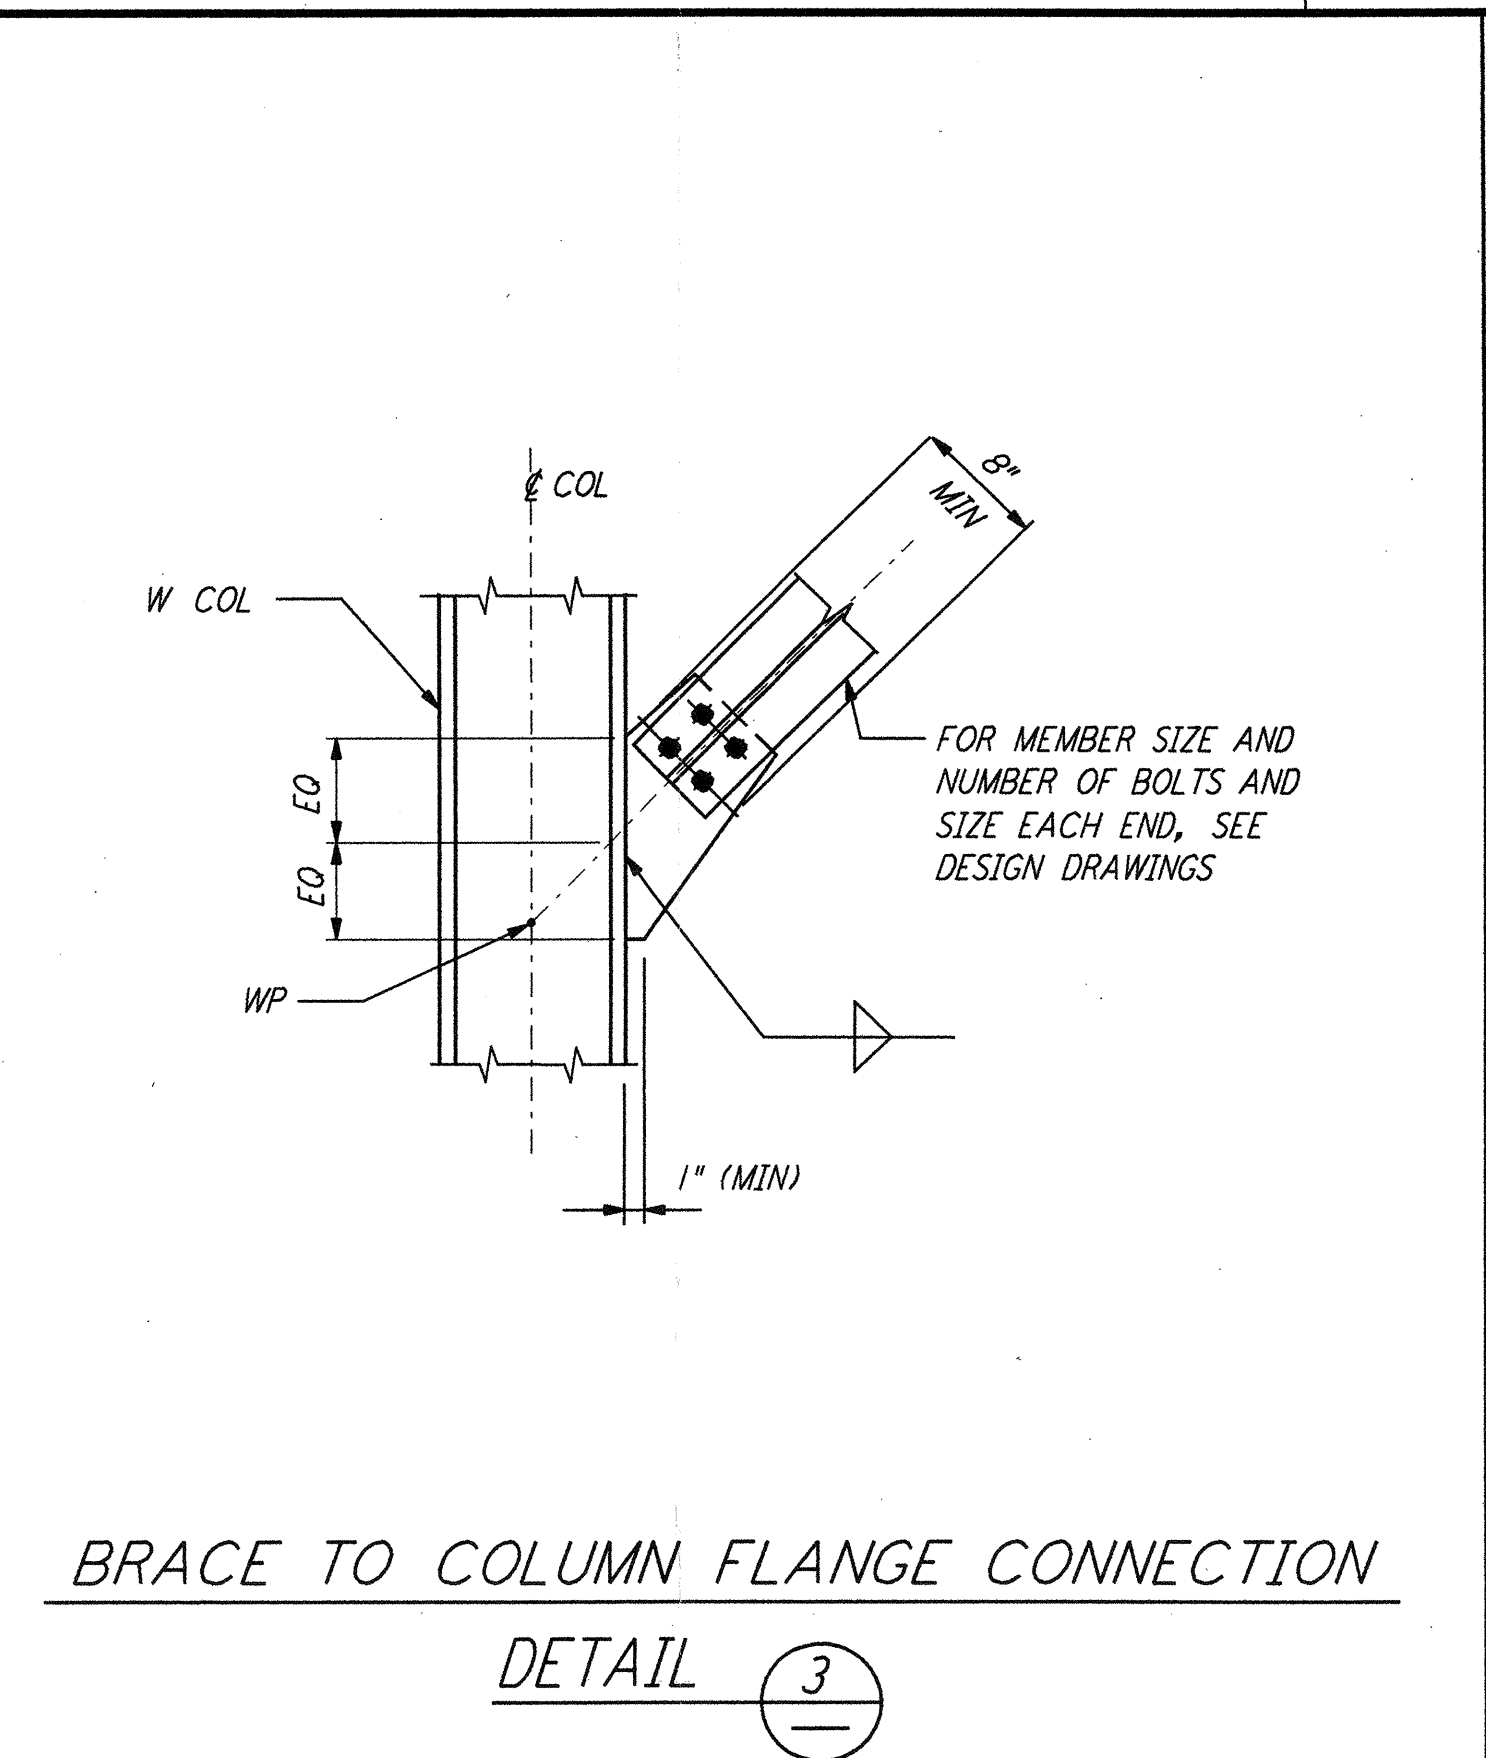

- NOTES:**
- FOR GENERAL NOTES, ABBREVIATIONS AND SYMBOLS, SEE DRAWING S-001.
 - ALL ANGLE VERTICAL BRACING END CONNECTIONS SHALL HAVE TWO BOLTS EACH END UNLESS NOTED OTHERWISE ON THE DESIGN DRAWINGS.

NO.	DATE	BY	CHKD	ENGR	PROJ	DESCRIPTION
1	6-15-98	CKT	BP	MDW	MDW	ISSUED FOR AS-BUILT

NO.	DATE	BY	CHKD	ENGR	PROJ	DESCRIPTION
1	6-24-96	MCS	DDM	BP	MDW	ISSUED FOR CONSTRUCTION
2	7-2-96	DDM	BP	MDW	MDW	CHECKED
3	6-28-96	BP	MDW	MDW	MDW	ENGINEER
4	7-9-96	MDW	MDW	MDW	MDW	PROJ

AS-BUILT DRAWINGS

PARSONS
 100 WEST WALNUT STREET
 PASADENA, CALIFORNIA

LIGO
 CALIFORNIA INSTITUTE OF TECHNOLOGY
 MASSACHUSETTS INSTITUTE OF TECHNOLOGY

LIGO-D960291-01-O

LASER INTERFEROMETER
 GRAVITATIONAL-WAVE OBSERVATORY
 SITE NO. 1 - HANFORD, WASHINGTON

TITLE	SCALE	CONTRACT NUMBER	PROJECT NUMBER
STRUCTURAL STANDARD STRUCTURAL STEEL CONNECTION DETAILS SHEET 3	NONE	PP150969	8094
SHEET NUMBER	REVISIONS	WA-S-006	

Non-Jul-06 15:44:10 1998 C:\PILOT\JOB\ES-1\3862.DWG 52886 K:\V3862\19086.dwg