




LOW ROOF FRAMING PLAN
 1/8" = 1'-0"

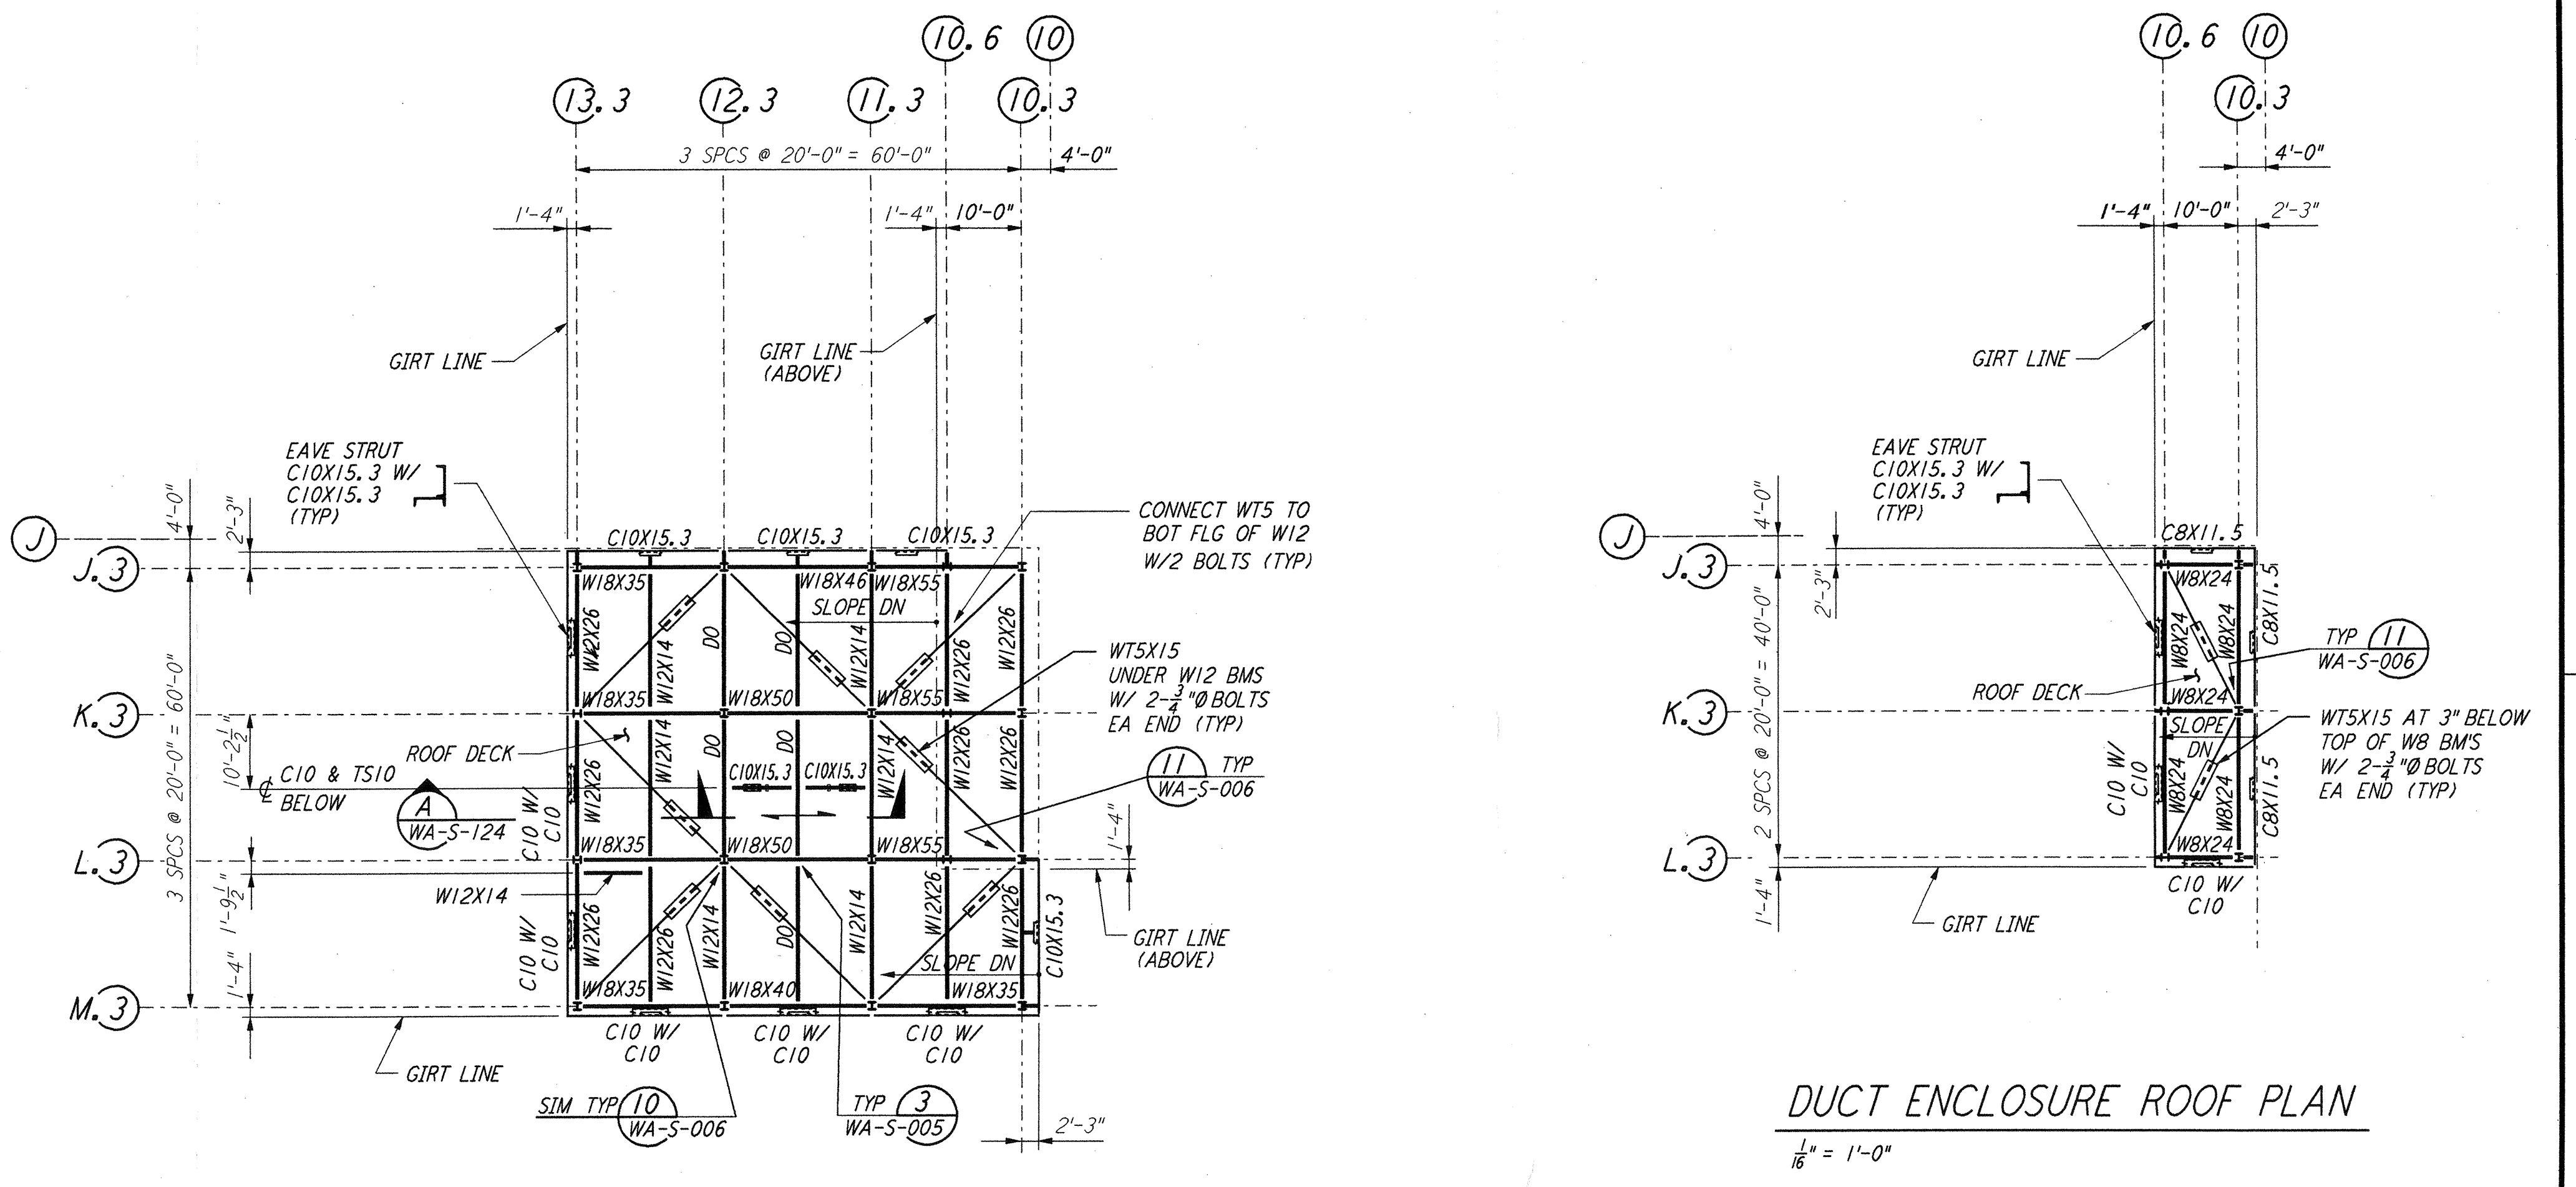


HIGH ROOF FRAMING PLAN
 1/8" = 1'-0"

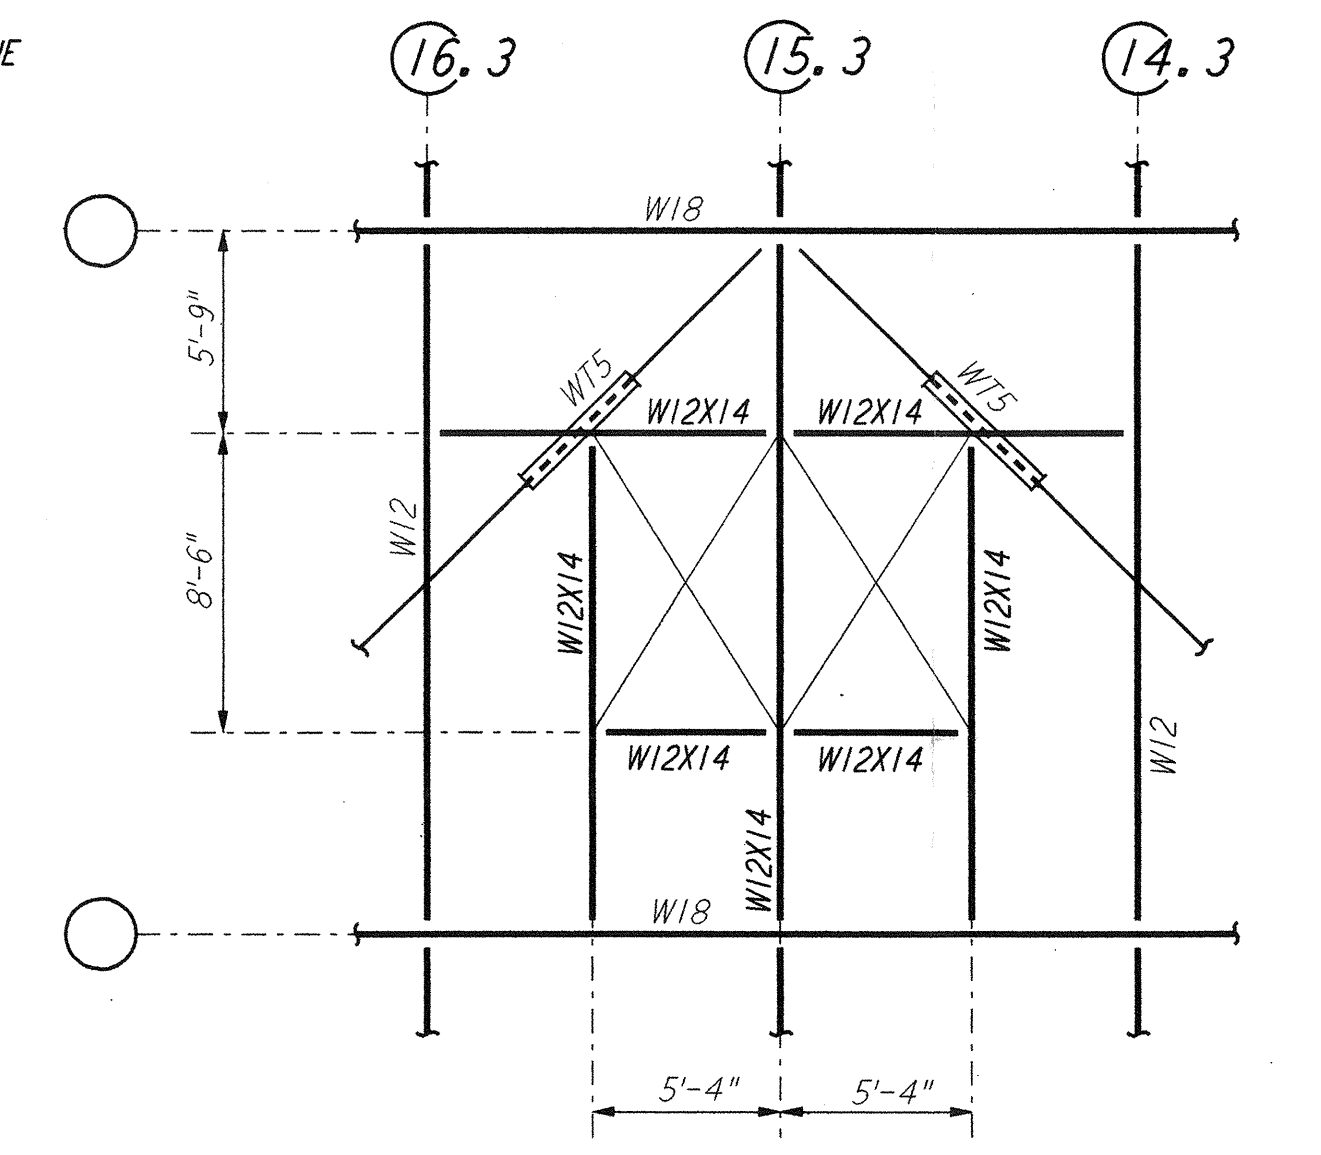

SKYLIGHT FRAMING PLAN
 3/8" = 1'-0"

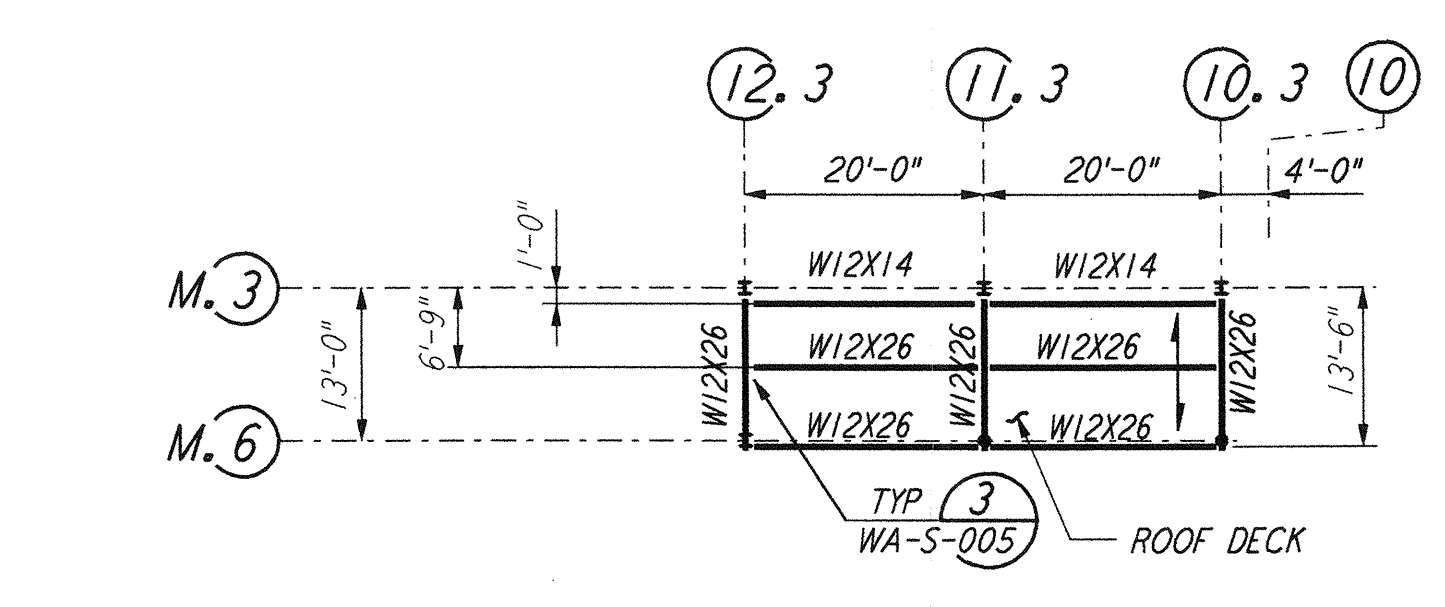


CANOPY FRAMING PLAN
 1/8" = 1'-0"

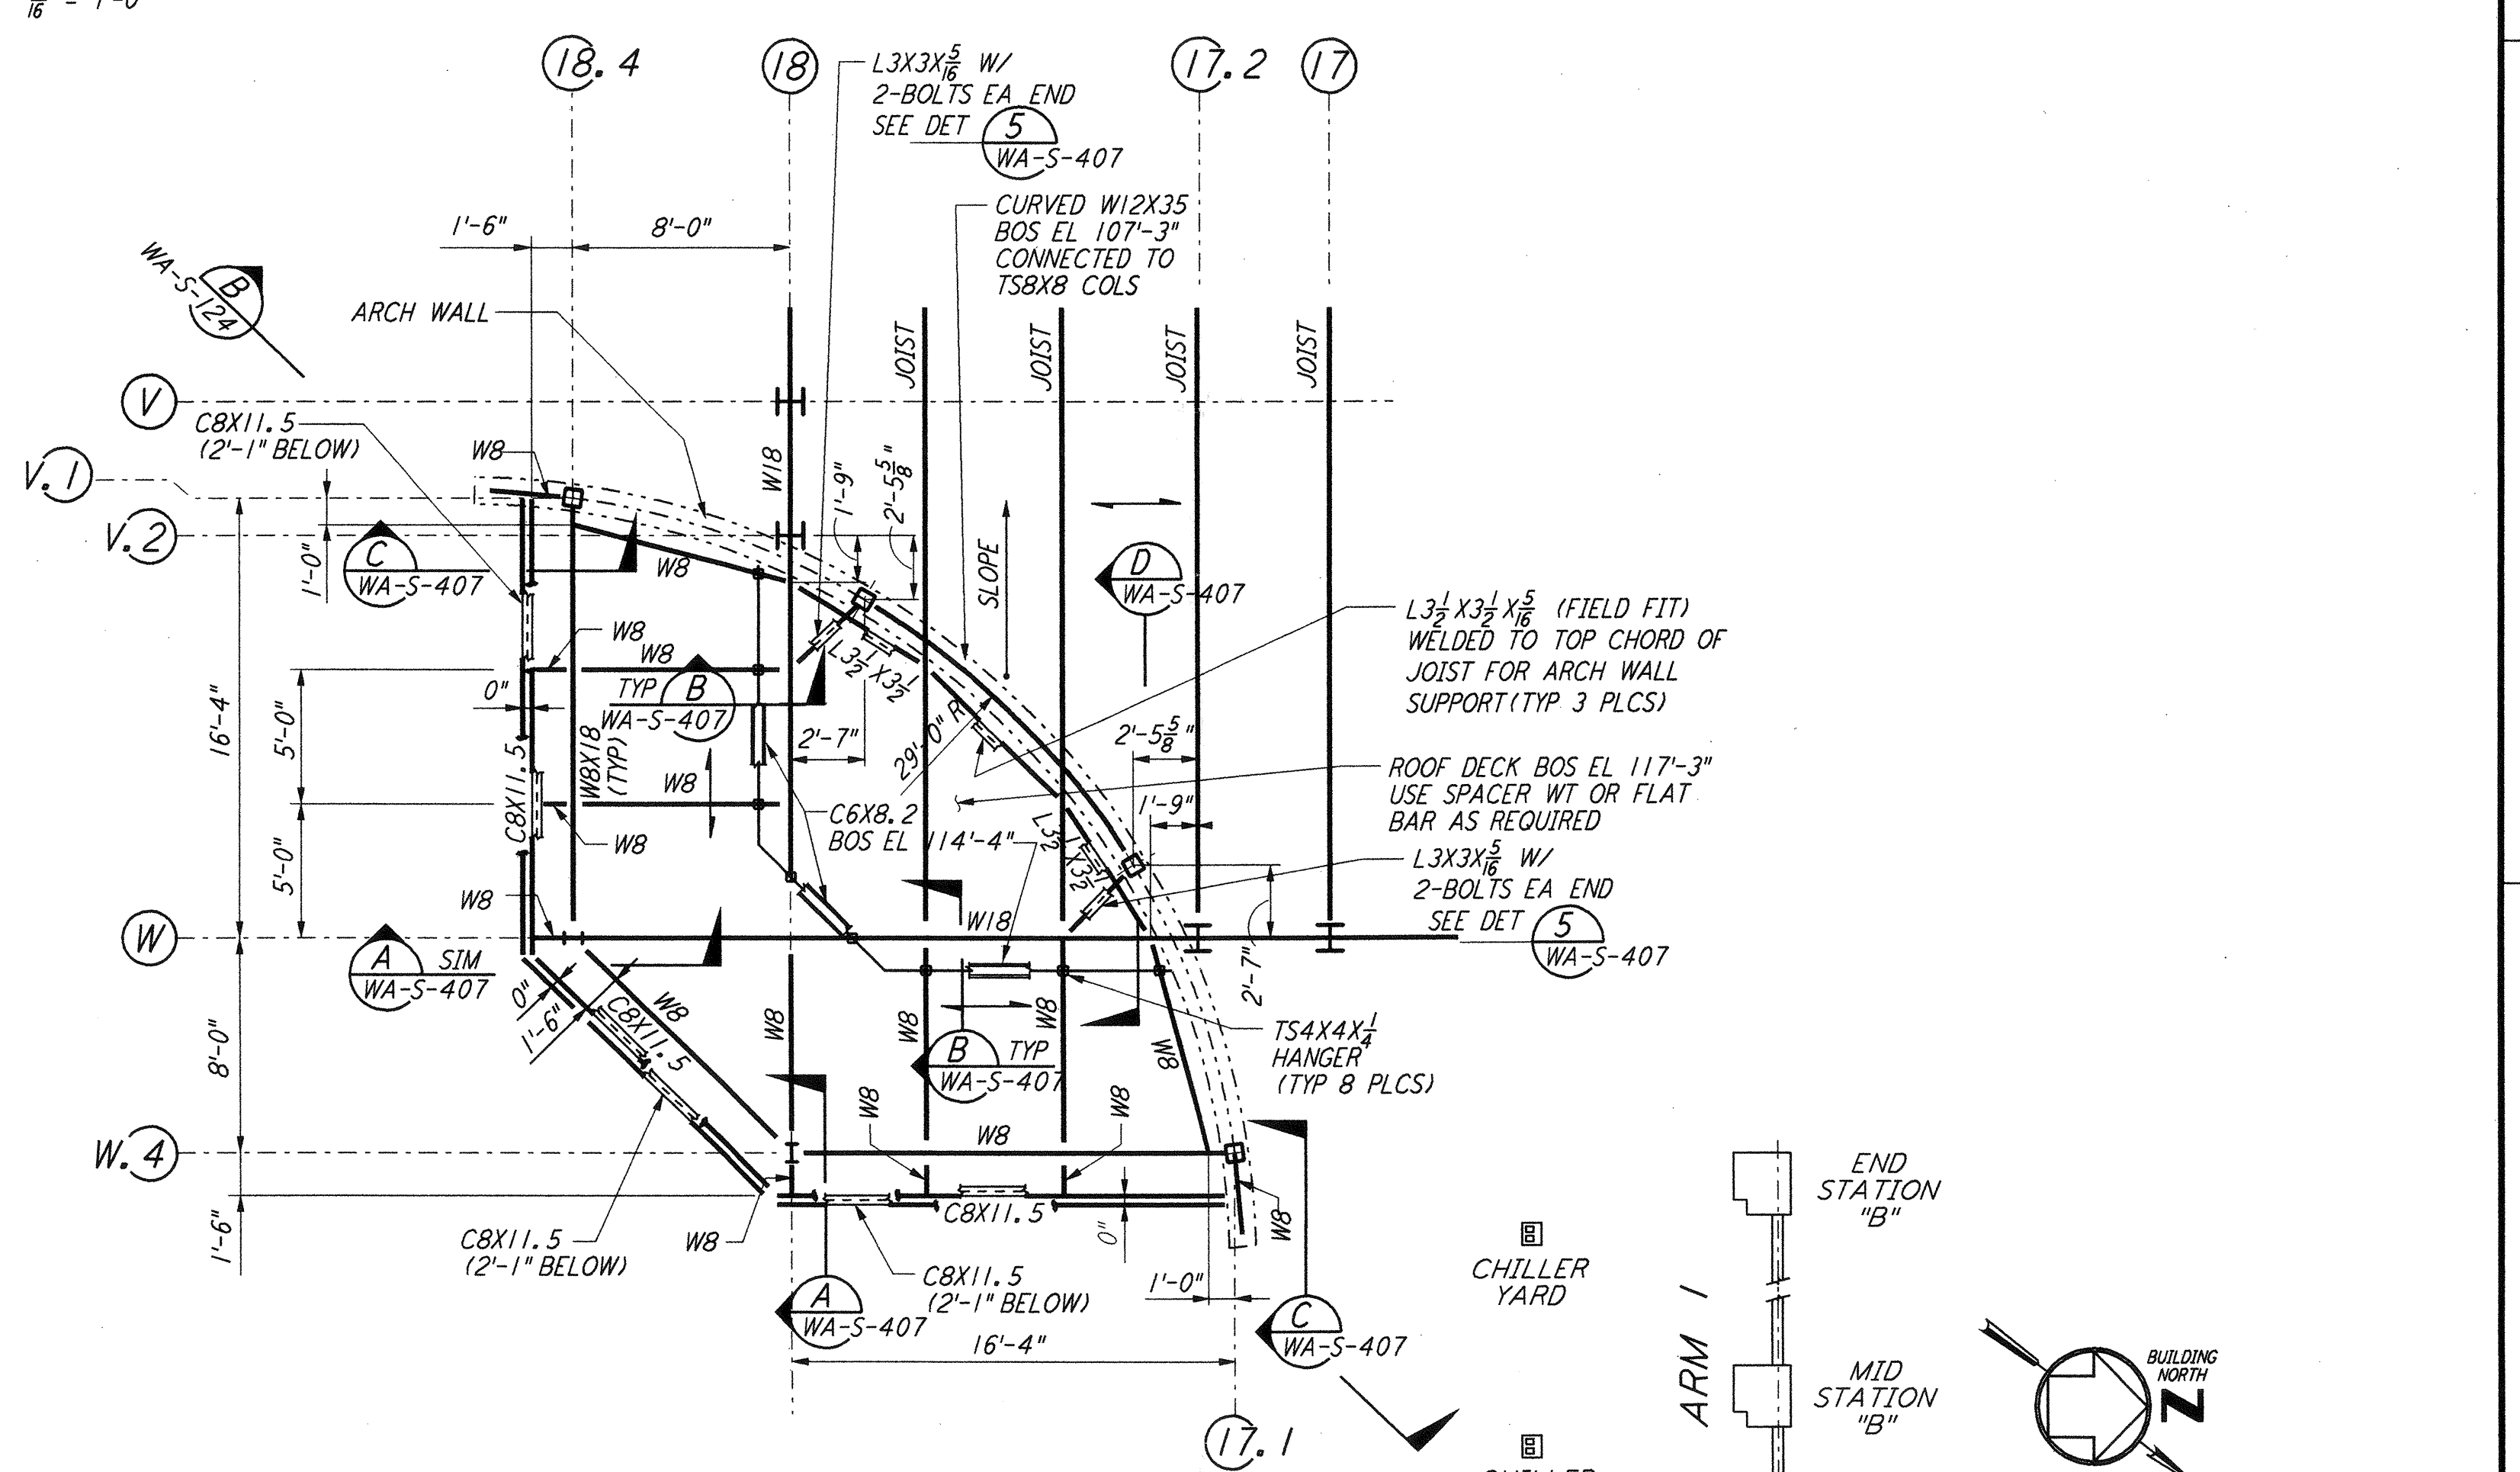


ENLARGED FRAMING PLAN
 3/8" = 1'-0"

NOTE:
 1. FOR STRUCTURAL GENERAL NOTES, ABBREVIATIONS AND LEGEND, SEE DWG WA-S-001.

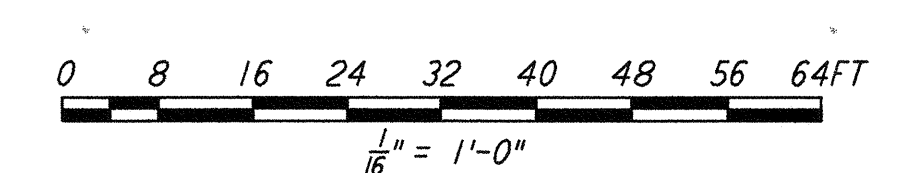

DUCT ENCLOSURE ROOF PLAN
 1/8" = 1'-0"

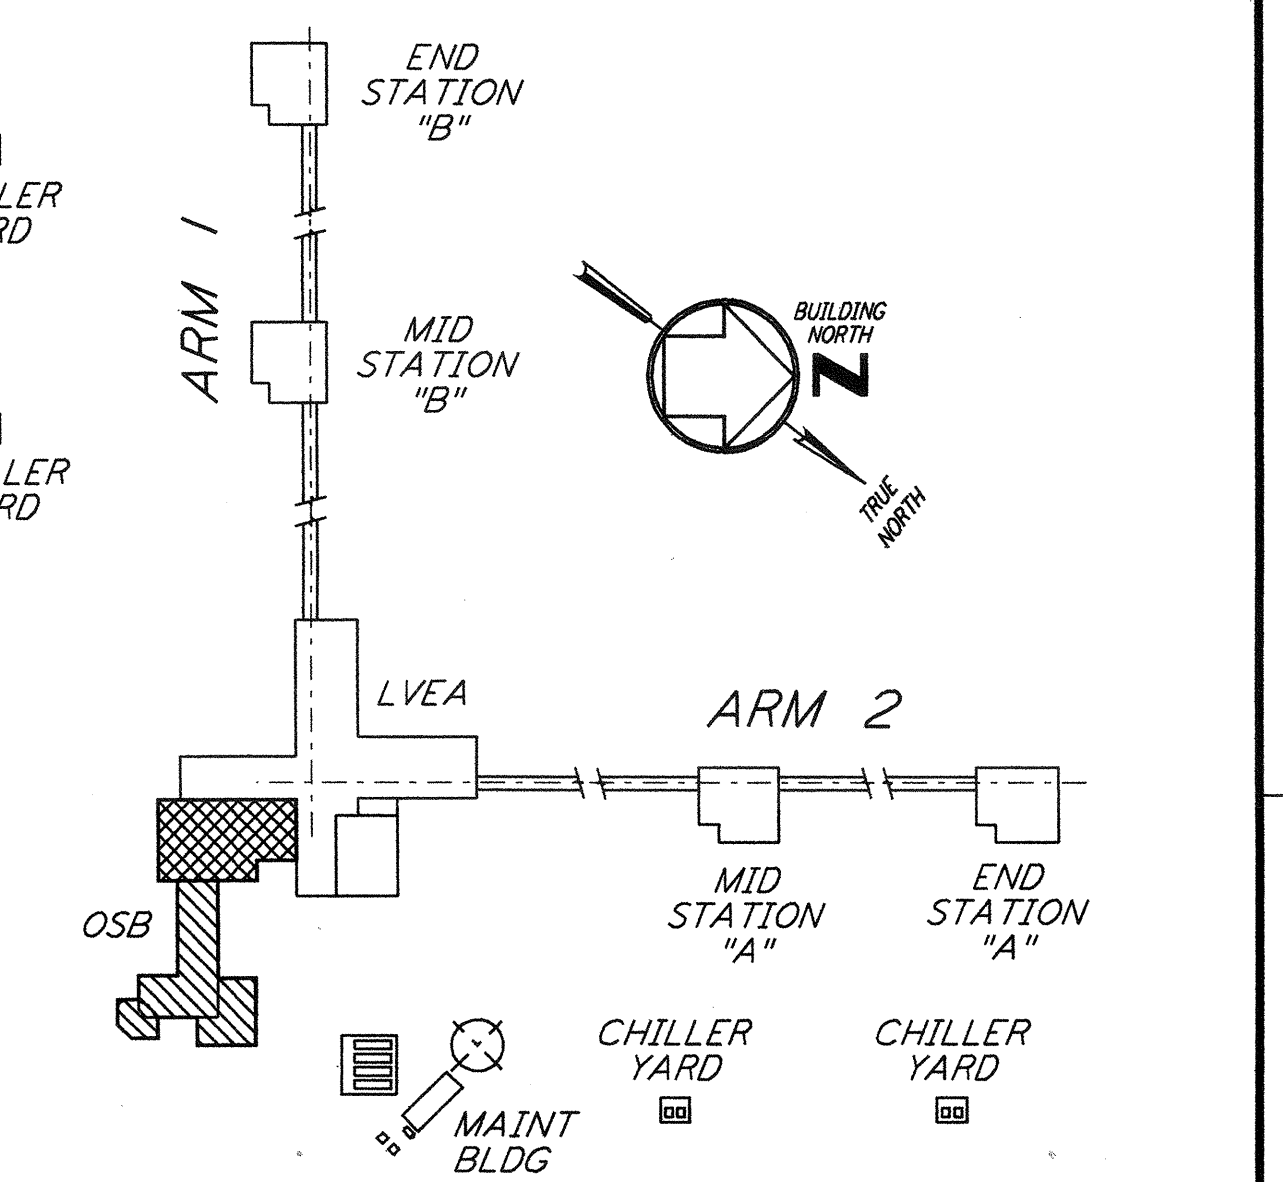

KEY PLAN
LIGO-D960297-02-0

This document and the design it covers are the property of PARSONS. They are loaned only with the borrower's expressed written agreement that they will not be reproduced, copied, loaned, exhibited, or used in any other way, except by written consent from PARSONS to the borrower.

This document and the design it covers are the property of PARSONS. They are loaned only with the borrower's expressed written agreement that they will not be reproduced, copied, loaned, exhibited, or used in any other way, except by written consent from PARSONS to the borrower.

NO.	DATE	BY	CHKD	ENGR	PROJ	DESCRIPTION
1	6-15-98	CKT	BP	BP	MDW	ISSUED FOR AS-BUILT
2	2-28-97	RIM	AB	BP	TDM	ADDED SKYLIGHT FRMG

ISSUED FOR CONSTRUCTION	DATE
DRAWN MCS	6-24-96
CHECKED DDM	7-2-96
ENGINEER BP	6-28-96
PROJ MDW	7-9-96

AS-BUILT DRAWINGS

100 WEST WALNUT STREET
 PASADENA, CALIFORNIA

CALIFORNIA INSTITUTE OF TECHNOLOGY
 MASSACHUSETTS INSTITUTE OF TECHNOLOGY

LASER INTERFEROMETER
 GRAVITATIONAL-WAVE OBSERVATORY
 SITE NO. 1 - HANFORD, WASHINGTON

TITLE	SCALE	CONTRACT NUMBER	PROJECT NUMBER
STRUCTURAL CORNER STATION OSB ROOF FRAMING PLANS	AS NOTED	PP150969	8094
SHEET NUMBER	REVISIONS		
WA-S-117			