


NOTE:
 1. FOR STRUCTURAL GENERAL NOTES, ABBREVIATIONS AND LEGEND, SEE DWG WA-S-001.

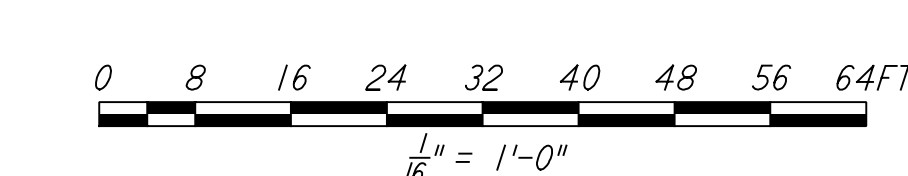

This document and the design it covers are the property of PARSONS. They are loaned only with the borrower's expressed written agreement that they will not be reproduced, copied, loaned, exhibited, or used in any other way, except by written consent from PARSONS to the borrower.

NO.	DATE	BY	CHKD	ENGR	PROJ	TDM	DESCRIPTION
1	6-15-98	CKT					ISSUED FOR AS-BUILT
2	2-28-97	AB	BP	TDM			ADDED SKYLIGHT FRMG

NO.	DATE	BY	CHKD	ENGR	PROJ	TDM	DESCRIPTION
1	6-24-96	MCS					ISSUED FOR CONSTRUCTION
2	7-2-96	DDM					CHECKED
3	6-28-96	BP					ENGINEER
4	7-9-96	MDW					PROJ

AS-BUILT DRAWINGS



LIGO-D960297-02-O

LASER INTERFEROMETER
 GRAVITATIONAL-WAVE OBSERVATORY
 SITE NO. 1 - HANFORD, WASHINGTON

STRUCTURAL CORNER STATION OSB ROOF FRAMING PLANS

SCALE: AS NOTED
 SHEET NUMBER: PPI50969
 PROJECT NUMBER: 8094

REVISIONS: **WA-S-117**