


- NOTES:**
- CONSTRUCTION SHALL COMPLY WITH ALL THE REQUIREMENTS OF THE GENERAL NOTES ON DRAWING WA-5-001.
 - THE BAR SPACING IS BASED ON CENTER TO CENTER OF TIE SET.
 - FOR ANCHOR BOLT DETAILS SEE DRAWING WA-5-003.

NO. OF FOUNDATIONS	LOCATION (COL LINES)	TOP OF CONC. EL.	FOUNDATION TYPE	DIMENSIONS															ANCHOR BOLTS PER PIER				REINFORCING PER FOUNDATION										CONC. CY	FDN LOC PLAN	REMARKS		
				PLAN	ELEV	A	B	C	D	F	G	H	J	K	M	R	N	ANCHOR BOLT PLAN	TYPE	NO PER PIER	SIZE D	L	P	BAR S NO	BAR S SIZE	BAR Z NO	BAR Z SIZE	BAR T NO	BAR T SIZE	BAR Y NO	BAR Y SIZE	BAR W NO				BAR W SIZE	TIE BAR TYPE
1	L.3-16.3	100'-0"	A 1	4'-6"	4'-6"	1'-0"	10"	10"	10"	10"	2'-6"	1"	7"	7"	---	III	2	4	1"	1'-4"	4"	5	#5	5	#5	5	#5	5	#5	8	#6	B	#4	5	1.0	WA-5-102	
1	L.3-15.3	100'-0"	A 1	4'-6"	4'-6"	1'-0"	10"	10"	10"	10"	2'-6"	1"	7"	7"	---	III	2	4	1"	1'-4"	4"	5	#5	5	#5	5	#5	5	#5	8	#6	B	#4	5	1.0	WA-5-102	
1	N.3-15.3	100'-0"	A 1	4'-6"	4'-6"	1'-0"	10"	10"	10"	10"	2'-6"	1"	7"	7"	---	III	2	4	1"	1'-4"	4"	5	#5	5	#5	5	#5	5	#5	8	#6	B	#4	5	1.0	WA-5-102	
1	V-15.3	100'-0"	A 1	4'-6"	4'-6"	1'-0"	10"	10"	10"	10"	1'-8"	1"	7"	7"	---	III	2	4	1"	1'-4"	4"	5	#5	5	#5	5	#5	5	#5	8	#6	B	#4	4	1.0	WA-5-102	
1	J.3-14.3	100'-0"	A 1	4'-0"	4'-8"	1'-0"	10"	10"	10"	10"	1'-8"	1"	7"	7"	---	III	2	4	1"	1'-4"	4"	5	#5	5	#5	5	#5	5	#5	8	#6	B	#4	4	1.0	WA-5-102	
1	L.3-14.3	100'-0"	A 1	4'-6"	4'-6"	1'-0"	10"	10"	10"	10"	1'-8"	1"	7"	7"	---	III	2	4	1"	1'-4"	4"	5	#5	5	#5	5	#5	5	#5	8	#6	B	#4	4	1.0	WA-5-102	
1	J.3-13.3	100'-0"	A 1	4'-0"	4'-8"	1'-0"	10"	10"	10"	10"	1'-8"	1"	7"	7"	---	III	2	4	1"	1'-4"	4"	5	#5	5	#5	5	#5	5	#5	8	#6	B	#4	4	1.0	WA-5-102	
1	K.3-13.3	100'-0"	A 1	4'-6"	4'-6"	1'-0"	10"	10"	10"	10"	1'-8"	1"	7"	7"	---	III	2	4	1"	1'-4"	4"	5	#5	5	#5	5	#5	5	#5	8	#6	B	#4	4	1.0	WA-5-102	
1	M.3-12.3	100'-0"	A 1	5'-0"	5'-0"	1'-0"	10"	10"	10"	10"	1'-8"	1"	7"	7"	---	III	2	4	1"	1'-4"	4"	6	#5	6	#5	6	#5	6	#5	8	#6	B	#4	4	1.2	WA-5-102	
1	N.3-12.3	100'-0"	A 1	5'-0"	5'-0"	1'-0"	10"	10"	10"	10"	1'-8"	1"	7"	7"	---	III	2	4	1"	1'-4"	4"	6	#5	6	#5	6	#5	6	#5	8	#6	B	#4	4	1.2	WA-5-102	
1	M.6-10.3	100'-0"	A 1	3'-0"	3'-0"	1'-0"	10"	10"	10"	10"	1'-8"	1"	1'-0"	1'-0"	---	III	2	4	1"	1'-4"	4"	4	#5	4	#5	-	-	-	8	#6	B	#4	4	0.5	WA-5-102		
1	M.6-11.3	100'-0"	A 1	3'-0"	3'-0"	1'-0"	10"	10"	10"	10"	1'-8"	1"	1'-0"	1'-0"	---	III	2	4	1"	1'-4"	4"	4	#5	4	#5	-	-	-	8	#6	B	#4	4	0.5	WA-5-102		
1	V.1-18.4	100'-0"	A 1	---	---	---	10"	10"	10"	10"	1'-8"	1"	8"	1'-0"	---	III	2	4	1"	1'-4"	4"	-	-	-	-	-	-	8	#6	B	#4	4	0.5	WA-5-102	FOR ADDL INFO SEE P/WA-5-405		
1	W-18.4	100'-0"	A 1	3'-0"	3'-0"	1'-0"	10"	10"	10"	10"	1'-8"	1"	5"	5"	---	III	2	4	1"	1'-4"	4"	4	#5	4	#5	-	-	-	8	#6	B	#4	4	0.5	WA-5-102		
1	W.4-17.1	100'-0"	A 1	---	---	---	10"	10"	10"	10"	1'-8"	1"	1'-0"	8"	---	III	2	4	1"	1'-4"	4"	-	-	-	-	-	-	8	#6	B	#4	4	0.5	WA-5-102	FOR ADDL INFO SEE P/WA-5-405		
1	W.4-18	100'-0"	A 1	3'-0"	3'-0"	1'-0"	10"	10"	10"	10"	1'-8"	1"	5"	5"	---	III	2	4	1"	1'-4"	4"	4	#5	4	#5	-	-	-	8	#6	B	#4	4	0.5	WA-5-102		

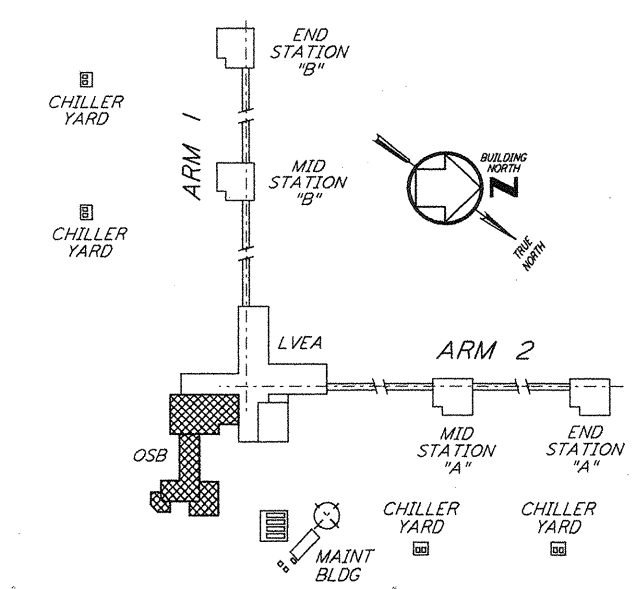

This document and the design it covers are the property of PARSONS. They are loaned only with the borrower's expressed written agreement that they will not be reproduced, copied, loaned, exhibited, or used in any other way, except by written consent from PARSONS to the borrower.

NO.	DATE	BY	CHKD	ENGR	PROJ	DESCRIPTION
1	6-15-96	CKT	PL	HW	---	ISSUED FOR AS-BUILT

ISSUED FOR CONSTRUCTION
 DRAWN: MCS 6-24-96
 CHECKED: DDM 7-2-96
 ENGINEER: BP 6-28-96
 PROJ: MDW 7-9-96

AS-BUILT DRAWINGS

PARSONS
 100 WEST WALNUT STREET
 PASADENA, CALIFORNIA

LIGO
 CALIFORNIA INSTITUTE OF TECHNOLOGY
 MASSACHUSETTS INSTITUTE OF TECHNOLOGY

LASER INTERFEROMETER
 GRAVITATIONAL-WAVE OBSERVATORY
 SITE NO. 1 - HANFORD, WASHINGTON

TITLE: STRUCTURAL CORNER STATION - OSB FOUNDATION SCHEDULE AND DETAILS SHEET I

SCALE: NONE CONTRACT NUMBER: PPI50969 PROJECT NUMBER: 8094

SHEET NUMBER: **WA-S-402**