



not be reproduced, copied, loaned, exhibited, or used in any other way, except by written consent from PARSONS to the borrower.

This document and the design it covers are the property of PARSONS. They are loaned only with the borrower's expressed written agreement that they will

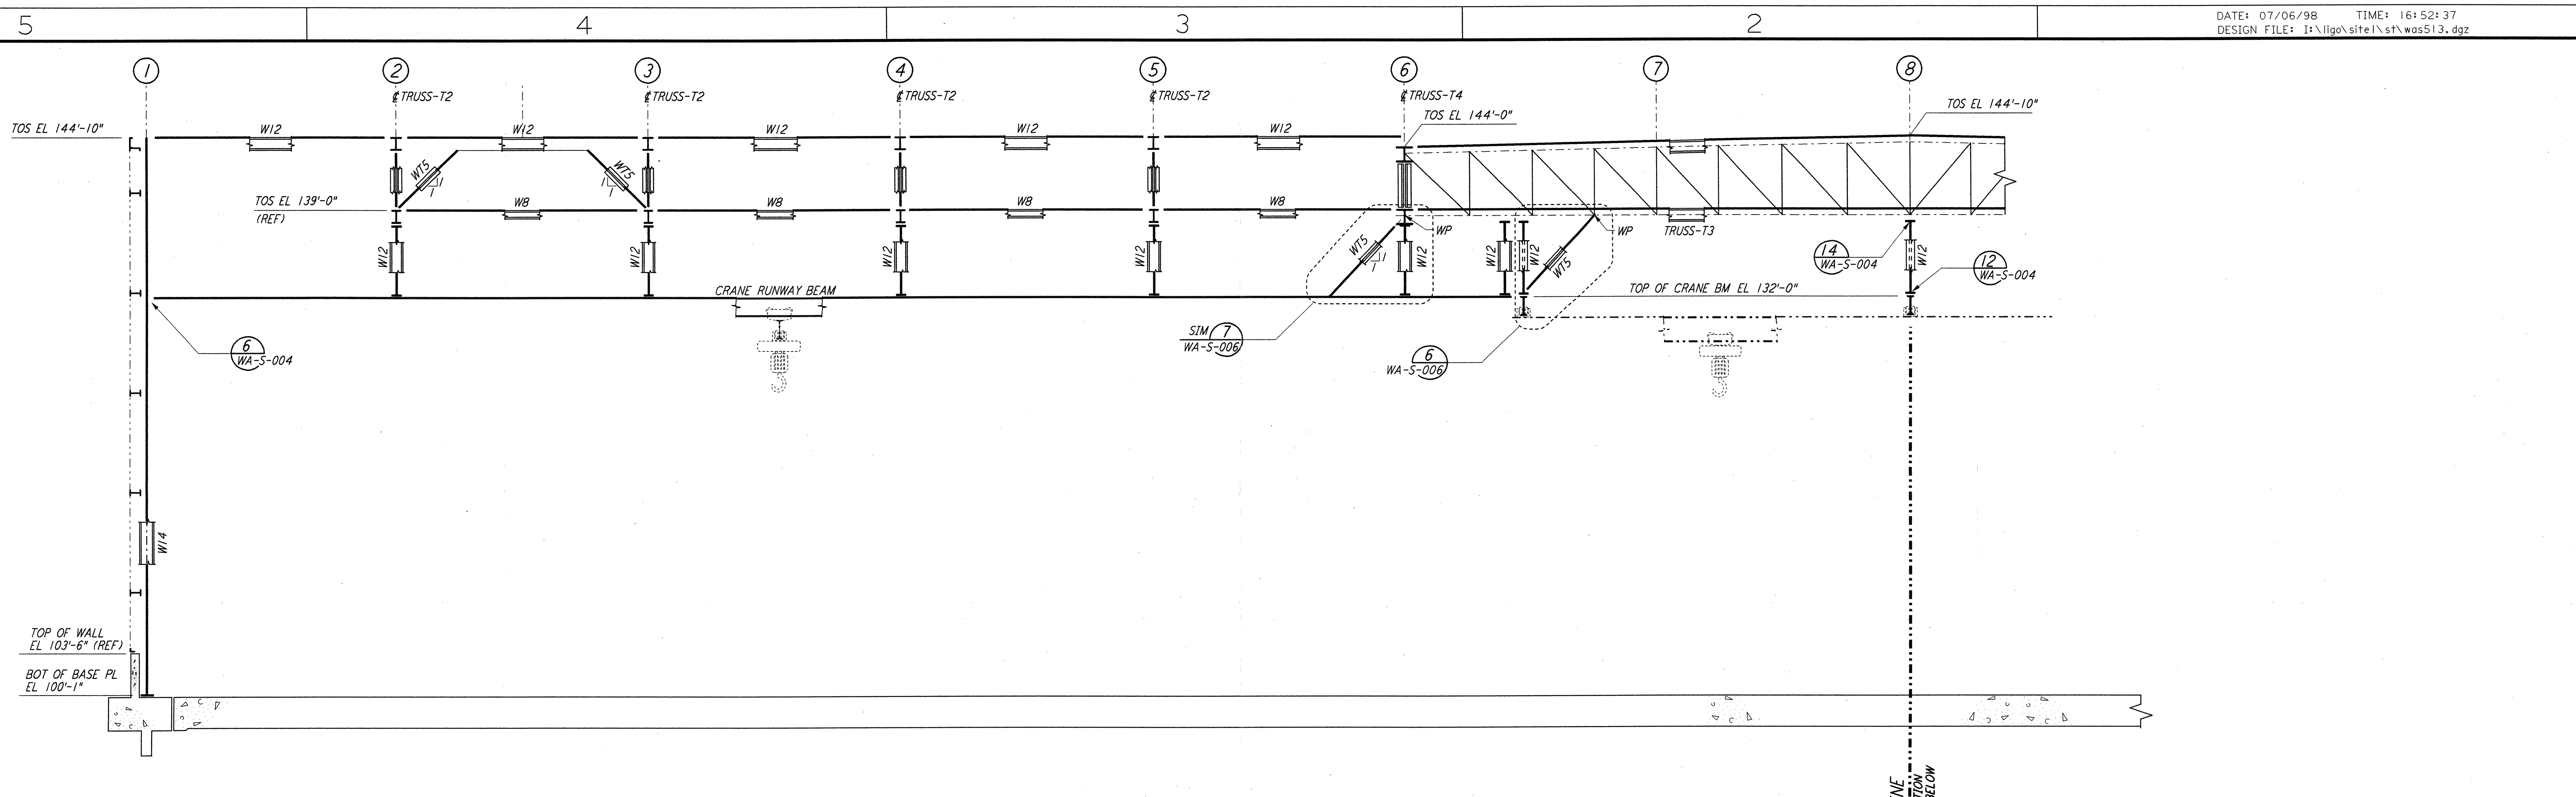


PARTIAL ELEVATION AT COLUMN LINE H  
 $\frac{3}{8}'' = 1'-0''$

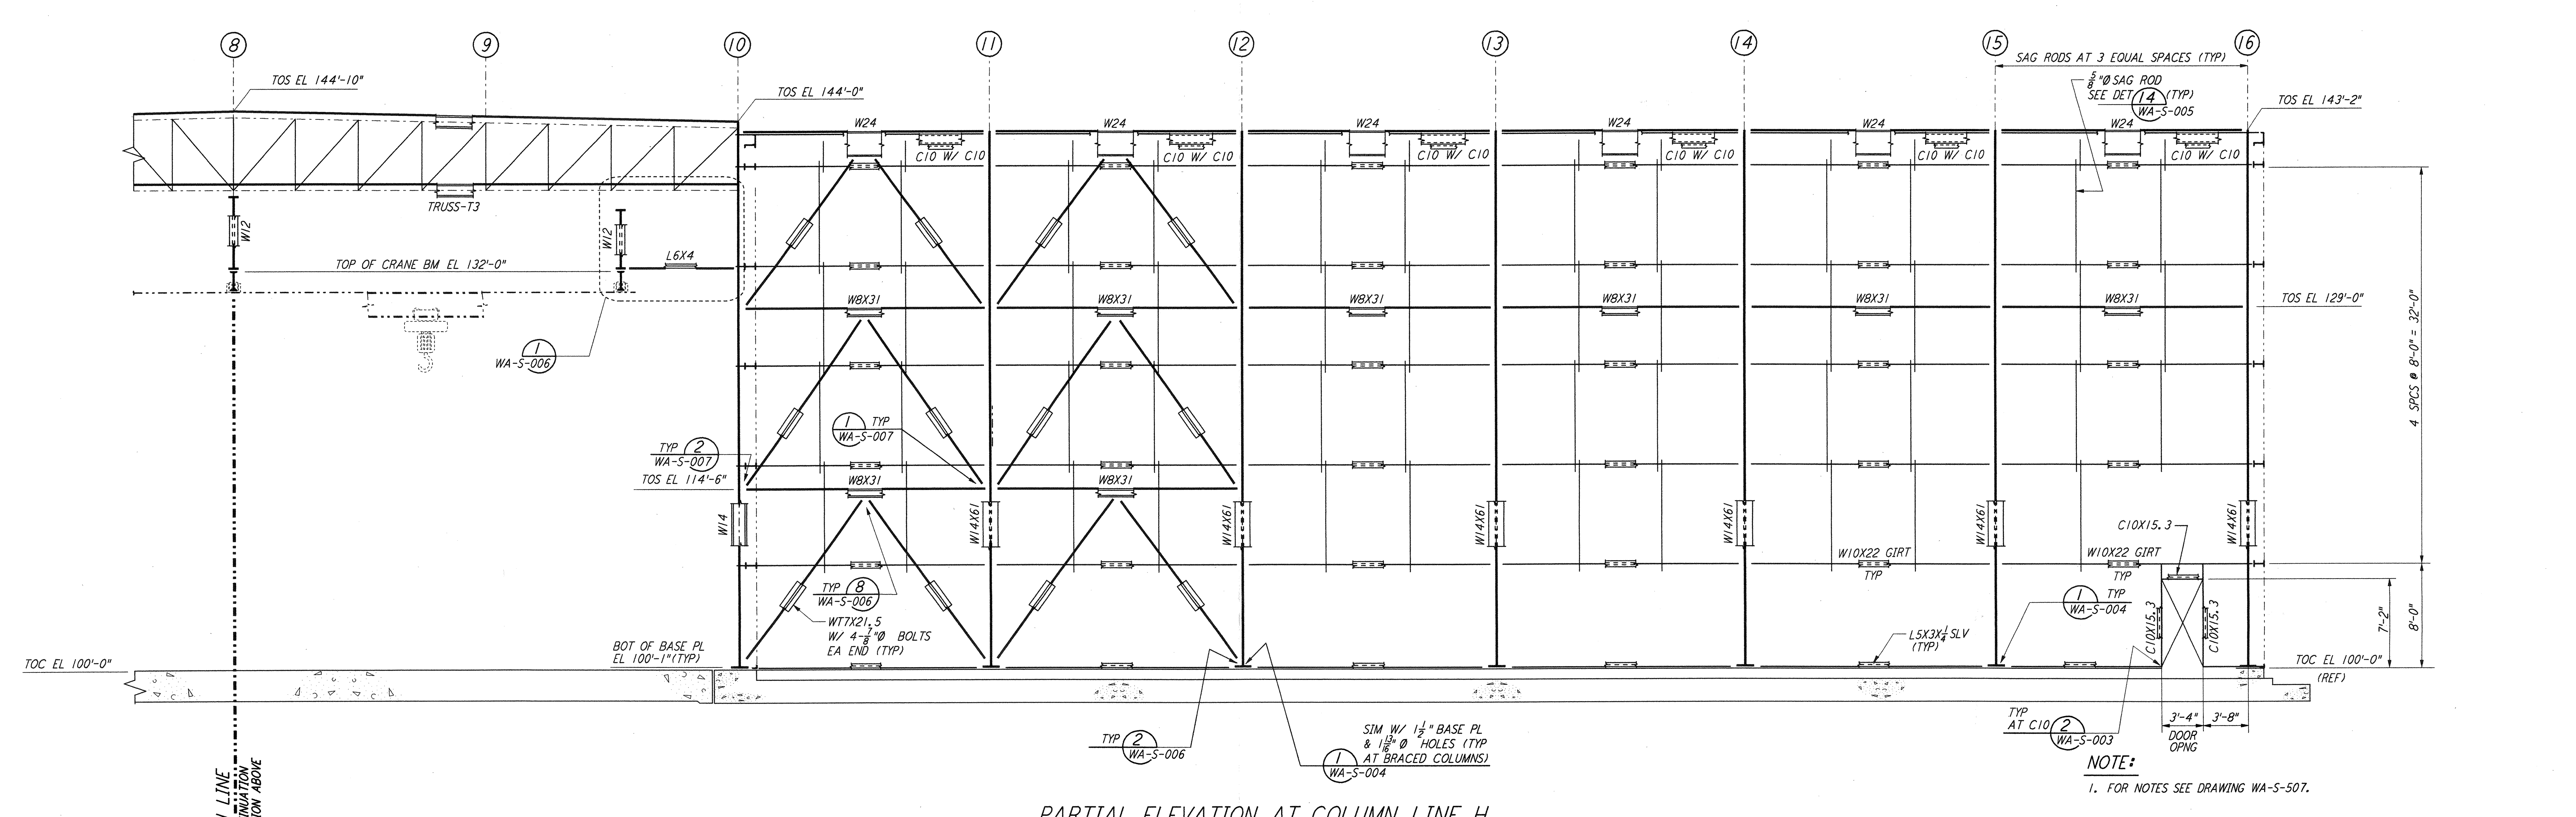

PARTIAL ELEVATION AT COLUMN LINE H  
 $\frac{3}{8}'' = 1'-0''$

NOTE:  
 1. FOR NOTES SEE DRAWING WA-S-507.

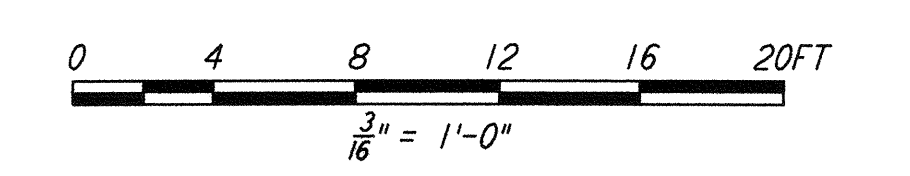

LIGO-D960334-01-O

REV.	NO.	DATE	BY	CHKD	ENGR	PROJ	DESCRIPTION
1	6-15-98	CKT	BP	BP	DP		ISSUED FOR AS-BUILT

ISSUED FOR CONSTRUCTION	MCS	6-24-96
DRAWN	DDM	7-2-96
CHECKED	BP	6-28-96
ENGINEER	MDW	7-9-96
PROJ		

**AS-BUILT DRAWINGS**

**PARSONS**

100 WEST WALNUT STREET  
 PASADENA, CALIFORNIA

**LIGO**

CALIFORNIA INSTITUTE OF TECHNOLOGY  
 MASSACHUSETTS INSTITUTE OF TECHNOLOGY

LASER INTERFEROMETER  
 GRAVITATIONAL-WAVE OBSERVATORY  
 SITE NO. 1 - HANFORD, WASHINGTON

TITLE: STRUCTURAL CORNER STATION LVEA FRAMING ELEVATIONS SHEET 7

AS NOTED PP150969 8094

**WA-S-513**