




SECTION **A** REF  
 NTS WA-E-112

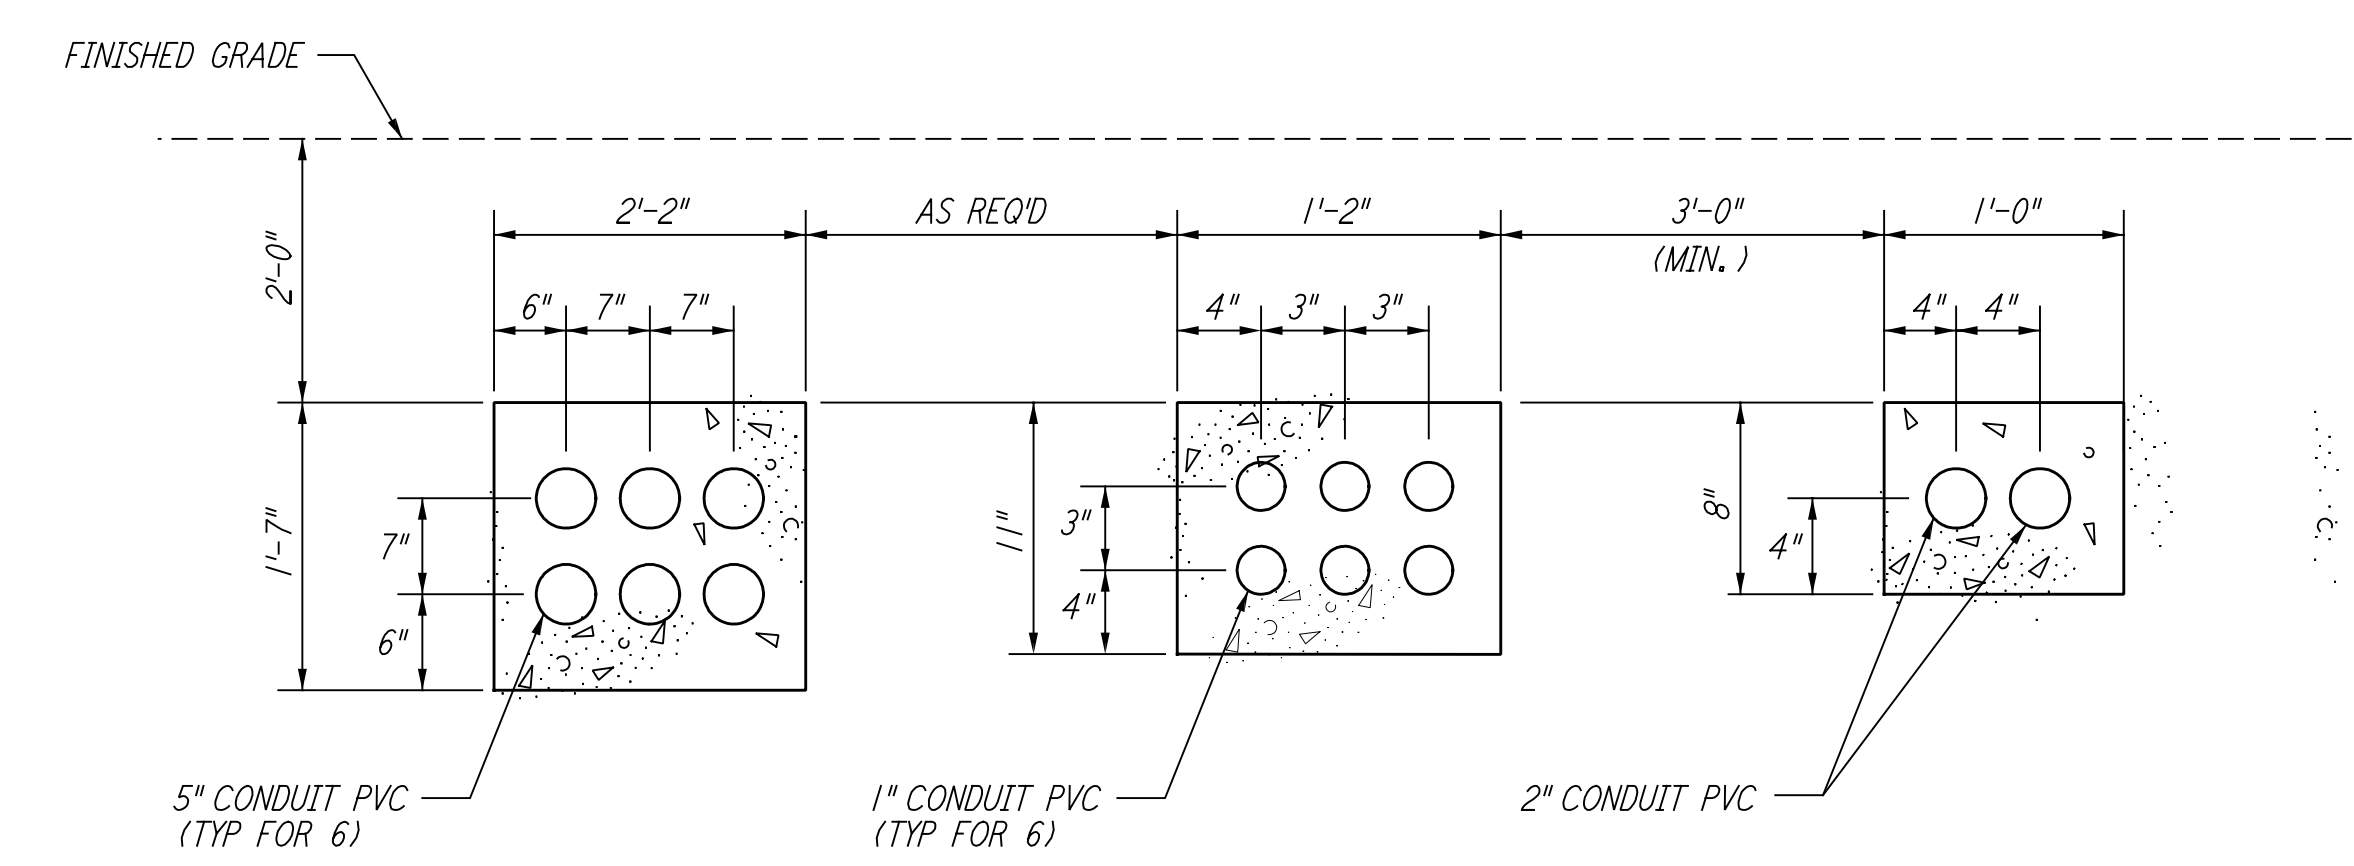


SECTION **B** REF  
 NTS WA-E-112

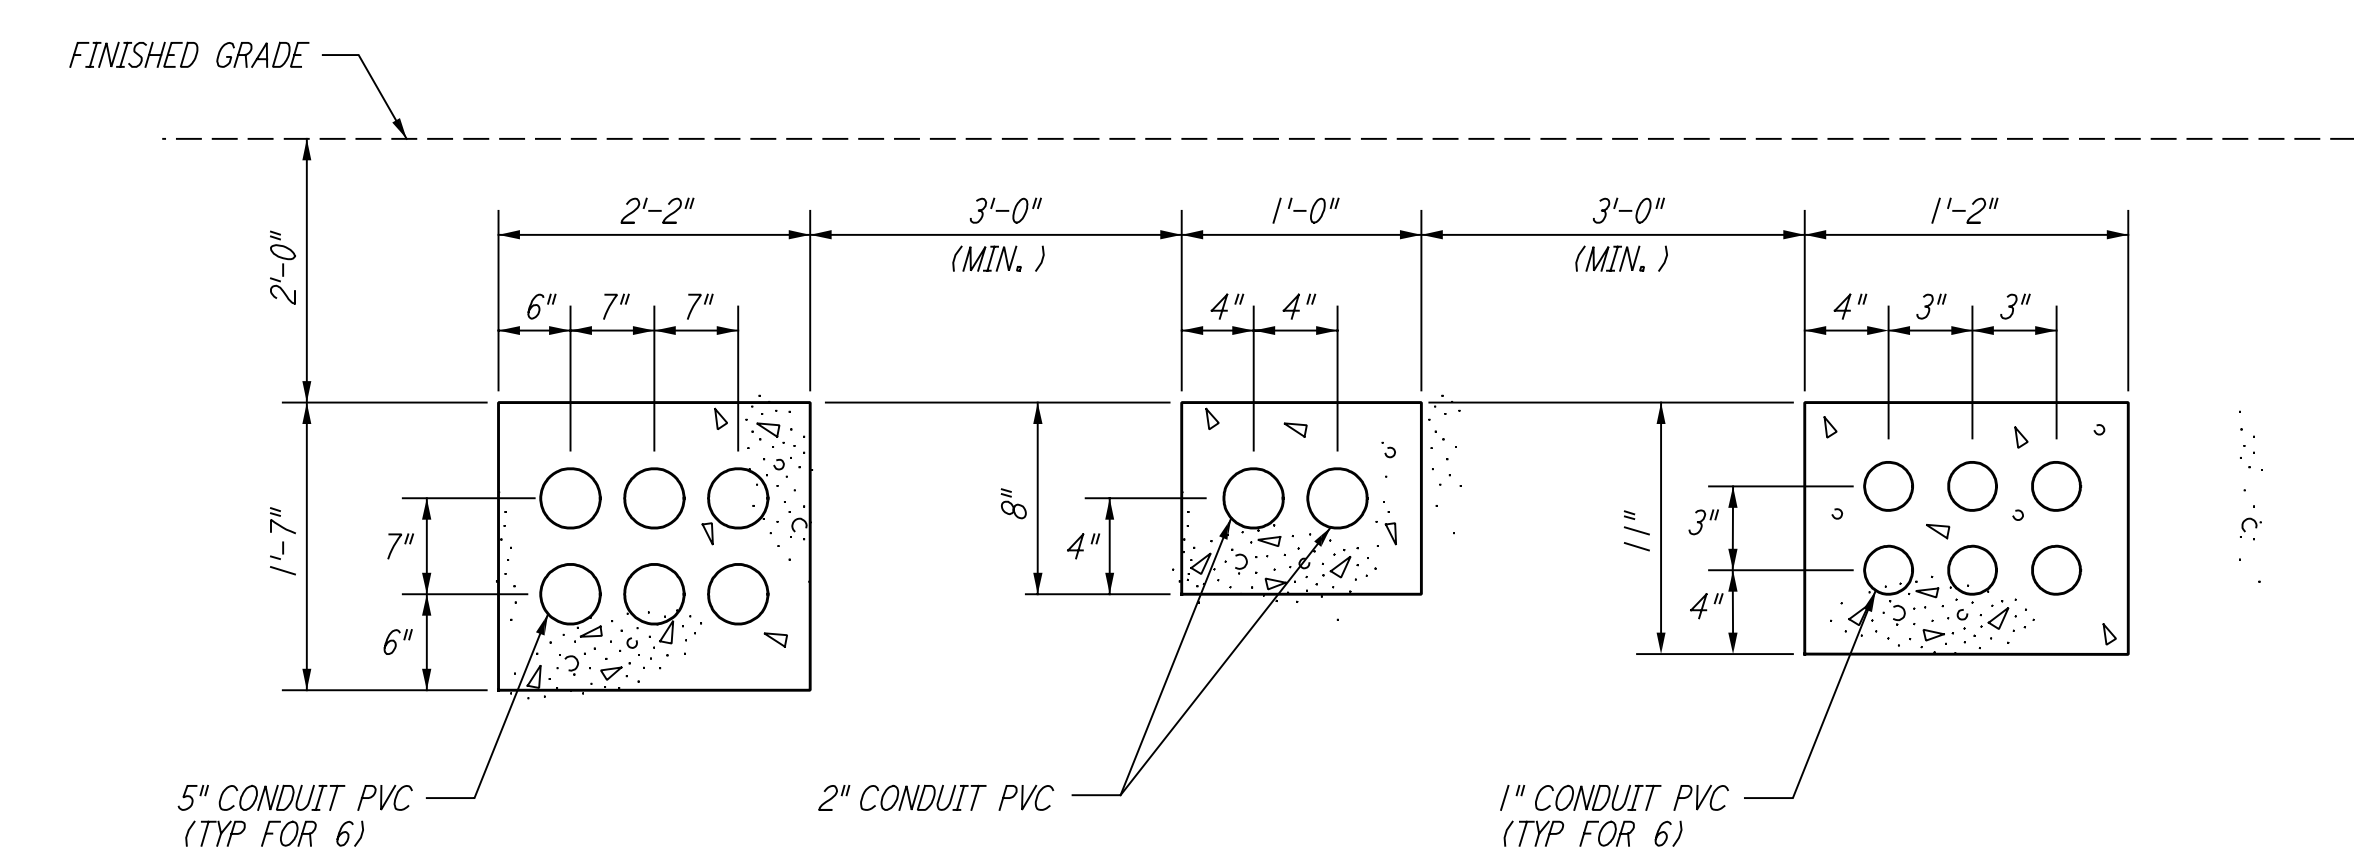


SECTION **C** REF  
 NTS WA-E-112

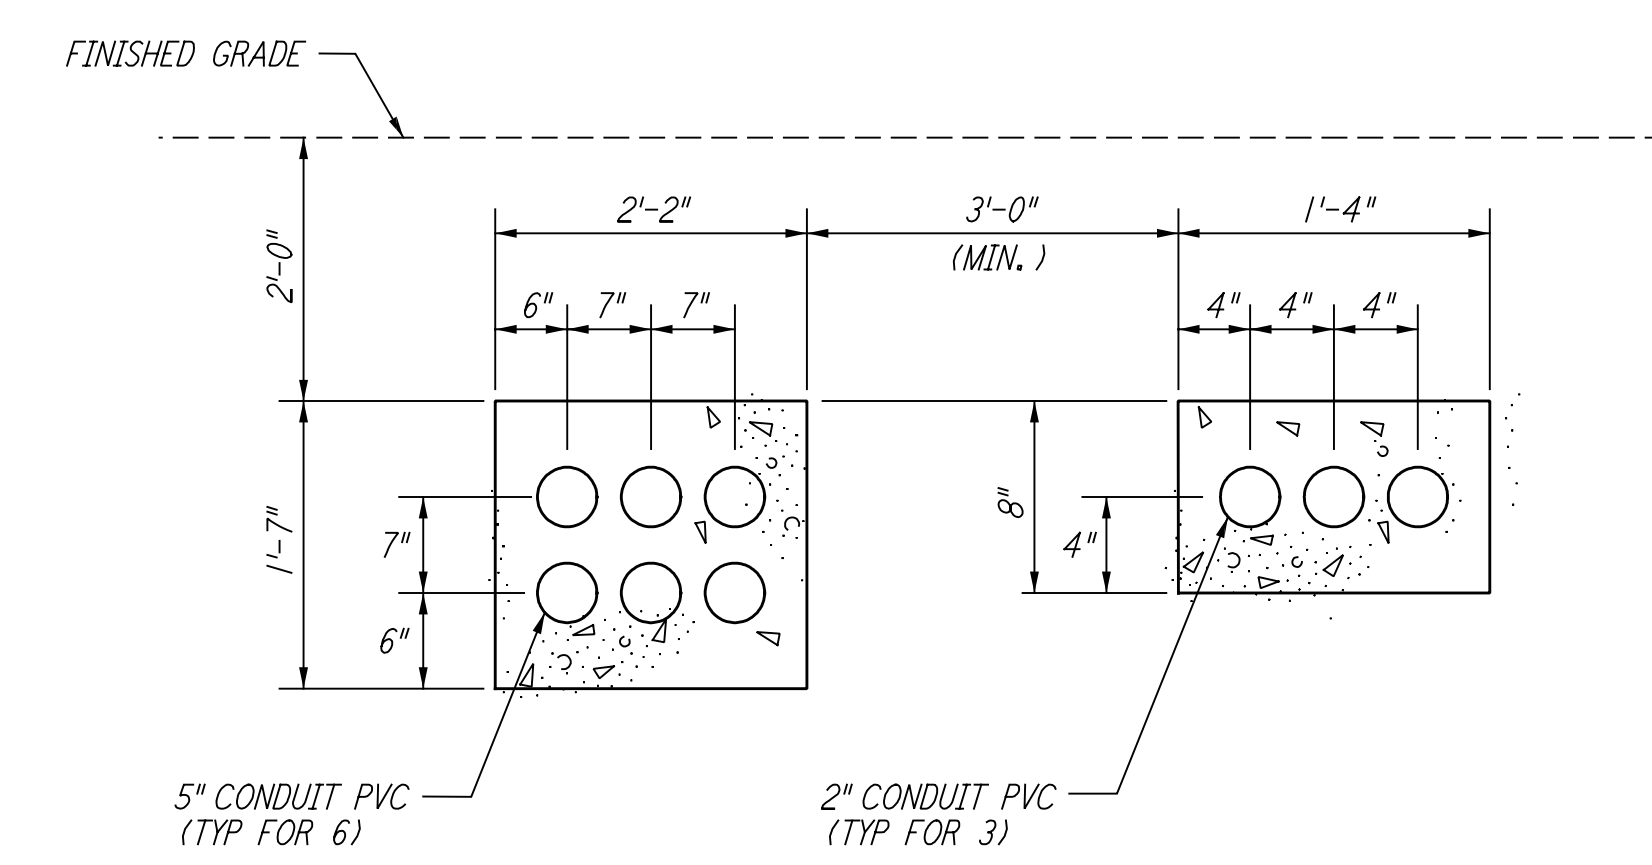


SECTION **D** REF  
 NTS WA-E-507  
 WA-E-112

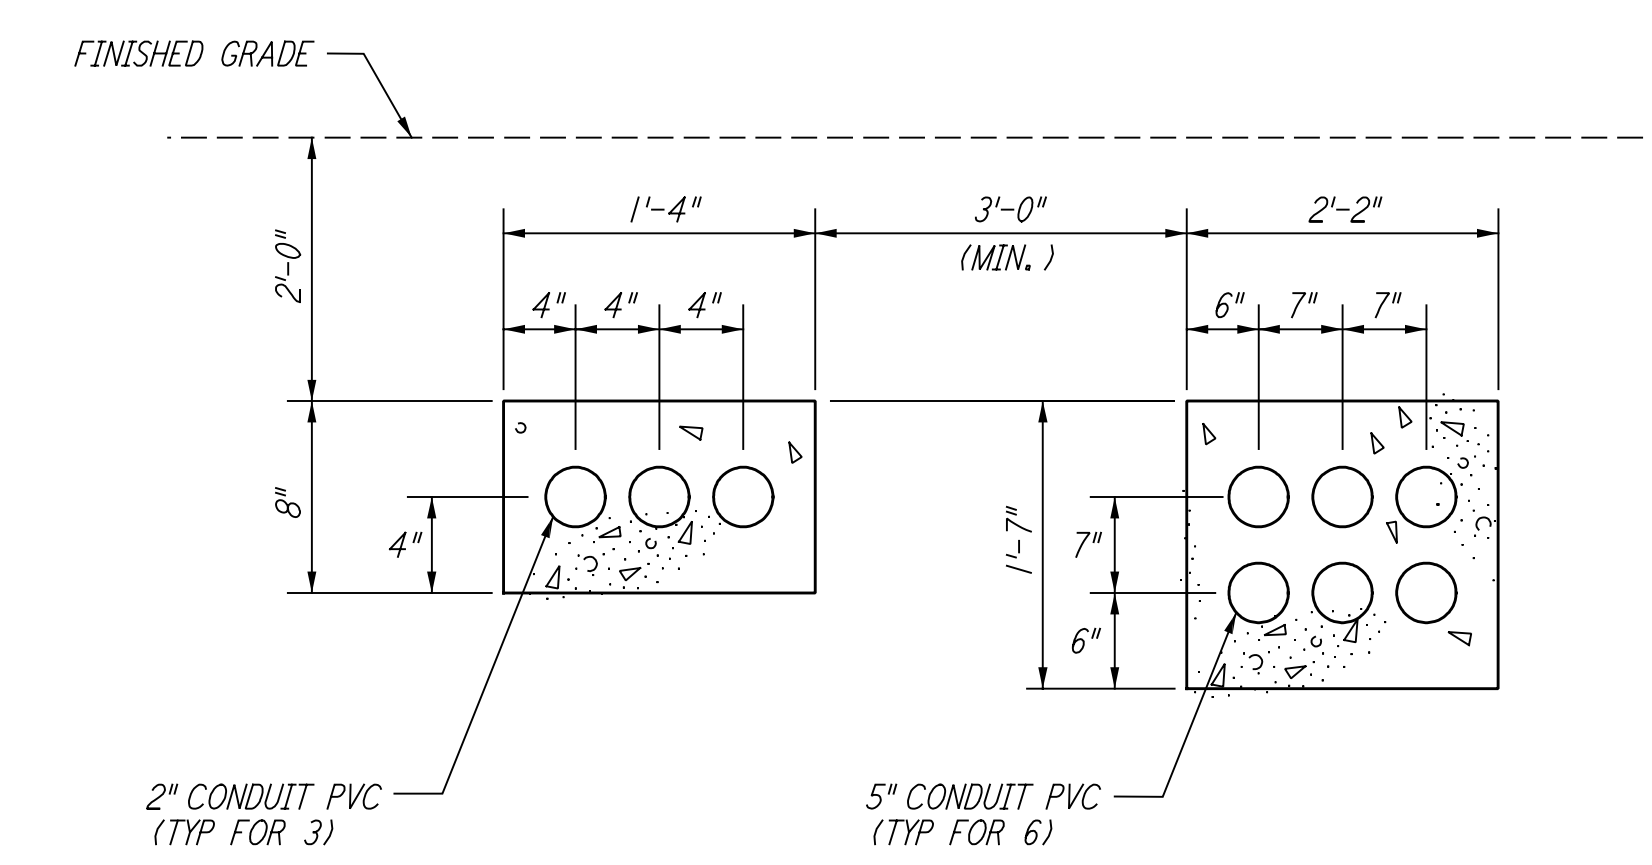

SECTION **E** REF  
 NTS WA-E-507

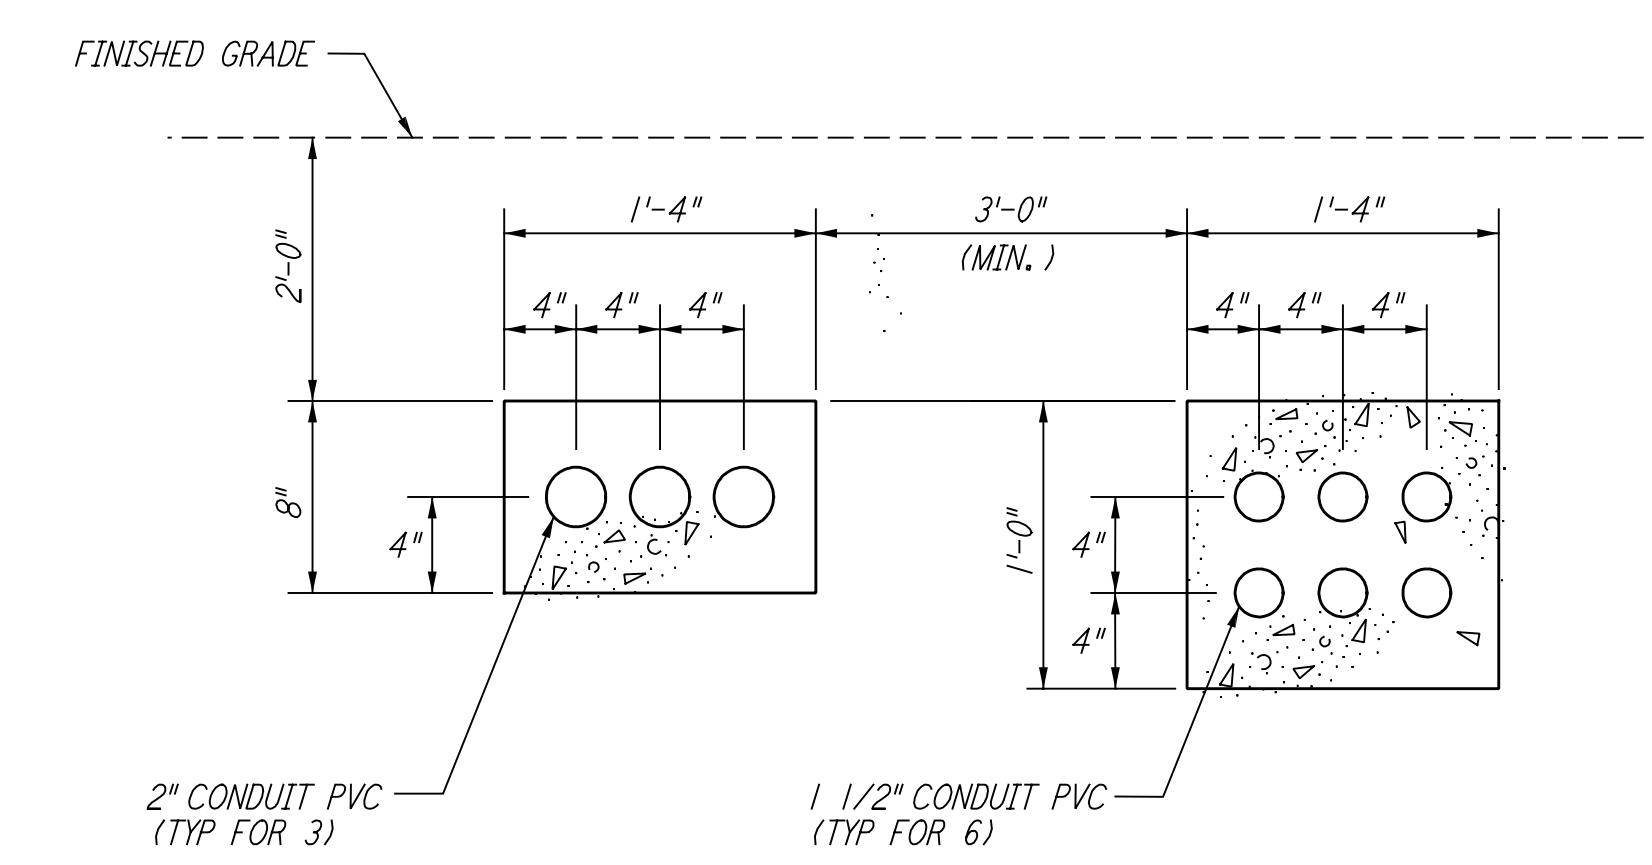

SECTION **F** REF  
 NTS WA-E-507

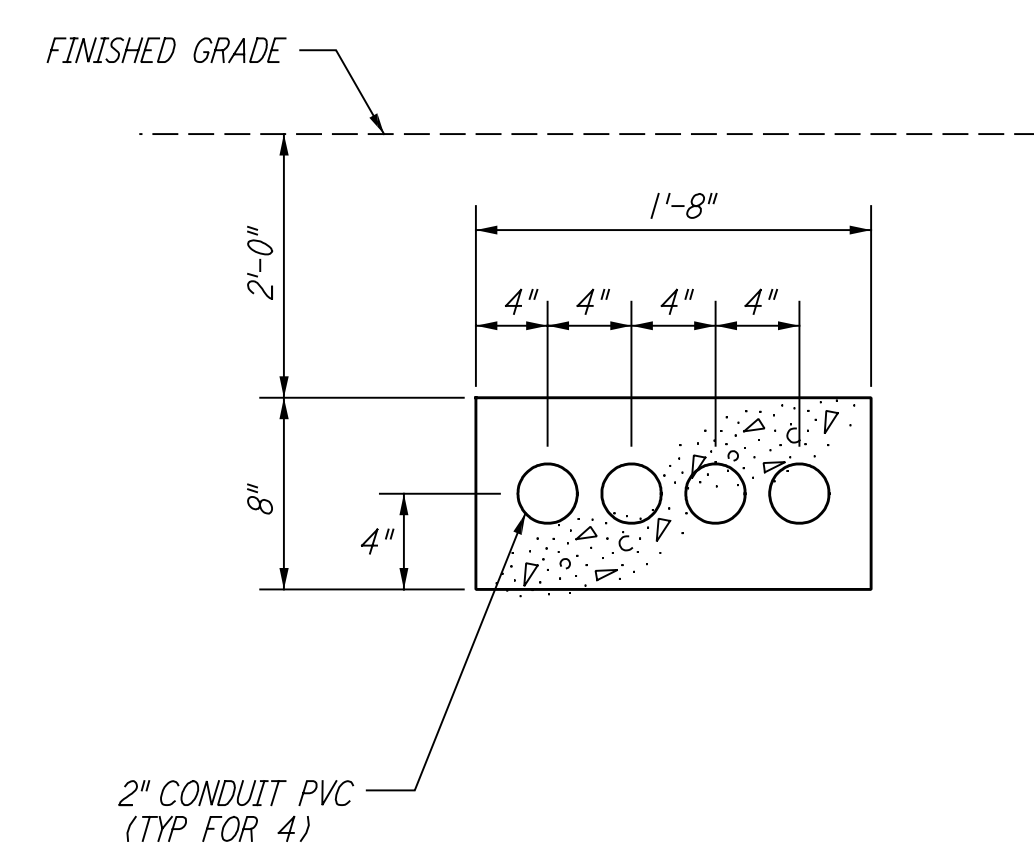


SECTION **G** REF  
 NTS WA-E-507

This document and the design it covers are the property of PARSONS. They are loaned only with the borrower's expressed written agreement that they will not be reproduced, copied, loaned, exhibited, or used in any other way, except by written consent from PARSONS to the borrower.

NO.	DATE	BY	CHKD	ENGR	PROJ	DESCRIPTION
1	6-15-98	J. G.				ISSUED FOR AS-BUILT

ISSUED FOR CONSTRUCTION		
DRAWN	M. M.	6-25-96
CHECKED	J. K.	7-3-96
ENGINEER	K. R.	7-3-96
PROJ	M. D. W.	7-8-96
<b>AS-BUILT DRAWINGS</b>		

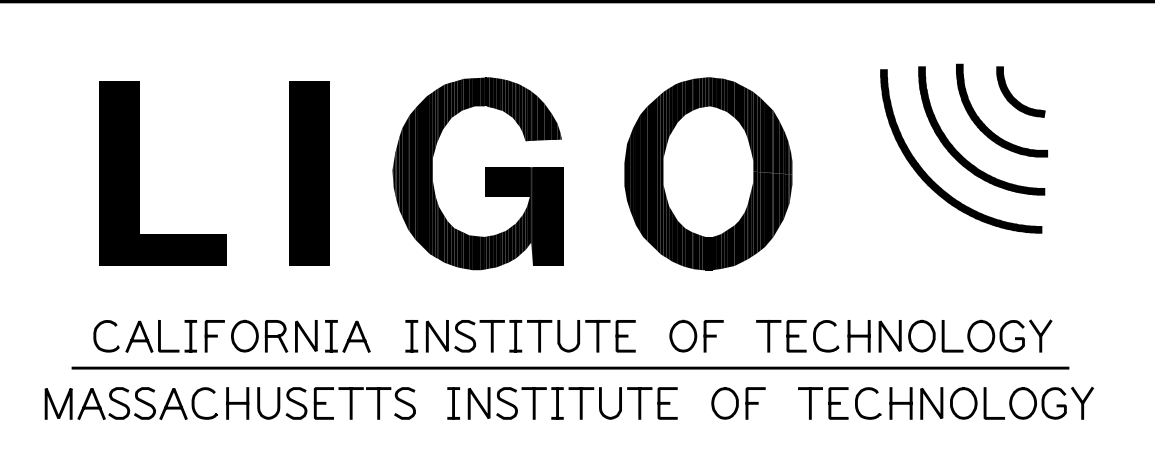

LASER INTERFEROMETER GRAVITATIONAL-WAVE OBSERVATORY SITE NO. 1 - HANFORD, WASHINGTON			
TITLE	SCALE	DRAWING NUMBER	PROJECT NUMBER
ELECTRICAL CORNER STATION UNDERGROUND SECTIONS	NONE	PP150969	8094
<b>WA-E-400</b>		REVISIONS	

LIGO-D960421-01-O