


WASTE AND VENT RISER DIAGRAM

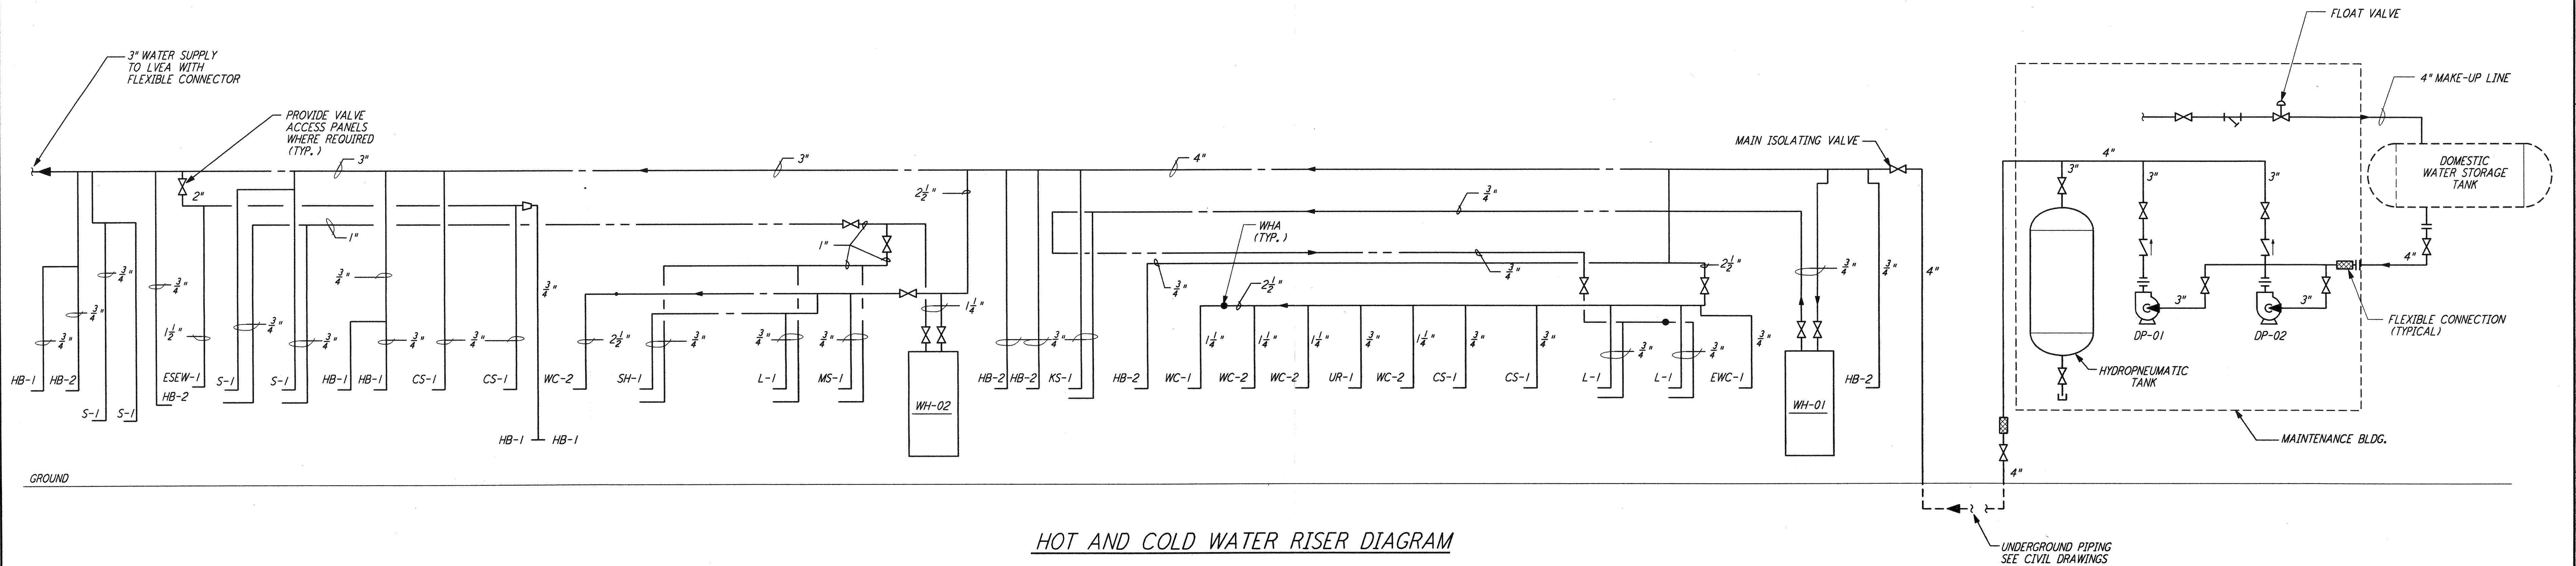

HOT AND COLD WATER RISER DIAGRAM

This document and the design it covers are the property of PARSONS. They are loaned only with the borrower's expressed written agreement that they will not be reproduced, copied, loaned, exhibited, or used in any other way, except by written consent from PARSONS to the borrower.

This document and the design it covers are the property of PARSONS. They are loaned only with the borrower's expressed written agreement that they will not be reproduced, copied, loaned, exhibited, or used in any other way, except by written consent from PARSONS to the borrower.

NO.	DATE	BY	CHKD	ENGR	PROJ	DESCRIPTION
2	5-15-98	CP	AA	AA	PZ	ISSUED FOR AS-BUILT
1	3-20-97	WNK	AA	AA	TDM	REVISED RISER DIAGRAMS

ISSUED FOR CONSTRUCTION
 DRAWN DG 6-24-96
 CHECKED WR 7/19/96
 ENGINEER MN 7/19/96
 PROJ MDW 7/19/96

AS-BUILT DRAWINGS

PARSONS
 100 WEST WALNUT STREET
 PASADENA, CALIFORNIA

LIGO
 CALIFORNIA INSTITUTE OF TECHNOLOGY
 MASSACHUSETTS INSTITUTE OF TECHNOLOGY

LIGO-D960443-02-O
 LASER INTERFEROMETER
 GRAVITATIONAL-WAVE OBSERVATORY
 SITE NO. 1 - HANFORD, WASHINGTON

PLUMBING
 CORNER STATION
 RISER DIAGRAM

SCALE: NONE
 CONTRACT NUMBER: PPI50969
 PROJECT NUMBER: 8094

REVISIONS: **WA-P-131**

E
 D
 C
 B
 A
 LIGOWAF.BDR