



- NOTES:**
1. FOR LEGEND, ABBREVIATIONS AND GENERAL NOTES SEE SHEET WA-H-001 AND WA-H-002.
 2. SEE SHEET WA-H-151 FOR APPLICABLE NOTES.
 3. PERFORATED DUCT LINER INSIDE THE SUPPLY AIR PLENUM OF AH-01 AND AH-02 WILL BE CORRUGATED TYPE.

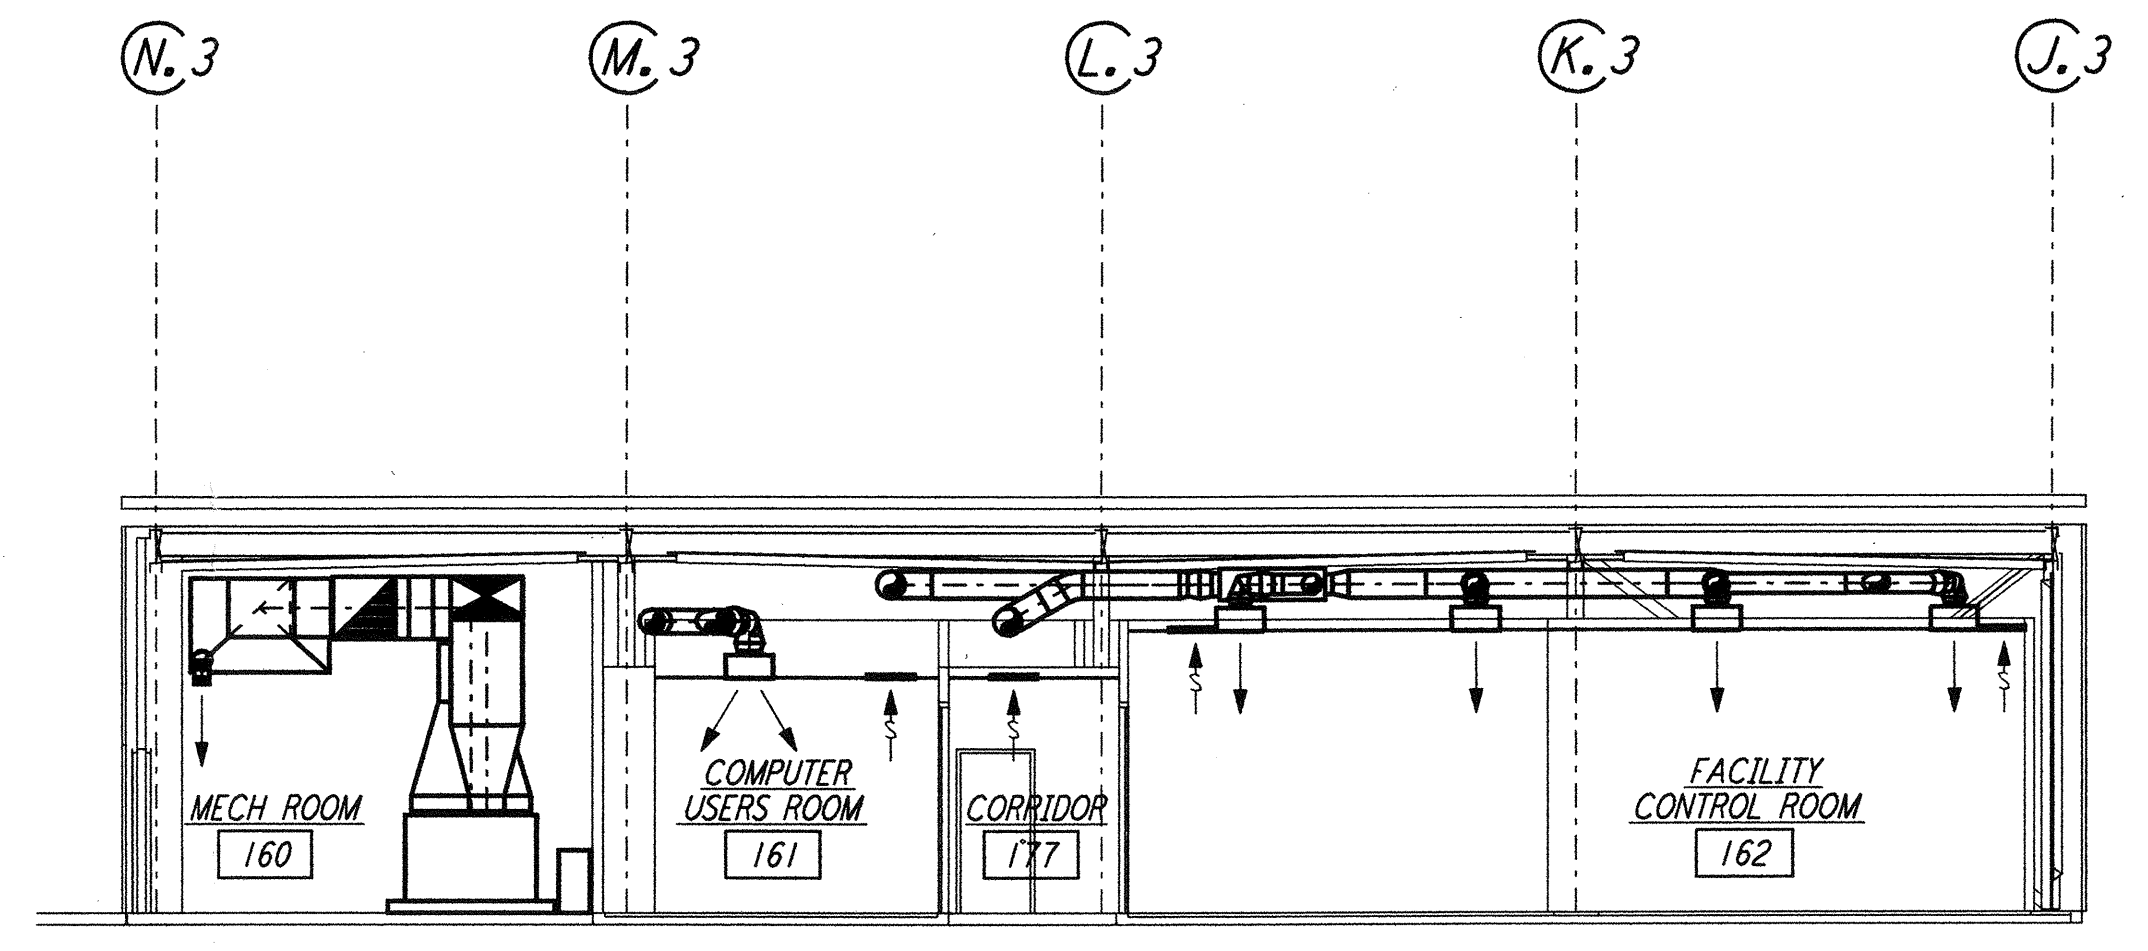

SECTION **C** REF
 $\frac{1}{8}'' = 1'-0''$ WA-H-152 WA-H-113

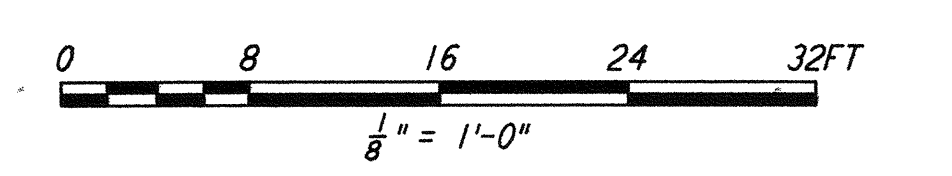

LIGO-D960484-01-O

LASER INTERFEROMETER GRAVITATIONAL-WAVE OBSERVATORY SITE NO. 1 - HANFORD, WASHINGTON		
SCALE AS NOTED		CONTRACT NUMBER PPI50969
SHEET NUMBER WA-H-152		PROJECT NUMBER 8094
HVAC CORNER STATION SECTIONS SHEET 2		

LIGO
 CALIFORNIA INSTITUTE OF TECHNOLOGY
 MASSACHUSETTS INSTITUTE OF TECHNOLOGY

PARSONS
 100 WEST WALNUT STREET
 PASADENA, CALIFORNIA

ISSUED FOR CONSTRUCTION		
DRAWN	CLP	6-24-98
CHECKED	ME	7/3/98
ENGINEER	AA	7/3/98
PROJ	MDW	7/8/98

**AS-BUILT
DRAWINGS**

NO.	DATE	BY	CHKD	ENGR	PROJ	DESCRIPTION
1	5-15-98	CP	AA	AA	MDW	ISSUED FOR AS-BUILT

This document and the design it covers are the property of PARSONS. They are loaned only with the borrower's expressed written agreement that they will not be reproduced, copied, loaned, exhibited, or used in any other way, except by written consent from PARSONS to the borrower.

This document and the design it covers are the property of PARSONS. They are loaned only with the borrower's expressed written agreement that they will not be reproduced, copied, loaned, exhibited, or used in any other way, except by written consent from PARSONS to the borrower.

E
D
C
B
A