




NOTES:
 1. SEE SHEET BT-C-002 FOR GENERAL NOTES, LEGEND AND ABBREVIATIONS.

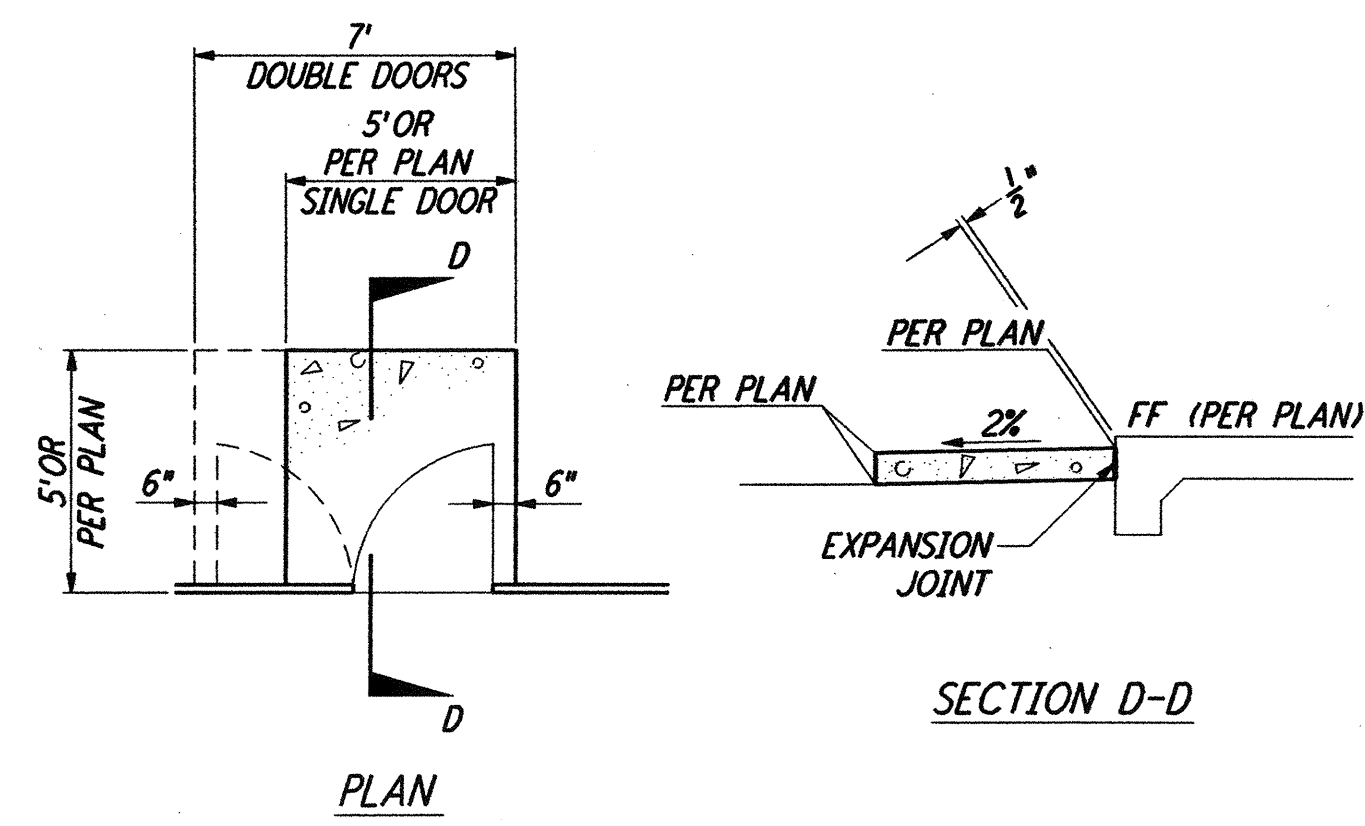


CONCRETE STOOP (1)
 NOT TO SCALE
 REF: BT-C-051, BT-C-041, BT-C-045

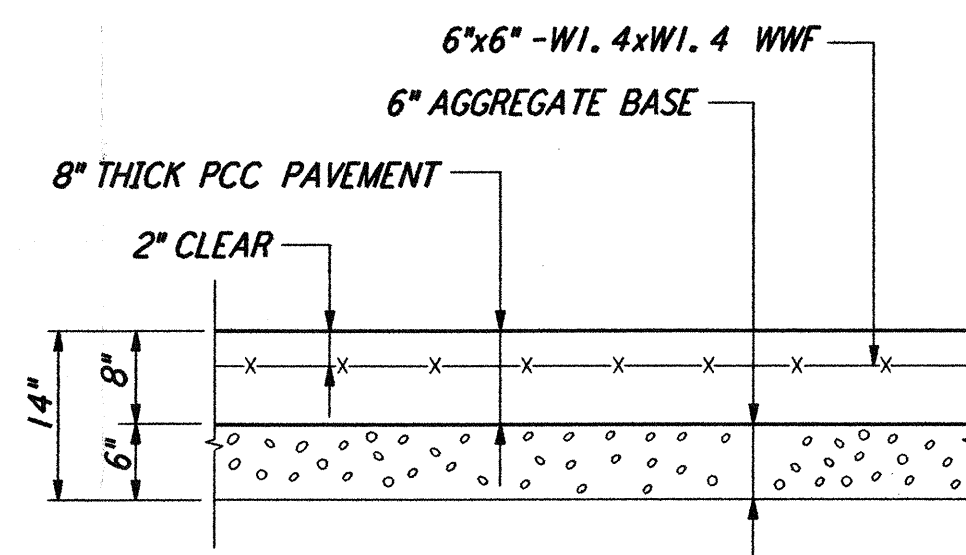


CONCRETE PAVEMENT (2)
 NOT TO SCALE
 REF: BT-C-051, BT-C-045

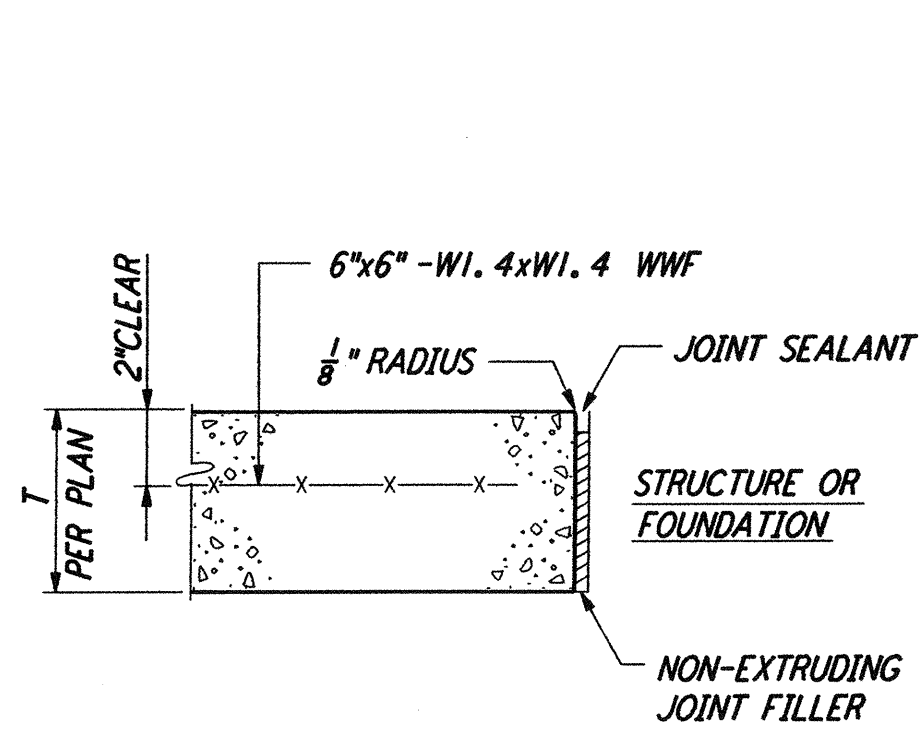


EXPANSION JOINT (EJ) (3)
 NOT TO SCALE
 REF: BT-C-051, BT-C-041, BT-C-045

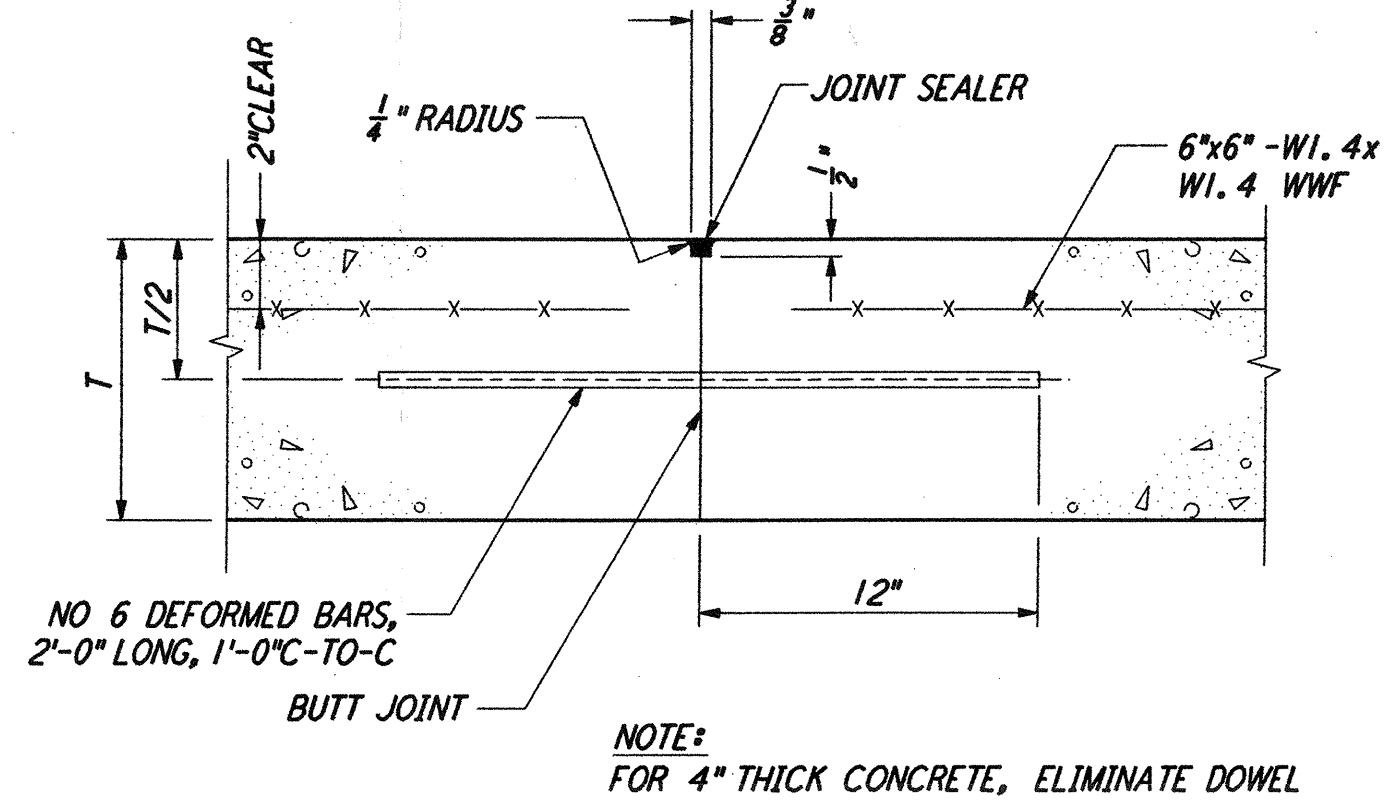


CONSTRUCTION JOINT (CJ) (4)
 NOT TO SCALE
 REF: BT-C-051, BT-C-045
 (SEPARATE POURS OR END OF DAY)

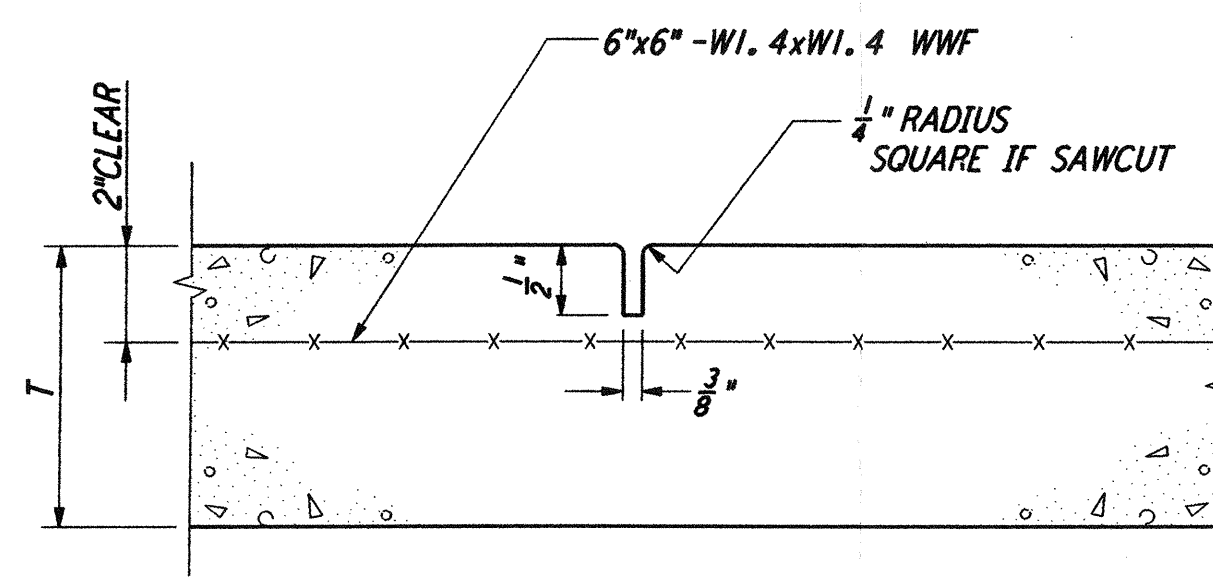


CONTRACTION JOINT (CO) (5)
 NOT TO SCALE
 REF: BT-C-051, BT-C-045
 (SPACING: 20' MAX)

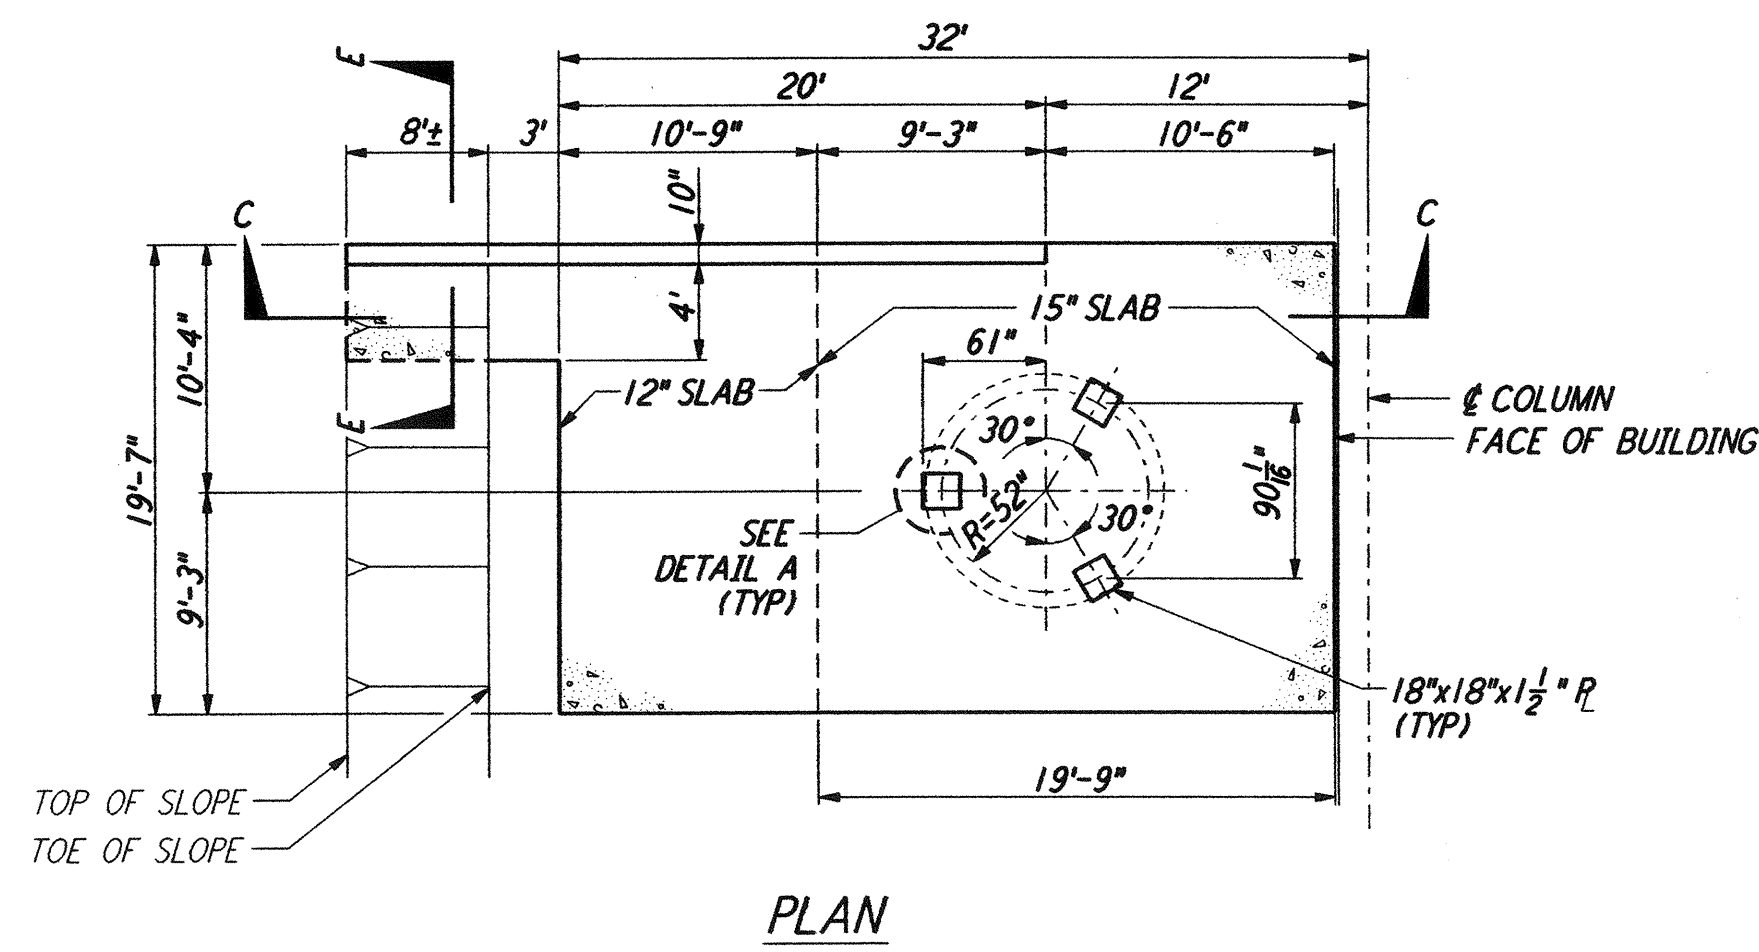

PLAN

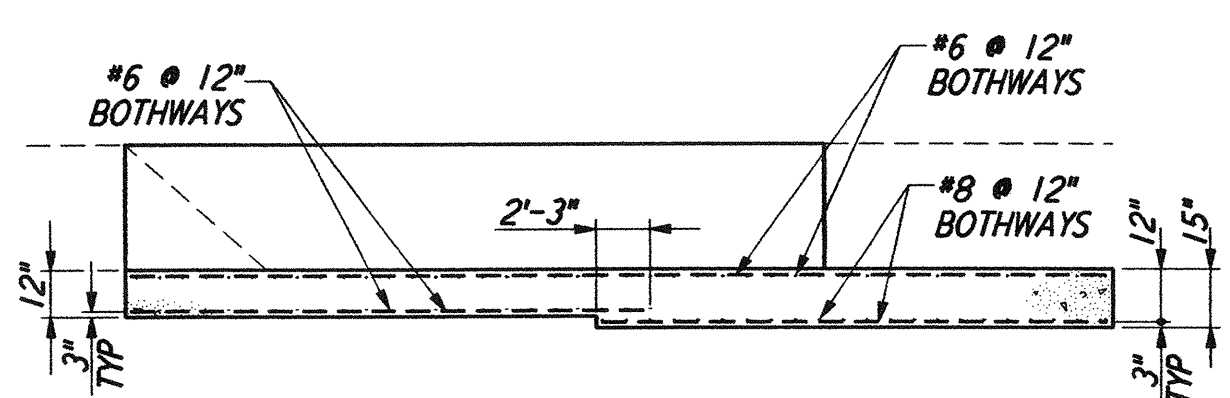


SECTION C-C

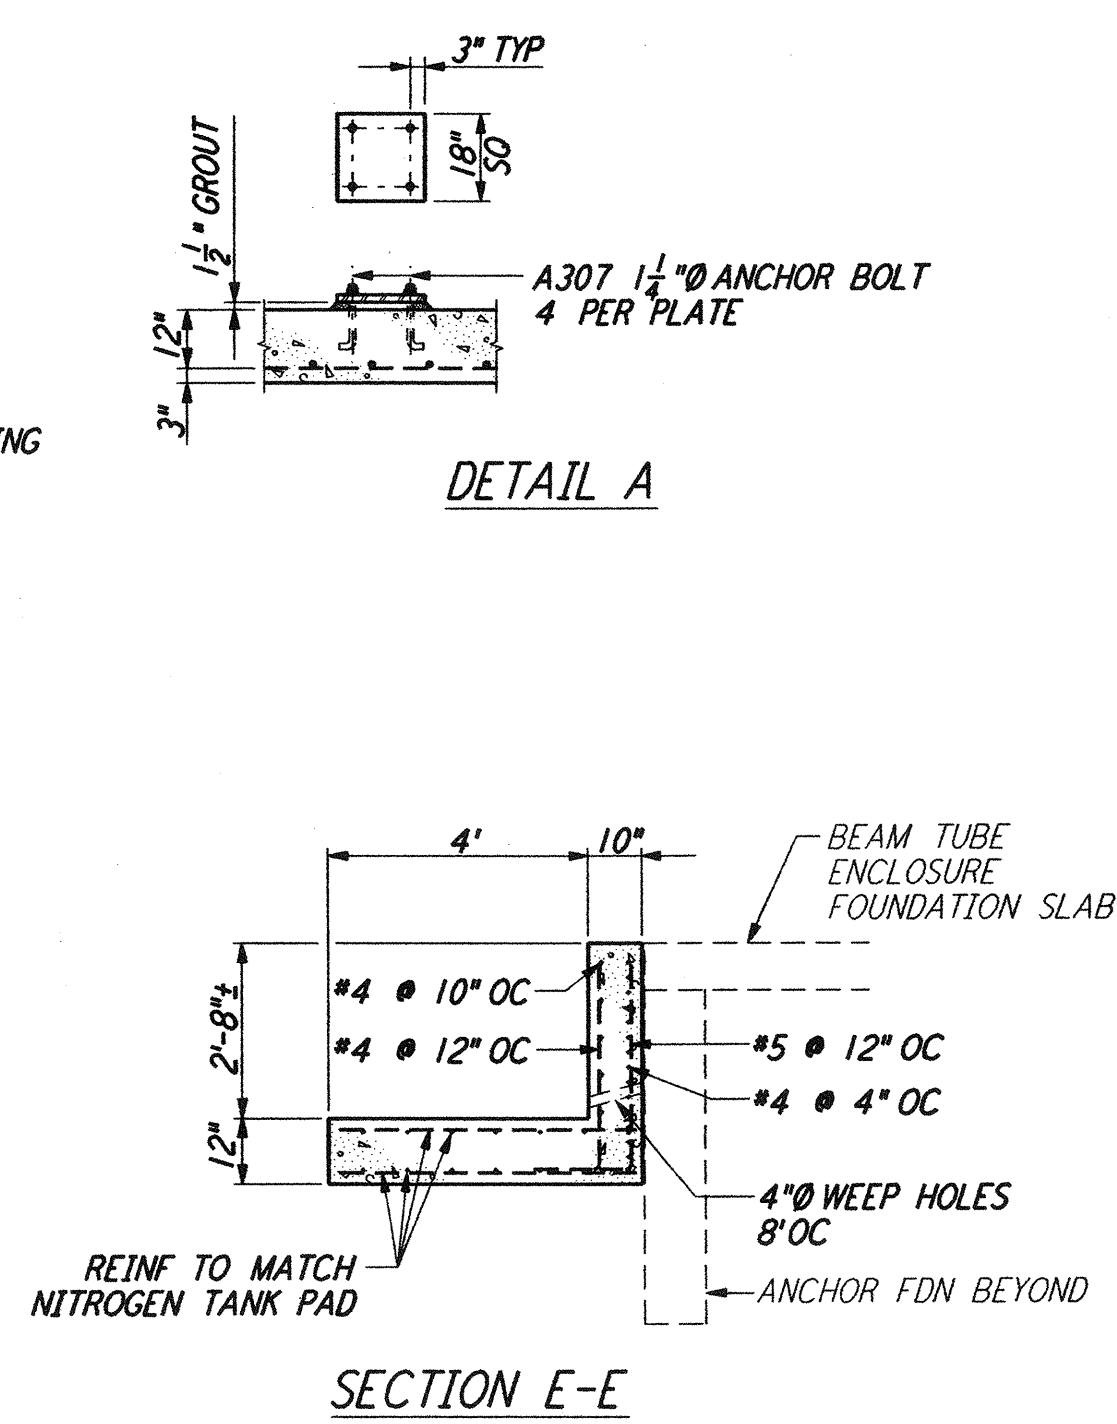

SECTION E-E

CONCRETE FOUNDATION FOR LIQUID NITROGEN TANK (6)
 NOT TO SCALE
 REF: BT-C-051, BT-C-021, BT-C-025, BT-C-041, BT-C-045

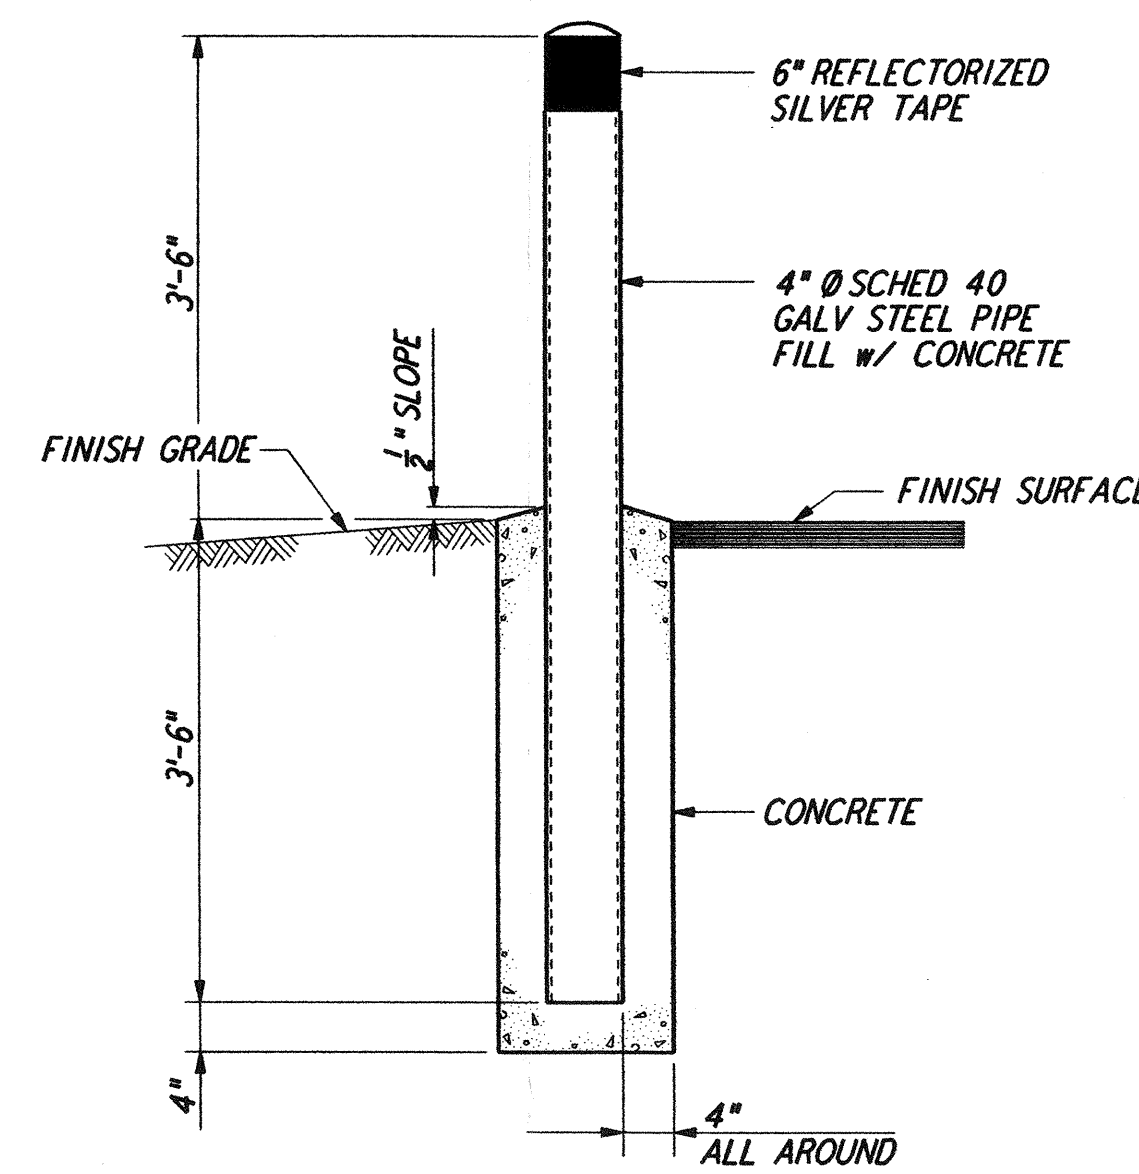

GUARD POST (7)
 NOT TO SCALE
 REF: BT-C-051, BT-C-004

This document and the design it covers are the property of PARSONS. They are loaned only with the borrower's expressed written agreement that they will not be reproduced, copied, loaned, exhibited, or used in any other way, except by written consent from PARSONS to the borrower.

This document and the design it covers are the property of PARSONS. They are loaned only with the borrower's expressed written agreement that they will not be reproduced, copied, loaned, exhibited, or used in any other way, except by written consent from PARSONS to the borrower.

LIGO-D960733-00-0

NO.	DATE	BY	CHKD	ENGR	PROJ	DESCRIPTION
0	1-22-99	MEI	--	--	MDW	ISSUED FOR AS BUILT
A	4-19-96	WRB	TDM	MDW	MDW	CHANGE ORDER NO. 4

AS-BUILT DRAWINGS

PARSONS
 100 WEST WALNUT STREET
 PASADENA, CALIFORNIA

LIGO
 CALIFORNIA INSTITUTE OF TECHNOLOGY
 MASSACHUSETTS INSTITUTE OF TECHNOLOGY

LASER INTERFEROMETER GRAVITATIONAL-WAVE OBSERVATORY BTE SITWORK & FABRICATION - HANFORD, WA		
TITLE	SCALE	CONTRACT NUMBER
CIVIL SITWORK DETAILS	AS NOTED	PP150969
		8094
SHEET NUMBER		REVISIONS
BT-C-051		