



**AIR HANDLING UNIT STRUCTURE**  
**FOUNDATION PLAN**  
 1/2" = 1'-0"

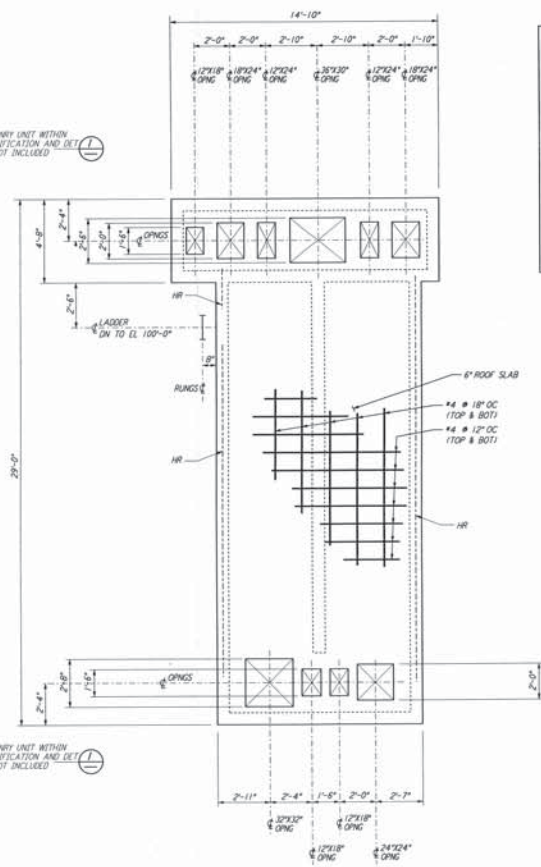

**AIR HANDLING UNIT STRUCTURE**  
**CONCRETE ROOF SLAB PLAN**  
 1/2" = 1'-0" NOT INCLUDED IN THIS CONTRACT

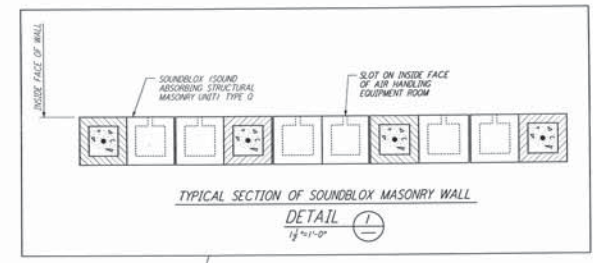

**NOT INCLUDED IN THIS CONTRACT**

LIGO-D960739-00-0



NO.	DATE	BY	CHKD	ENGR	PRJL	DESCRIPTION
1	1-22-99	MET				ISSUED FOR AS BUILT
2	4-19-98	MCS	KS	BP		CHANGE ORDER #4

**AS-BUILT DRAWINGS**

**PARSONS**  
 100 WEST WALNUT STREET  
 PASADENA, CALIFORNIA

**LIGO**  
 CALIFORNIA INSTITUTE OF TECHNOLOGY  
 MASSACHUSETTS INSTITUTE OF TECHNOLOGY

LASER INTERFEROMETER  
 GRAVITATIONAL-WAVE OBSERVATORY  
 BTE SITENWORK & FABRICATION - HANFORD, WA

TITLE: **STRUCTURAL MID & END STATIONS "B" AIR HANDLING UNIT ENCLOSURE PLANS**

AS NOTED PPI 50969 8094  
**BT-S-605**