

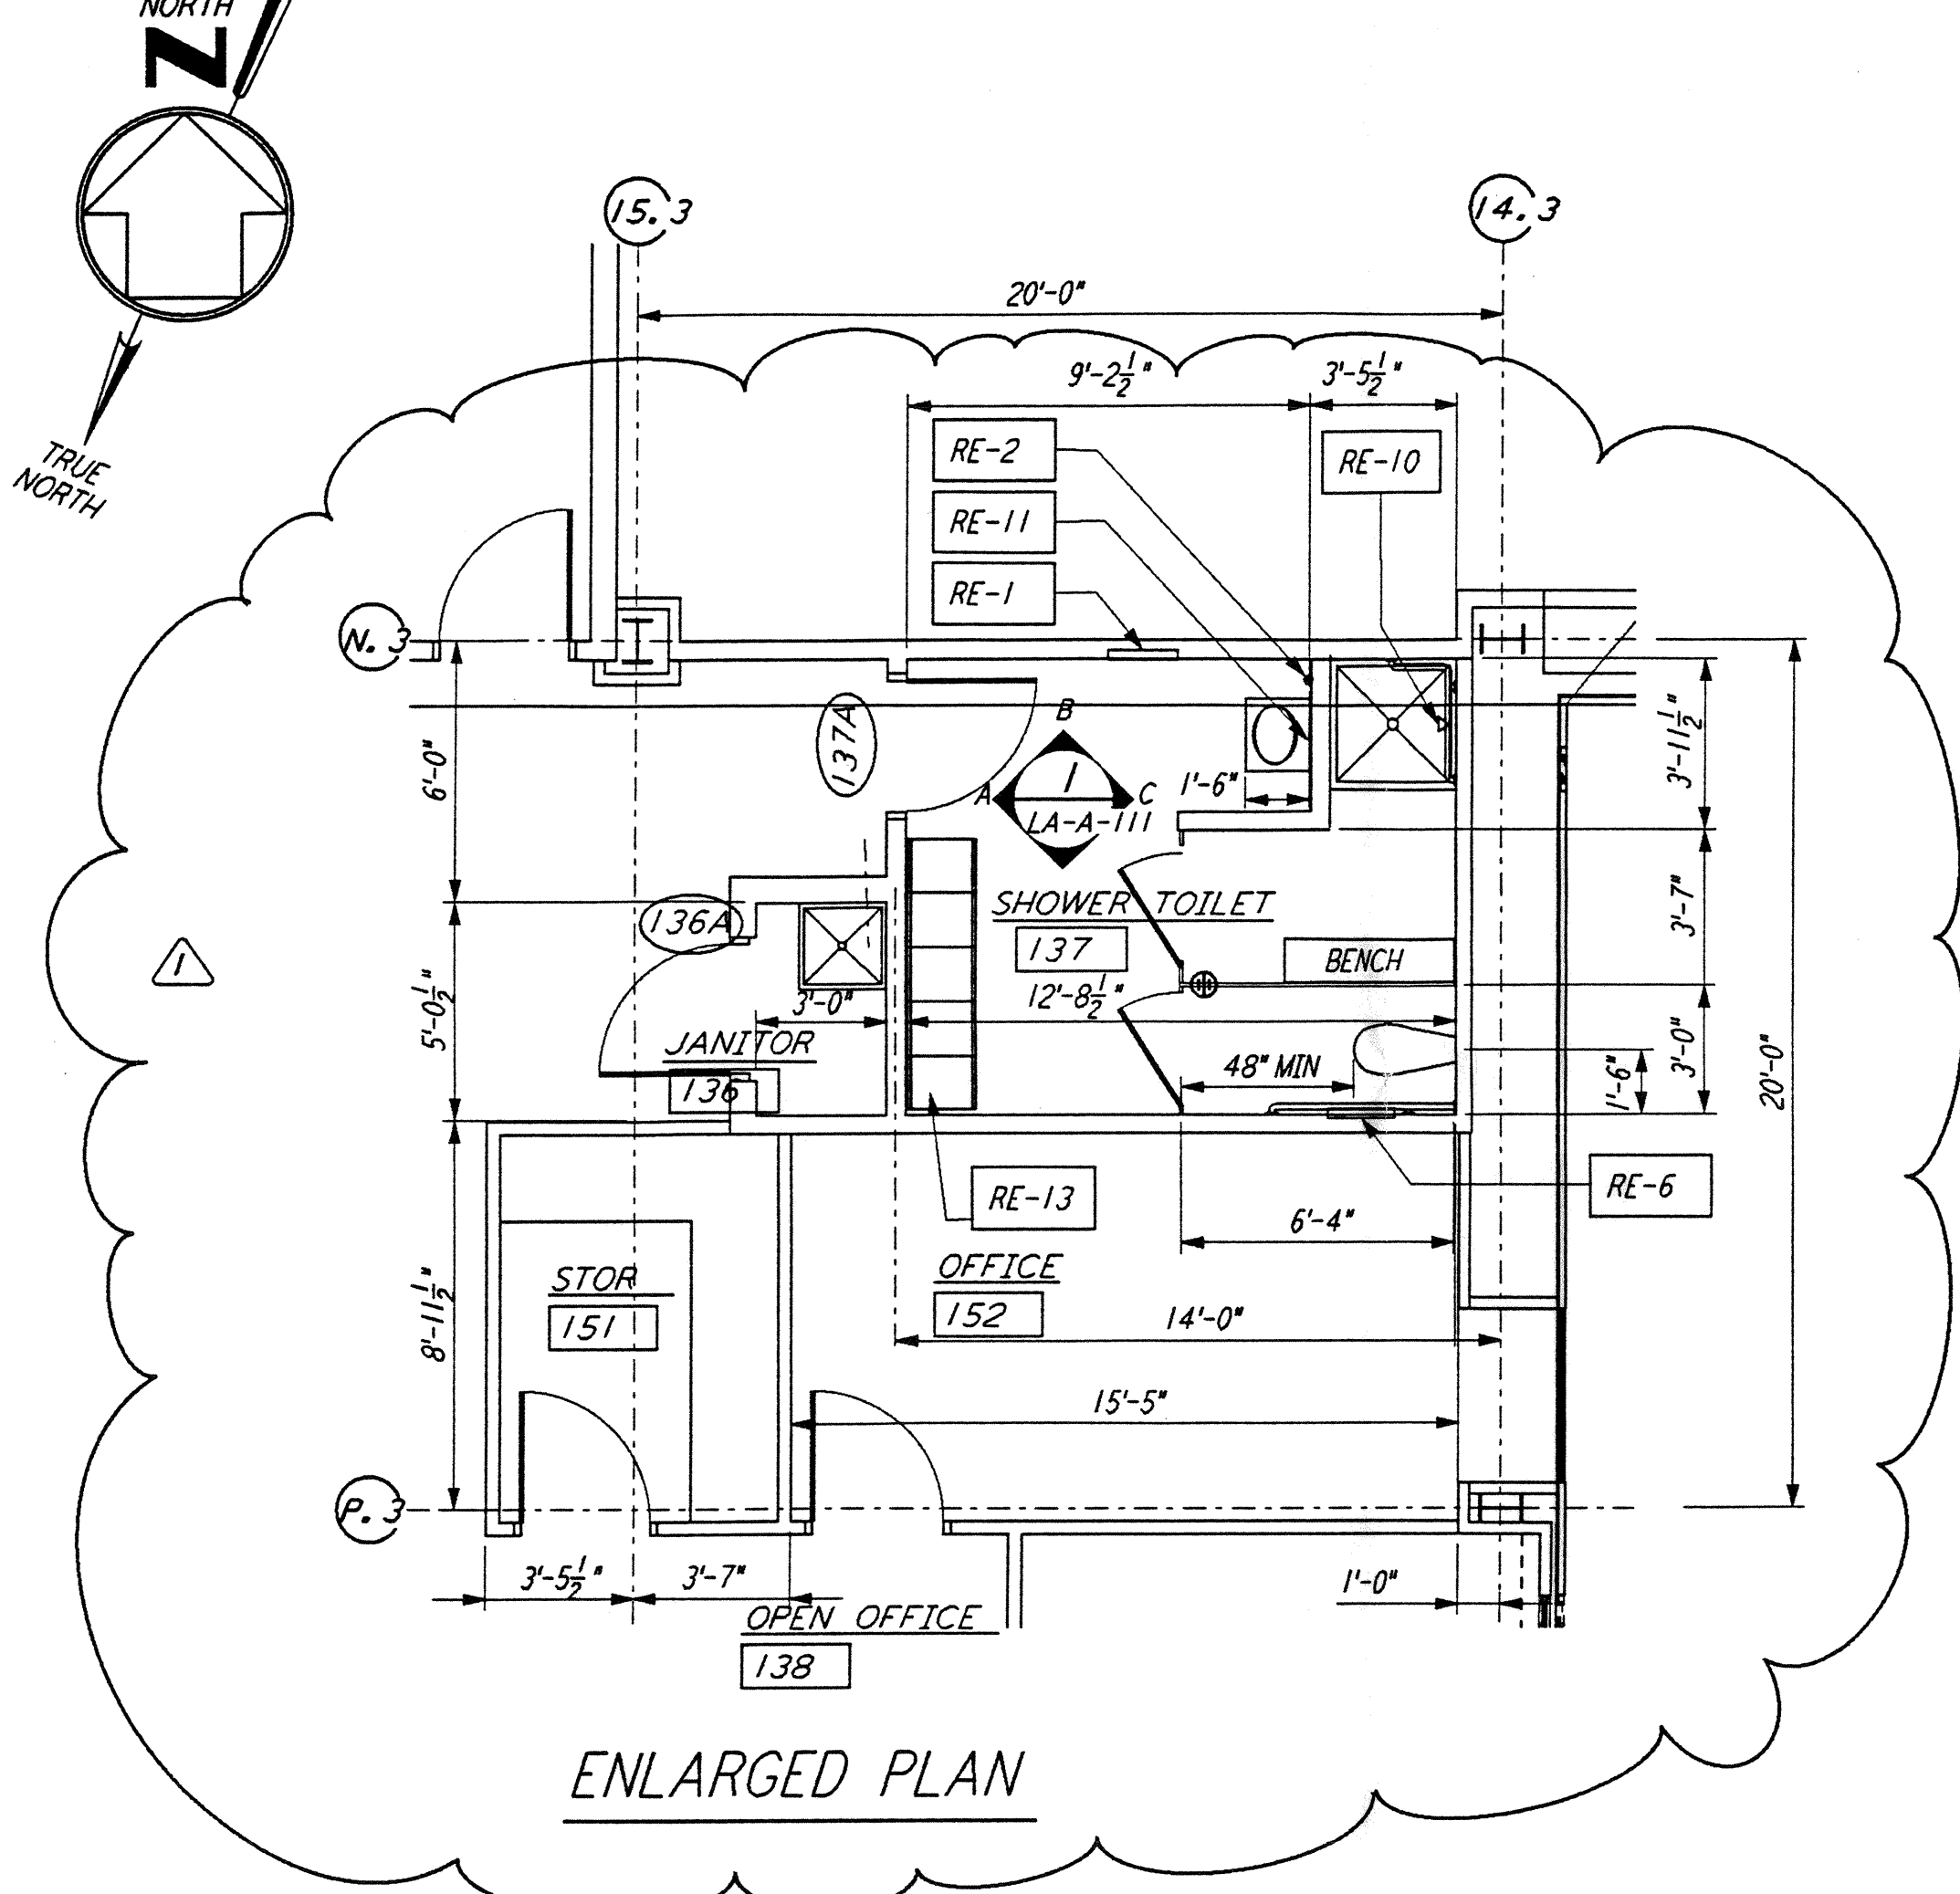



NOTE: SEE SPECIFICATIONS FOR
 ADDITIONAL INFORMATION
 AND SCHEDULES

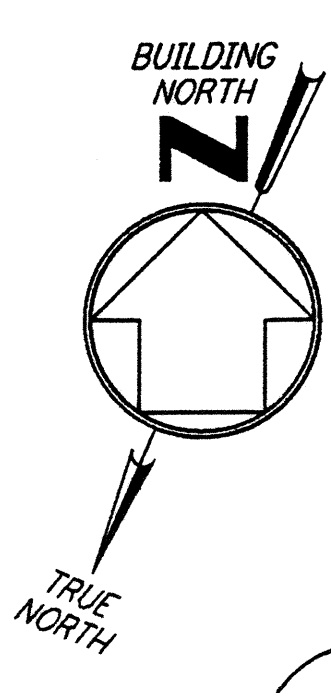


JANITOR 136 / SHOWER TOILET 137
 1/4" = 1'-0"

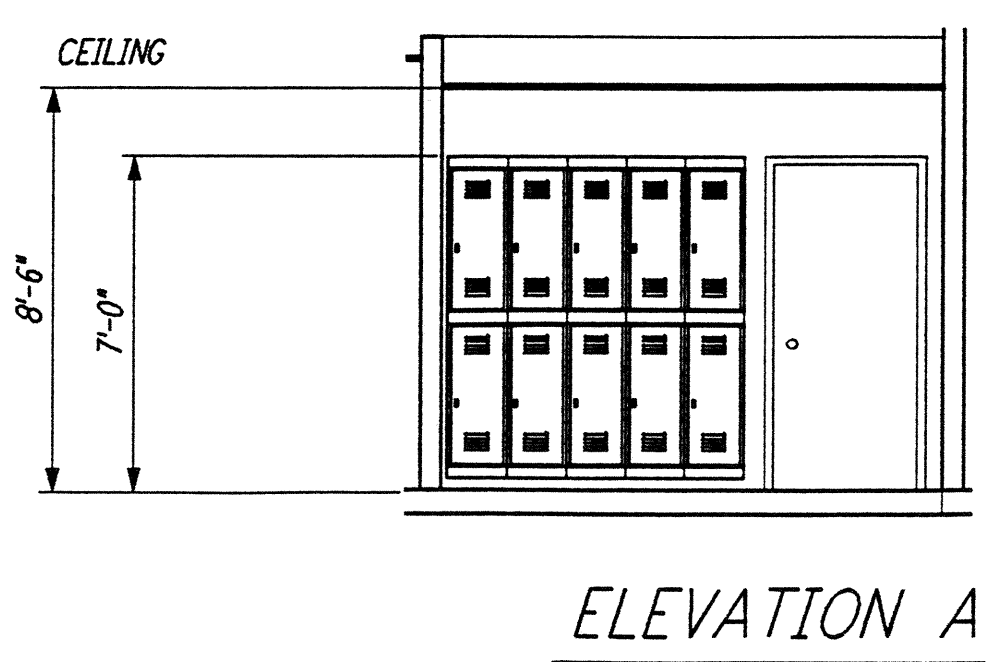

ELEVATION A

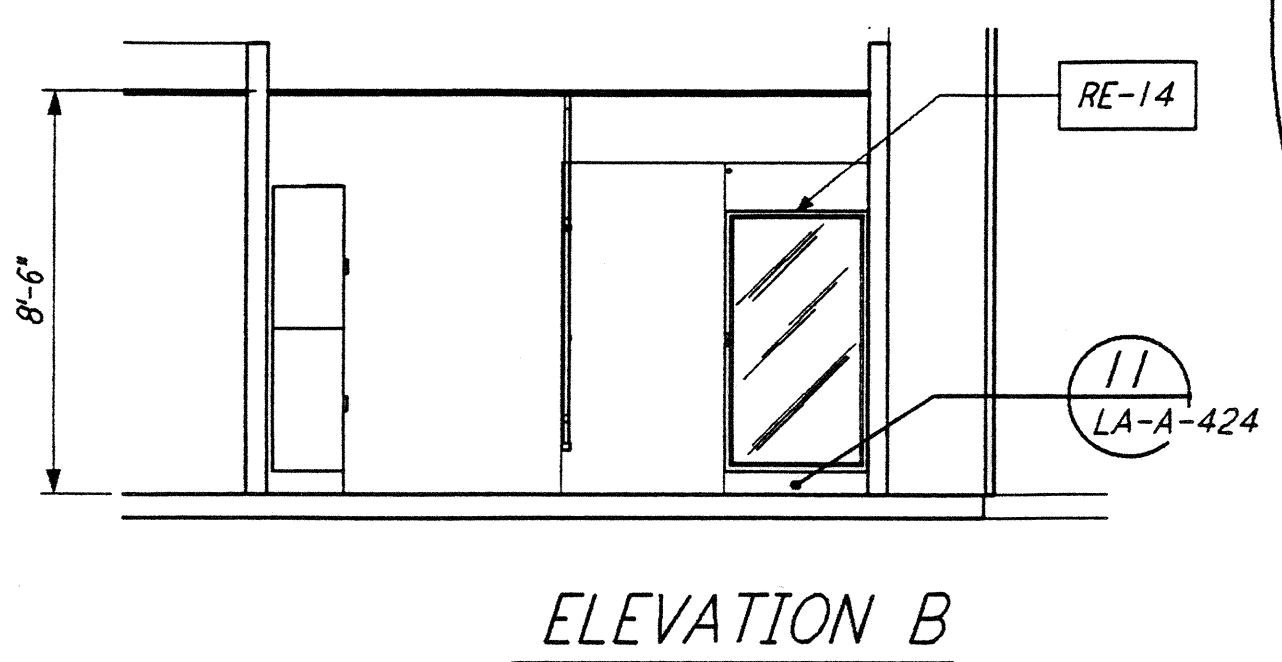


ELEVATION B

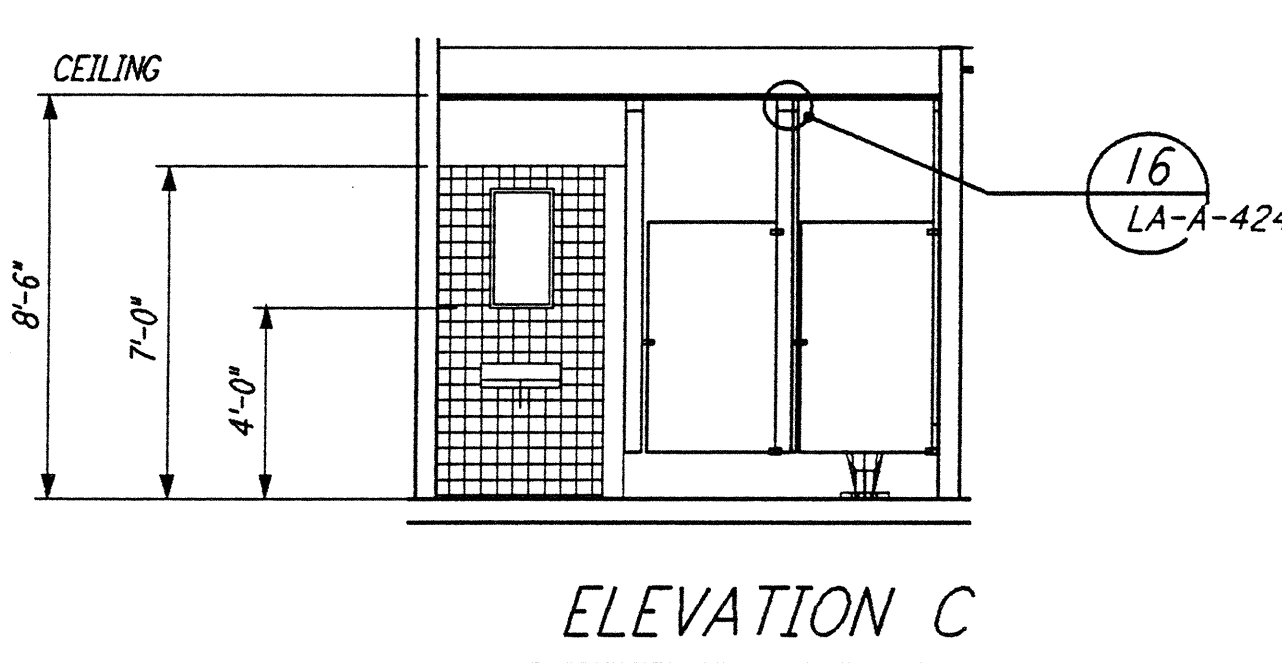


ELEVATION C


1 REF
 LA-A-111 LA-A-108

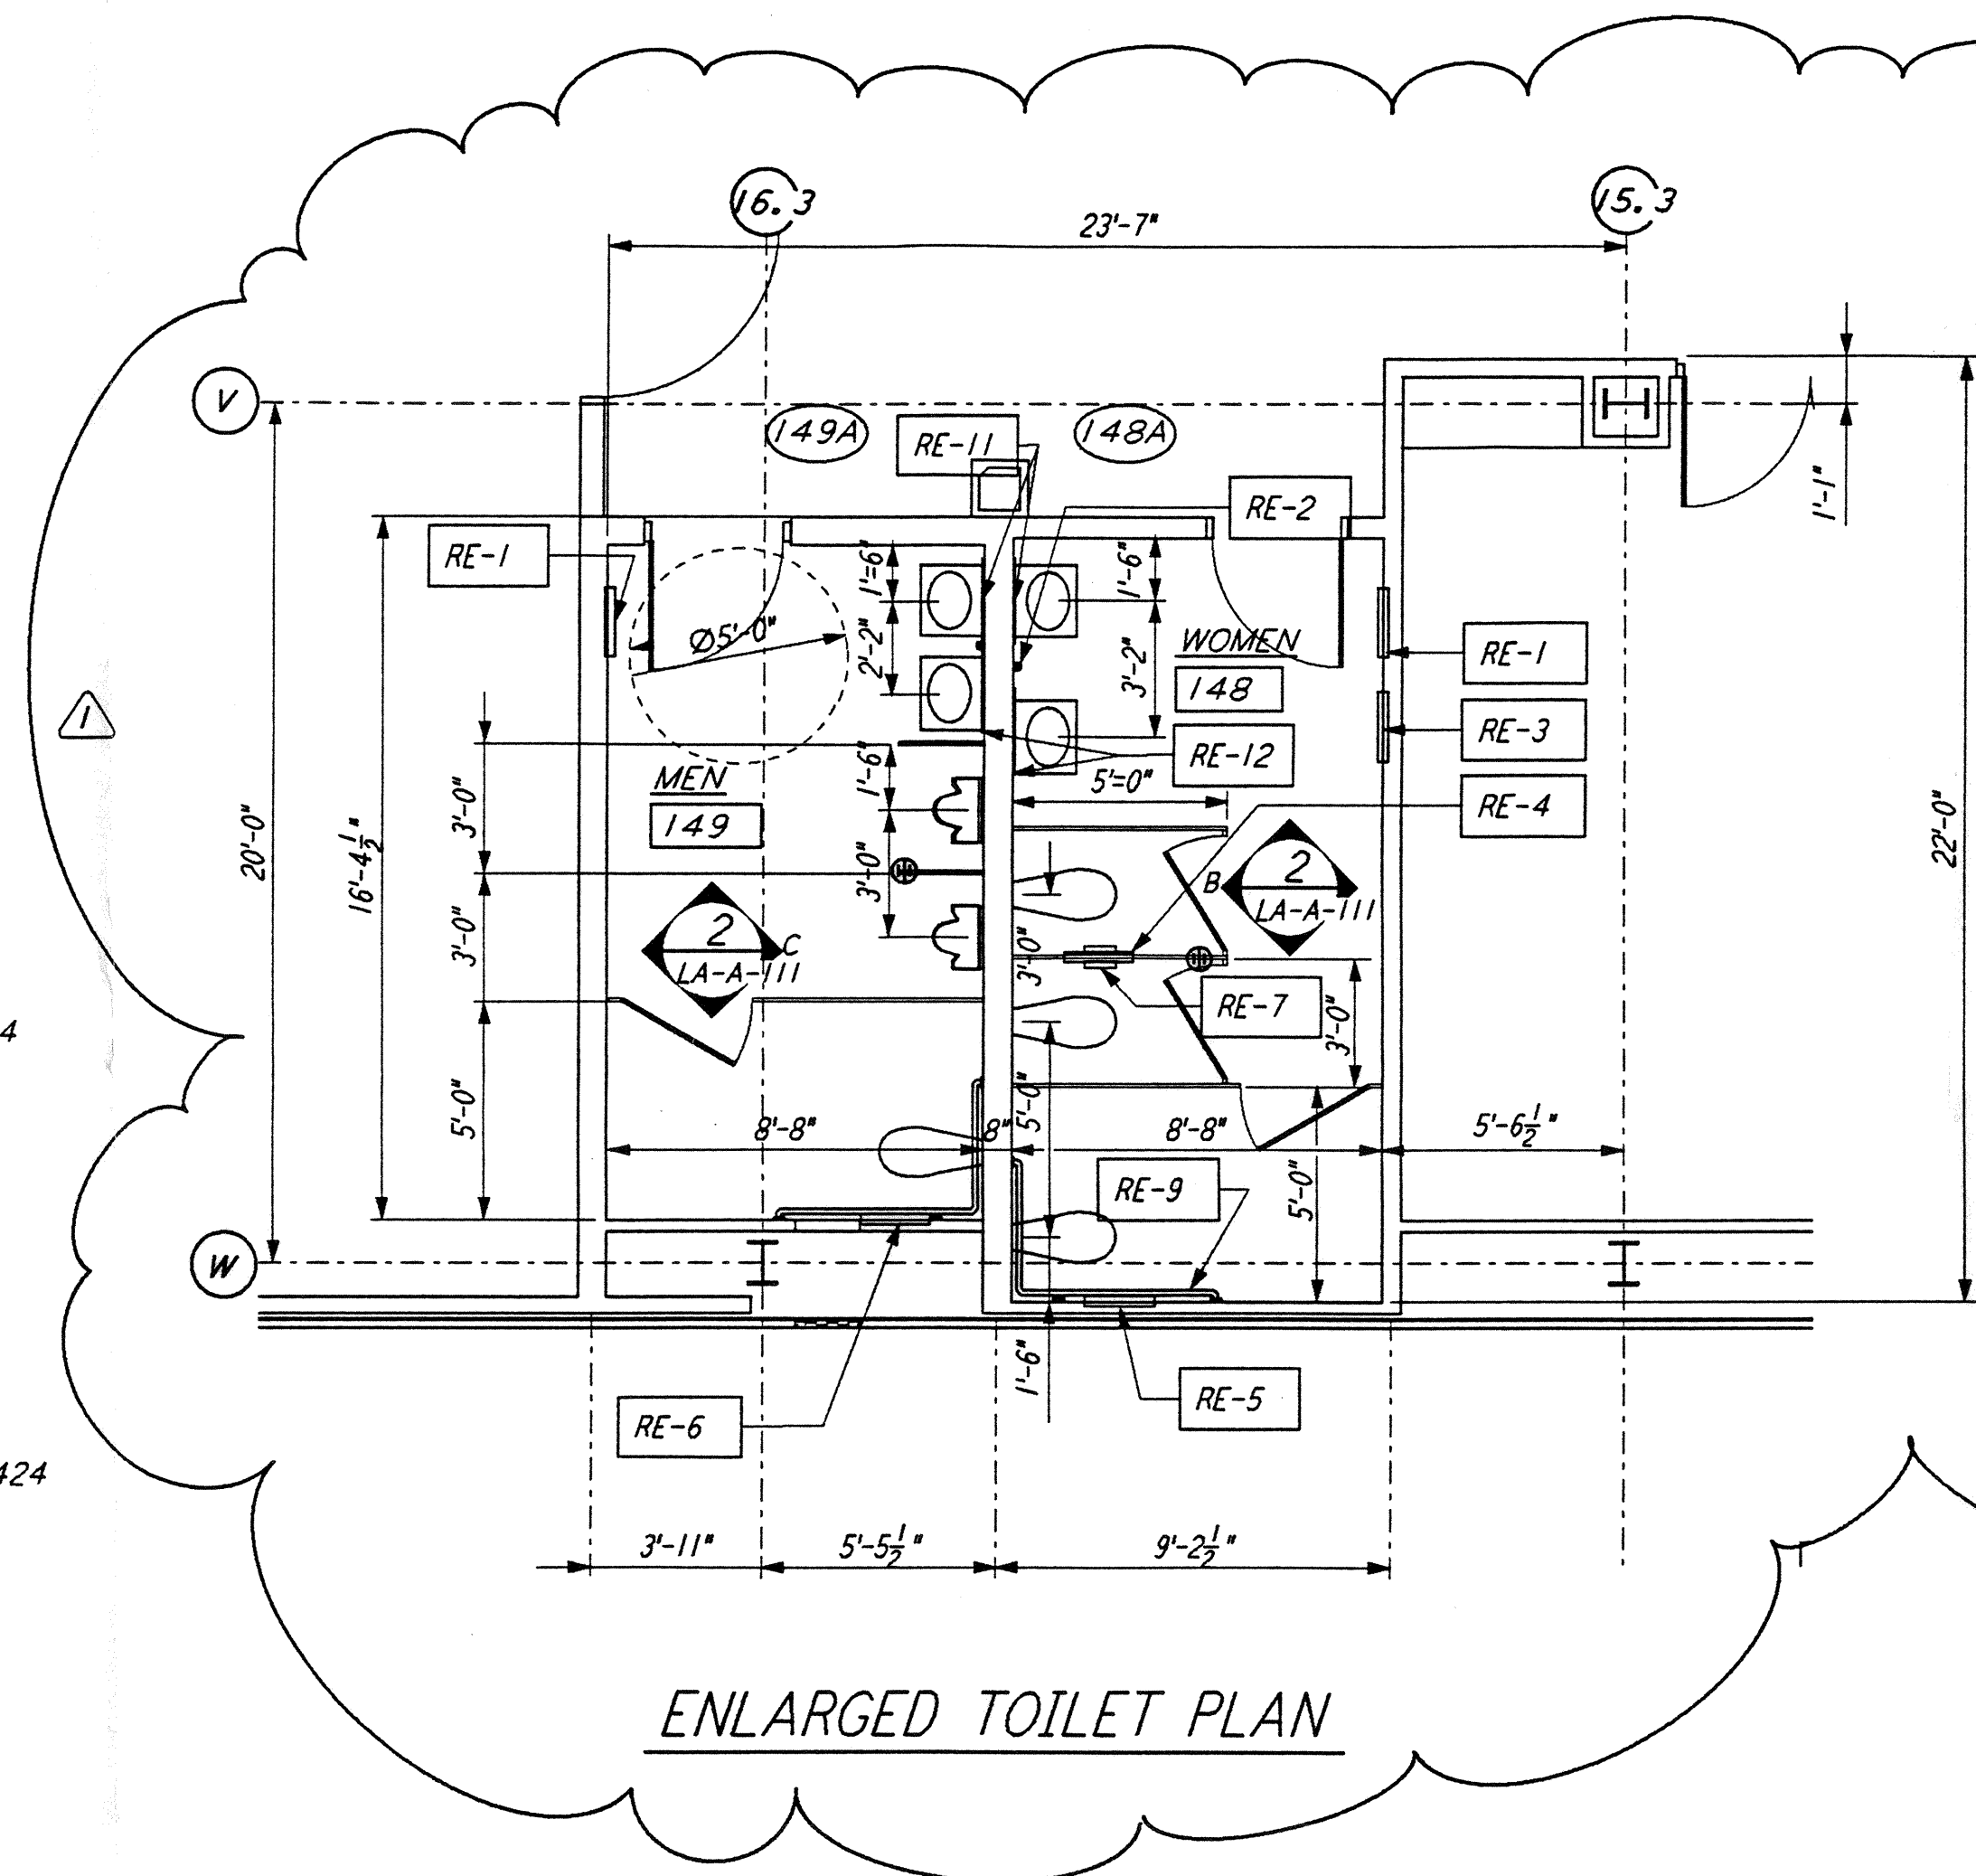

MEN 149 / WOMEN 148
 1/4" = 1'-0"

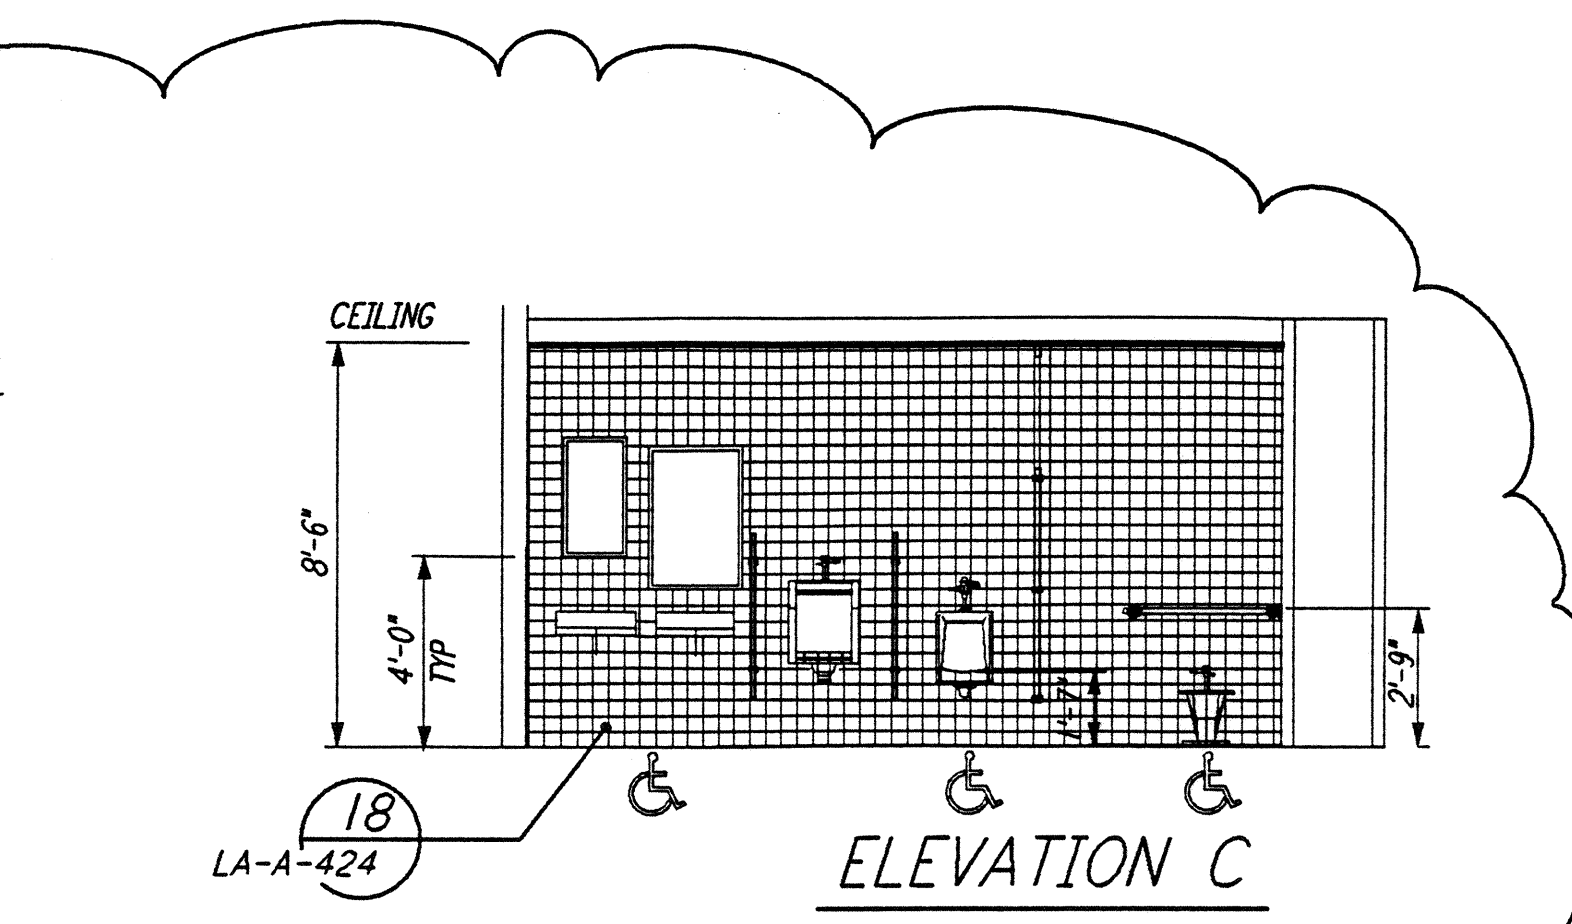


ELEVATION C

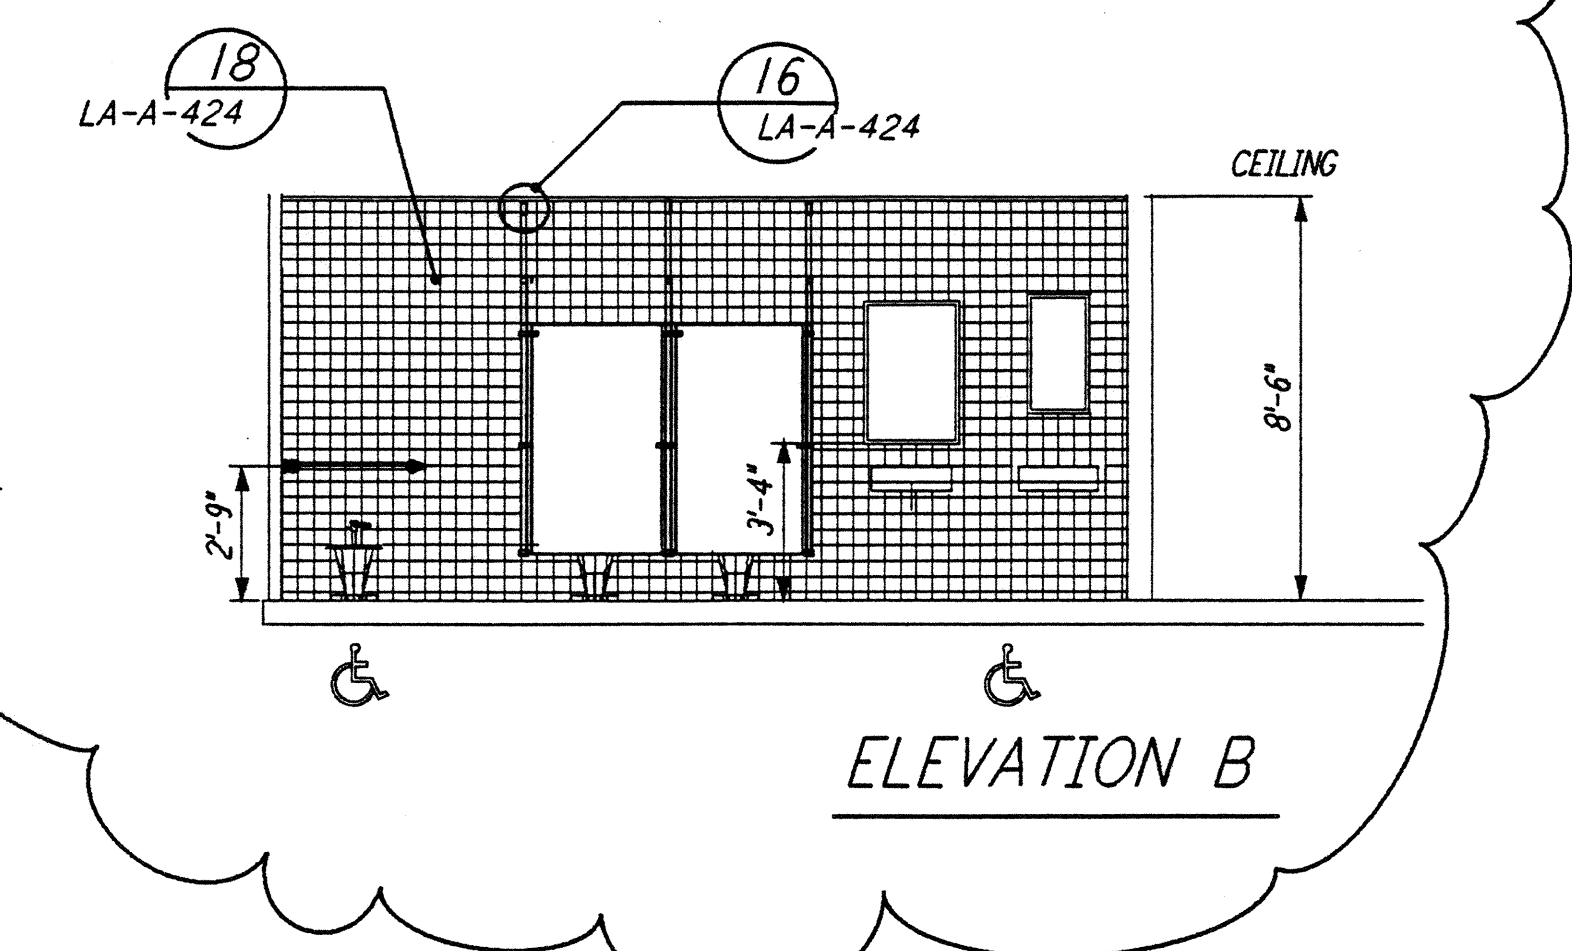


ELEVATION B

2 REF
 LA-A-111 LA-A-108

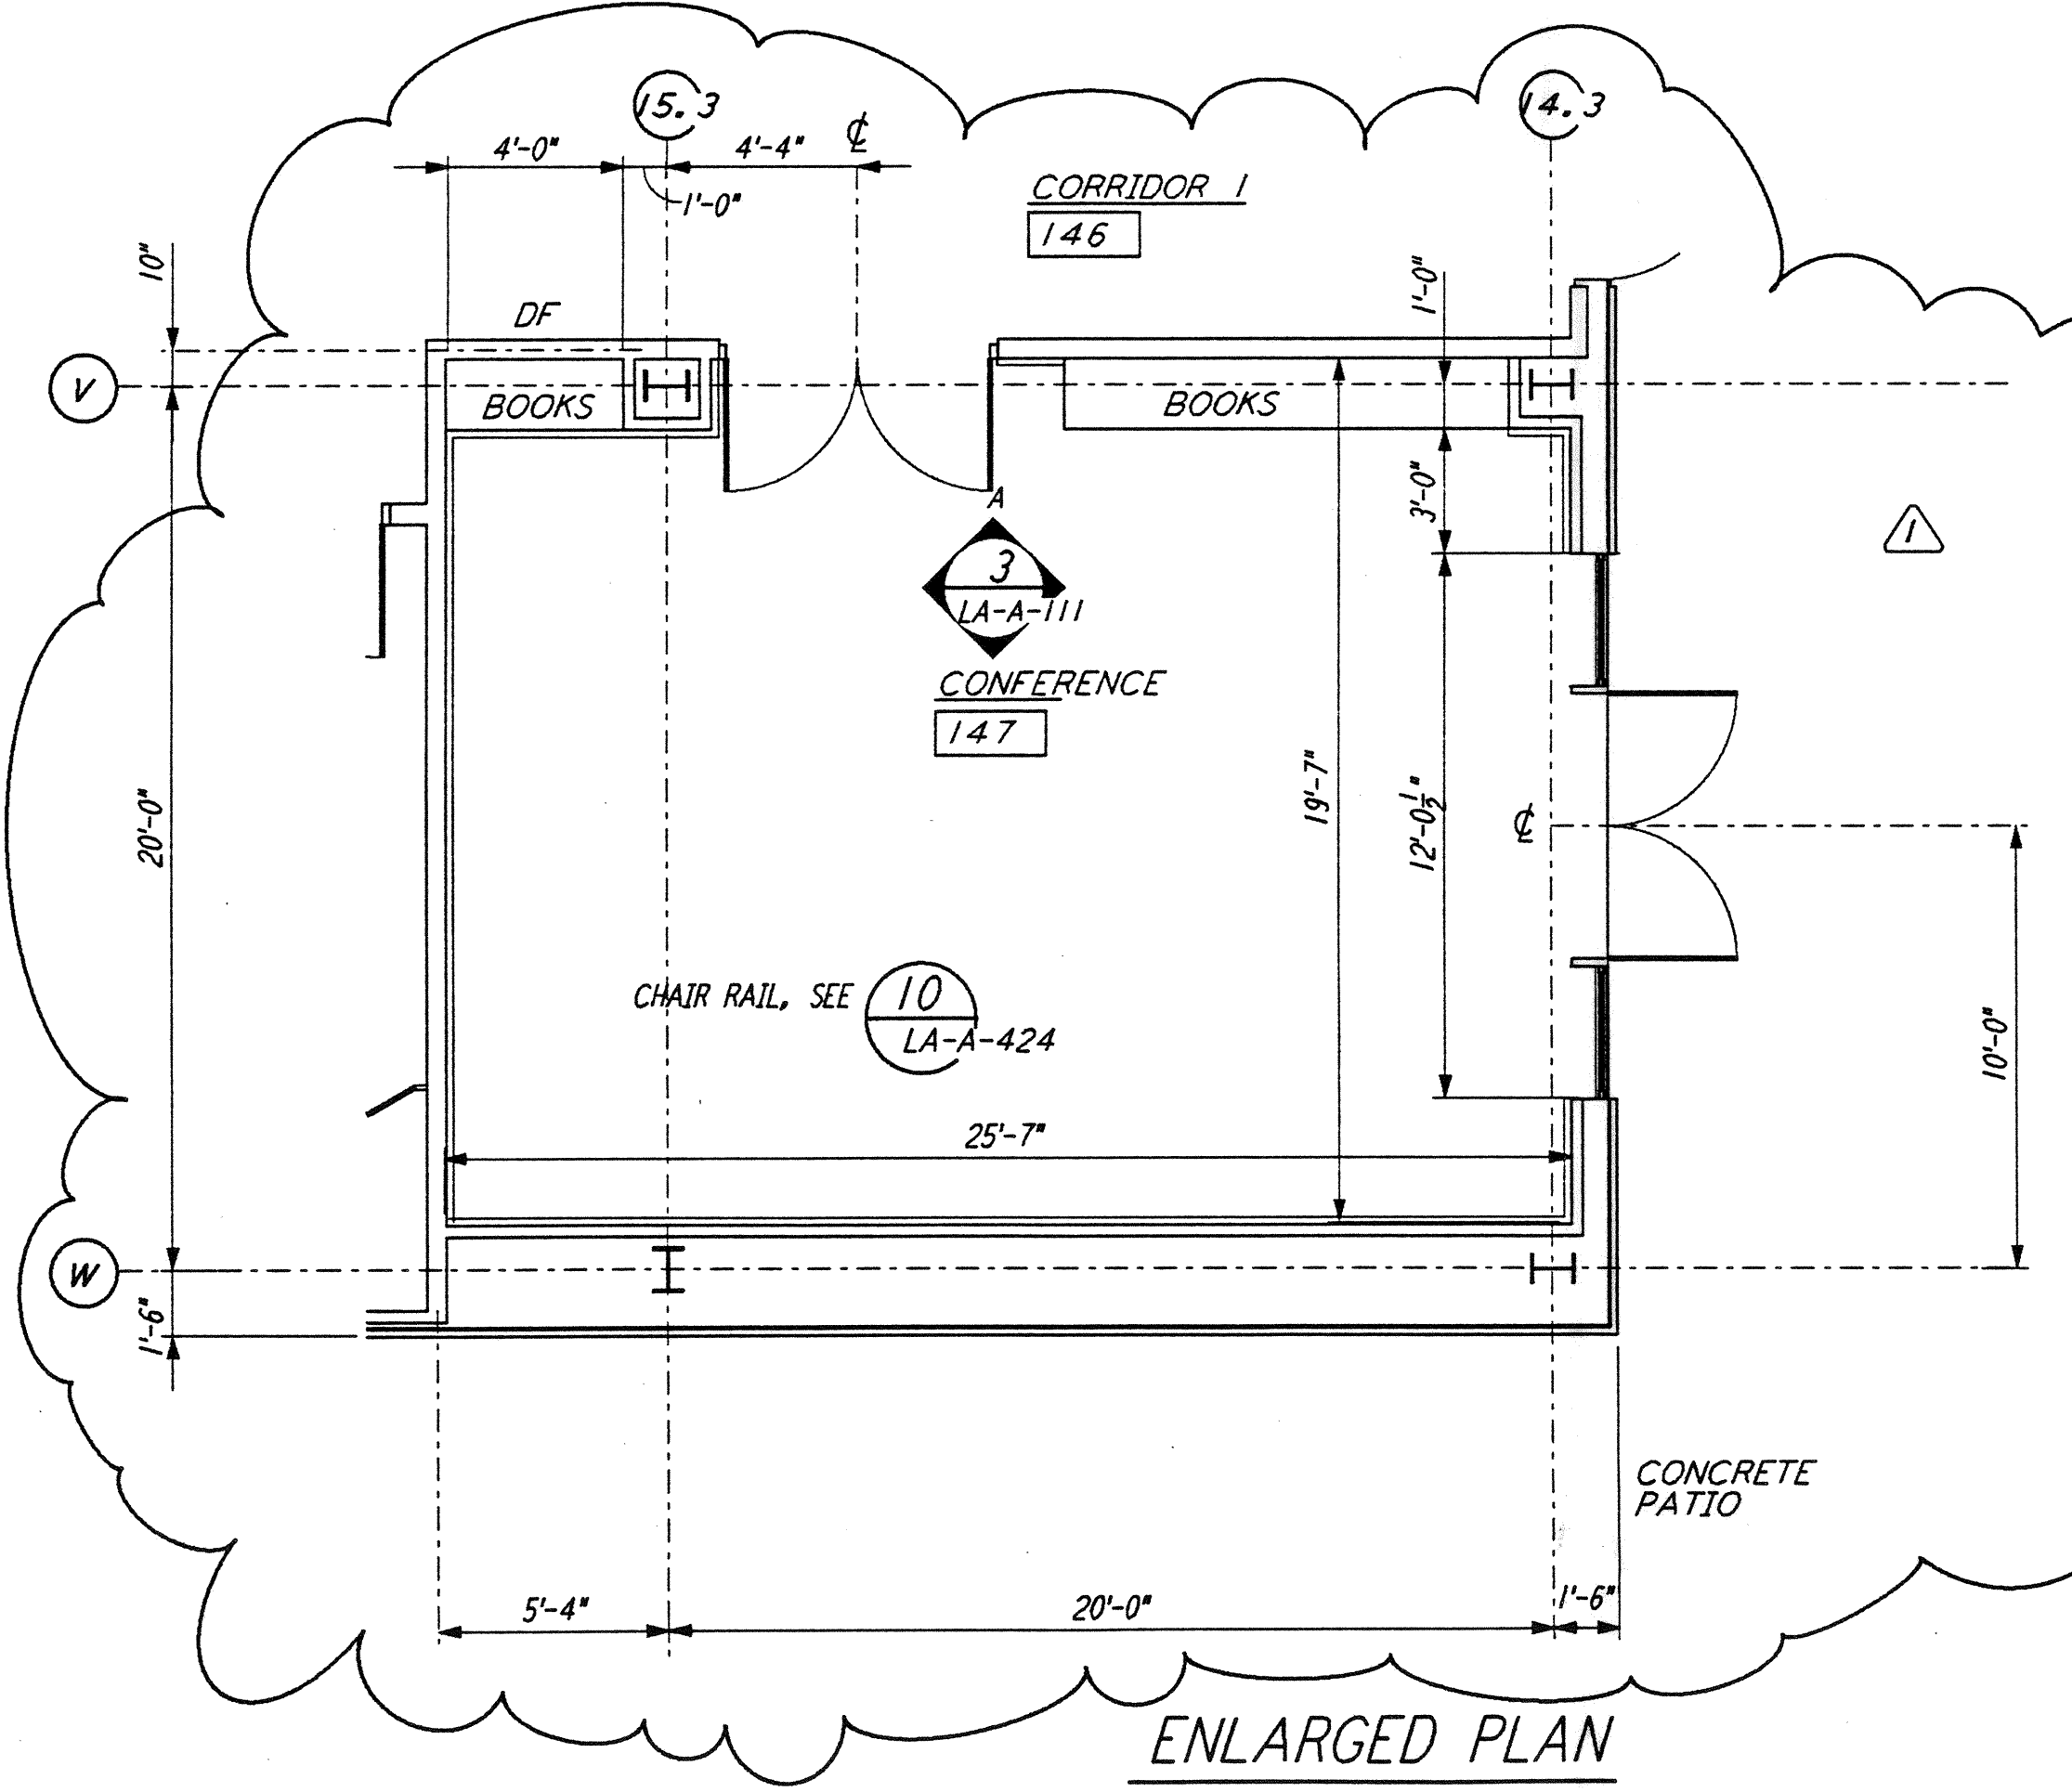


CONFERENCE ROOM 147
 1/4" = 1'-0"

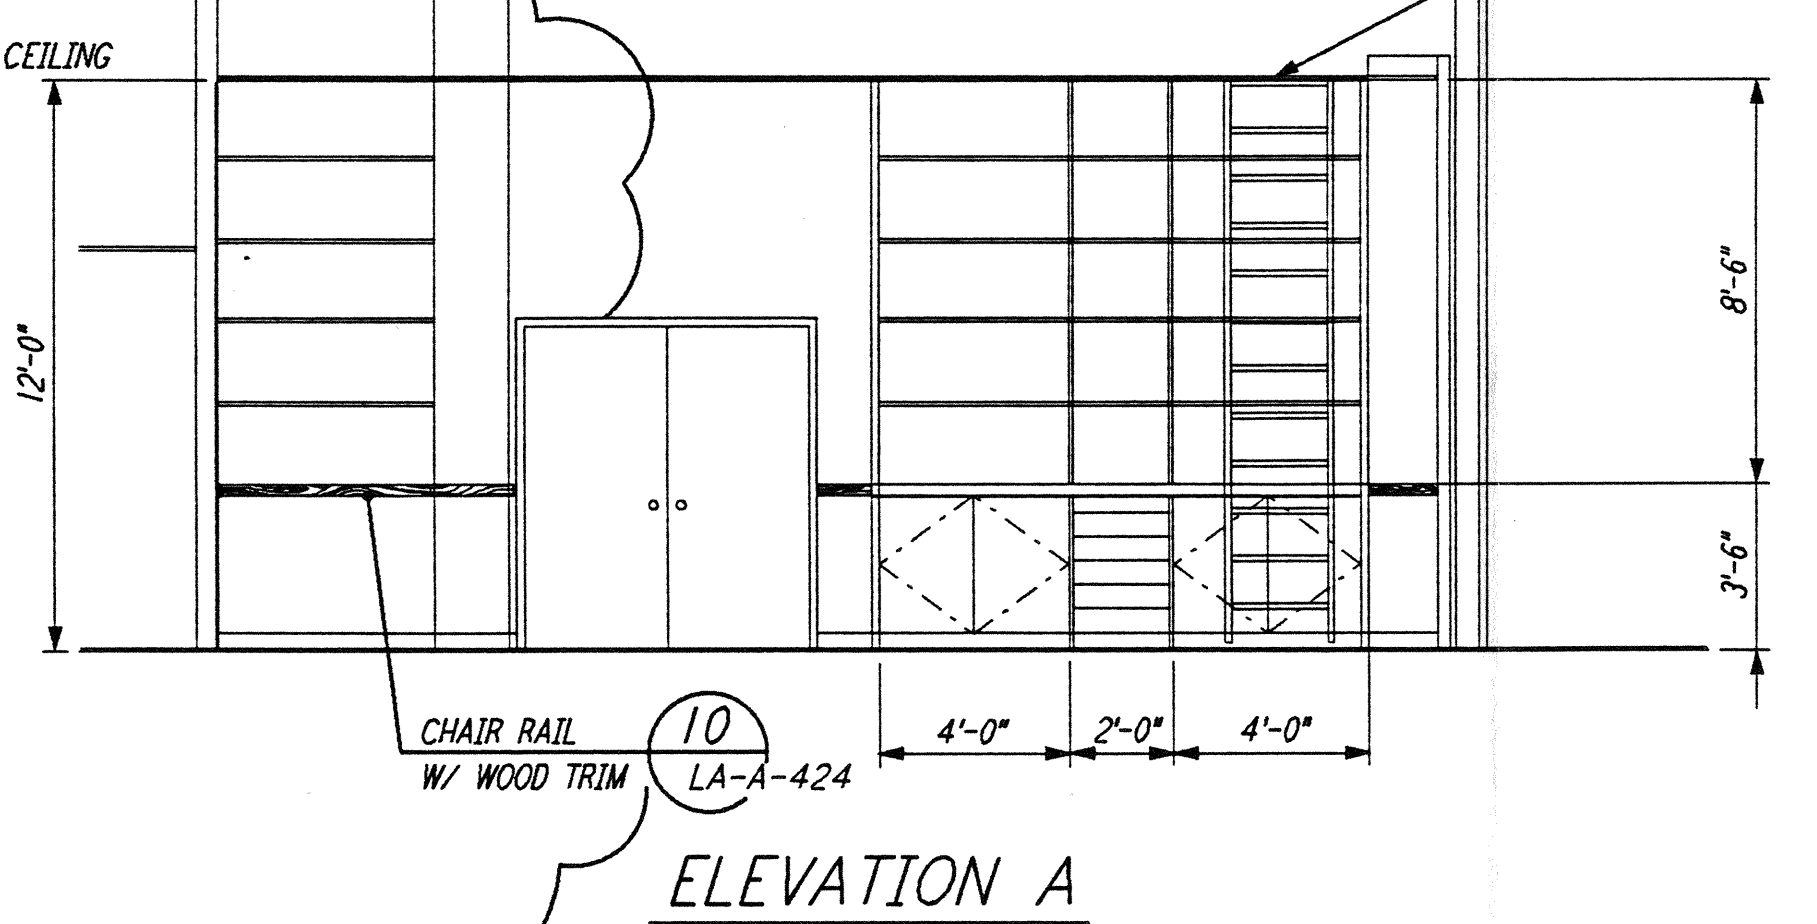


ELEVATION A


3 REF
 LA-A-111 LA-A-108

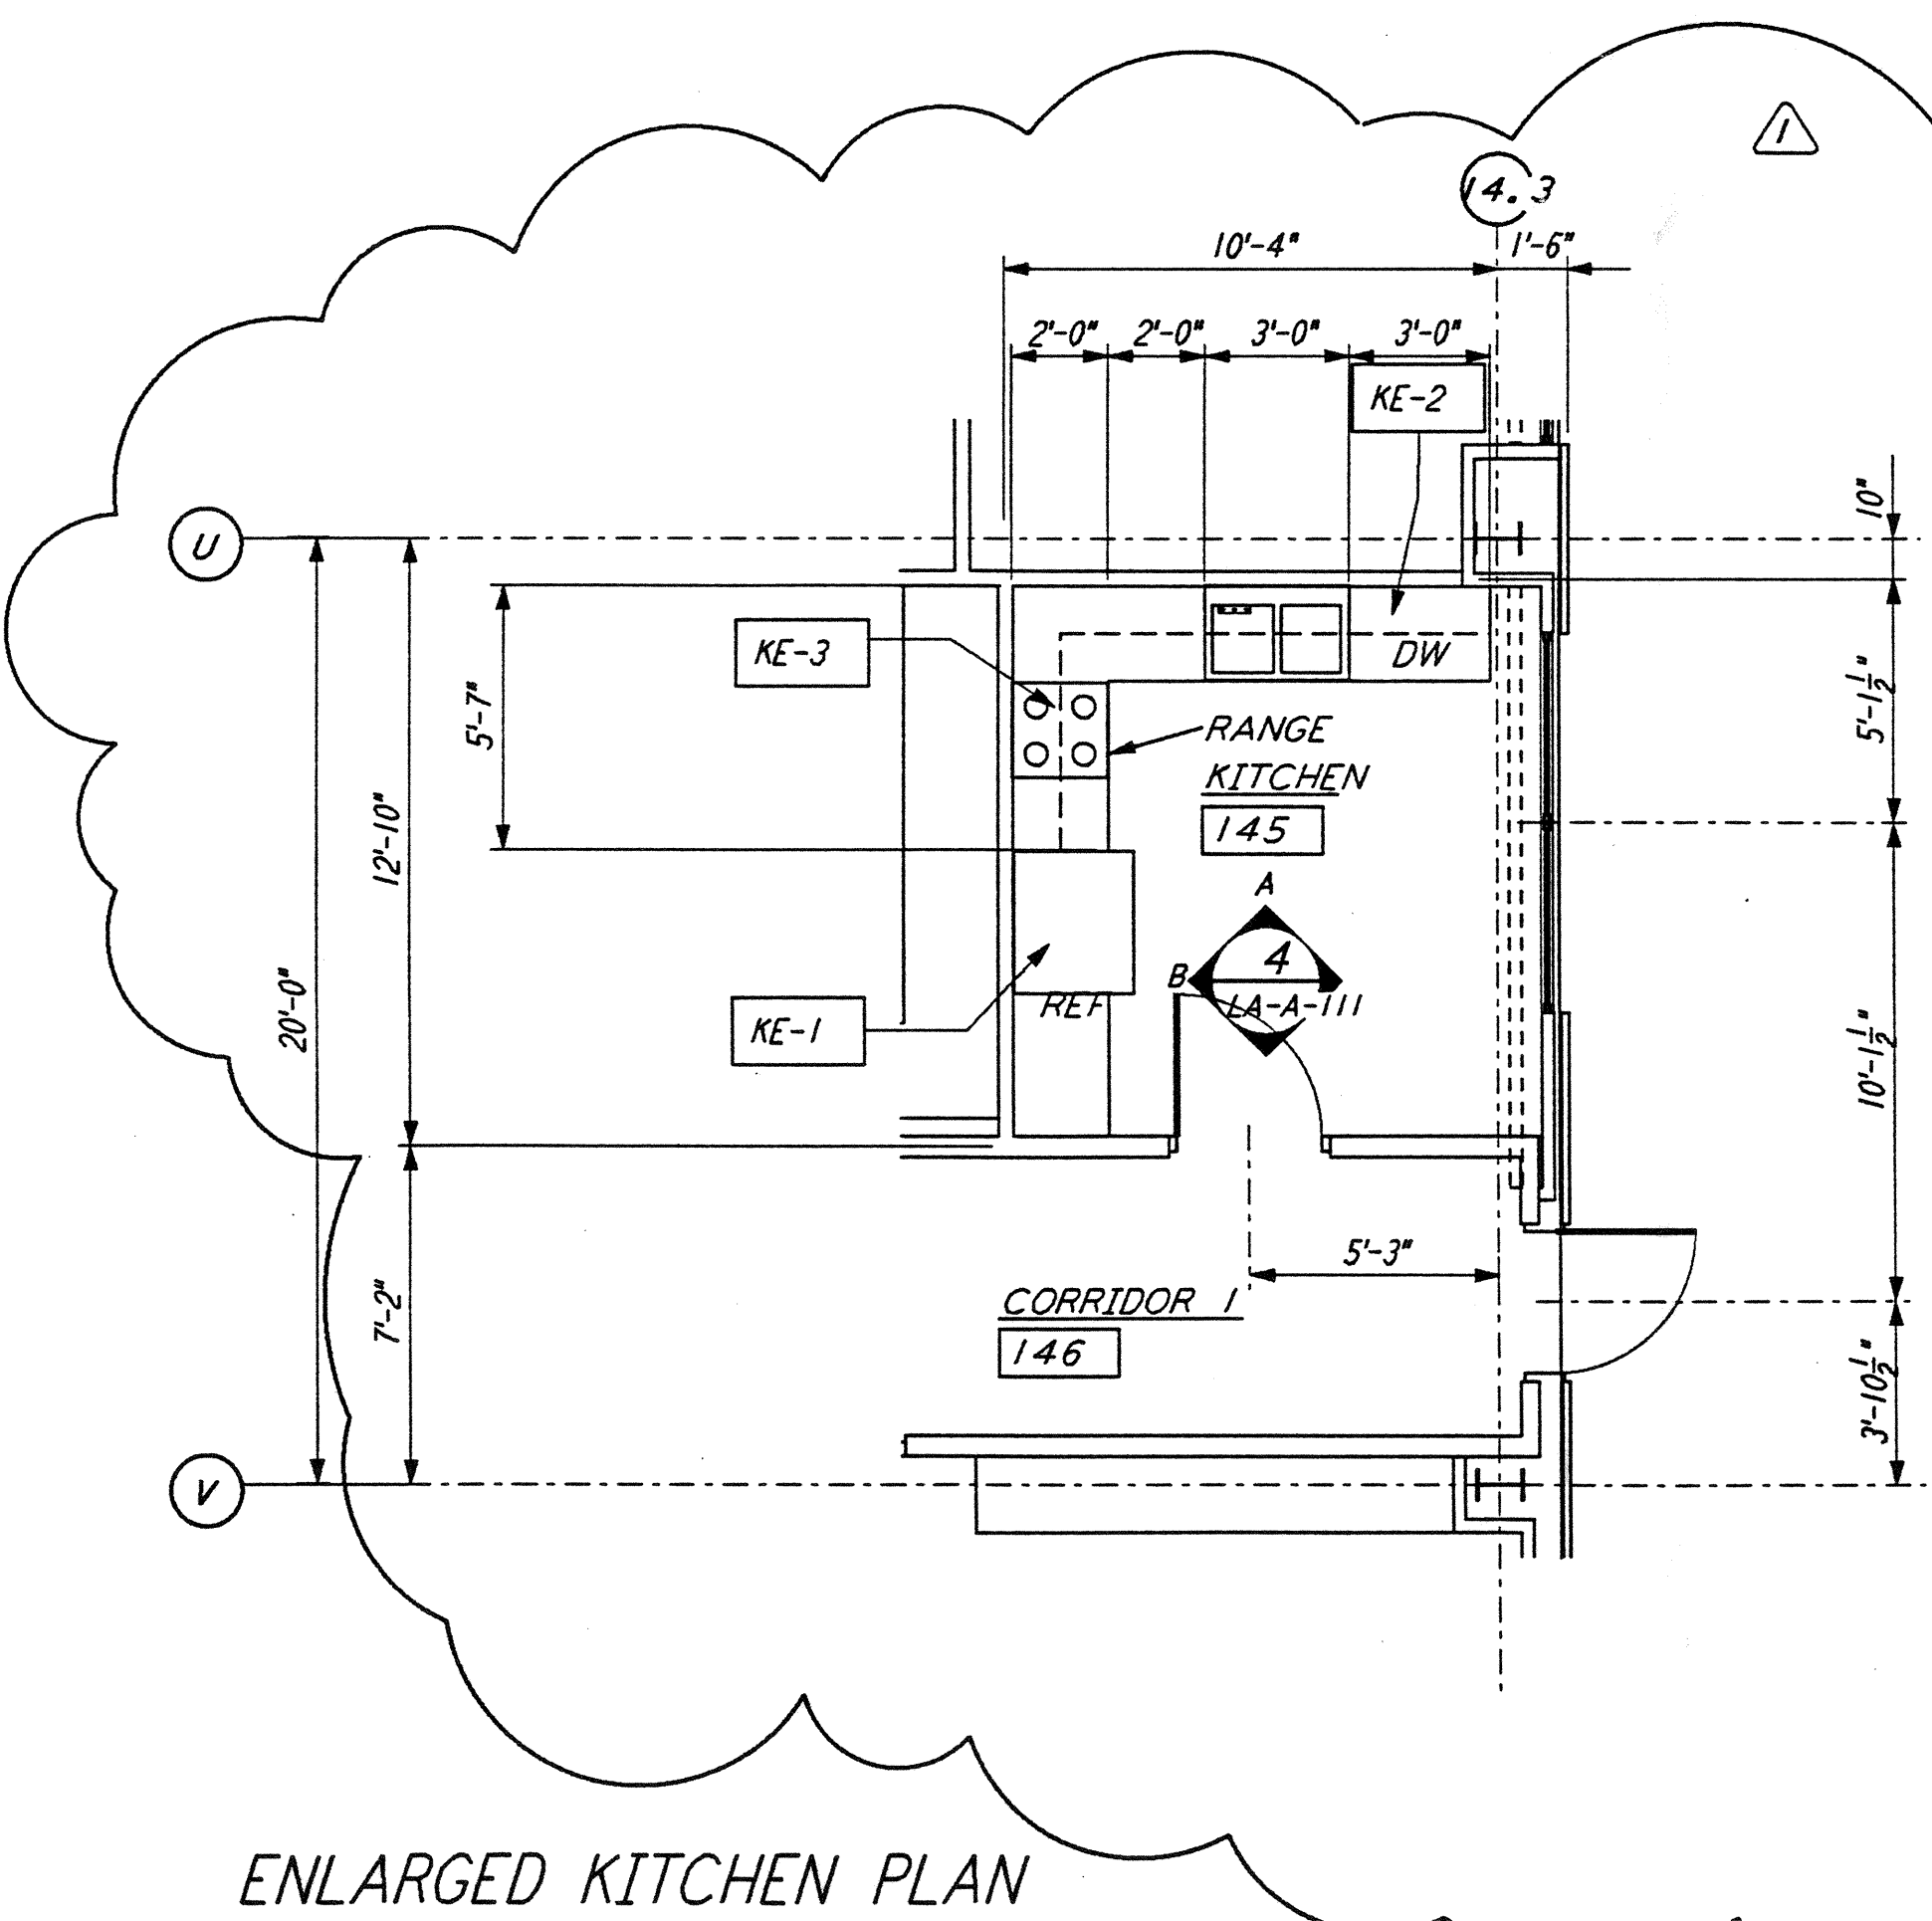

KITCHEN PLAN 145
 1/4" = 1'-0"

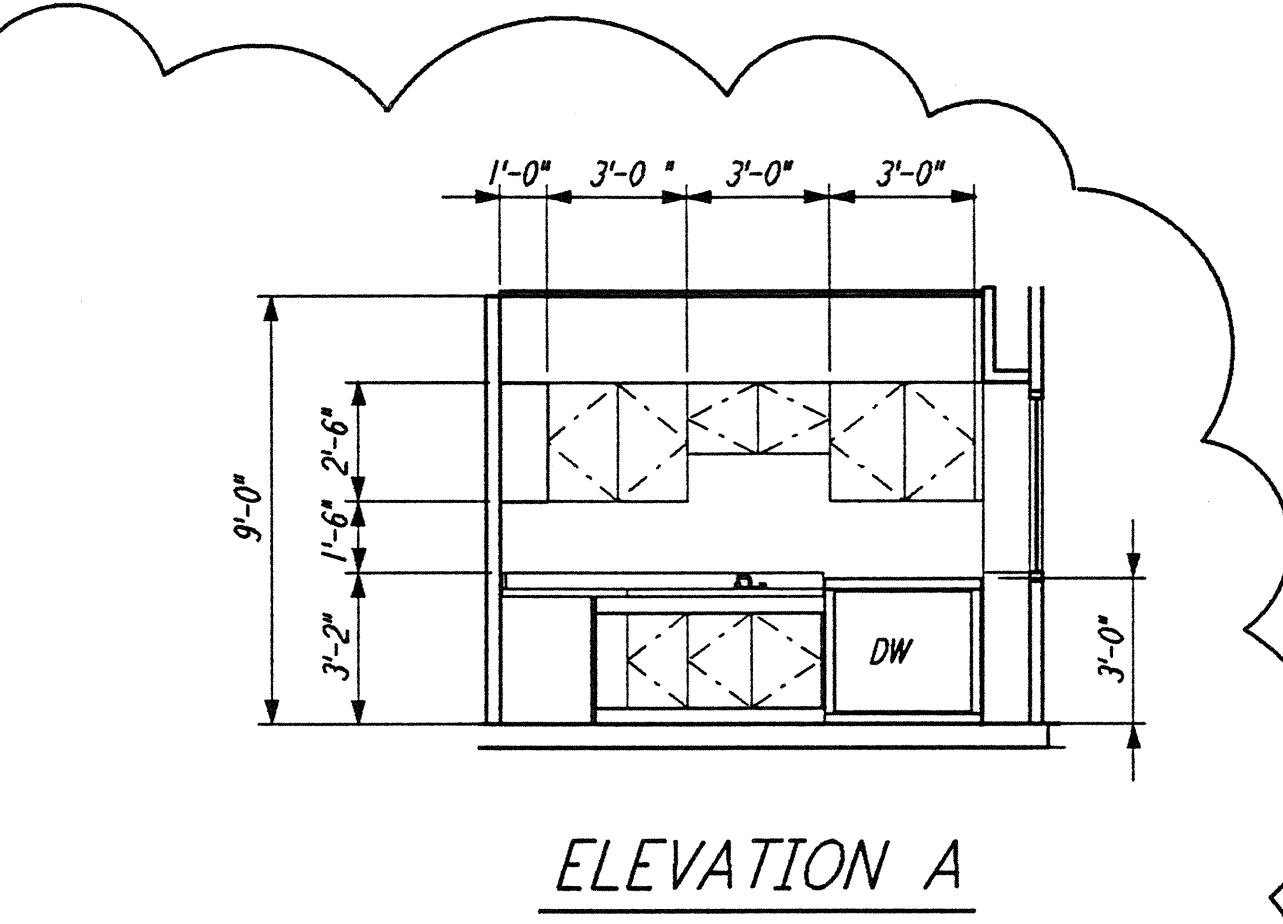


ELEVATION A

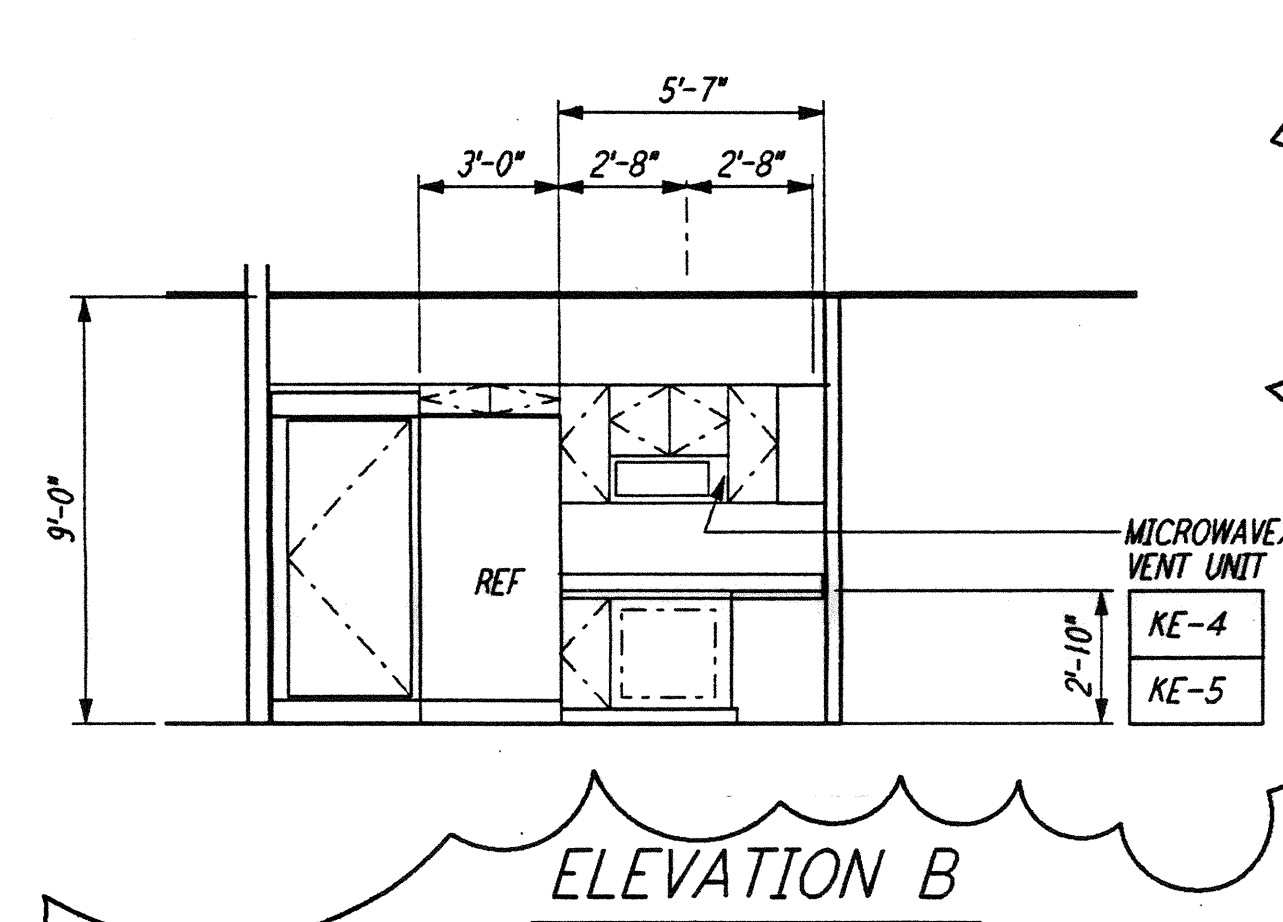

ELEVATION B

4 REF
 LA-A-111 LA-A-108

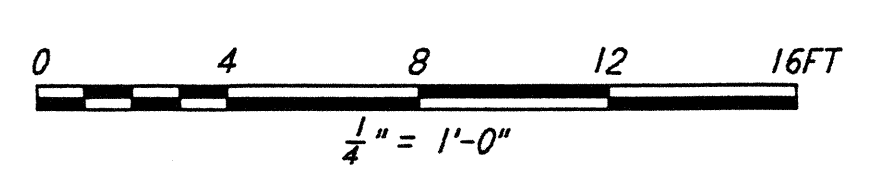

LIGO-D960876-01-O

not be reproduced, copied, loaned, exhibited, or used in any other way, except by written consent from PARSONS to the borrower.

This document and the design it covers are the property of PARSONS. They are loaned only with the borrower's expressed written agreement that they will

NO.	DATE	BY	CHKD	ENGR	PROJ	OSB REVISION	DESCRIPTION
1	2-28-97	CKT	TB	AK	TDM	OSB	REVISION

ISSUED FOR CONSTRUCTION		
DRAWN	CKT	11-15-96
CHECKED	TB	11-15-96
ENGINEER	SF	11-15-96
PROJ	MDW	11-15-96



PARSONS
 100 WEST WALNUT STREET
 PASADENA, CALIFORNIA

LIGO
 CALIFORNIA INSTITUTE OF TECHNOLOGY
 MASSACHUSETTS INSTITUTE OF TECHNOLOGY

LASER INTERFEROMETER
 GRAVITATIONAL-WAVE OBSERVATORY
 SITE NO. 2 - LIVINGSTON, LOUISIANA

TITLE	SCALE	CONTRACT NUMBER	PROJECT NUMBER
ARCHITECTURAL CORNER STATION OSB ENLARGED PLANS	AS NOTED	PPI 50969	8094
SHEET NUMBER		REVISIONS	
LA-A-111			