

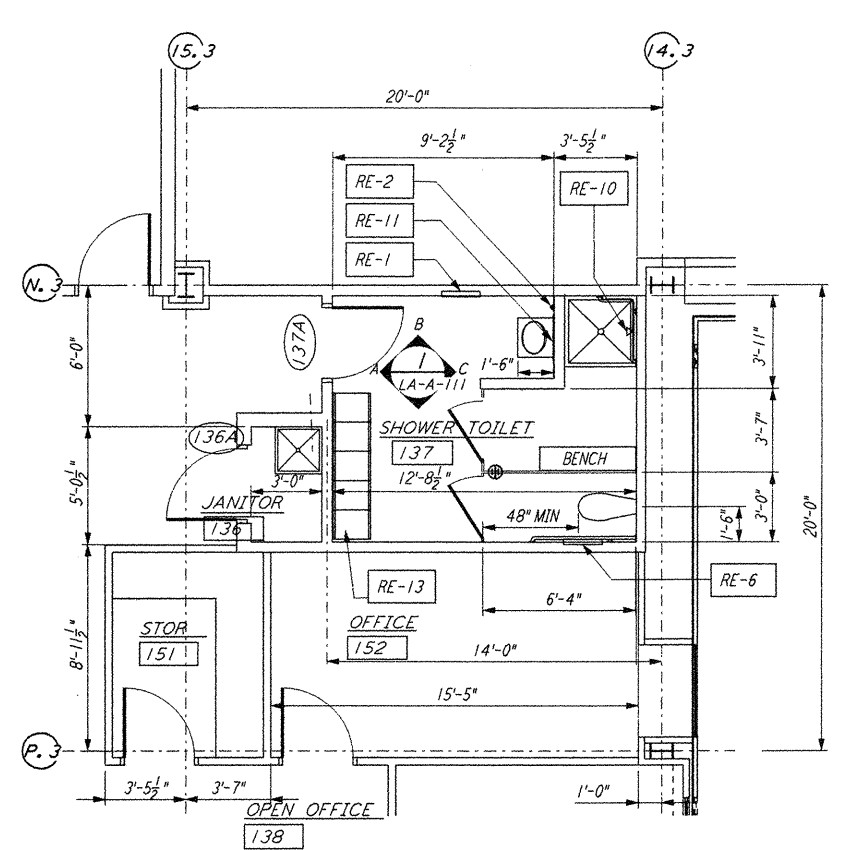


NOTE: SEE SPECIFICATIONS FOR
 ADDITIONAL INFORMATION
 AND SCHEDULES

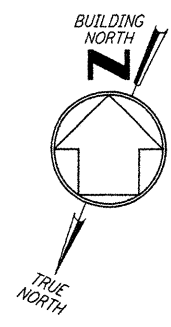


ENLARGED PLAN


JANITOR 136 / SHOWER TOILET 137
 $\frac{1}{4}'' = 1'-0''$

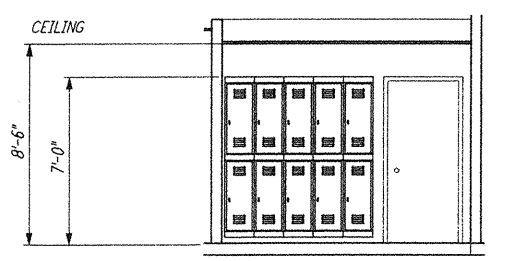

ELEVATION A

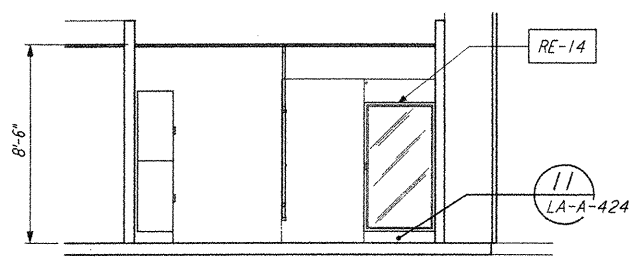


ELEVATION B

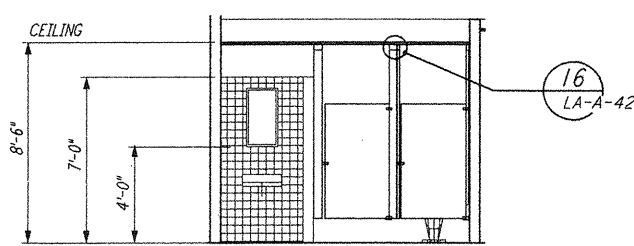


ELEVATION C

1 REF
 LA-A-111 LA-A-108

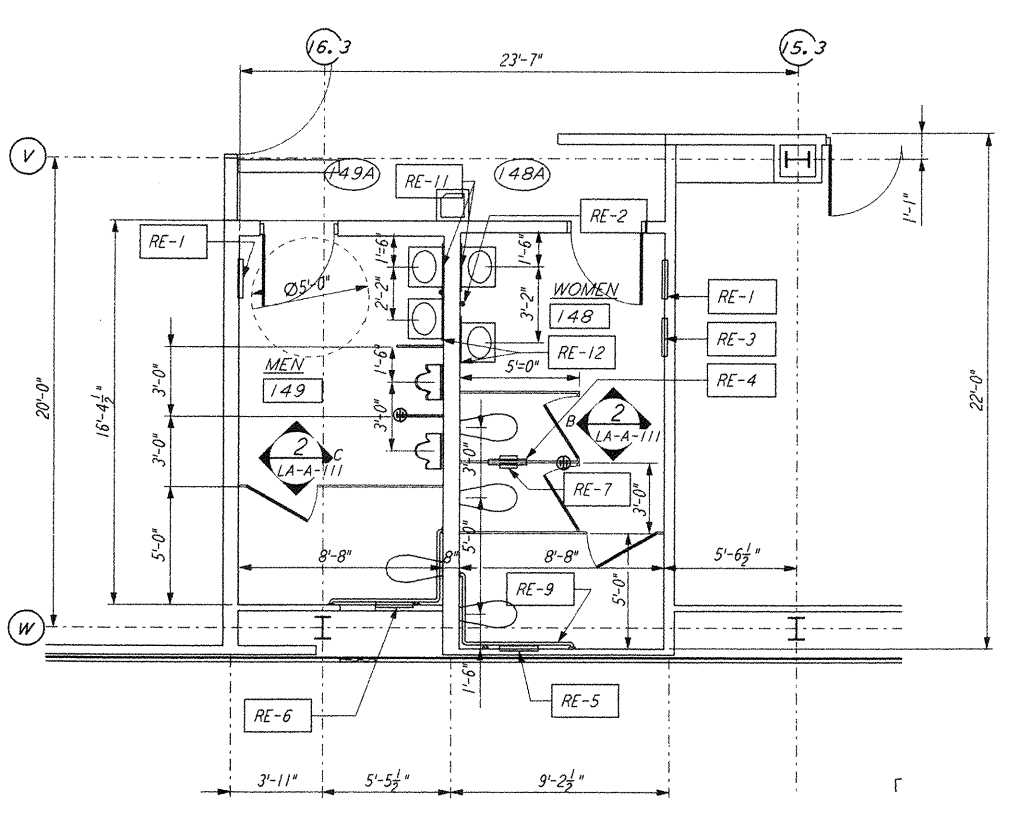


ENLARGED TOILET PLAN

MEN 149 / WOMEN 148
 $\frac{1}{4}'' = 1'-0''$

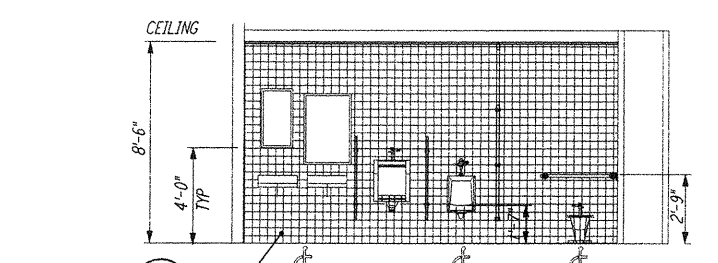


ELEVATION C

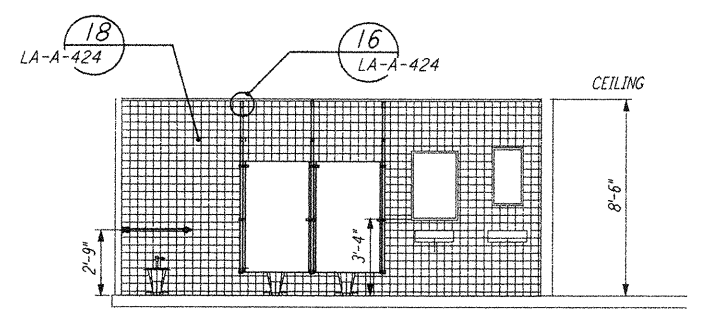


ELEVATION B

2 REF
 LA-A-111 LA-A-108

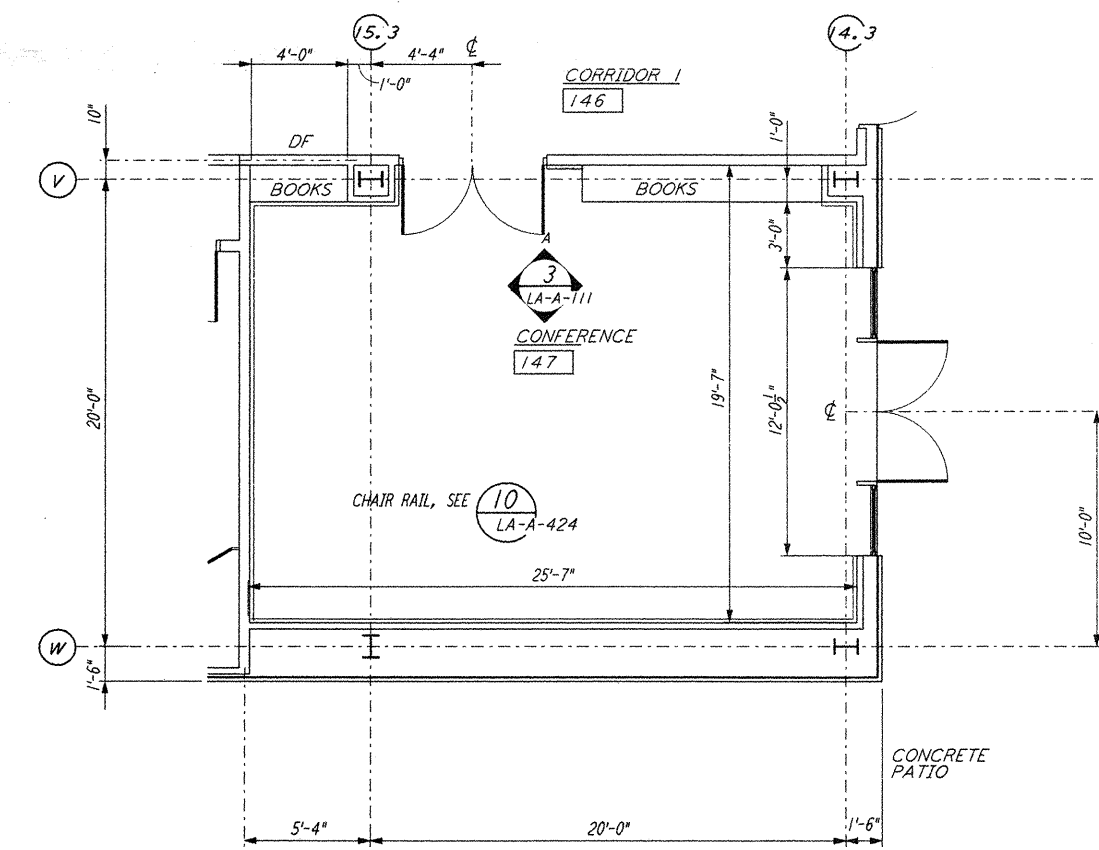


ENLARGED PLAN

CONFERENCE ROOM 147
 $\frac{1}{4}'' = 1'-0''$

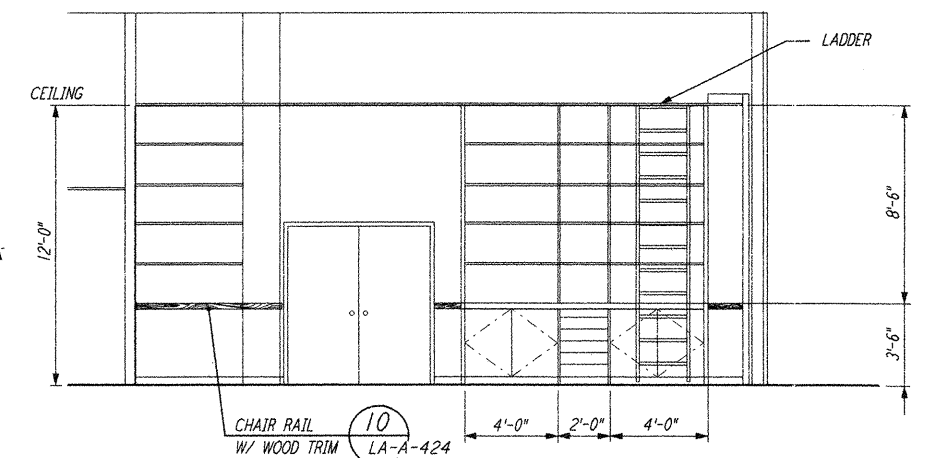


ELEVATION A

3 REF
 LA-A-111 LA-A-108

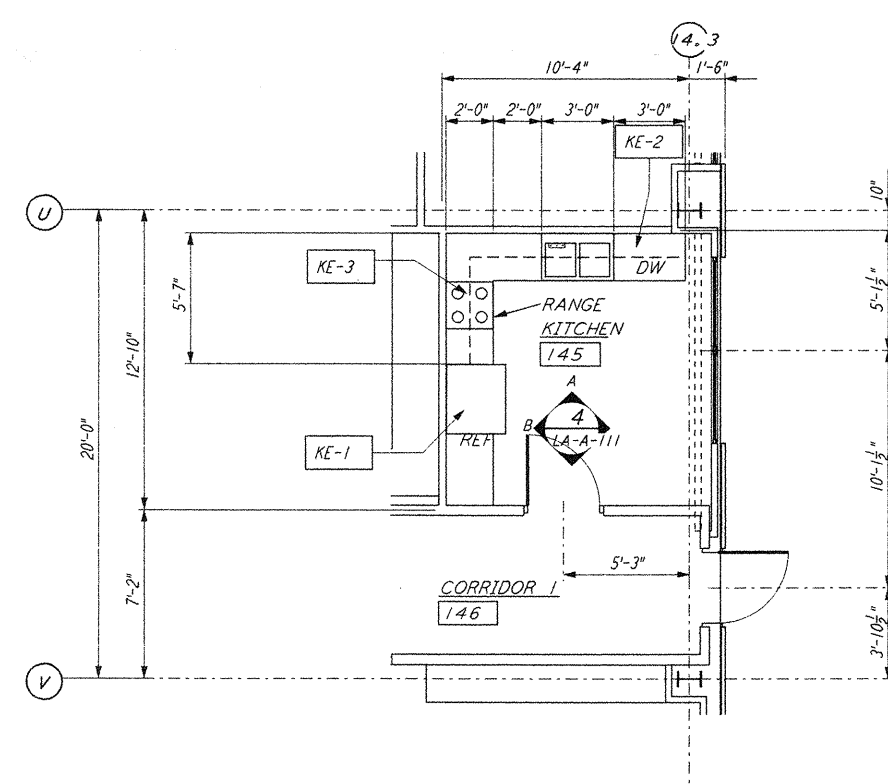


ENLARGED KITCHEN PLAN

KITCHEN PLAN 145
 $\frac{1}{4}'' = 1'-0''$

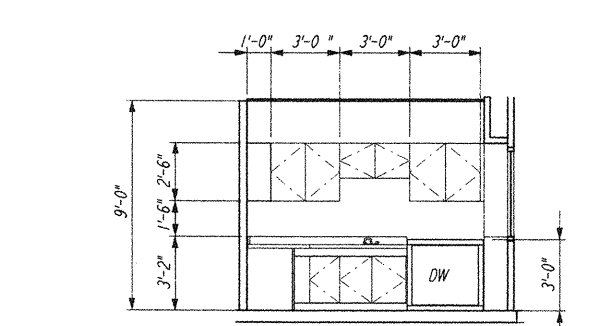


ELEVATION A

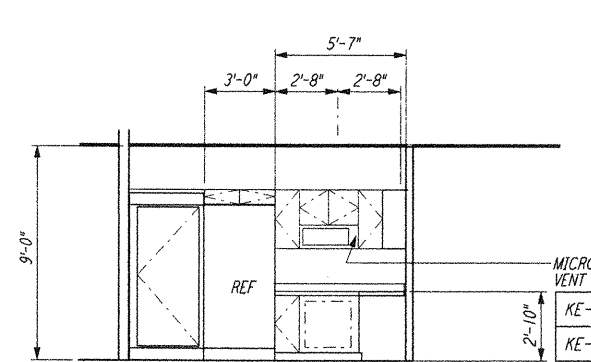

ELEVATION B

4 REF
 LA-A-111 LA-A-108

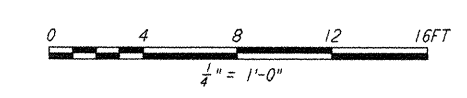

| NO. | DATE | BY | CHKD | ENGR | PROJ | DESCRIPTION |
|-----|----------|-----|------|------|------|---------------------|
| 2 | 08-07-98 | SJM | CKT | AK | TDM | ISSUED FOR AS-BUILT |
| 1 | 2-28-97 | CKT | TB | AK | TDM | OSB REVISION |

| NO. | DATE | BY | CHKD | ENGR | PROJ | DESCRIPTION |
|-----|----------|-----|------|------|------|-------------------------|
| 1 | 11-15-96 | CKT | TB | AK | TDM | ISSUED FOR CONSTRUCTION |
| 1 | 11-15-96 | CKT | TB | AK | TDM | CHECKED |
| 1 | 11-15-96 | CKT | TB | AK | TDM | ENGINEER |
| 1 | 11-15-96 | CKT | TB | AK | TDM | PROJ |

AS-BUILT DRAWINGS

PARSONS
 100 WEST WALNUT STREET
 PASADENA, CALIFORNIA

LIGO
 CALIFORNIA INSTITUTE OF TECHNOLOGY
 MASSACHUSETTS INSTITUTE OF TECHNOLOGY

LIGO-D960876-02-0
 LASER INTERFEROMETER
 GRAVITATIONAL-WAVE OBSERVATORY
 SITE NO. 2 - LIVINGSTON, LOUISIANA

ARCHITECTURAL CORNER STATION OSB ENLARGED PLANS
 AS NOTED PP150969 8094
LA-A-111

This document and the design it covers are the property of PARSONS. They are loaned only with the borrower's expressed written agreement that they will not be reproduced, copied, loaned, exhibited, or used in any other way, except by written consent from PARSONS to the borrower.

P:\PL01\001\33\19862.DWG 52885 K:\V\862\ar\lga111.dwg
 14 Aug 14 19:39:01 1998