


SEE SHEET LA-A-107

SEE SHEET LA-A-107

0 8 16 24 32 40 48 56 64 FT
 1/8" = 1'-0"
 DATUM POINT EL +100.00 = 61.44' (LVEA)
 DATUM POINT EL +100.00 = 61.44' (OSB)

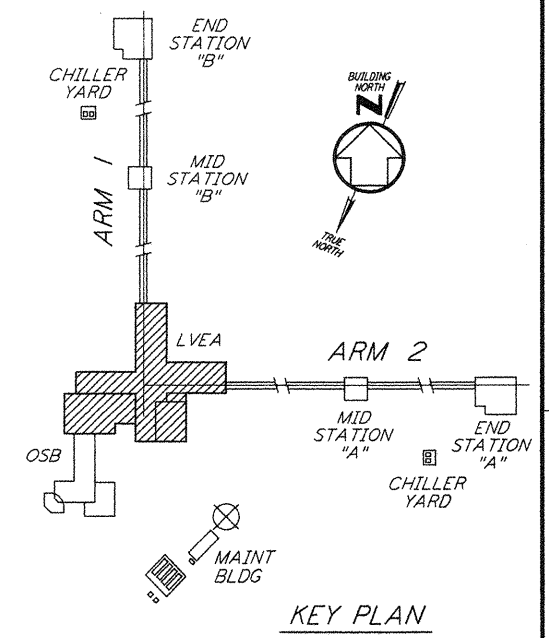

KEY PLAN

LIGO-D960881-01-0

NO.	DATE	BY	CHKD	ENGR	PROJ	DESCRIPTION
1	08-07-98	SJM	WCT	RAJ		ISSUED FOR AS-BUILT

ISSUED FOR CONSTRUCTION
 DRAWN CKT 11-15-98
 CHECKED TB 11-15-98
 ENGINEER SF 11-15-98
 PROJ TOM 11-15-98

AS-BUILT DRAWINGS

PARSONS
 100 WEST WALNUT STREET
 PASADENA, CALIFORNIA

LIGO
 CALIFORNIA INSTITUTE OF TECHNOLOGY
 MASSACHUSETTS INSTITUTE OF TECHNOLOGY

LASER INTERFEROMETER
 GRAVITATIONAL-WAVE OBSERVATORY
 SITE NO. 2 - LIVINGSTON, LOUISIANA

ARCHITECTURAL
 CORNER STATION
 LVEA ROOF PLAN

SCALE: CONTRACT NUMBER: PPI50969 PROJECT NUMBER: 8094
 SHEET NUMBER: LA-A-131 REVISIONS: 1

This document and the design it covers are the property of PARSONS. They are loaned only with the borrower's expressed written agreement that they will not be reproduced, copied, loaned, exhibited, or used in any other way, except by written consent from PARSONS to the borrower.