




MID STATION "A" / "B" REFLECTED CEILING PLAN
 1/8" = 1'-0" (4) LA-A-201

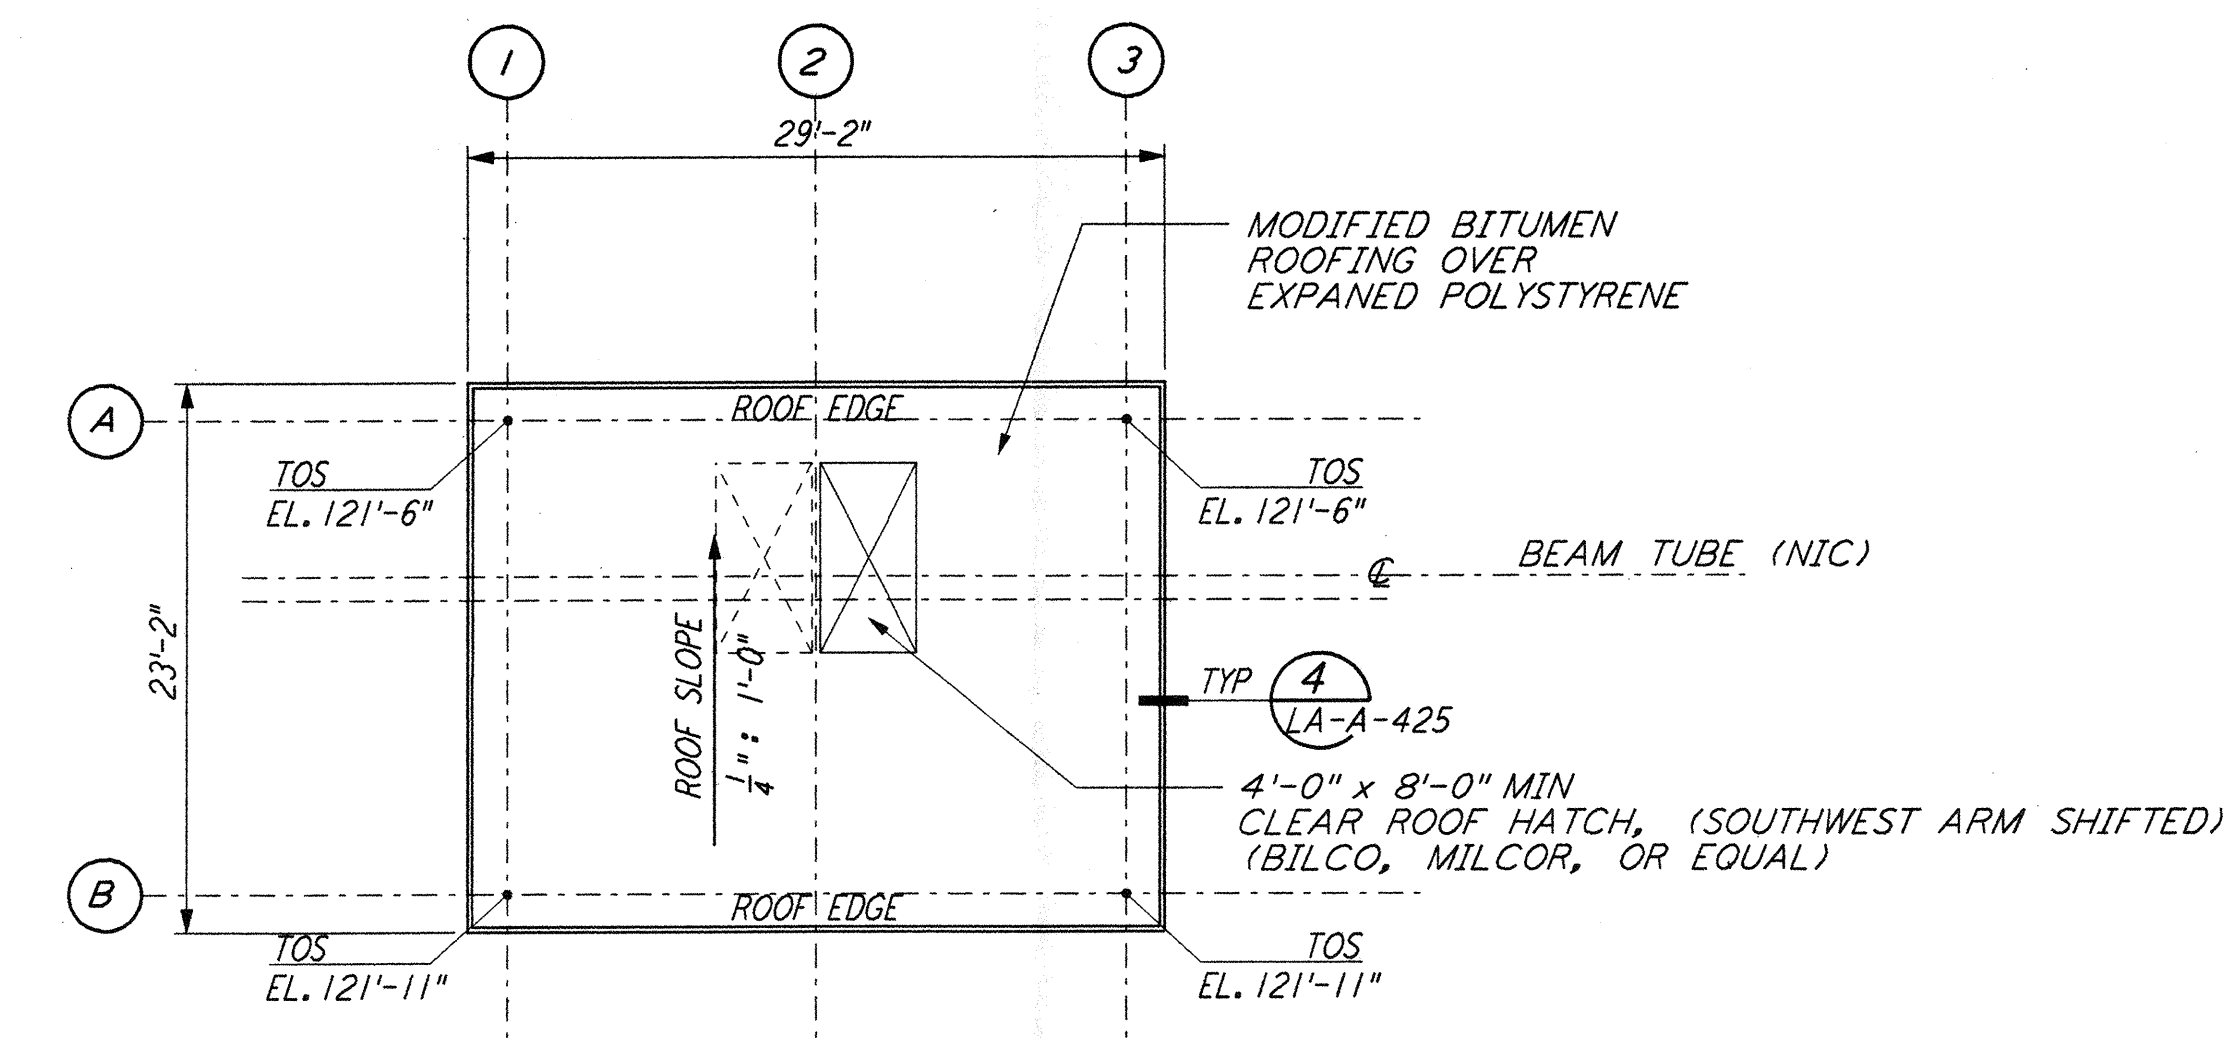


MID STATION "A" / "B" ROOF PLAN
 1/8" = 1'-0" (1) LA-A-201

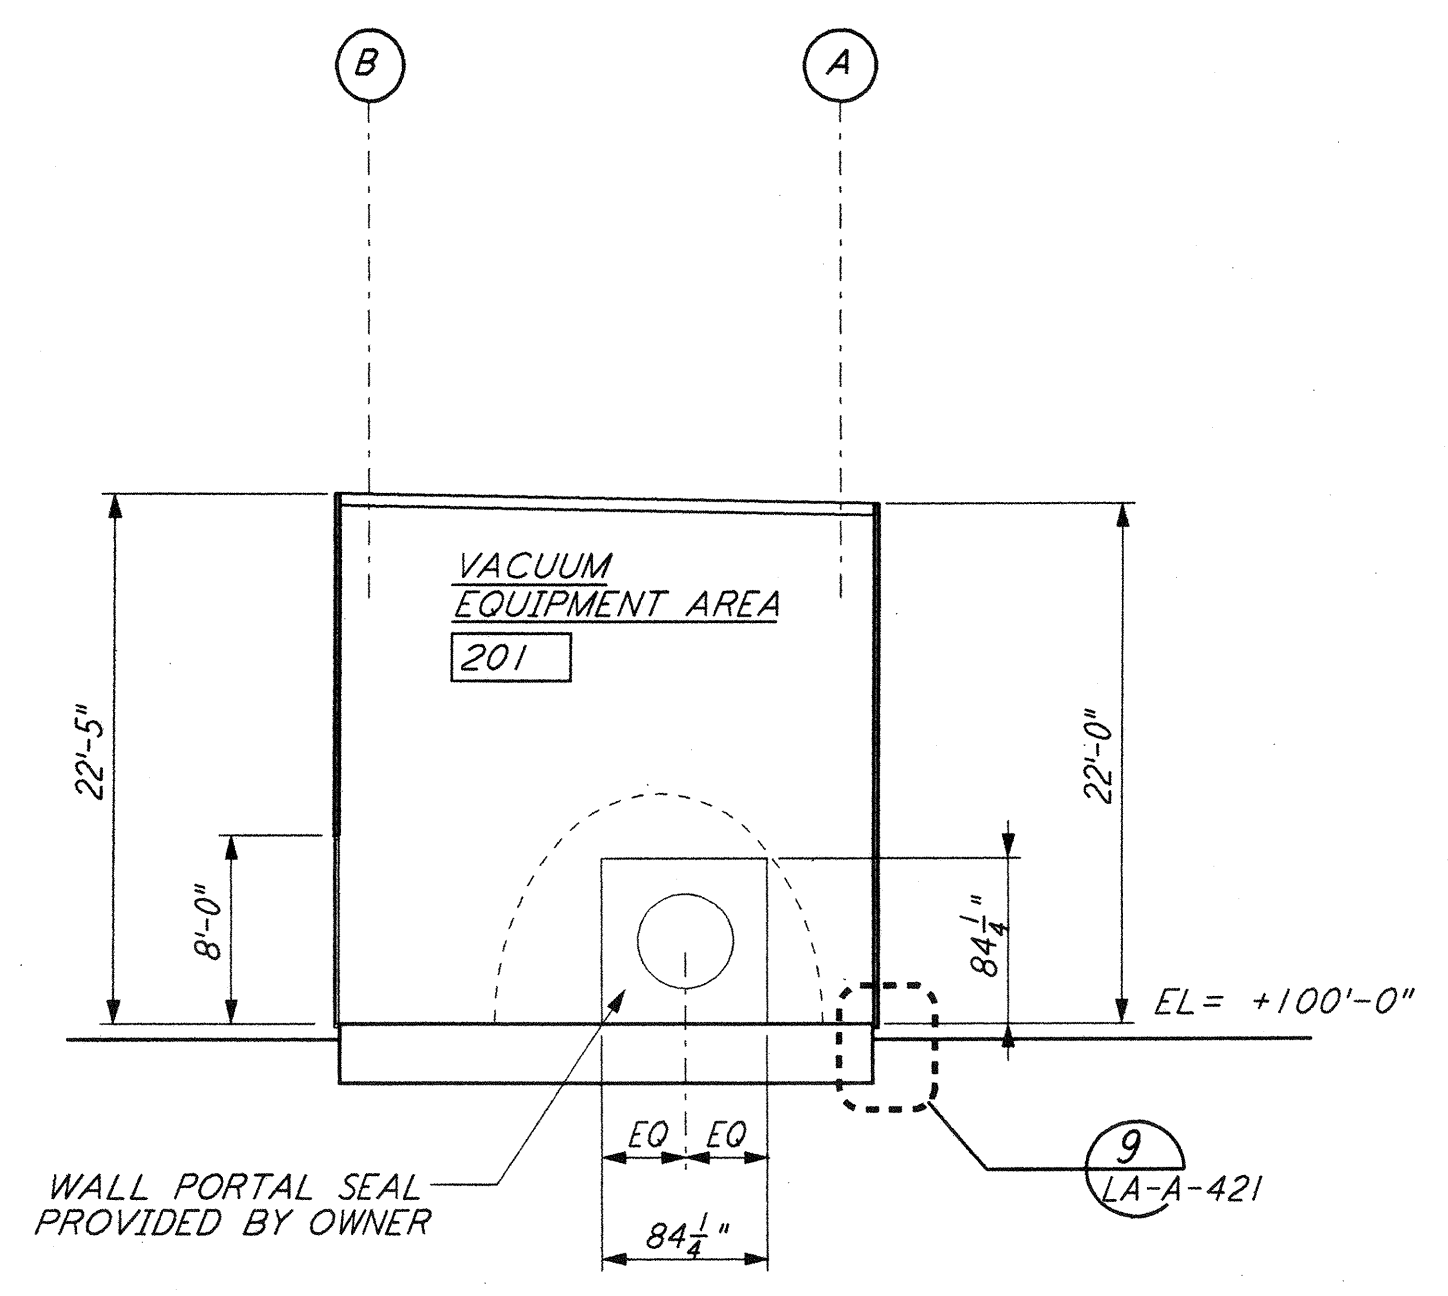


SECTION A-A
 1/8" = 1'-0" (9) LA-A-201

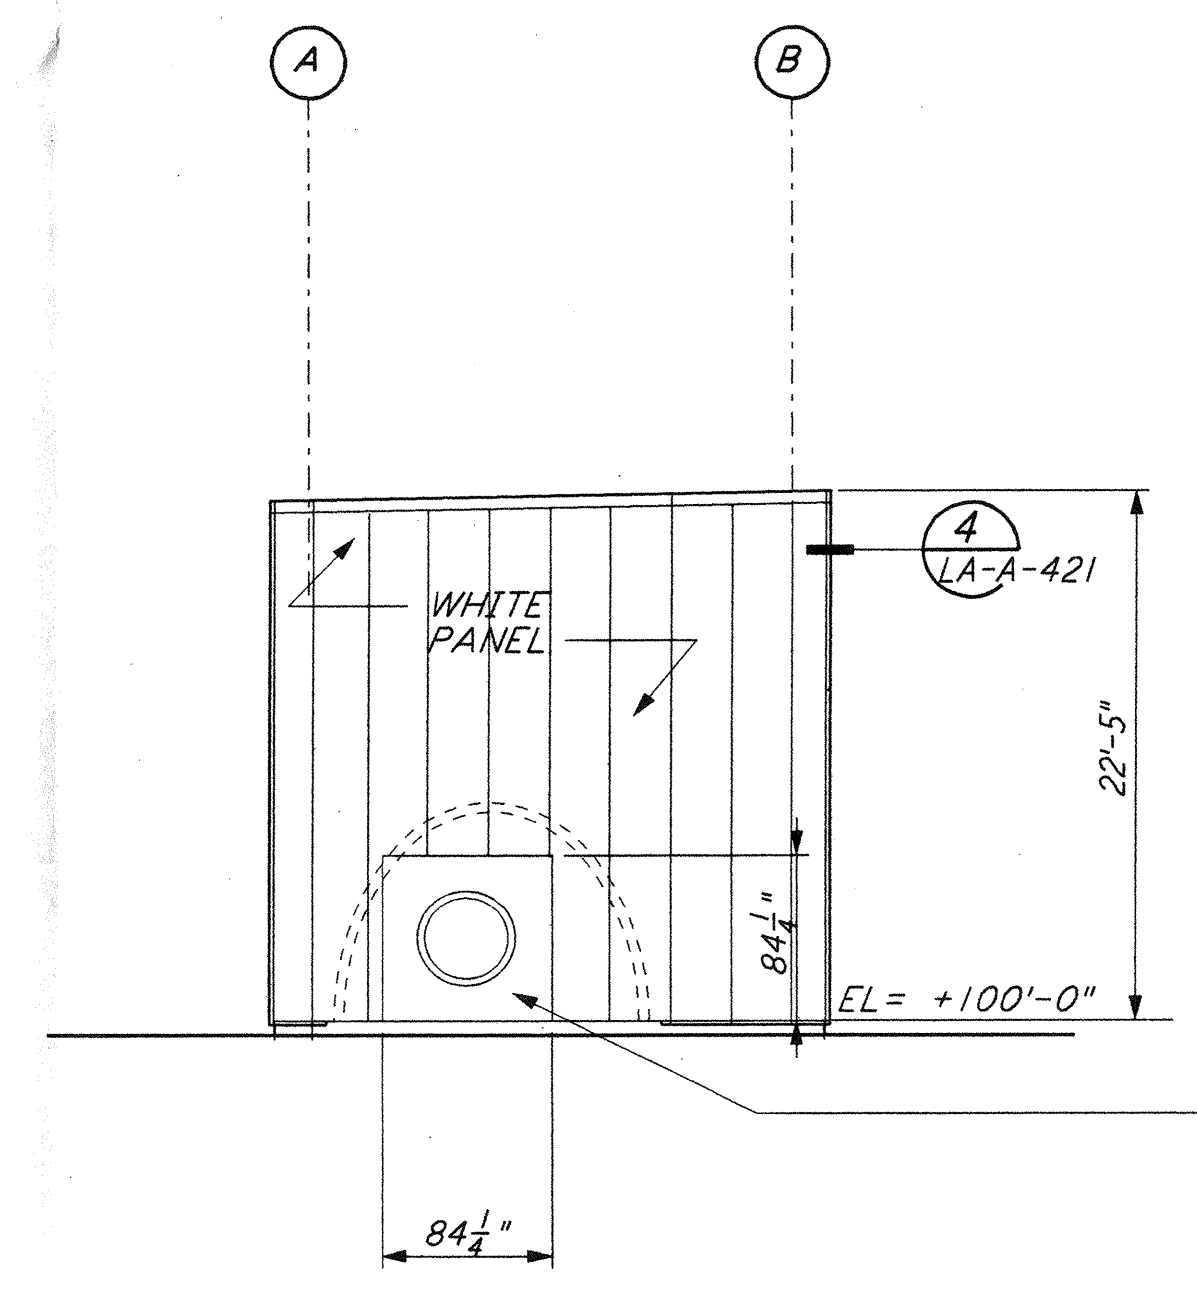


ELEVATION A-A
 1/8" = 1'-0" (4) LA-A-201

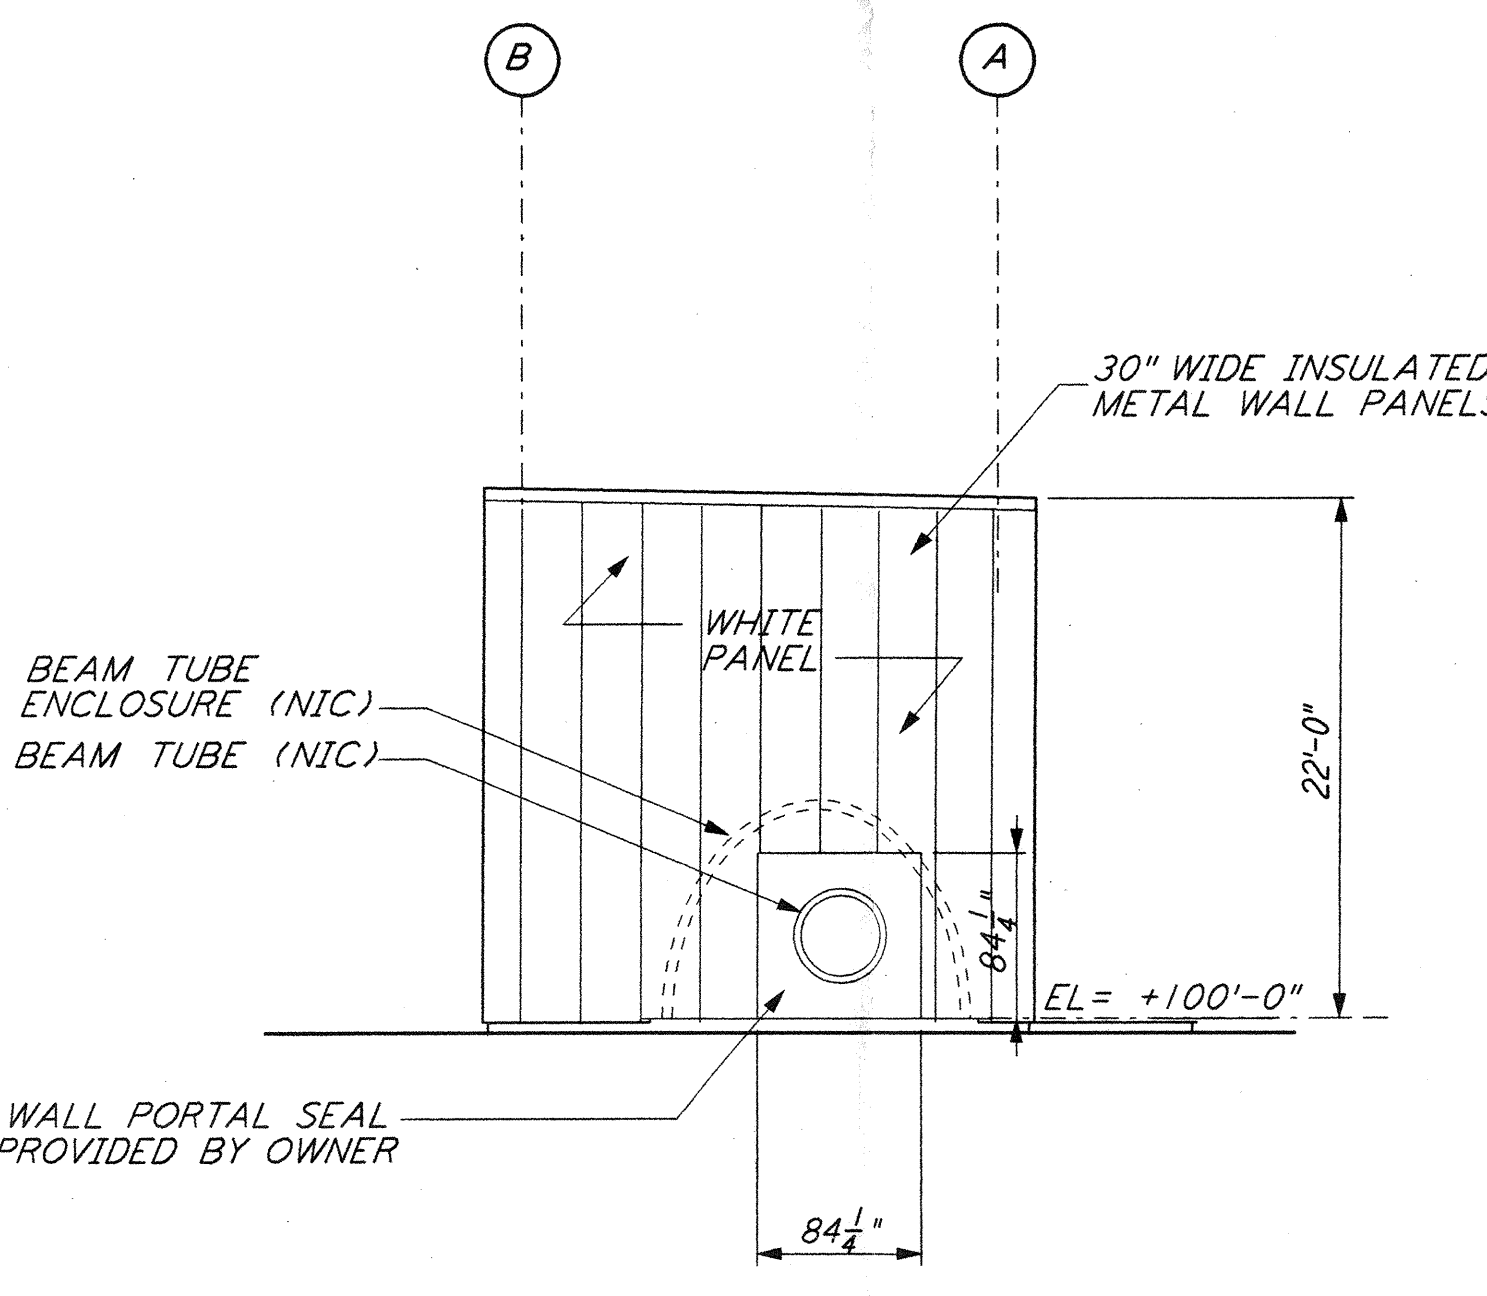


ELEVATION C-C
 1/8" = 1'-0" (3) LA-A-201

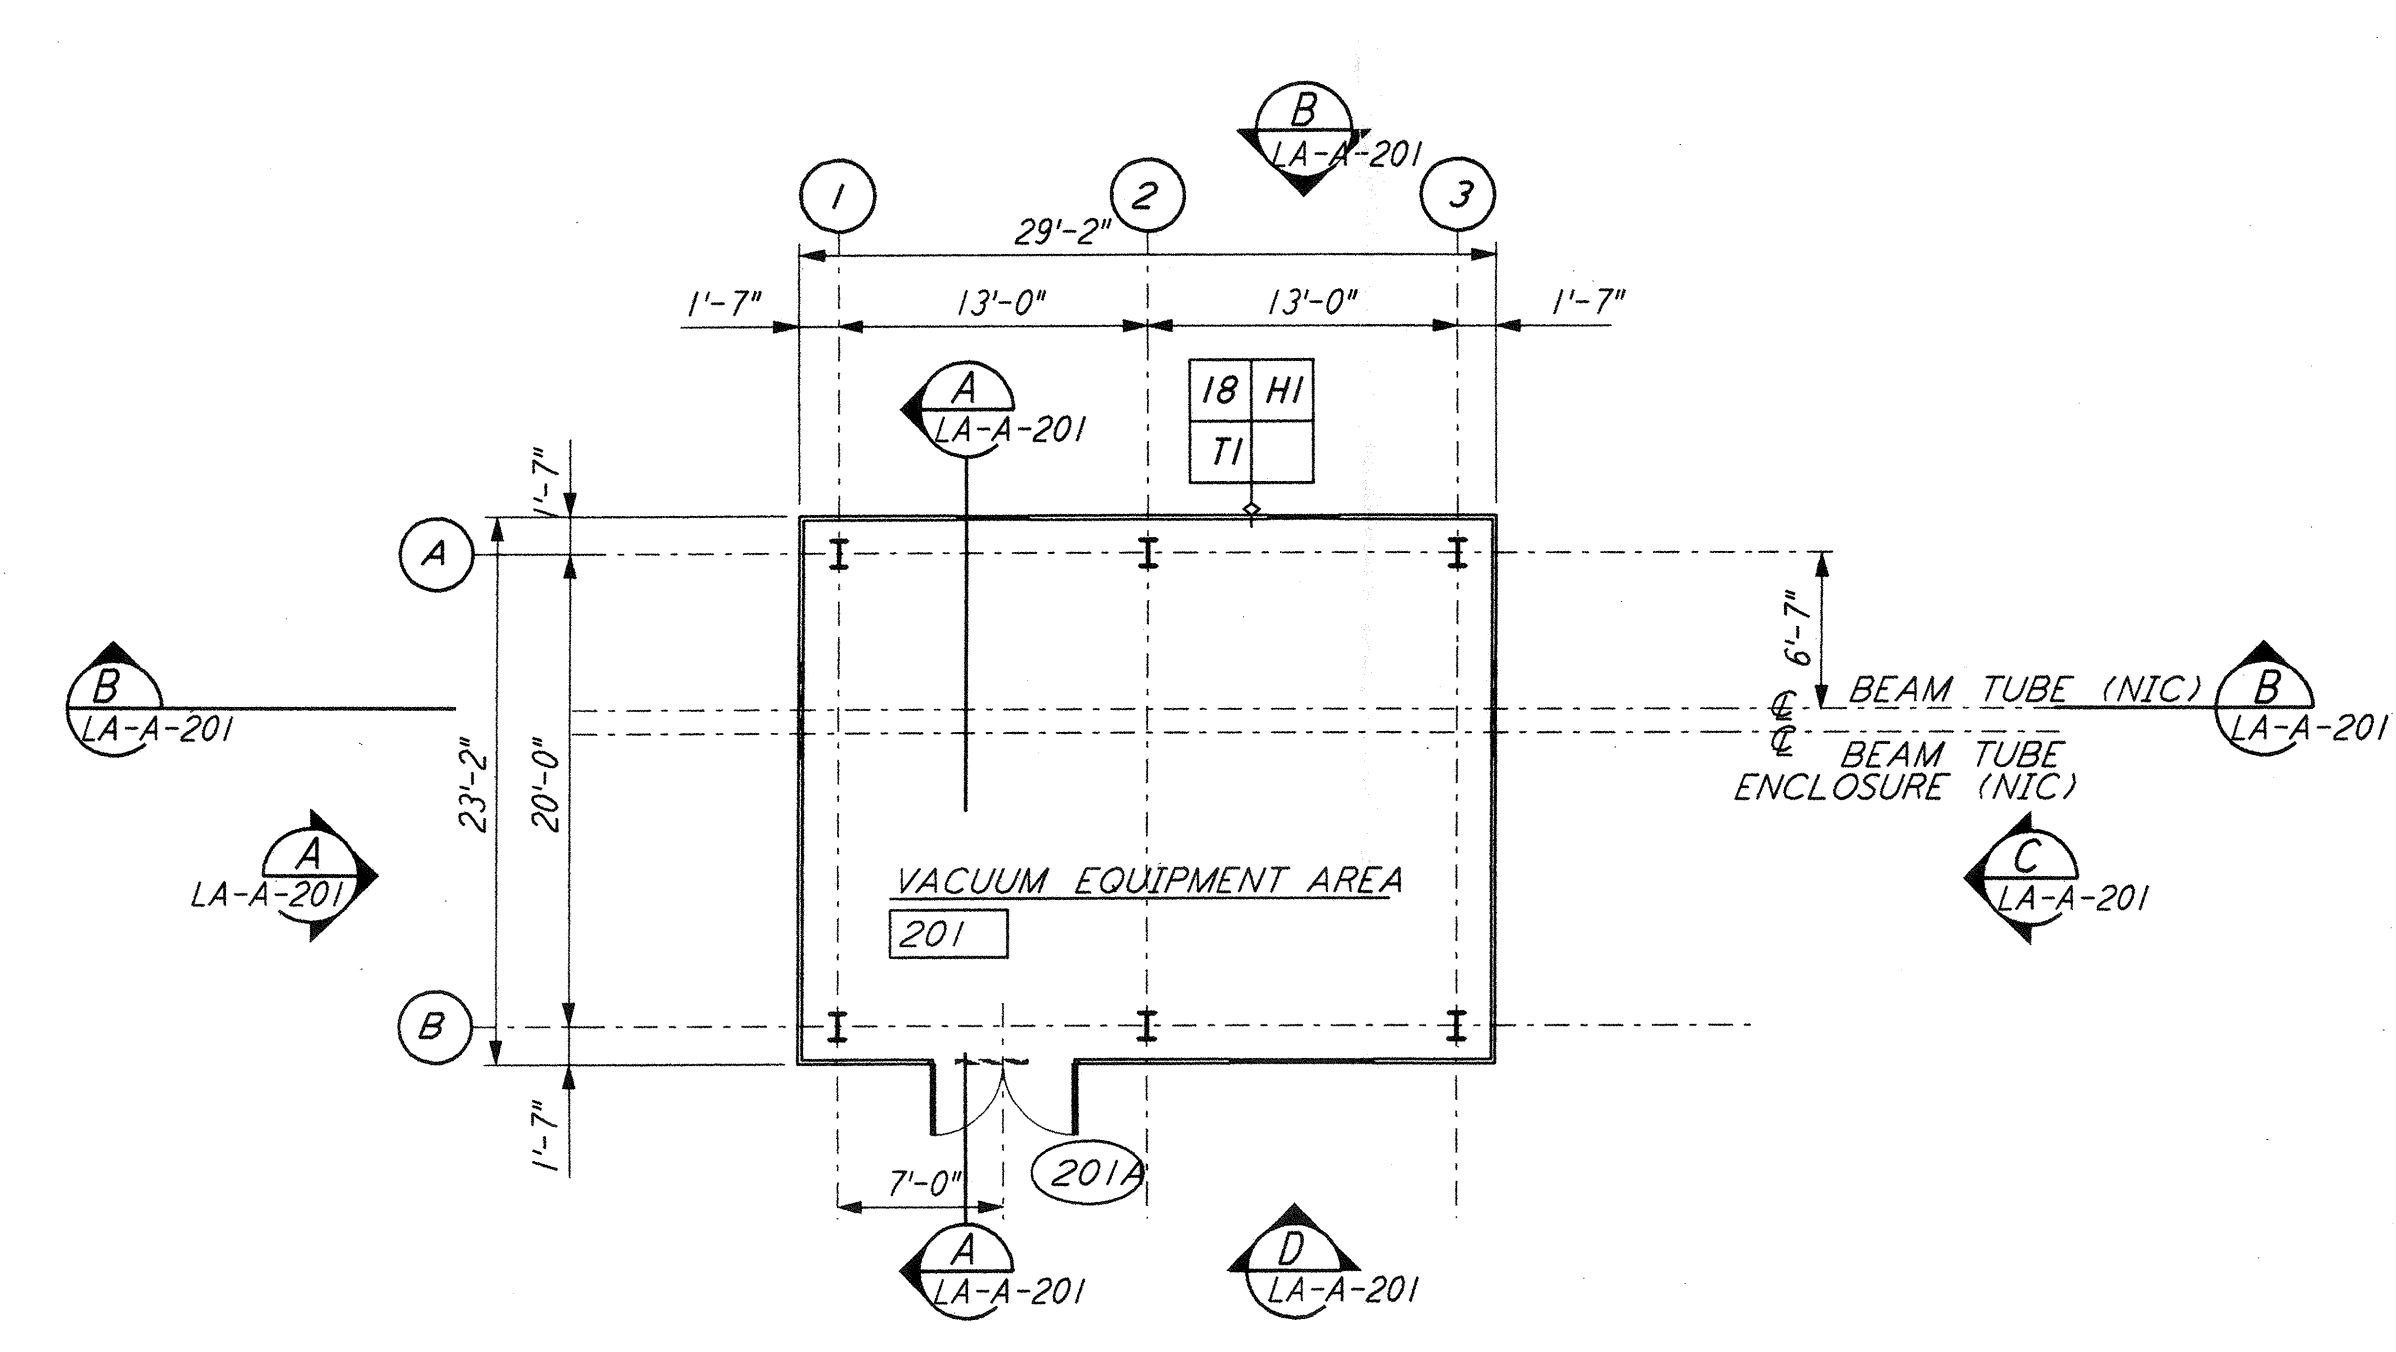


MID STATION "A" FLOOR PLAN
 1/8" = 1'-0" (2) LA-A-201

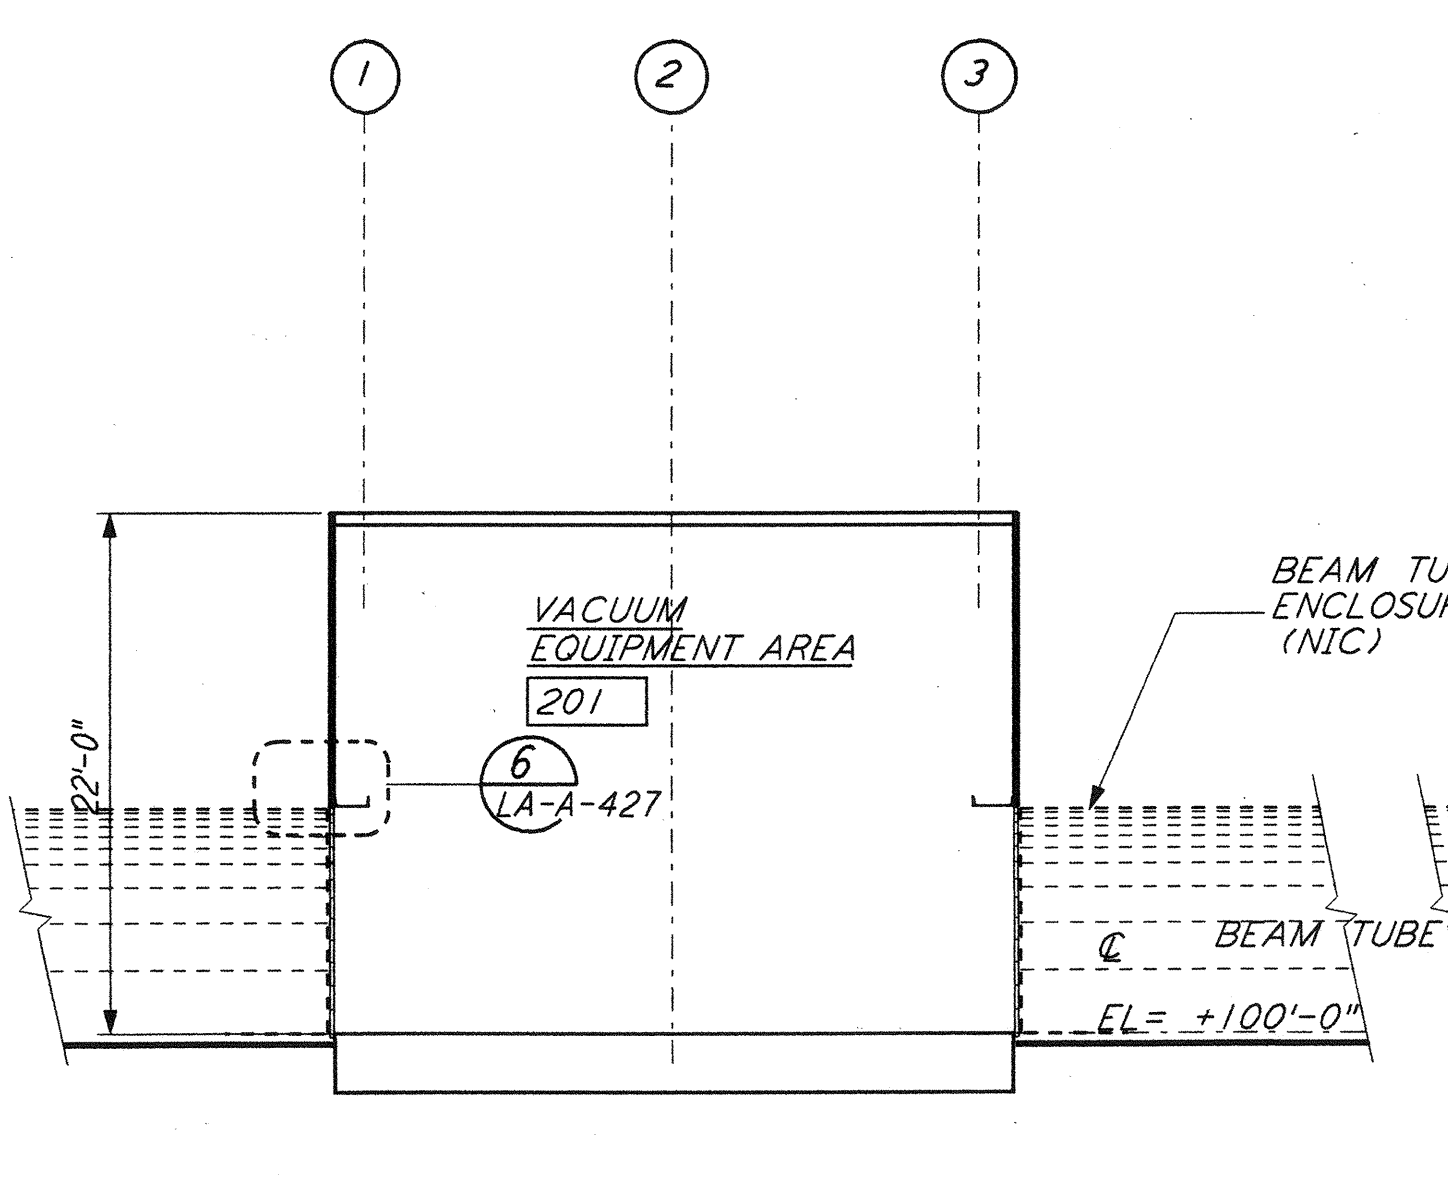


SECTION B-B
 1/8" = 1'-0" (6) LA-A-201

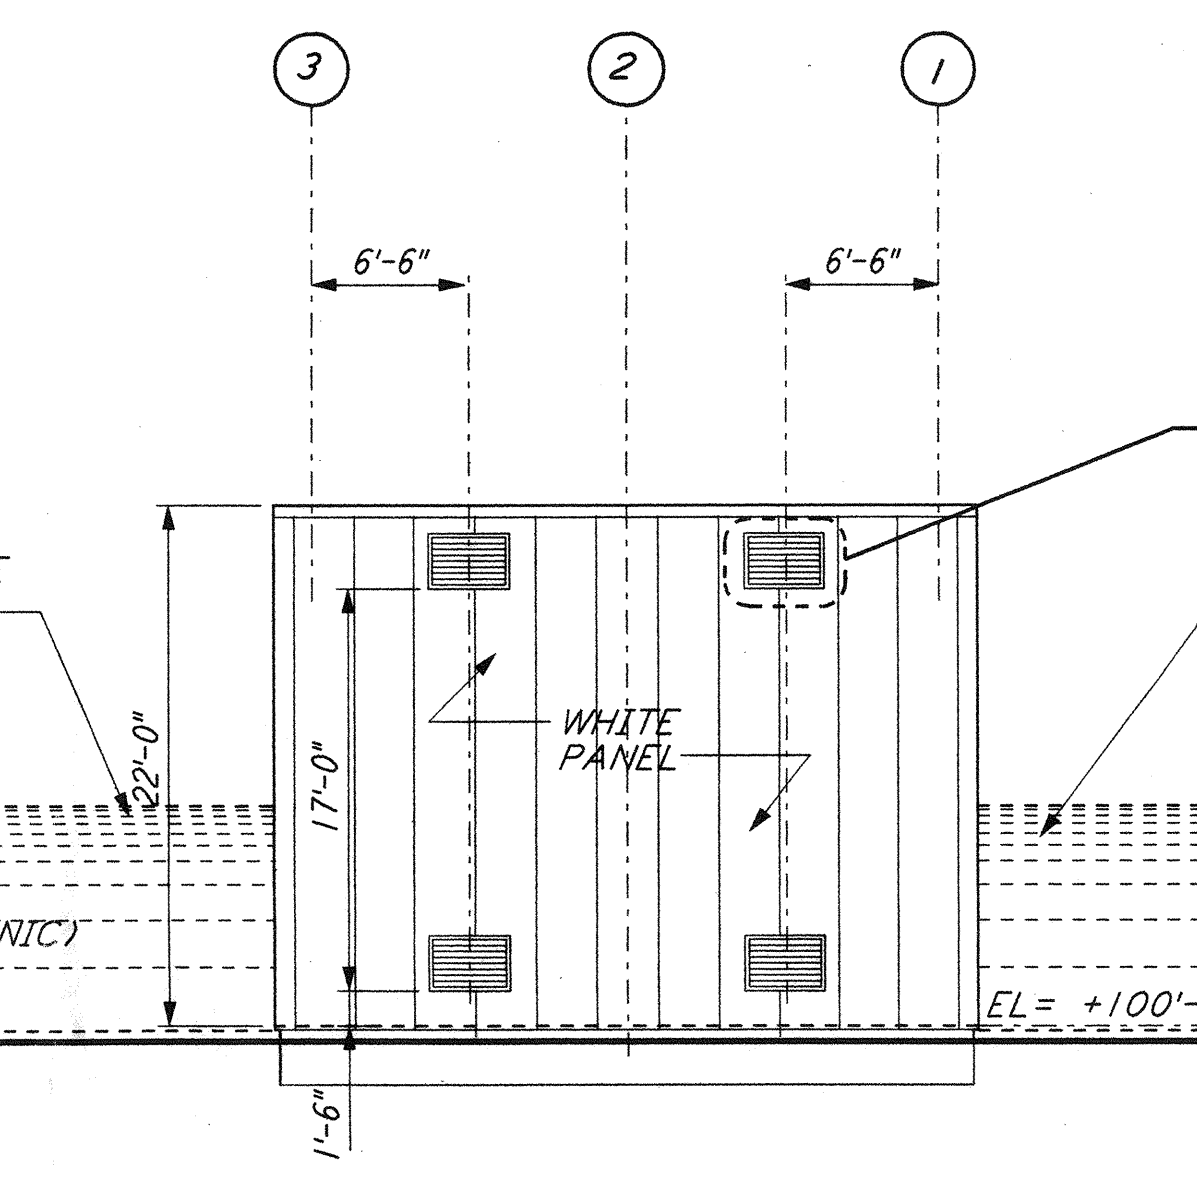


ELEVATION B-B
 1/8" = 1'-0" (5, 6, 7) LA-A-201

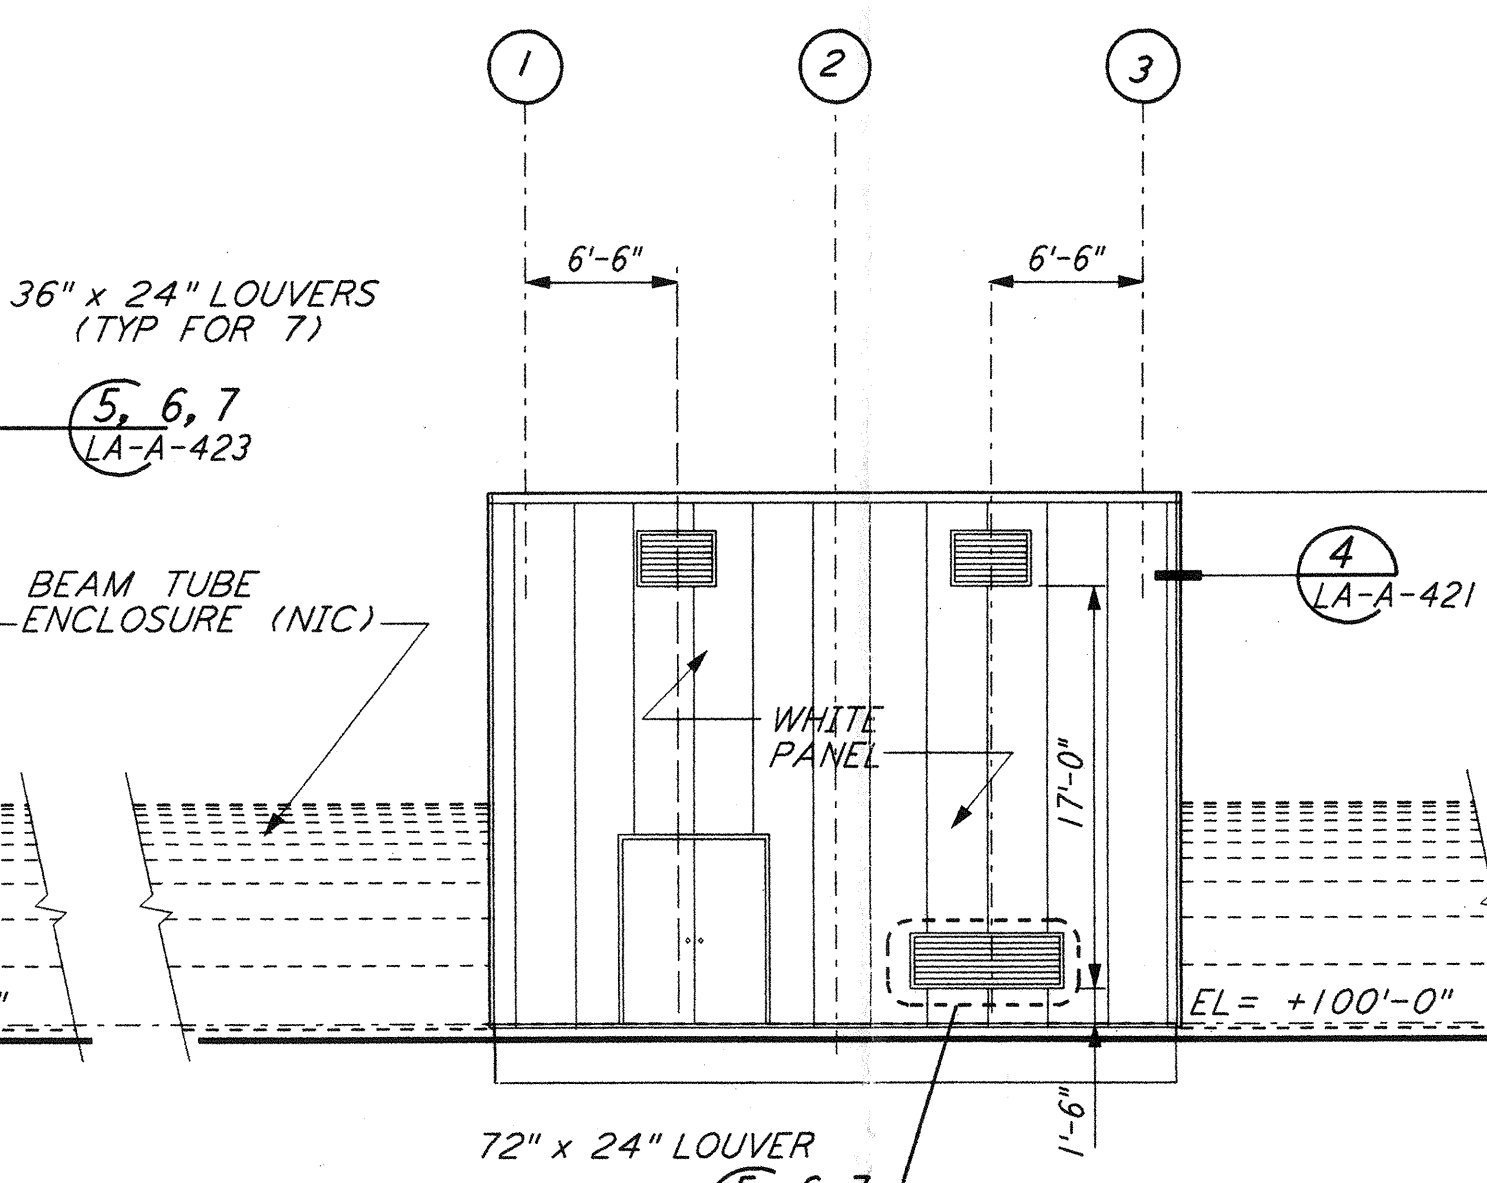


ELEVATION D-D
 1/8" = 1'-0" (4) LA-A-201

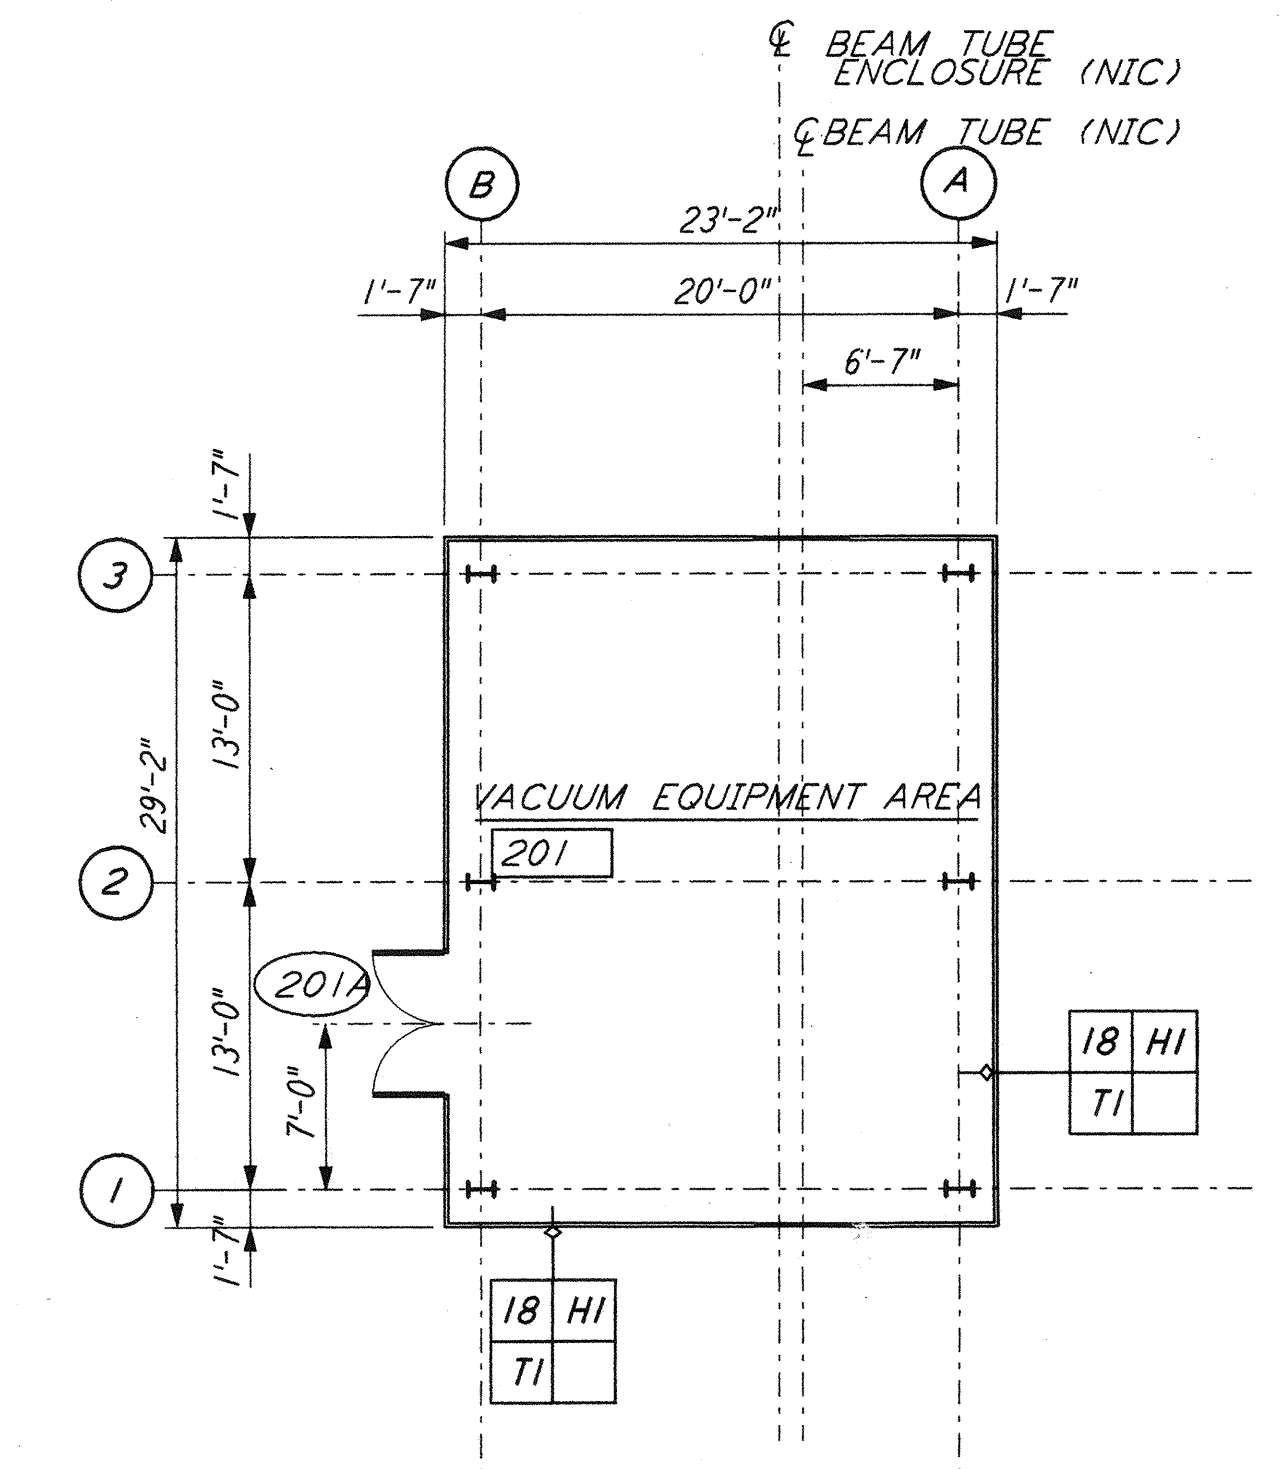

MID STATION "B" FLOOR PLAN
 1/8" = 1'-0" (3) LA-A-201

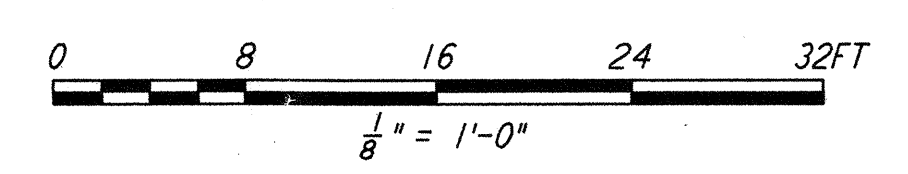

DATUM POINT EL +100.00 = 61.00' (MID STATION "B")
 DATUM POINT EL +100.00 = 63.00' (MID STATION "A")

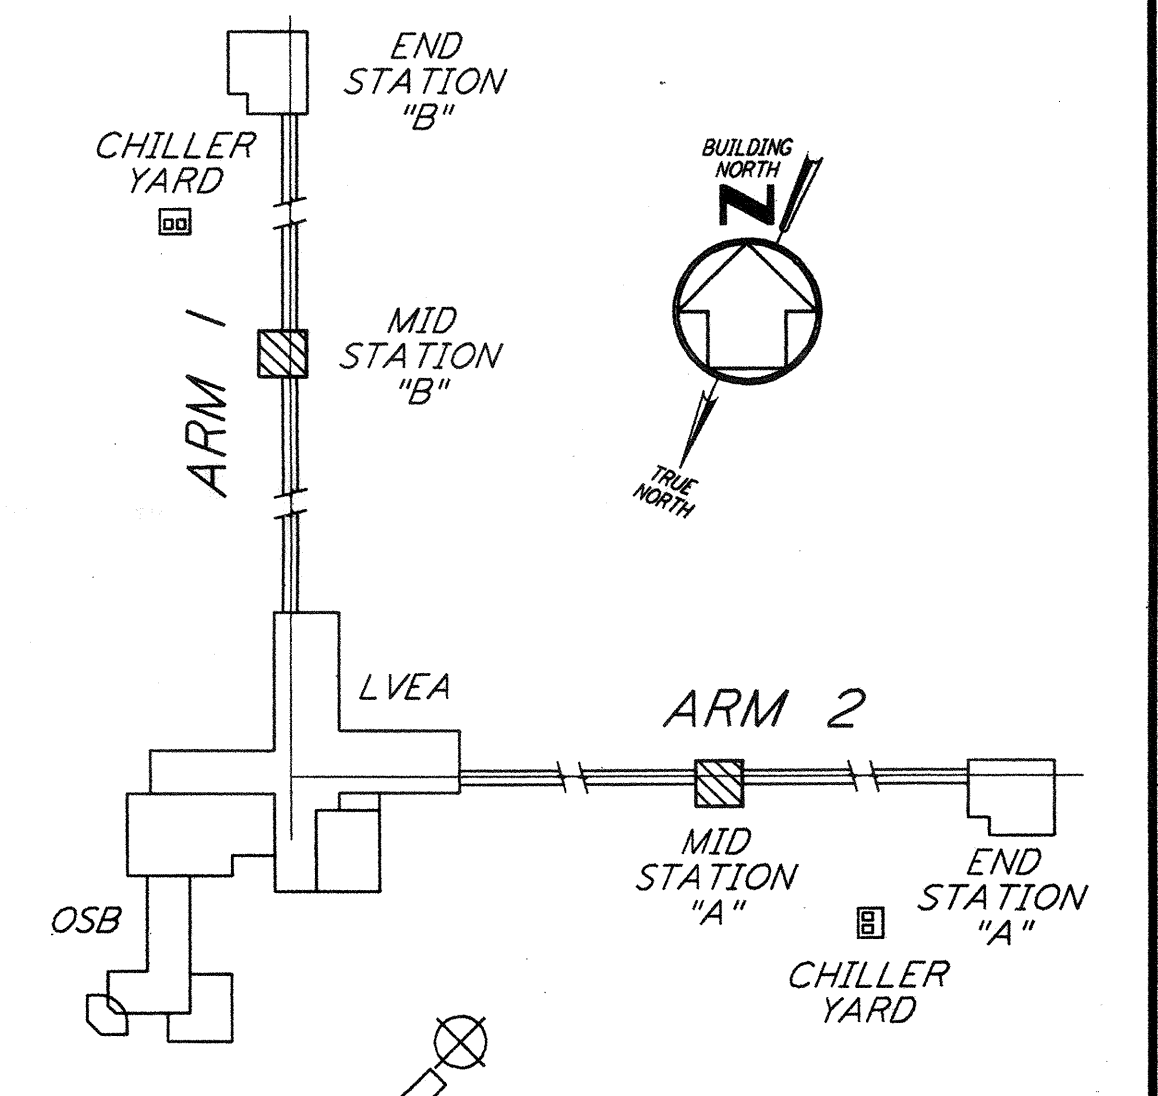

KEY PLAN
LIGO-D960892-02-0

not be reproduced, copied, loaned, exhibited, or used in any other way, except by written consent from PARSONS to the borrower.

This document and the design it covers are the property of PARSONS. They are loaned only with the borrower's expressed written agreement that they will

NO.	DATE	BY	CHKD	ENGR	PROJ	DESCRIPTION
2	08-07-98	SJM	CKT	AKK	MDW	ISSUED FOR AS-BUILT
1	2-28-97	CKT	TB	AK	TDM	MID STATION REVISION

ISSUED FOR CONSTRUCTION
DRAWN CKT 11-15-96
CHECKED TB 11-15-96
ENGINEER SF 11-15-96
PROJ MDW 11-15-96

AS-BUILT DRAWINGS

100 WEST WALNUT STREET
 PASADENA, CALIFORNIA

CALIFORNIA INSTITUTE OF TECHNOLOGY
 MASSACHUSETTS INSTITUTE OF TECHNOLOGY

LASER INTERFEROMETER GRAVITATIONAL-WAVE OBSERVATORY SITE NO. 2 - LIVINGSTON, LOUISIANA		
TITLE	SCALE	CONTRACT NUMBER
ARCHITECTURAL MID STATIONS PLANS/SECTIONS/ELEVATIONS	AS NOTED	PP150969
SHEET NUMBER	PROJECT NUMBER	8094
LA-A-201		