




MID STATION "A" / "B" REFLECTED CEILING PLAN
 1/8" = 1'-0" (LA-A-201)

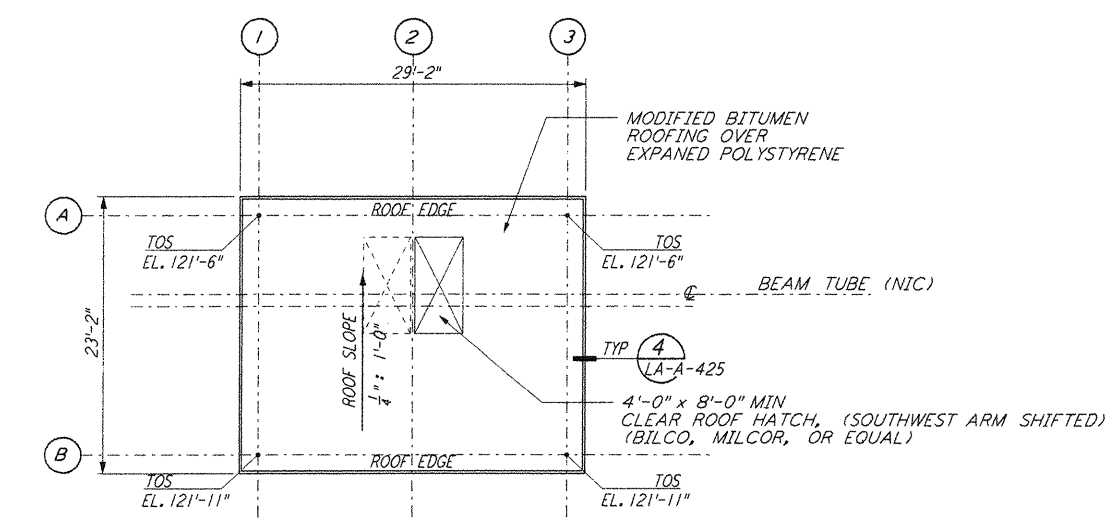


MID STATION "A" / "B" ROOF PLAN
 1/8" = 1'-0" (LA-A-201)

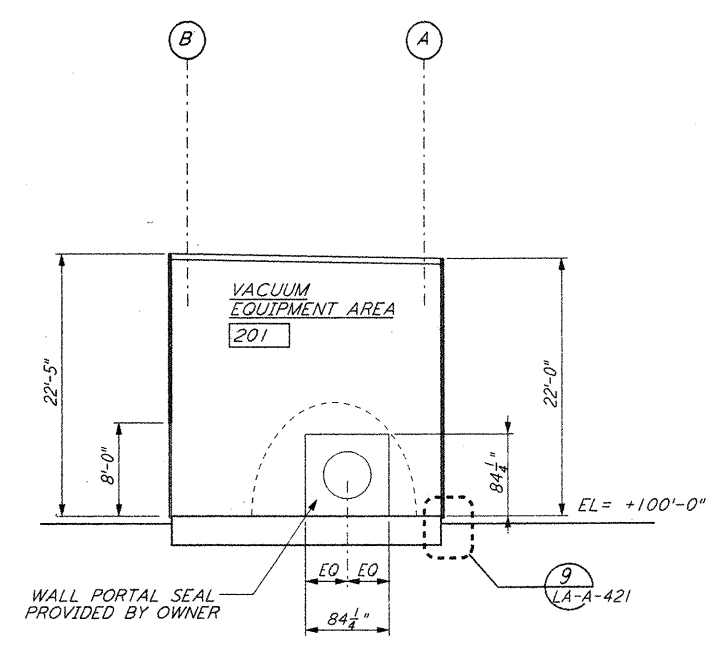


SECTION A-A
 1/8" = 1'-0" (LA-A-201)

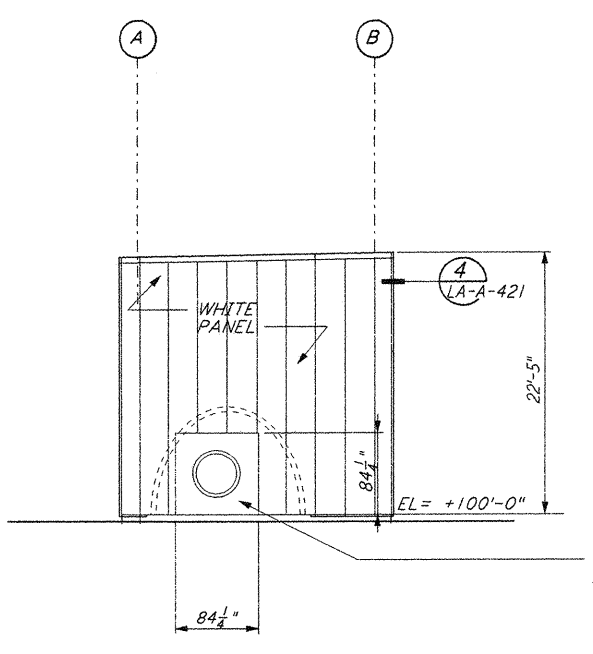


ELEVATION A-A
 1/8" = 1'-0" (LA-A-201)

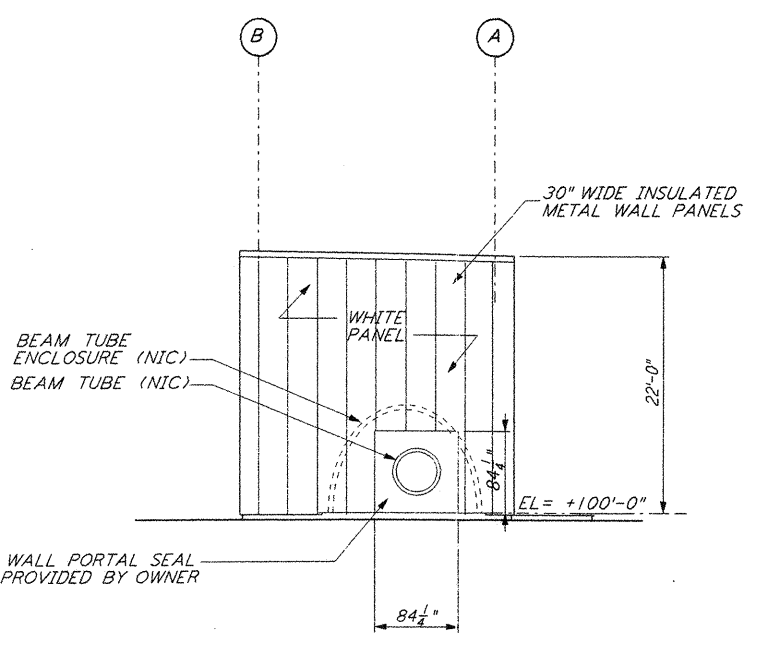


ELEVATION B-B
 1/8" = 1'-0" (LA-A-201)

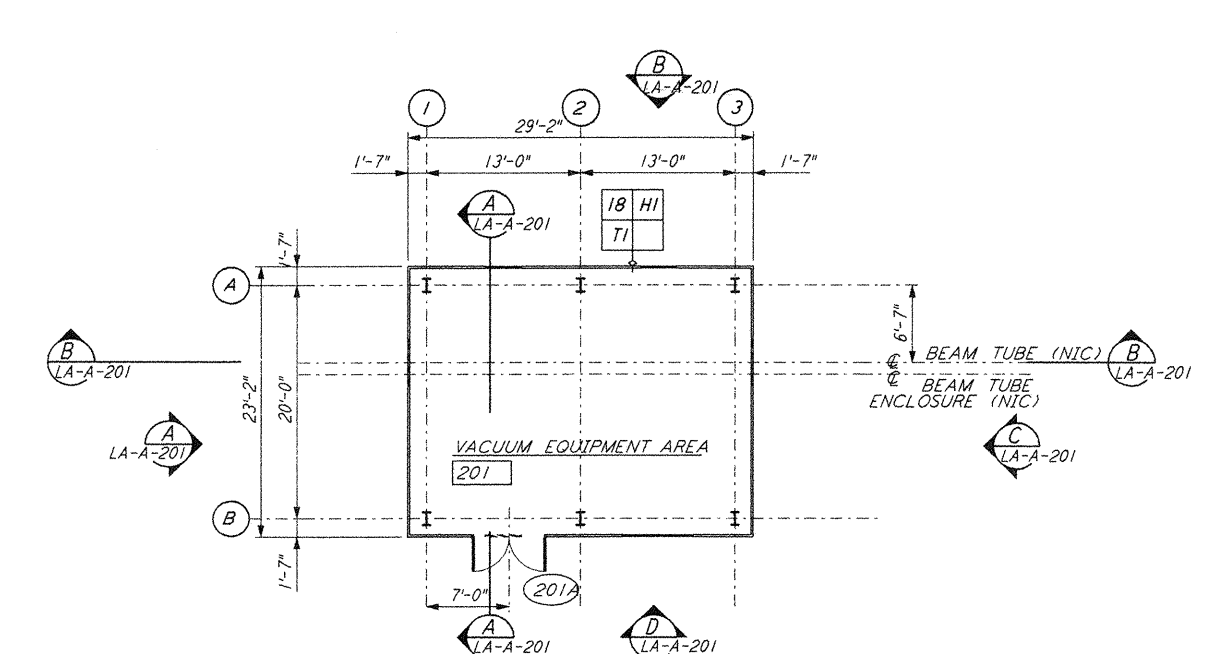


MID STATION "A" FLOOR PLAN
 1/8" = 1'-0" (LA-A-201)

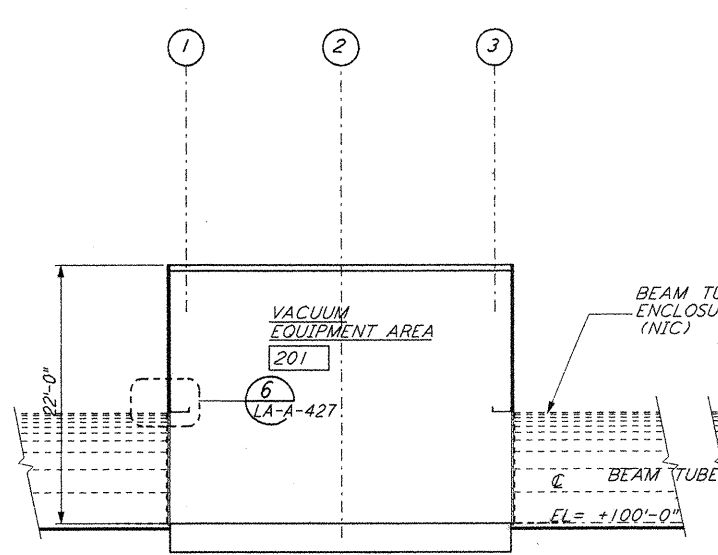


SECTION B-B
 1/8" = 1'-0" (LA-A-201)

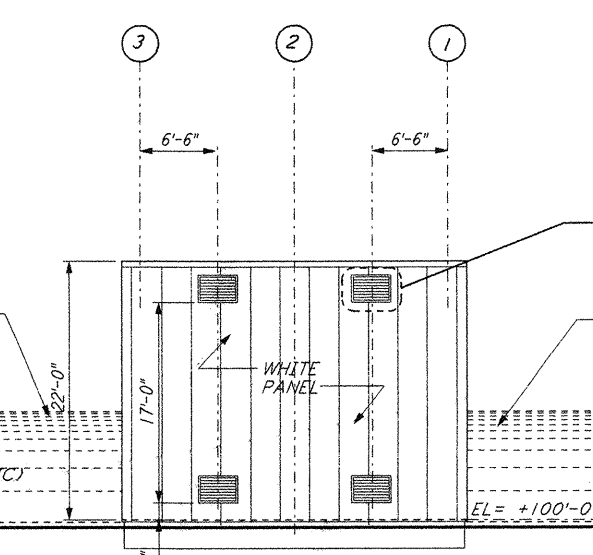


ELEVATION C-C
 1/8" = 1'-0" (LA-A-201)

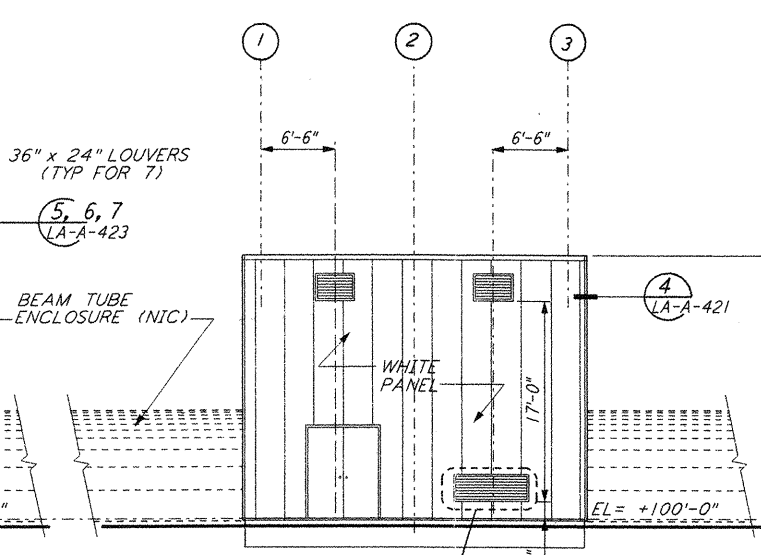

ELEVATION D-D
 1/8" = 1'-0" (LA-A-201)

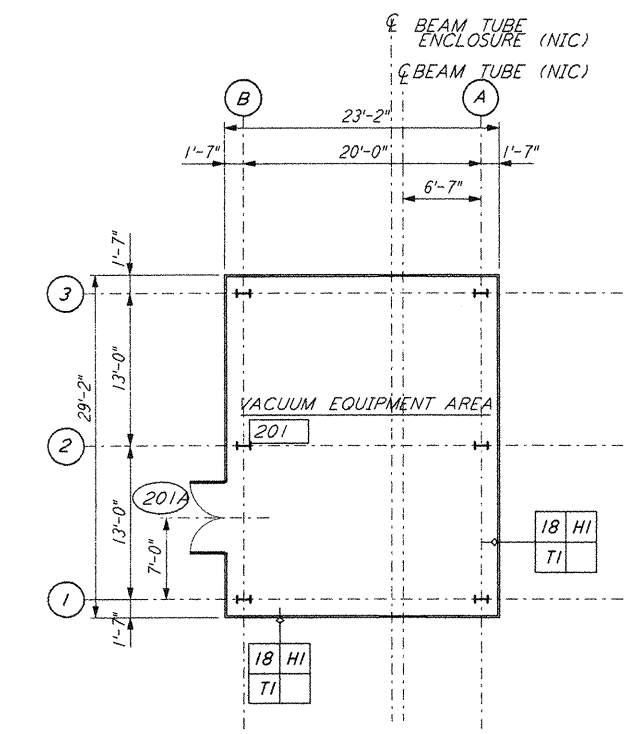

MID STATION "B" FLOOR PLAN
 1/8" = 1'-0" (LA-A-201)

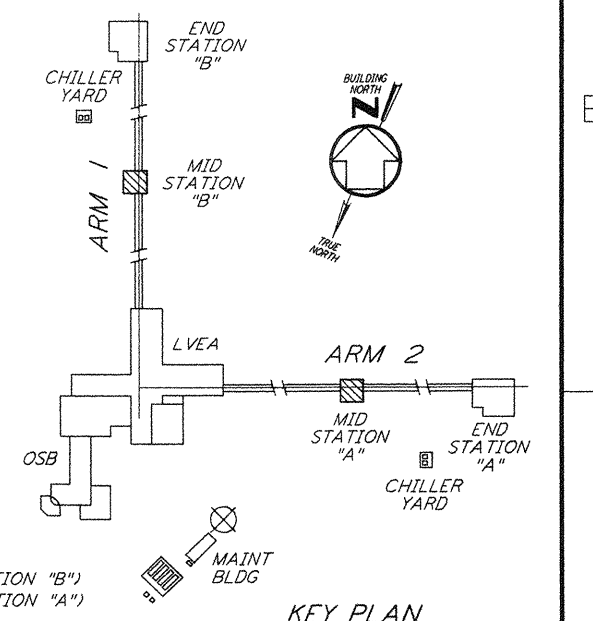

KEY PLAN
LIGO-D960892-02-0

DATUM POINT EL +100.00 = 61.00' (MID STATION "B")
 DATUM POINT EL +100.00 = 63.00' (MID STATION "A")

not be reproduced, copied, loaned, exhibited, or used in any other way, except by written consent from PARSONS to the borrower.

This document and the design it covers are the property of PARSONS. They are loaned only with the borrower's expressed written agreement that they will

NO.	DATE	BY	CHKD	ENGR	PROJ	DESCRIPTION
1	2-28-97	CKT	TB	AK	TOM	MID STATION REVISION
2	08-07-98	SJM	CKT	AKL	YUN	ISSUED FOR AS-BUILT

ISSUED FOR CONSTRUCTION	
DRAWN	CKT 11-15-96
CHECKED	TB 11-15-96
ENGINEER	SF 11-15-96
PROJ	MDW 11-15-96
AS-BUILT DRAWINGS	

PARSONS
 100 WEST WALNUT STREET
 PASADENA, CALIFORNIA

LIGO
 CALIFORNIA INSTITUTE OF TECHNOLOGY
 MASSACHUSETTS INSTITUTE OF TECHNOLOGY

LASER INTERFEROMETER
 GRAVITATIONAL-WAVE OBSERVATORY
 SITE NO. 2 - LIVINGSTON, LOUISIANA

TITLE	SCALE	CONTRACT NUMBER	PROJECT NUMBER
ARCHITECTURAL MID STATIONS PLANS/SECTIONS/ELEVATIONS	AS NOTED	PP150969	8094
SHEET NUMBER		REVISIONS	
LA-A-201			