


This document and the design it covers are the property of PARSONS. They are loaned only with the borrower's expressed written agreement that they will not be reproduced, copied, loaned, exhibited, or used in any other way, except by written consent from PARSONS to the borrower.

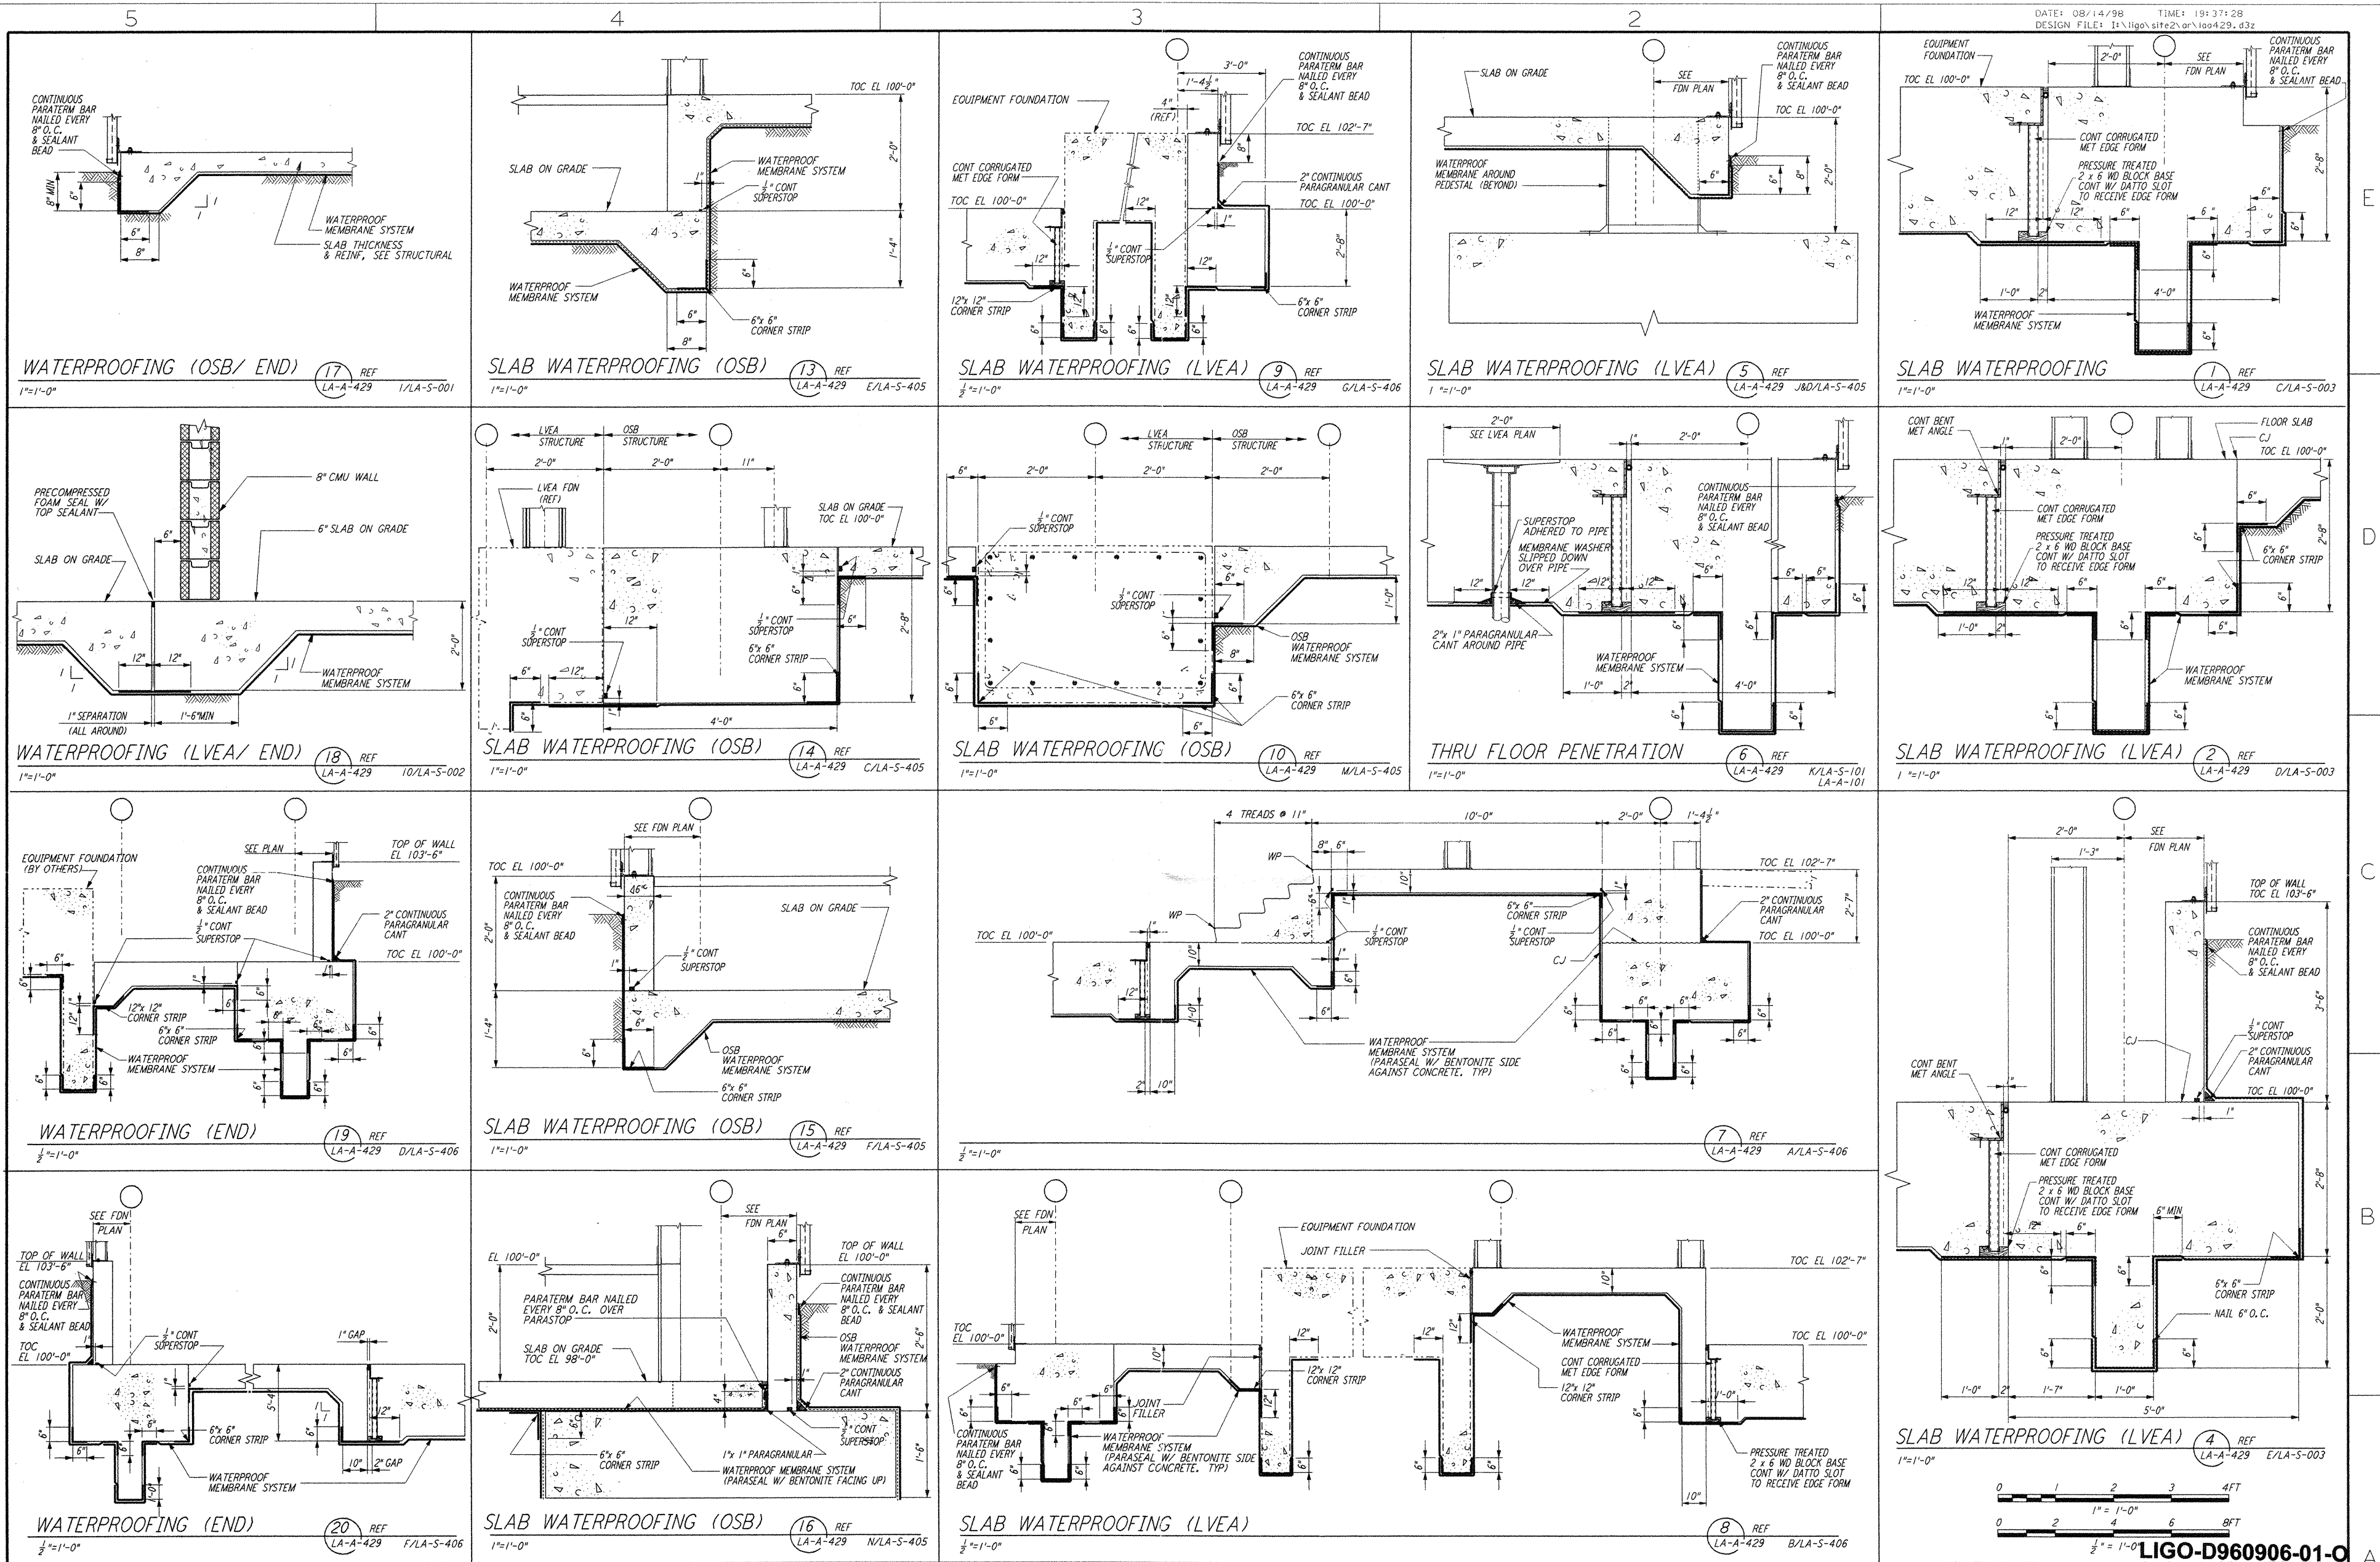


NO.	DATE	BY	CHKD	ENGR	PROJ	DESCRIPTION
1	08-07-98	SJM	CAK	WLD		ISSUED FOR AS-BUILT

NO.	DATE	BY	CHKD	ENGR	PROJ	DESCRIPTION
1	08-07-98	SJM	CAK	WLD		ISSUED FOR AS-BUILT

ISSUED FOR CONSTRUCTION  
 DRAWN CKT 11-15-96  
 CHECKED TB 11-15-96  
 ENGINEER SF 11-15-96  
 PROJ TOM 11-15-96

**AS-BUILT DRAWINGS**

100 WEST WALNUT STREET  
 PASADENA, CALIFORNIA

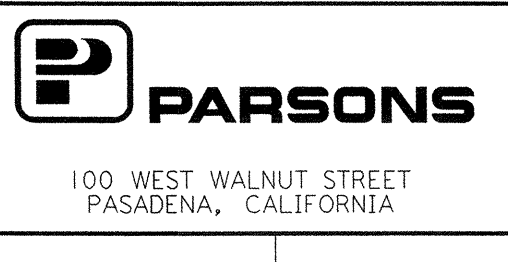

LASER INTERFEROMETER GRAVITATIONAL-WAVE OBSERVATORY SITE NO. 2 - LIVINGSTON, LOUISIANA	
TITLE	SCALE
ARCHITECTURAL SLAB WATERPROOFING SYSTEM	PPI50969 8094
SHEET NUMBER	REVISION
<b>LA-A-429</b>	