
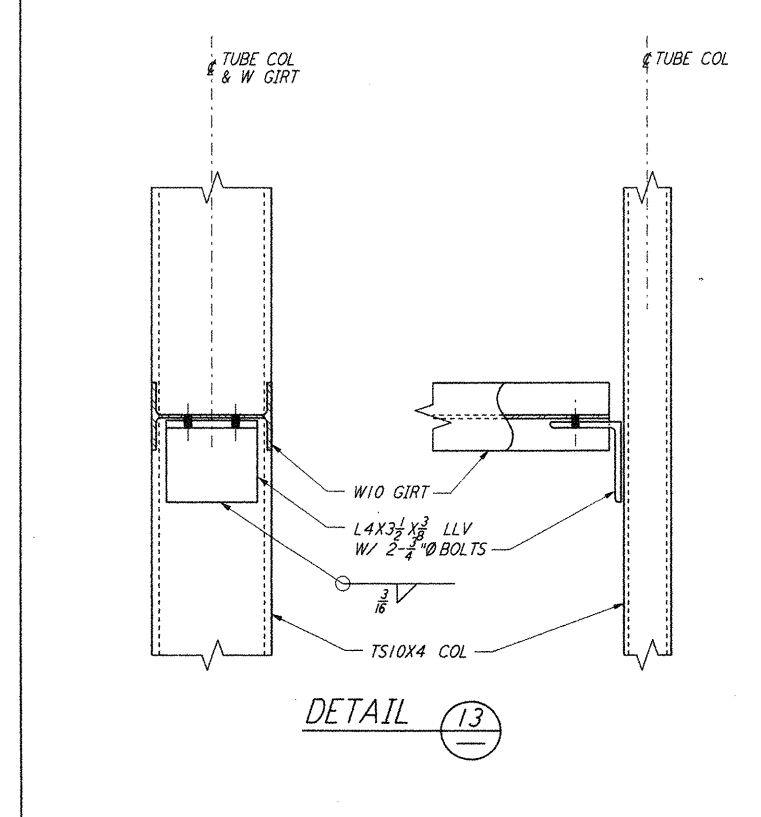
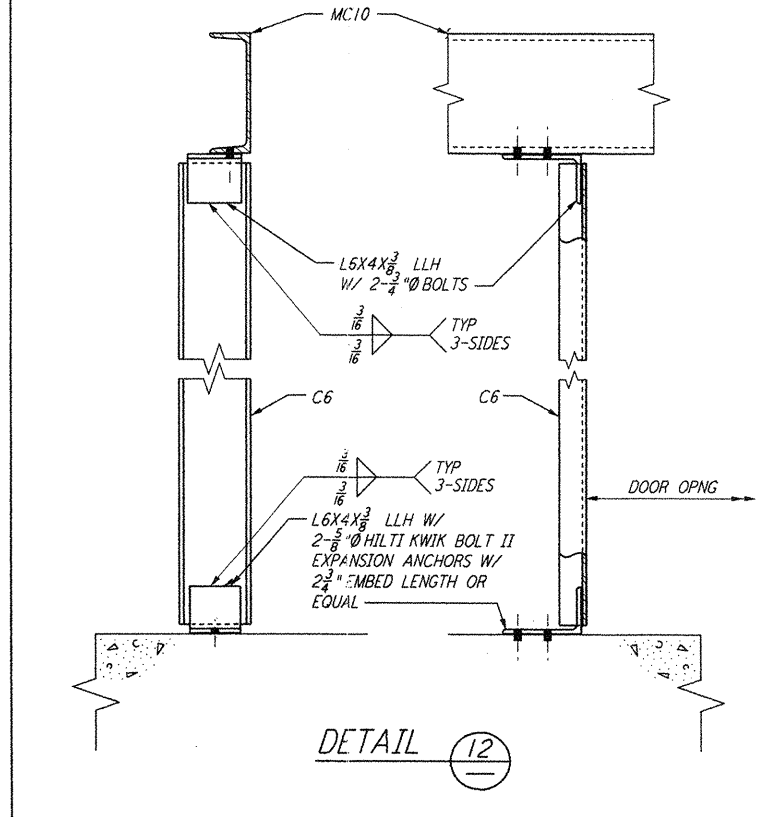


BUILDING ID	DOOR ID	DIMENSION "A"	FROM GRID (X)	TOWARD GRID (Y)
LVEA	101B	7 1/2"	7	8
OSB	170A	9'-9 1/2"	K.3	L.3
OSB	171B	6 1/2"	11.3	12.3
OSB	172B	6 1/2"	11.3	12.3
OSB	173B	3 1/2"	M.3	L.3
END STATION	205A	4 1/2"	C	D
END STATION	205B	8 1/2"	B	A

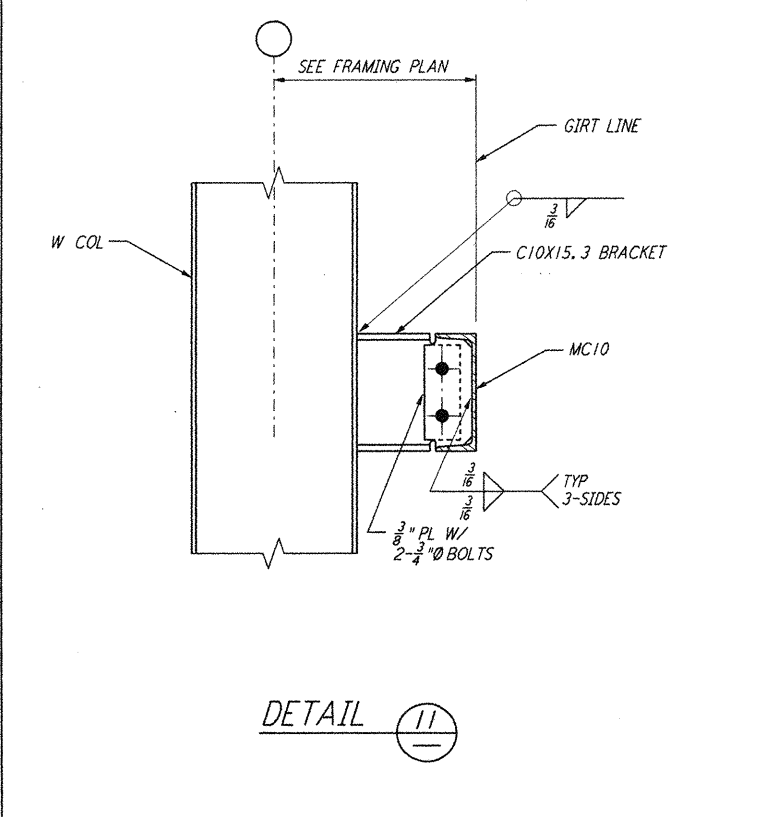

**NOTE:**  
 1. FOR GENERAL NOTES, ABBREVIATIONS AND SYMBOLS SEE DRAWING LA-S-001.

NO.	DATE	BY	CHKD	ENGR	PROJ	DESCRIPTION
1	08-07-98	WA	DDM	DDM	DDM	ISSUED FOR AS-BUILT

ISSUED FOR CONSTRUCTION  
 DRAWN MCS 11-15-96  
 CHECKED DDM 11-15-96  
 ENGINEER BP 11-15-96  
 PROJ TDM 11-15-96

**AS-BUILT DRAWINGS**

**PARSONS**  
 100 WEST WALNUT STREET  
 PASADENA, CALIFORNIA

**LIGO**  
 CALIFORNIA INSTITUTE OF TECHNOLOGY  
 MASSACHUSETTS INSTITUTE OF TECHNOLOGY

**LIGO-D960913-01-O**

LASER INTERFEROMETER  
 GRAVITATIONAL-WAVE OBSERVATORY  
 SITE NO.2 - LIVINGSTON, LOUISIANA

TITLE: STRUCTURAL STANDARD STRUCTURAL STEEL CONNECTION DETAILS SHEET 4  
 SCALE: NONE  
 CONTRACT NUMBER: PPI50969  
 PRODUCT NUMBER: 8094  
 SHEET NUMBER: LA-S-007

This document and the design it covers are the property of PARSONS. They are loaned only with the borrower's expressed written agreement that they will not be reproduced, copied, loaned, exhibited, or used in any other way, except by written consent from PARSONS to the borrower.

The Aug 13 13:23:51 1998 C:\PLOT\QUE\53-V3882.DWG 52095 K:\V3882-11807.prf LIGOLAF.BDR