




This document and the design it covers are the property of PARSONS. They are loaned only with the borrower's expressed written agreement that they will not be reproduced, copied, loaned, exhibited, or used in any other way, except by written consent from PARSONS to the borrower.

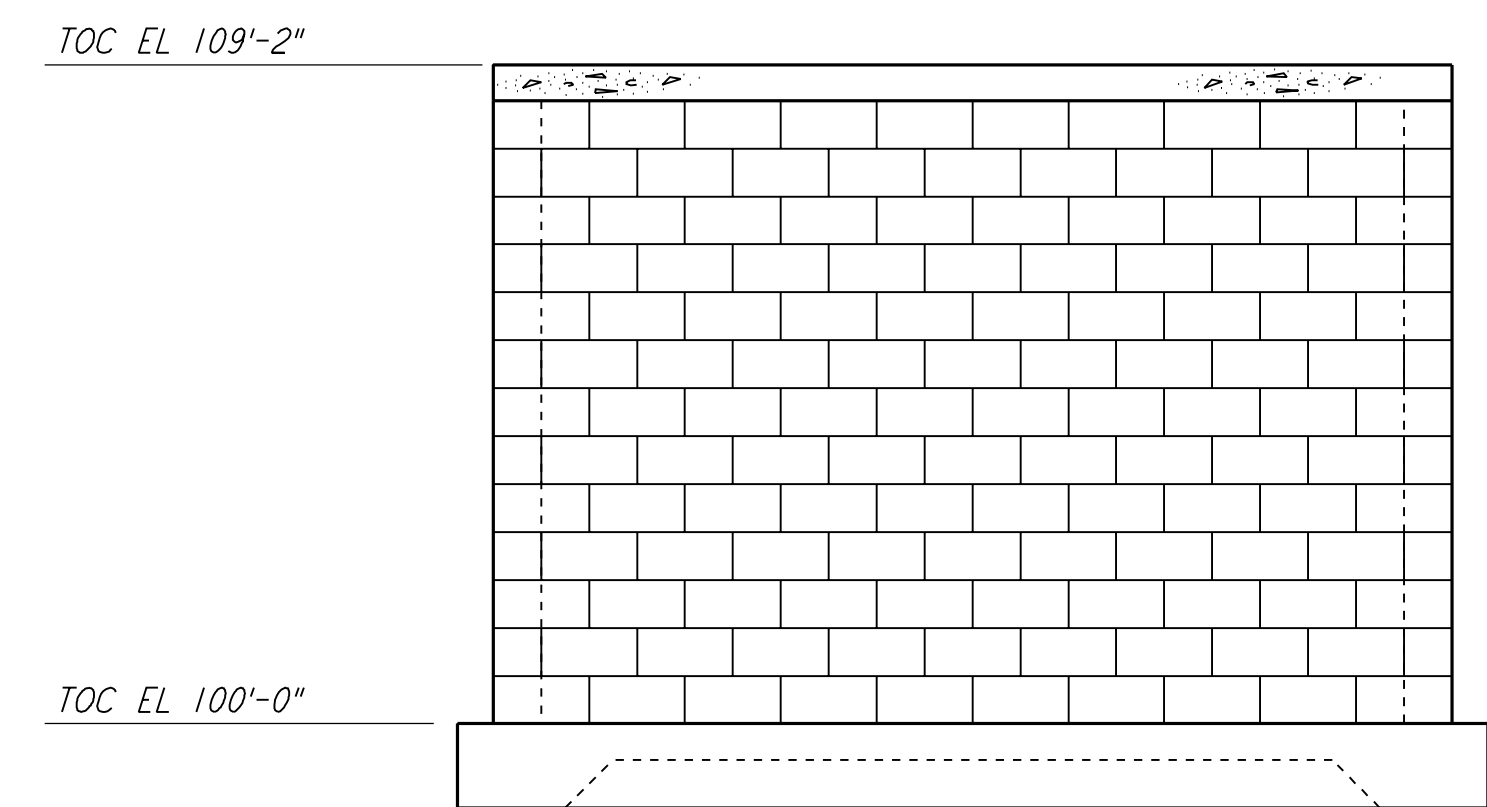


ELEVATION A REF
 $\frac{3}{8}'' = 1'-0''$
 LA-S-303 LA-S-302

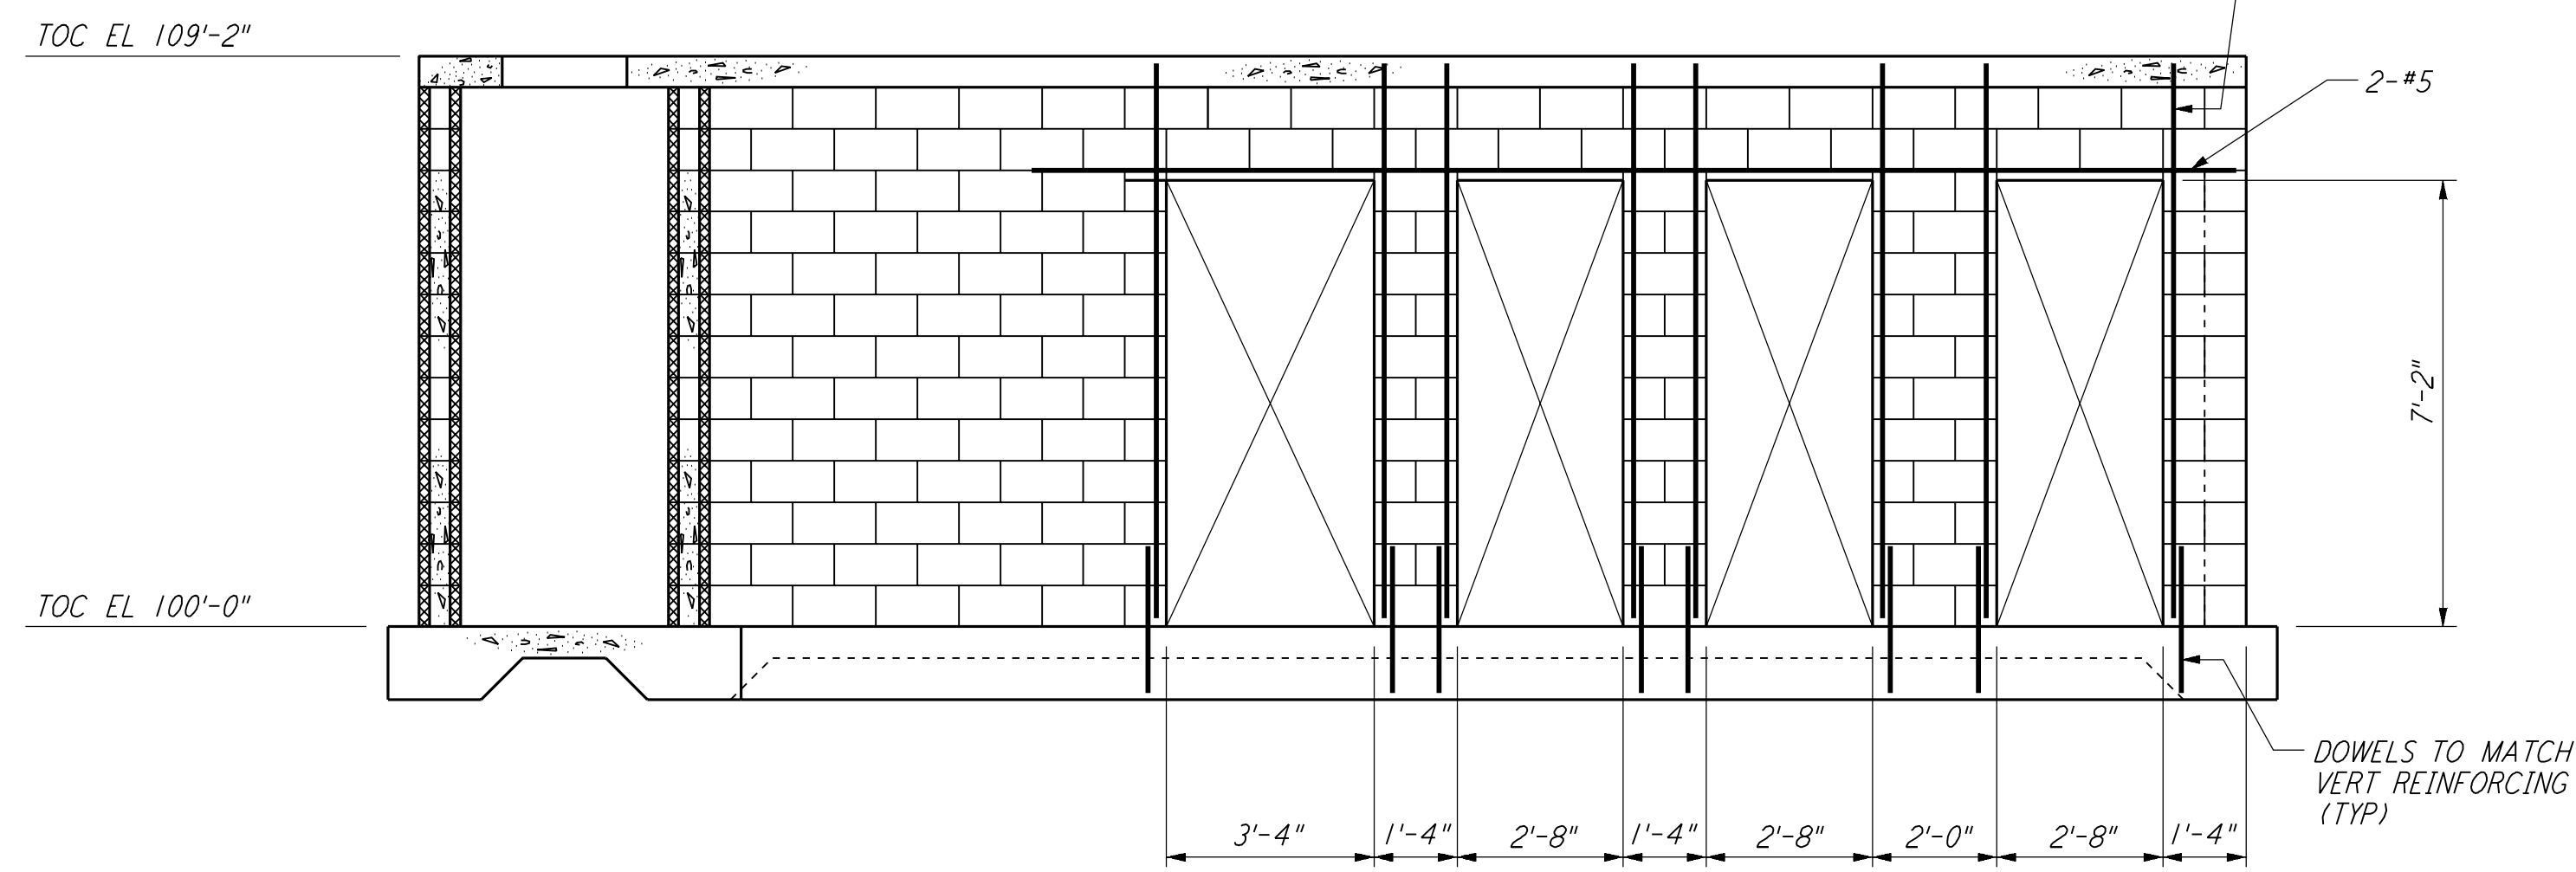


ELEVATION B REF
 $\frac{3}{8}'' = 1'-0''$
 LA-S-303 LA-S-302

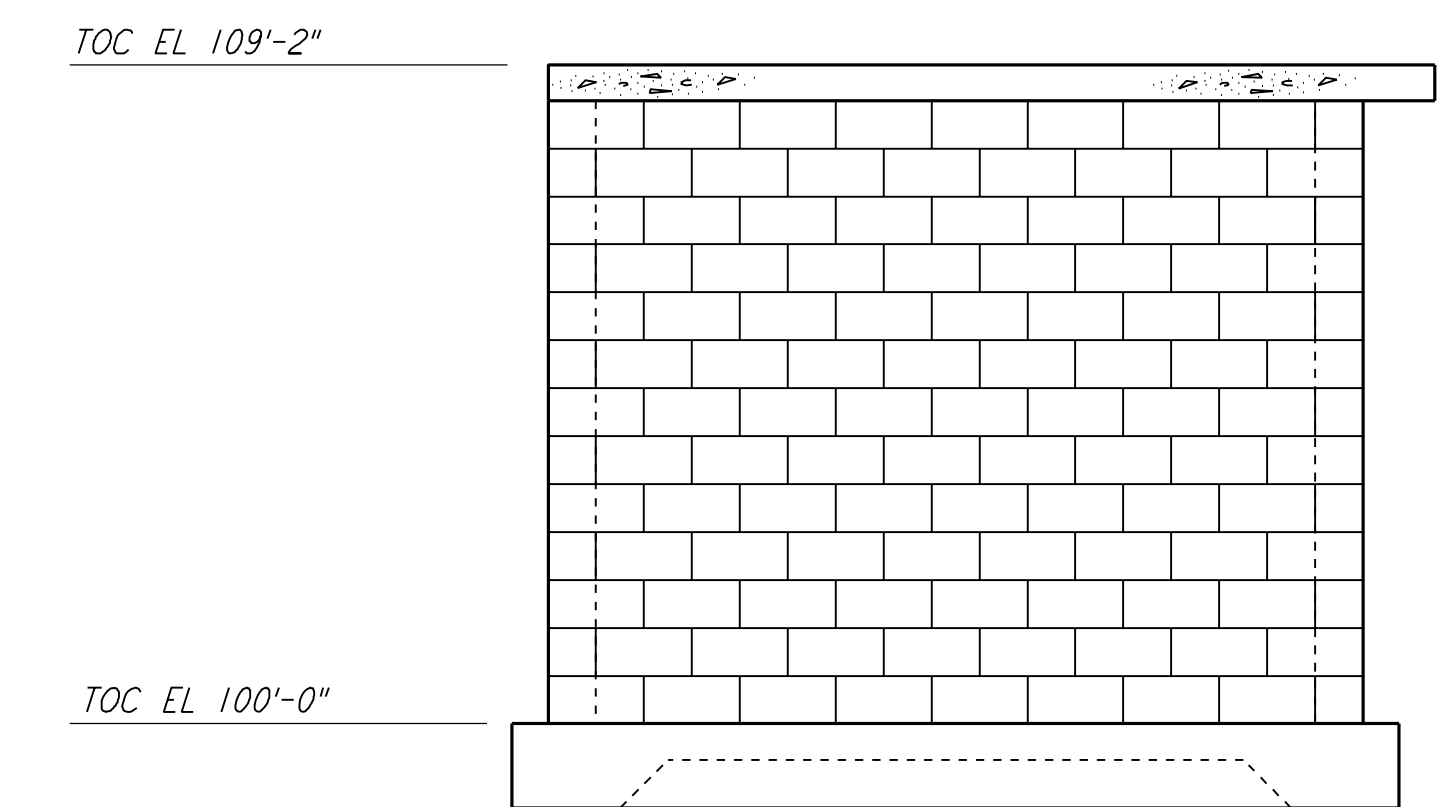


ELEVATION C REF
 $\frac{3}{8}'' = 1'-0''$
 LA-S-303 LA-S-302

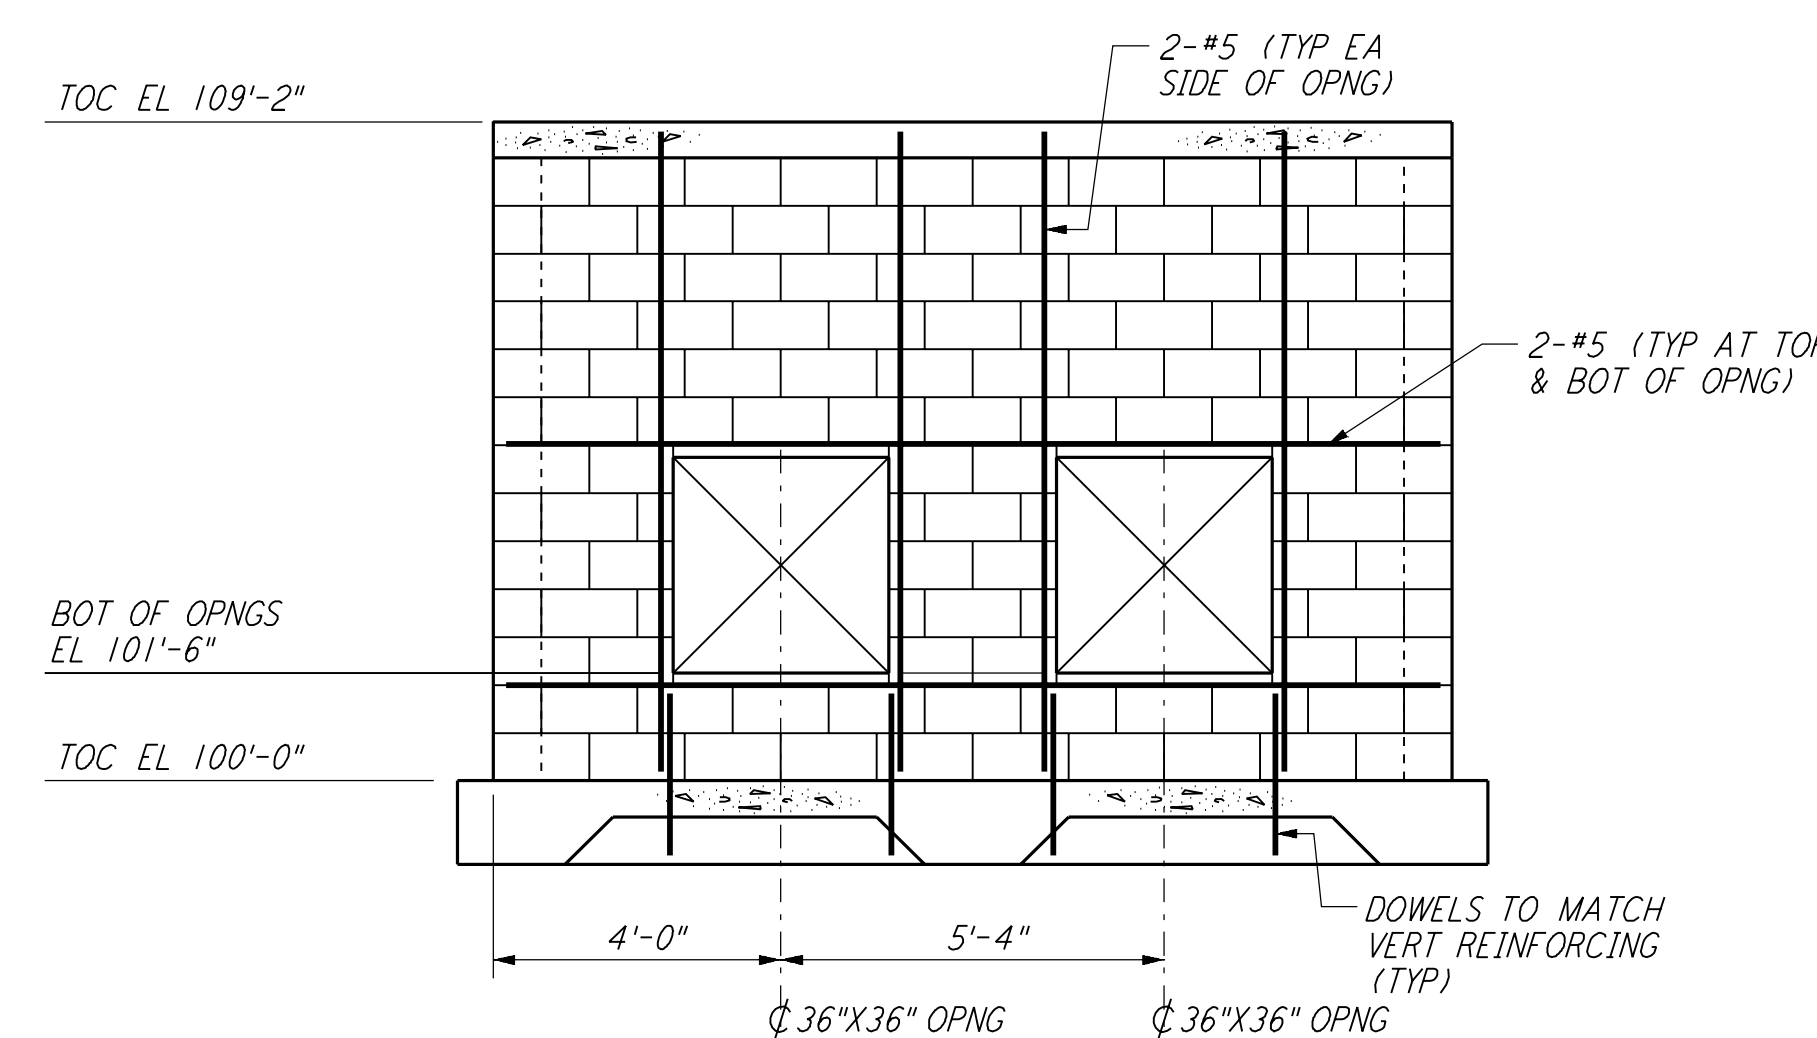


ELEVATION D REF
 $\frac{3}{8}'' = 1'-0''$
 LA-S-303 LA-S-302

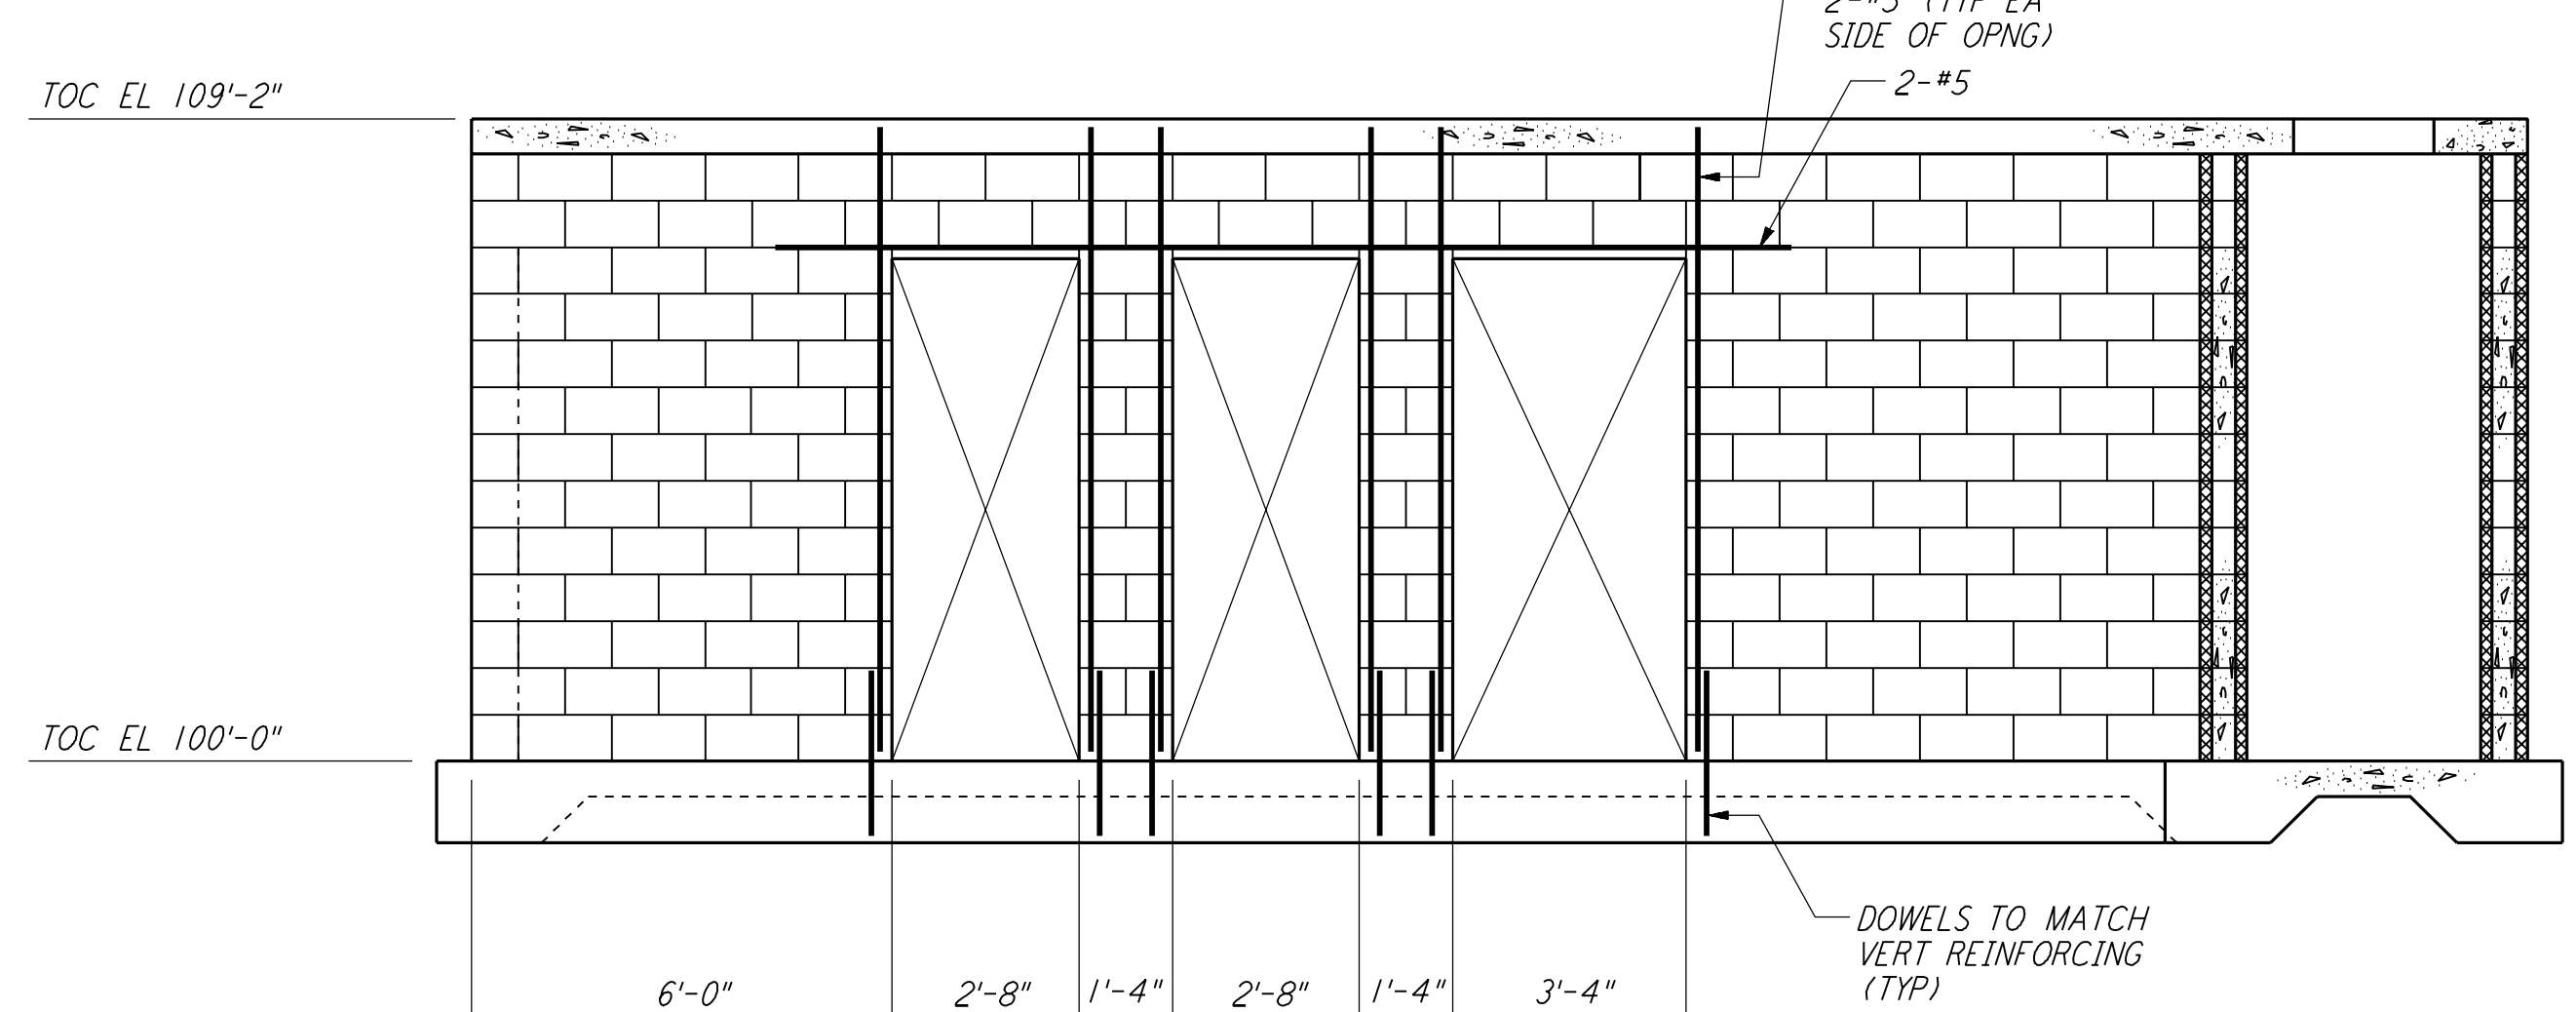


ELEVATION E REF
 $\frac{3}{8}'' = 1'-0''$
 LA-S-303 LA-S-302

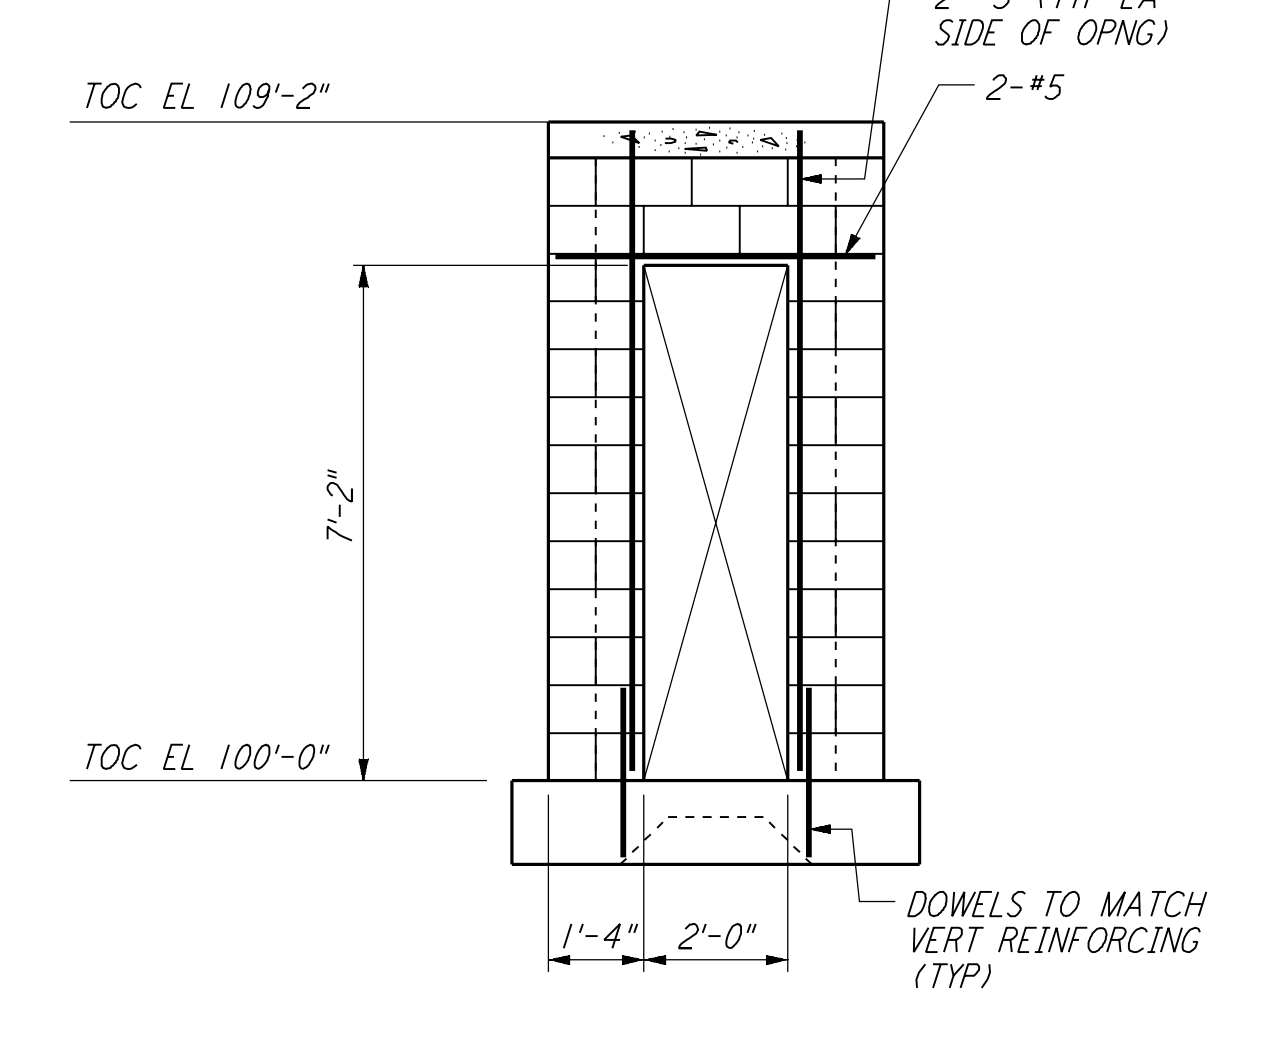


ELEVATION F REF
 $\frac{3}{8}'' = 1'-0''$
 LA-S-303 LA-S-302

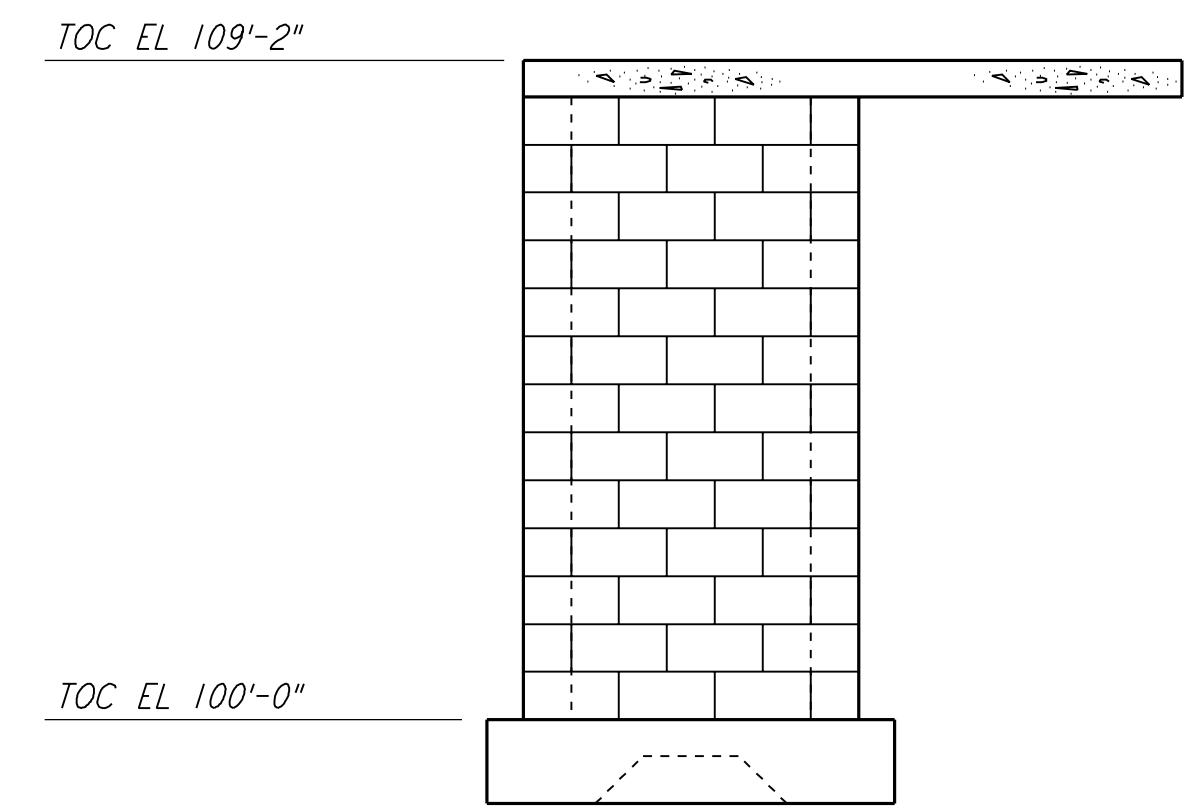

ELEVATION G REF
 $\frac{3}{8}'' = 1'-0''$
 LA-S-303 LA-S-302

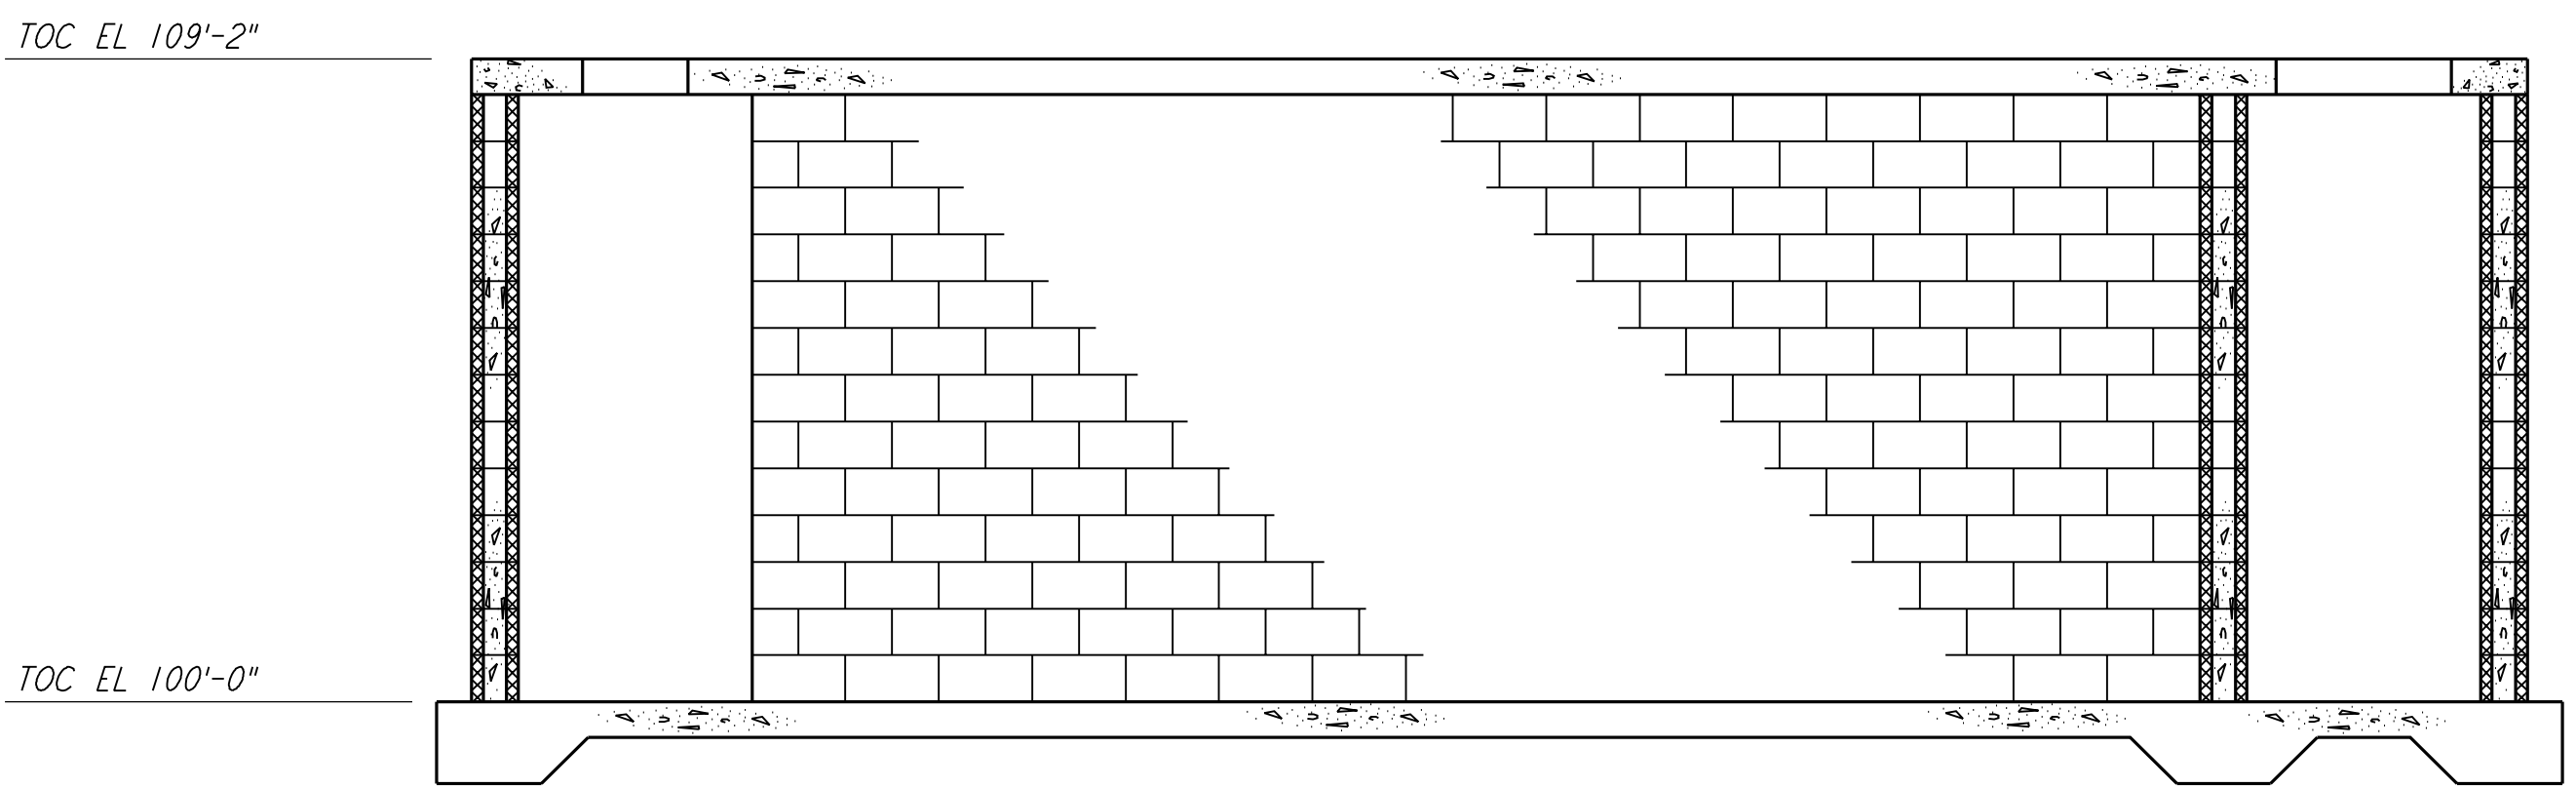

ELEVATION H REF
 $\frac{3}{8}'' = 1'-0''$
 LA-S-303 LA-S-302

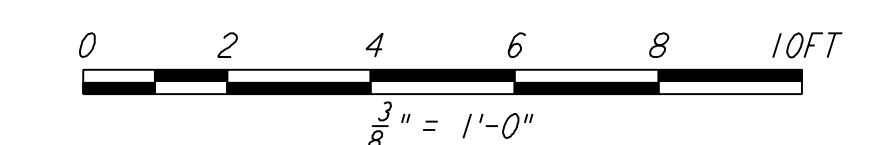

LIGO-D960947-01-O

NO.	DATE	BY	CHKD	ENGR	PROJ	DESCRIPTION
1	08-07-98	WA				ISSUED FOR AS-BUILT

ISSUED FOR CONSTRUCTION		
DRAWN	MCS	11-15-96
CHECKED	DDM	11-15-96
ENGINEER	BP	11-15-96
PROJ	TDM	11-15-96
AS-BUILT DRAWINGS		

PARSONS
 100 WEST WALNUT STREET
 PASADENA, CALIFORNIA

LIGO
 CALIFORNIA INSTITUTE OF TECHNOLOGY
 MASSACHUSETTS INSTITUTE OF TECHNOLOGY

LASER INTERFEROMETER
 GRAVITATIONAL-WAVE OBSERVATORY
 SITE NO.2 - LIVINGSTON, LOUISIANA

TITLE	SCALE	CONTRACT NUMBER	PROJECT NUMBER
STRUCTURAL END STATIONS "A" & "B" AIR HANDLING UNIT ENCLOSURE ELEVS & SECTS	AS NOTED	PP150969	8094
SHEET NUMBER		REVISIONS	
LA-S-303		1	