

- NOTES:**
- CONSTRUCTION SHALL COMPLY WITH ALL THE REQUIREMENTS OF THE GENERAL NOTES ON DRAWING LA-S-001.
  - THE BAR SPACING IS BASED ON CENTER TO CENTER OF TIE SET.
  - FOR ANCHOR BOLT DETAILS SEE DRAWING LA-S-003.


**TIE REINFORCEMENT NOTES:**

1A. THESE BARS MUST BE TIED AS SHOWN BY DASHED LINES WHEN X DISTANCE IS OVER 6 INCHES.  
 2A. THESE BARS NEED NOT BE TIED WHEN X DISTANCE IS 6 INCHES OR LESS.  
 3A. ALTERNATE 90° HOOKS IN COLUMNS.

not be reproduced, copied, loaned, exhibited, or used in any other way, except by written consent from PARSONS to the borrower.

This document and the design it covers are the property of PARSONS. They are loaned only with the borrower's expressed written agreement that they will not be reproduced, copied, loaned, exhibited, or used in any other way, except by written consent from PARSONS to the borrower.

FOUNDATION NO. OF FDN'S REQD.	FOUNDATION LOCATION (COL. LINES)	TOP OF CONC. EL.	FOUNDATION TYPE		DIMENSIONS													ANCHOR BOLTS PER PIER					REINFORCING PER FOUNDATION										CONC. CY	FDN LOC. PLAN	REMARKS				
			PLAN	ELEV.	A	B	C	D	F	G	H	J	K	M	R	N	ANCHOR BOLT PLAN	TYPE	NO PER PIER	SIZE	L	P	BAR S NO.	BAR S SIZE	BAR Z NO.	BAR Z SIZE	BAR T NO.	BAR T SIZE	BAR Y NO.	BAR Y SIZE	BAR W NO.	BAR W SIZE				TIE BAR TYPE	TIE BAR SIZE	NO. RECD.	
1	V-18	100'-0"	B	2	4'-0"	9'-0"	1'-6"	10"	10"	10"	10"	1'-2"	1"	7"	7"	5'-0"	III	2	4	1"	1'-4"	4"	5	#6	10	#6	5	#6	10	#6	8	#6	B	#4	3	2.3	LA-S-102		
	V-2-18	100'-0"	B	2	4'-0"	9'-0"	1'-6"	10"	10"	10"	10"	1'-2"	1"	7"	7"	5'-0"	III	2	4	1"	1'-4"	4"	5	#6	10	#6	5	#6	10	#6	8	#6	B	#4	3	2.3	LA-S-102		
1	W-17.2	100'-0"	B	2	4'-0"	9'-0"	1'-6"	10"	10"	10"	10"	1'-2"	1"	7"	7"	5'-0"	III	2	4	1"	1'-4"	4"	5	#6	10	#6	5	#6	10	#6	8	#6	B	#4	3	2.3	LA-S-102		
	W-17	100'-0"	B	2	4'-0"	9'-0"	1'-6"	10"	10"	10"	10"	1'-2"	1"	7"	7"	5'-0"	III	2	4	1"	1'-4"	4"	5	#6	10	#6	5	#6	10	#6	8	#6	B	#4	3	2.3	LA-S-102		
1	T-16.3	100'-0"	B	2	4'-0"	24'-0"	1'-6"	10"	10"	10"	10"	1'-2"	1"	7"	7"	20'-0"	III	2	4	1"	1'-4"	4"	5	#6	25	#6	5	#6	25	#6	8	#6	B	#4	3	6.0	LA-S-102		
	U-16.3	100'-0"	B	2	4'-0"	24'-0"	1'-6"	10"	10"	10"	10"	1'-2"	1"	7"	7"	20'-0"	III	2	4	1"	1'-4"	4"	5	#6	25	#6	5	#6	25	#6	8	#6	B	#4	3	6.0	LA-S-102		
1	W-15.3	100'-0"	B	2	4'-0"	24'-0"	1'-6"	10"	10"	10"	10"	1'-2"	1"	7"	7"	20'-0"	III	2	4	1"	1'-4"	4"	5	#6	25	#6	5	#6	25	#6	8	#6	B	#4	3	6.0	LA-S-102		
	W-14.3	100'-0"	B	2	4'-0"	24'-0"	1'-6"	10"	10"	10"	10"	1'-2"	1"	7"	7"	20'-0"	III	2	4	1"	1'-4"	4"	5	#6	25	#6	5	#6	25	#6	8	#6	B	#4	3	6.0	LA-S-102		
1	U-18	100'-0"	B	2	6'-0"	24'-0"	1'-6"	10"	10"	10"	10"	1'-6"	1"	7"	7"	20'-0"	III	2	4	1"	1'-4"	4"	7	#6	25	#6	7	#6	25	#6	8	#6	B	#4	3	9.0	LA-S-102		
	U-17	100'-0"	B	2	6'-0"	24'-0"	1'-6"	10"	10"	10"	10"	1'-6"	1"	7"	7"	20'-0"	III	2	4	1"	1'-4"	4"	7	#6	25	#6	7	#6	25	#6	8	#6	B	#4	3	9.0	LA-S-102		
1	K.3-17	100'-0"															III	2	4	1"	1'-4"	4"																	
	J.3-17	100'-0"										2'-6"	1"	7"	7"		III	2	4	1"	1'-4"	4"																	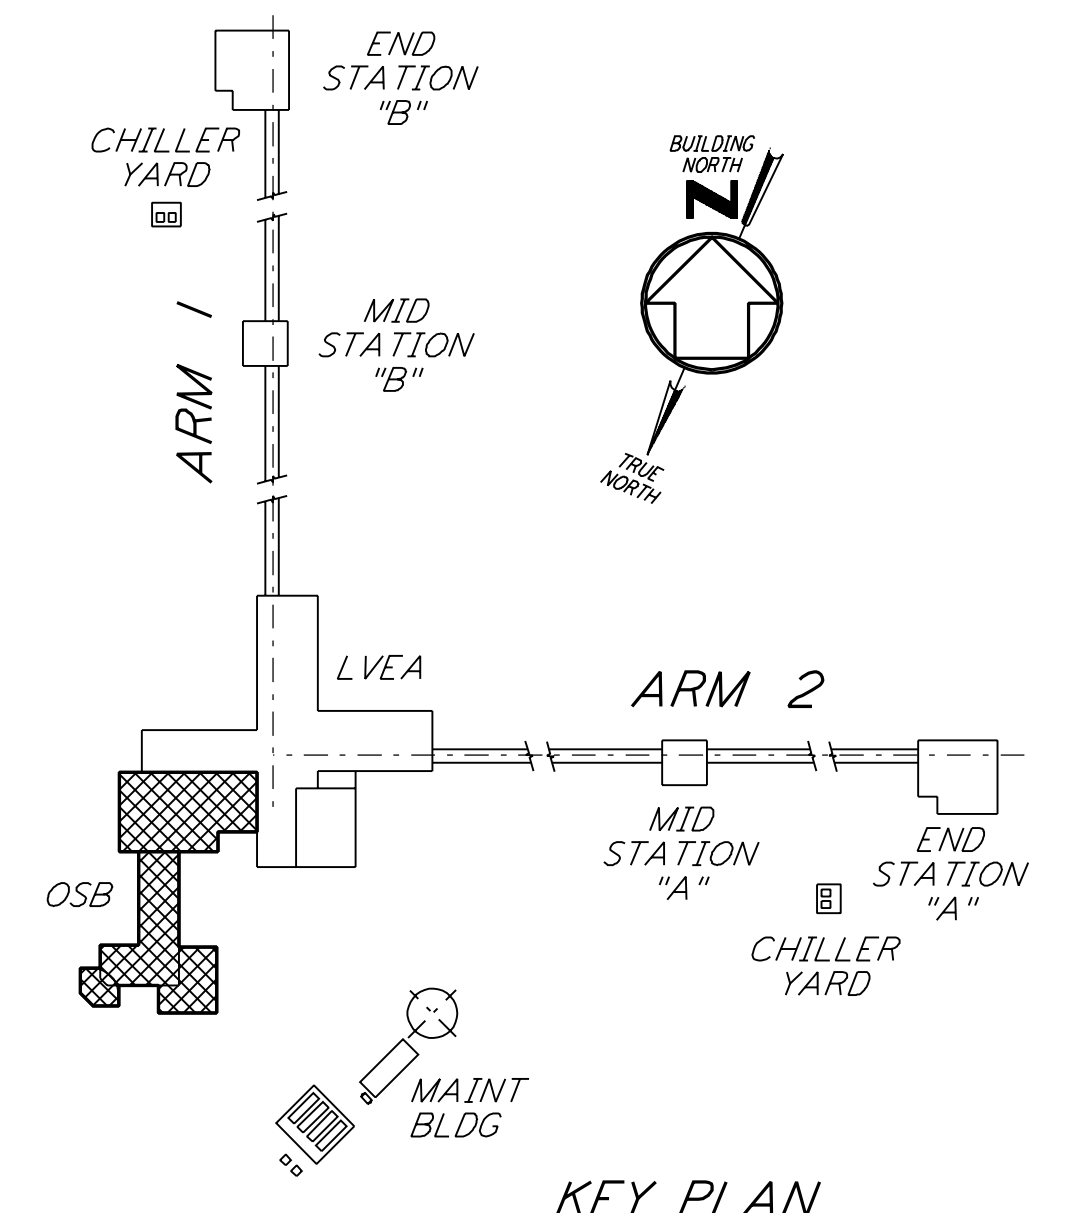
LIGO-D960955-01-0

NO.	DATE	BY	CHKD	ENGR	PROJ	DESCRIPTION
1	08-07-98	WA				ISSUED FOR AS-BUILT

ISSUED FOR CONSTRUCTION  
 DRAWN MCS 11-15-96  
 CHECKED DDM 11-15-96  
 ENGINEER BP 11-15-96  
 PROJ TDM 11-15-96

**AS-BUILT DRAWINGS**

**PARSONS**  
 100 WEST WALNUT STREET  
 PASADENA, CALIFORNIA

**LIGO**  
 CALIFORNIA INSTITUTE OF TECHNOLOGY  
 MASSACHUSETTS INSTITUTE OF TECHNOLOGY

LASER INTERFEROMETER  
 GRAVITATIONAL-WAVE OBSERVATORY  
 SITE NO. 2 - LIVINGSTON, LOUISIANA

STRUCTURAL  
 CORNER STATION - OSB  
 FOUNDATION SCHEDULE  
 AND DETAILS SHEET 2

SCALE: NONE  
 CONTRACT NUMBER: PP150969  
 PROJECT NUMBER: 8094

SHEET NUMBER: **LA-S-403**