


This document and the design it covers are the property of PARSONS. They are loaned only with the borrower's expressed written agreement that they will not be reproduced, copied, loaned, exhibited, or used in any other way, except by written consent from PARSONS to the borrower.

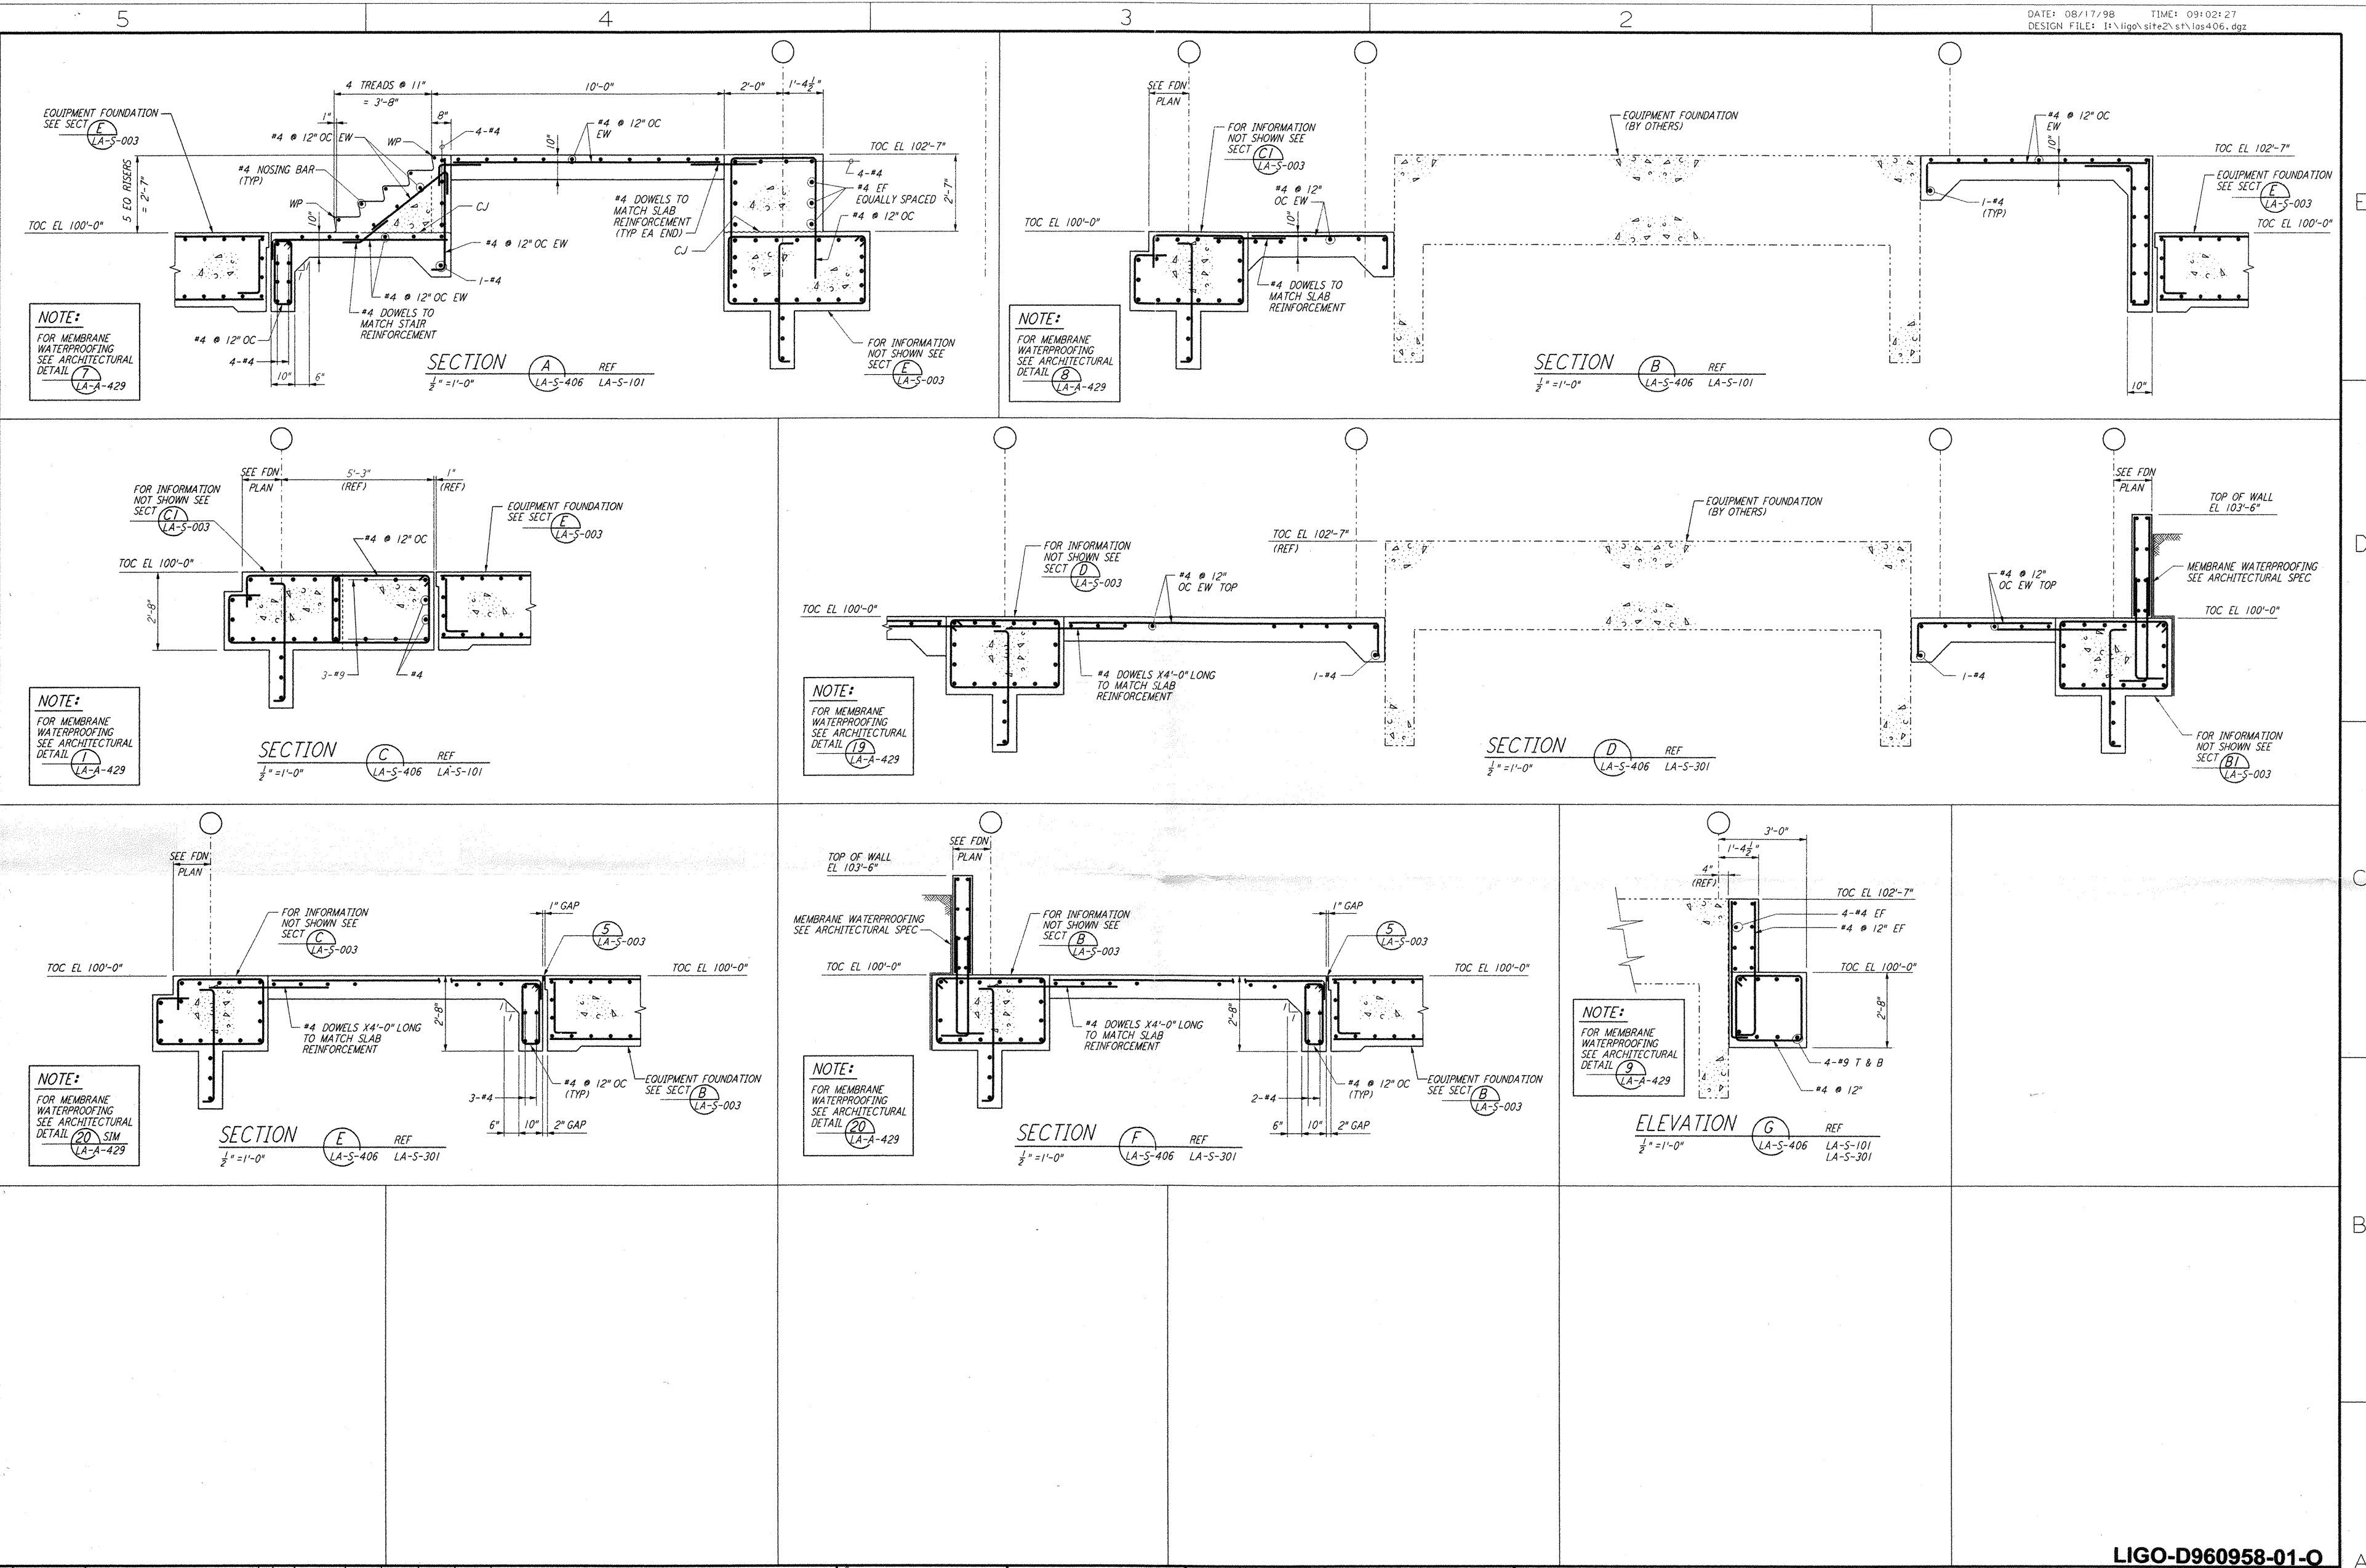

NO.	DATE	BY	CHKD	ENGR	PROJ	DESCRIPTION
1	08-07-98	WA	DDM	BP	WLU	ISSUED FOR AS-BUILT

ISSUED FOR CONSTRUCTION	DATE	BY
DRAWN	MCS	11-15-96
CHECKED	DDM	11-15-96
ENGINEER	BP	11-15-96
PROJ	TDM	11-15-96

AS-BUILT DRAWINGS

PARSONS
 100 WEST WALNUT STREET
 PASADENA, CALIFORNIA

LIGO
 CALIFORNIA INSTITUTE OF TECHNOLOGY
 MASSACHUSETTS INSTITUTE OF TECHNOLOGY

STRUCTURAL FOUNDATION SECTIONS & DETAILS SHEET 2

LIGO-D960958-01-O LASER INTERFEROMETER GRAVITATIONAL-WAVE OBSERVATORY SITE NO. 2 - LIVINGSTON, LOUISIANA	
SCALE: AS NOTED SHEET NUMBER: PPI50969 PROJECT NUMBER: 8094	REVISIONS:
DRAWING NO.	DESCRIPTION
LA-S-406	