



NOTES:
 1. FOR LEGEND, ABBREVIATIONS AND GENERAL NOTES SEE SHEETS LA-H-001 AND LA-H-002.

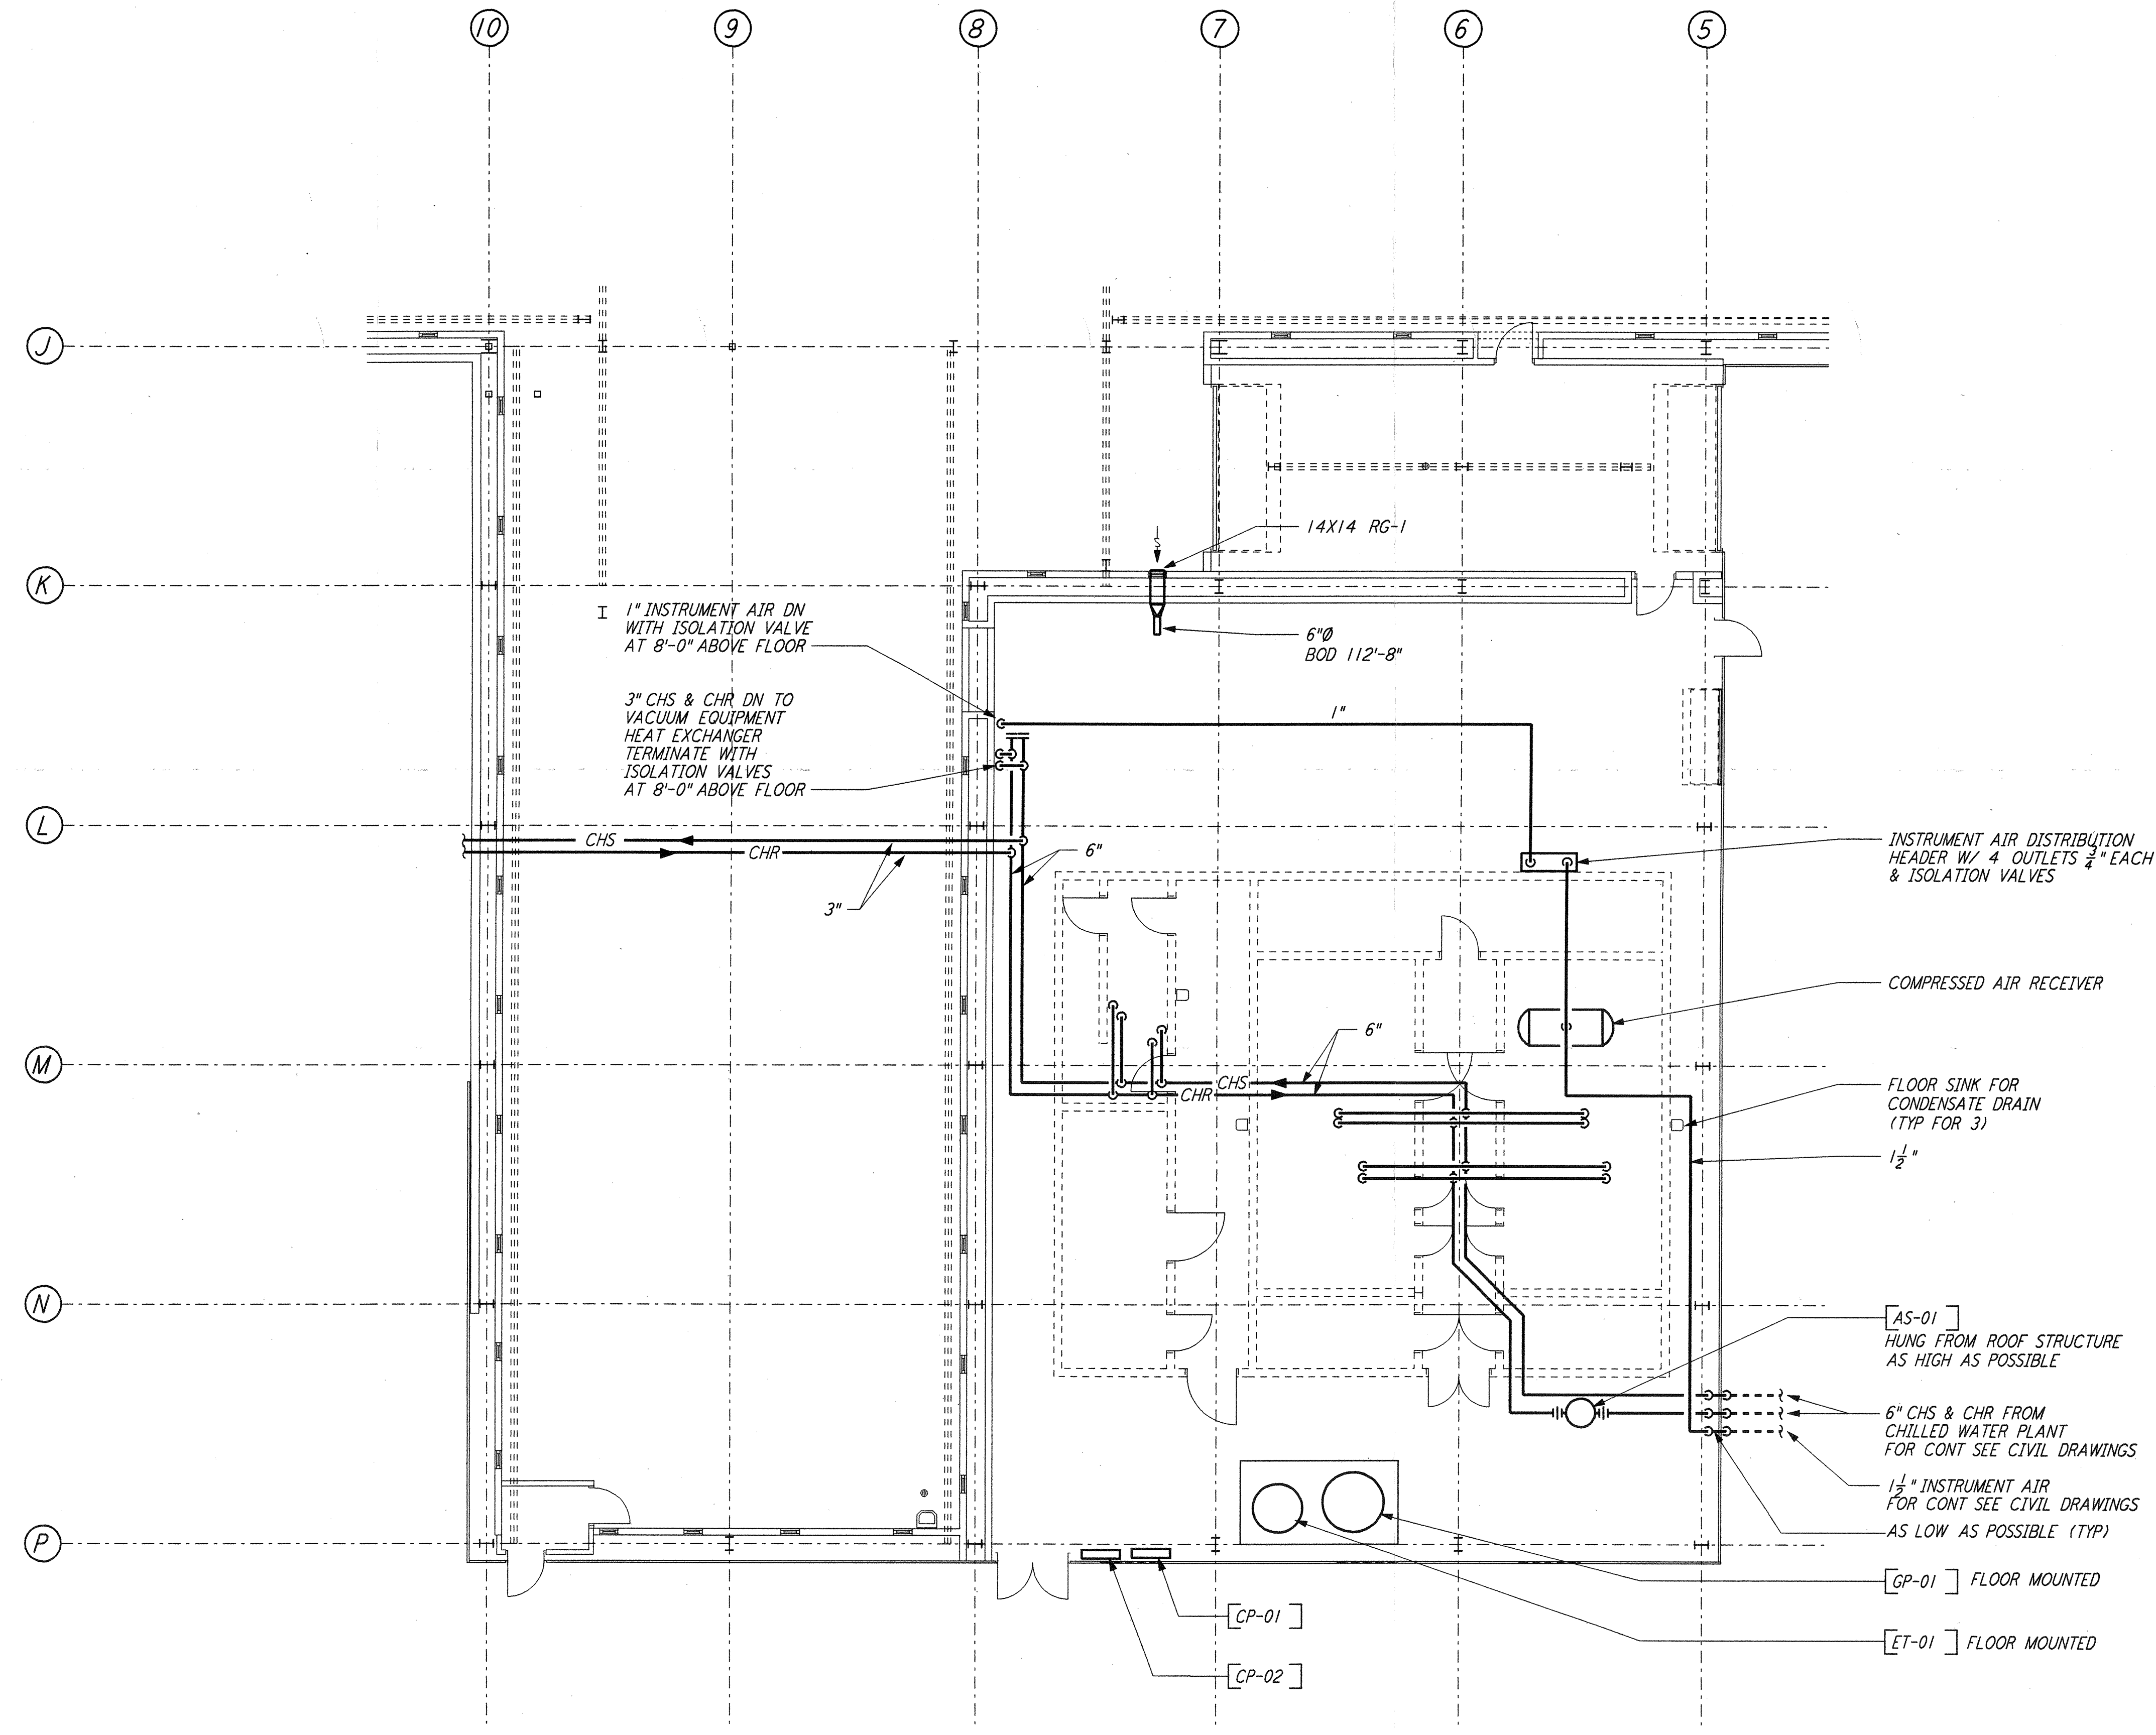

MECHANICAL ROOM PIPING PLAN
 $\frac{1}{8}'' = 1'-0''$

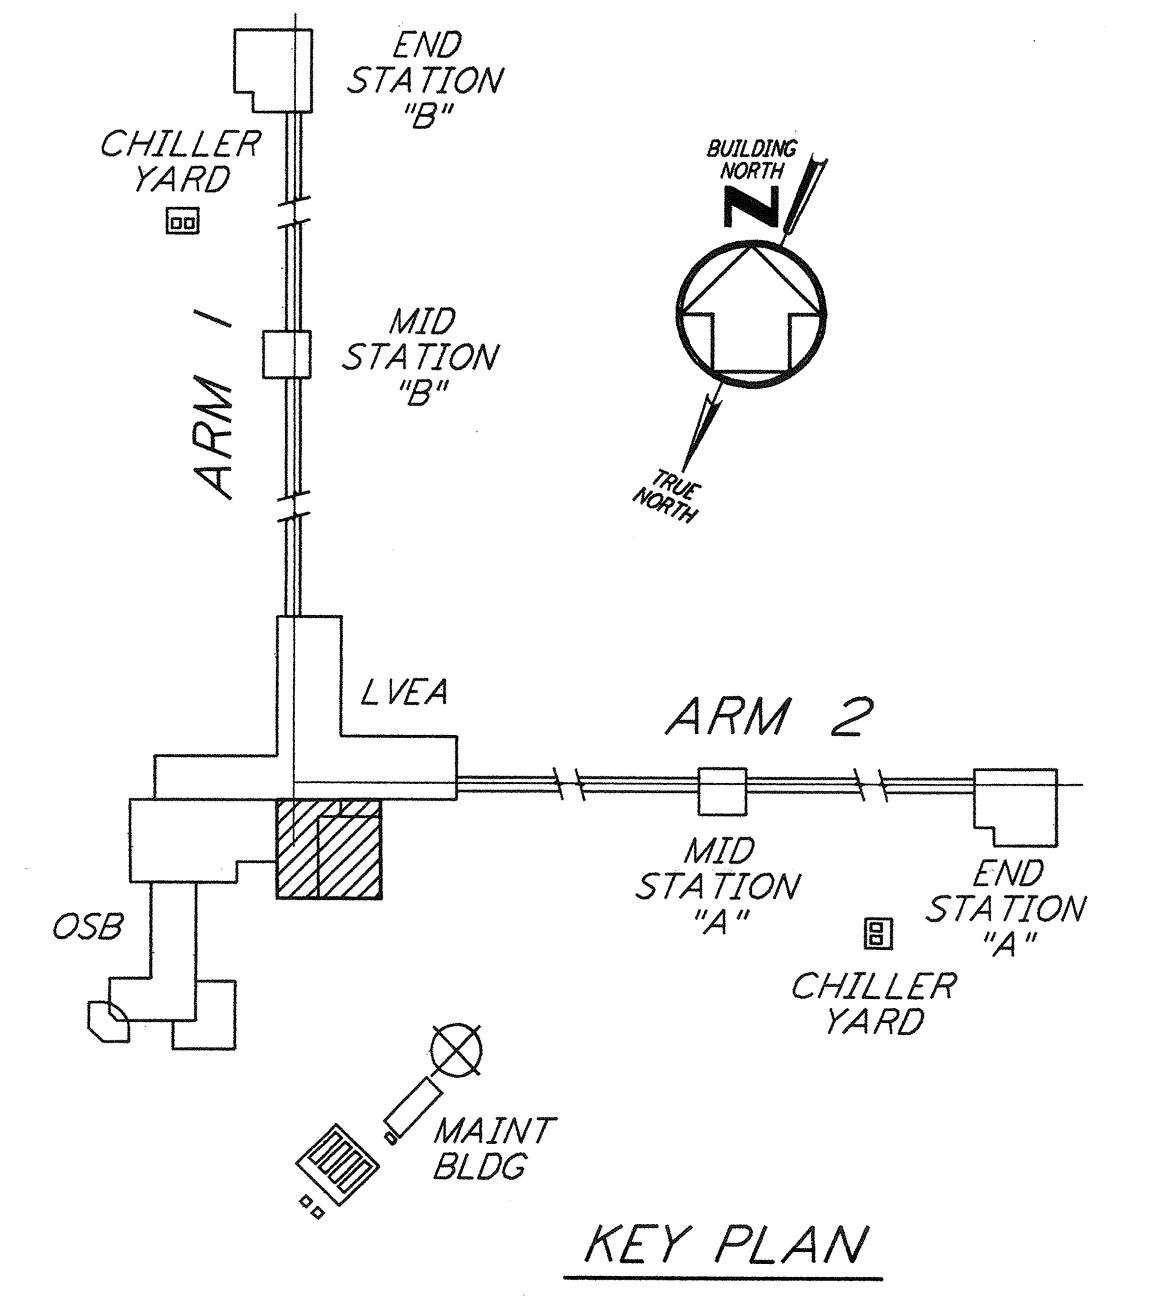

0 8 16 24 32FT
 $\frac{1}{8}'' = 1'-0''$

PARSONS, they are loaned only with the borrower's expressed written agreement that they will not be used for any other work, except by written consent of PARSONS to the borrower.

| NO. | DATE | BY | CHKD | ENGR | PROJ | DESCRIPTION |
|-----|--------|-----|------|------|------|---------------------|
| 1 | 8-7-98 | DJB | AA | AA | WJ | ISSUED FOR AS-BUILT |

ISSUED FOR CONSTRUCTION
 DRAWN: CLP 11-15-96
 CHECKED: MN 10-25-96
 ENGINEER: AA 1-23-96
 PROJ: TDM 11-15-96

AS-BUILT DRAWINGS

PARSONS
 100 WEST WALNUT STREET
 PASADENA, CALIFORNIA

LIGO
 CALIFORNIA INSTITUTE OF TECHNOLOGY
 MASSACHUSETTS INSTITUTE OF TECHNOLOGY

LIGO-D960973-01-0

LASER INTERFEROMETER
 GRAVITATIONAL-WAVE OBSERVATORY
 SITE NO. 2 - LIVINGSTON, LOUISIANA

TITLE: HVAC CORNER STATION LVEA & OSB MECHANICAL ROOM PIPING PLAN

SCALE: AS NOTED
 CONTRACT NUMBER: PPI50969
 SHEET NUMBER: LA-H-117
 PROJECT NUMBER: 8094