




SCHEMATIC & WIRING DIAGRAM SYMBOLS

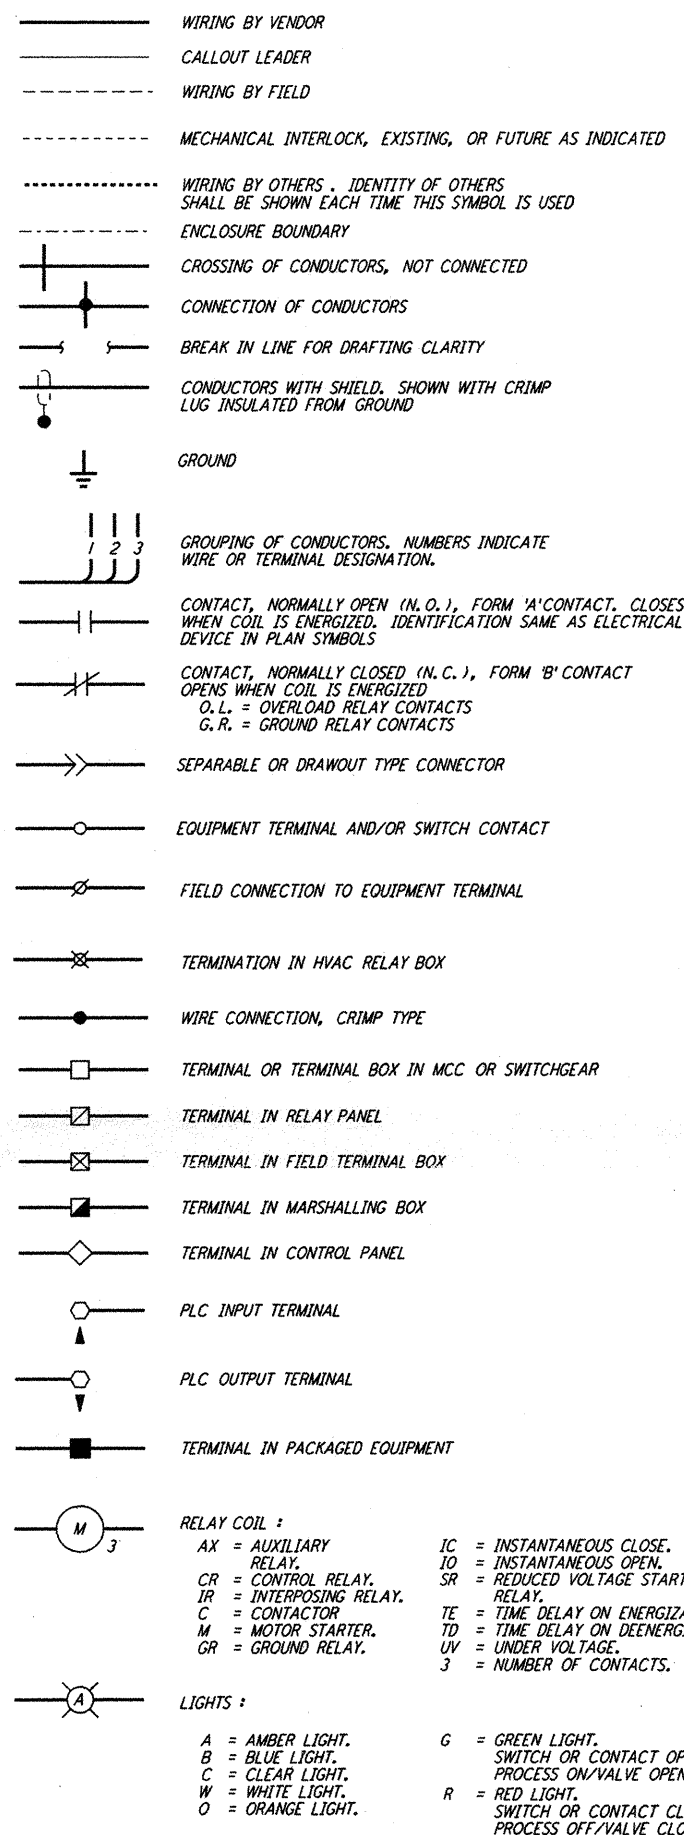

SCHEMATIC & WIRING DIAGRAM SYMBOLS

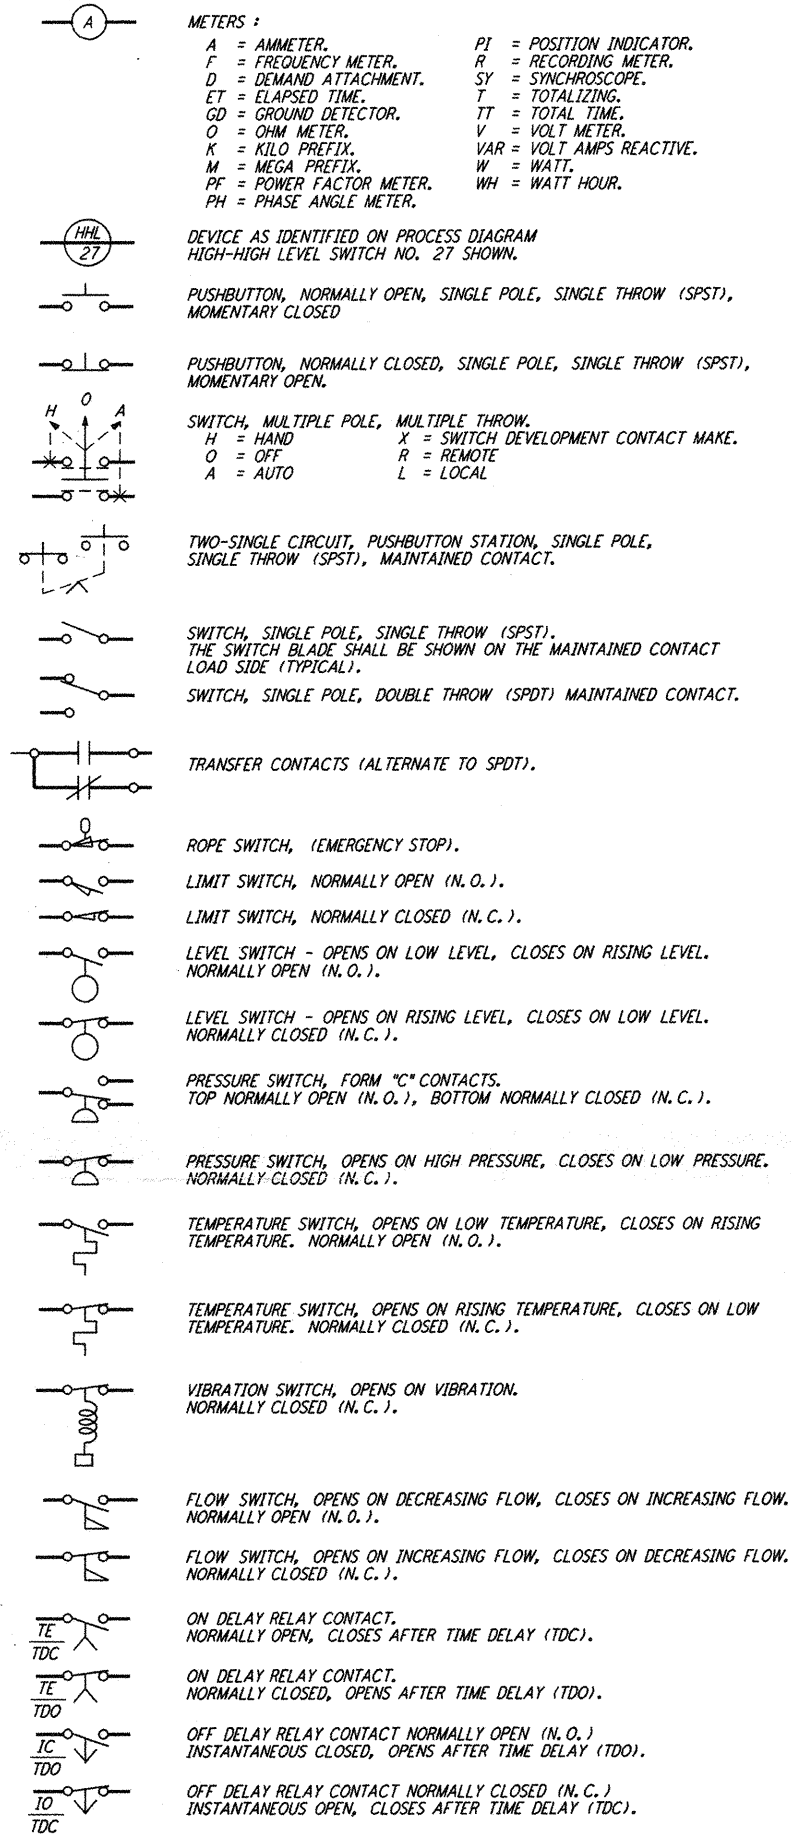

SCHEMATIC & WIRING DIAGRAM SYMBOLS

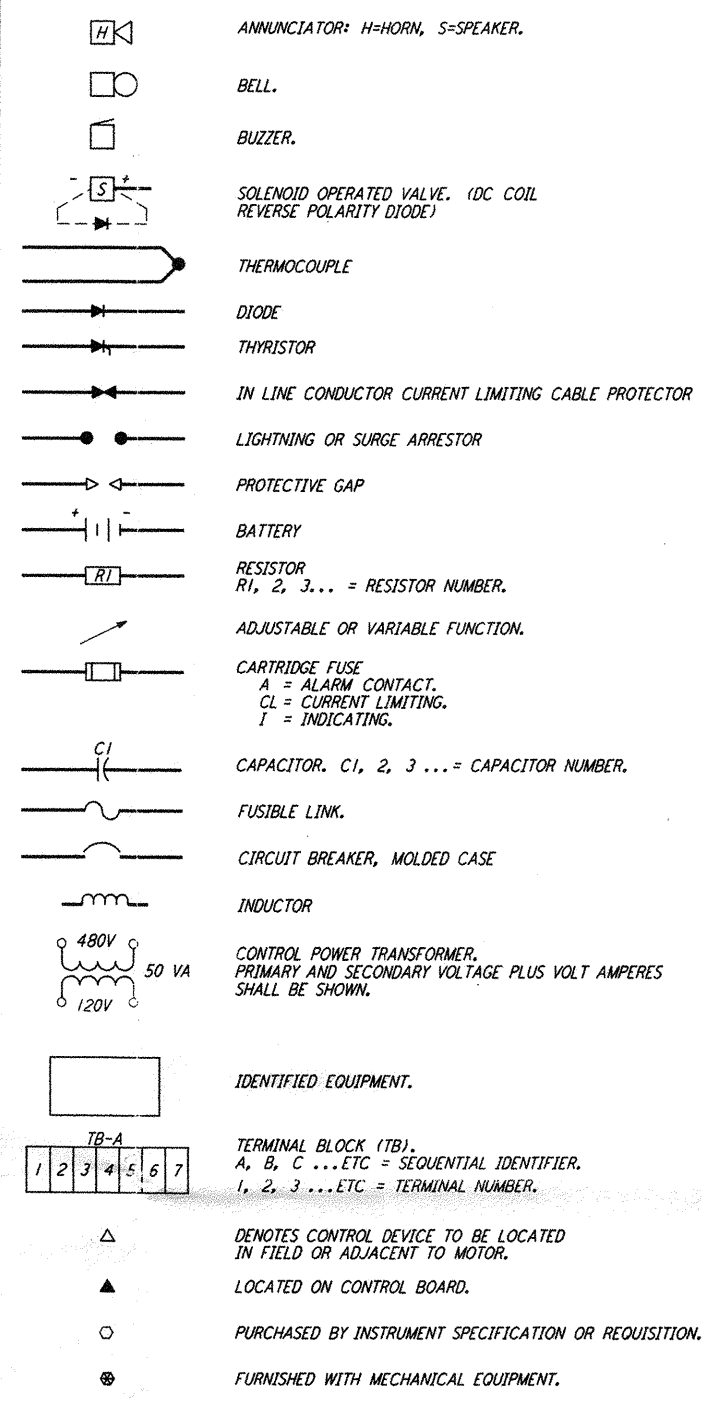

MOTOR CONTROL CABLE CONDUCTOR COLOR CODE

CODE	COLOR	CONDUCTOR NO.
R	RED	1
O	ORANGE	2
X2	WHITE	X2
BU	BLUE	3
Y	YELLOW	4
BK	BLACK	5
BR	BROWN	6
R/BK	RED/BLACK	7
BU/BK	BLUE/BLACK	8
GR	GREEN	GROUND OR (-)

This document and the design it covers are the property of PARSONS. They are loaned only with the borrower's expressed written agreement that they will not be reproduced, copied, loaned, exhibited, or used in any other way, except by written consent from PARSONS to the borrower.

REFERENCES	DESCRIPTION
LA-E-001	ABBREVIATIONS & ACRONYMS
LA-E-002	STANDARD PLAN SYMBOLS
LA-E-004	ONE/THREE LINE DIAGRAM SYMBOLS

NO.	DATE	BY	CHKD	ENGR	PROJ	DESCRIPTION
1	8-7-98	JE	JK	JK	JK	ISSUED FOR AS-BUILT

ISSUED FOR CONSTRUCTION		
DRAWN	M. M.	11-15-96
CHECKED	JCL	7-24-96
ENGINEER	KCP	10-25-96
PROJ	T. D. M.	11-15-96

AS-BUILT DRAWINGS

PARSONS
 100 WEST WALNUT STREET
 PASADENA, CALIFORNIA

LIGO
 CALIFORNIA INSTITUTE OF TECHNOLOGY
 MASSACHUSETTS INSTITUTE OF TECHNOLOGY

LIGO-D960996-01-0

LASER INTERFEROMETER
 GRAVITATIONAL-WAVE OBSERVATORY
 SITE NO.2 - LIVINGSTON, LOUISIANA

TITLE	SCALE	CONTRACT NUMBER	PROJECT NUMBER
ELECTRICAL STANDARD SCHEMATIC & WIRING DIAGRAMS SYMBOLS	NONE	PP150969	8094
SHEET NUMBER		REVISIONS	
LA-E-003		▲	