


- NOTES:**
- FOR GENERAL NOTES AND LEGEND, SEE DWG. LA-E-100.
 - ALL CDSAC CONDUIT EMBEDDED WITHIN AND BELOW LVEA FLOOD SLABS SHALL BE 2" IN SIZE AND SPACED 4" ON CENTER AT STUB-UPS.
 - 4" C CONDUIT ONLY COMMUNICATIONS CONTINUE ON CIVIL DWG FOR BEAM TUBE BAKE-UP.

This document and the design it covers are the property of PARSONS. They are loaned only with the borrower's expressed written agreement that they will not be reproduced, copied, loaned, exhibited, or used in any other way, except by written consent from PARSONS to the borrower.

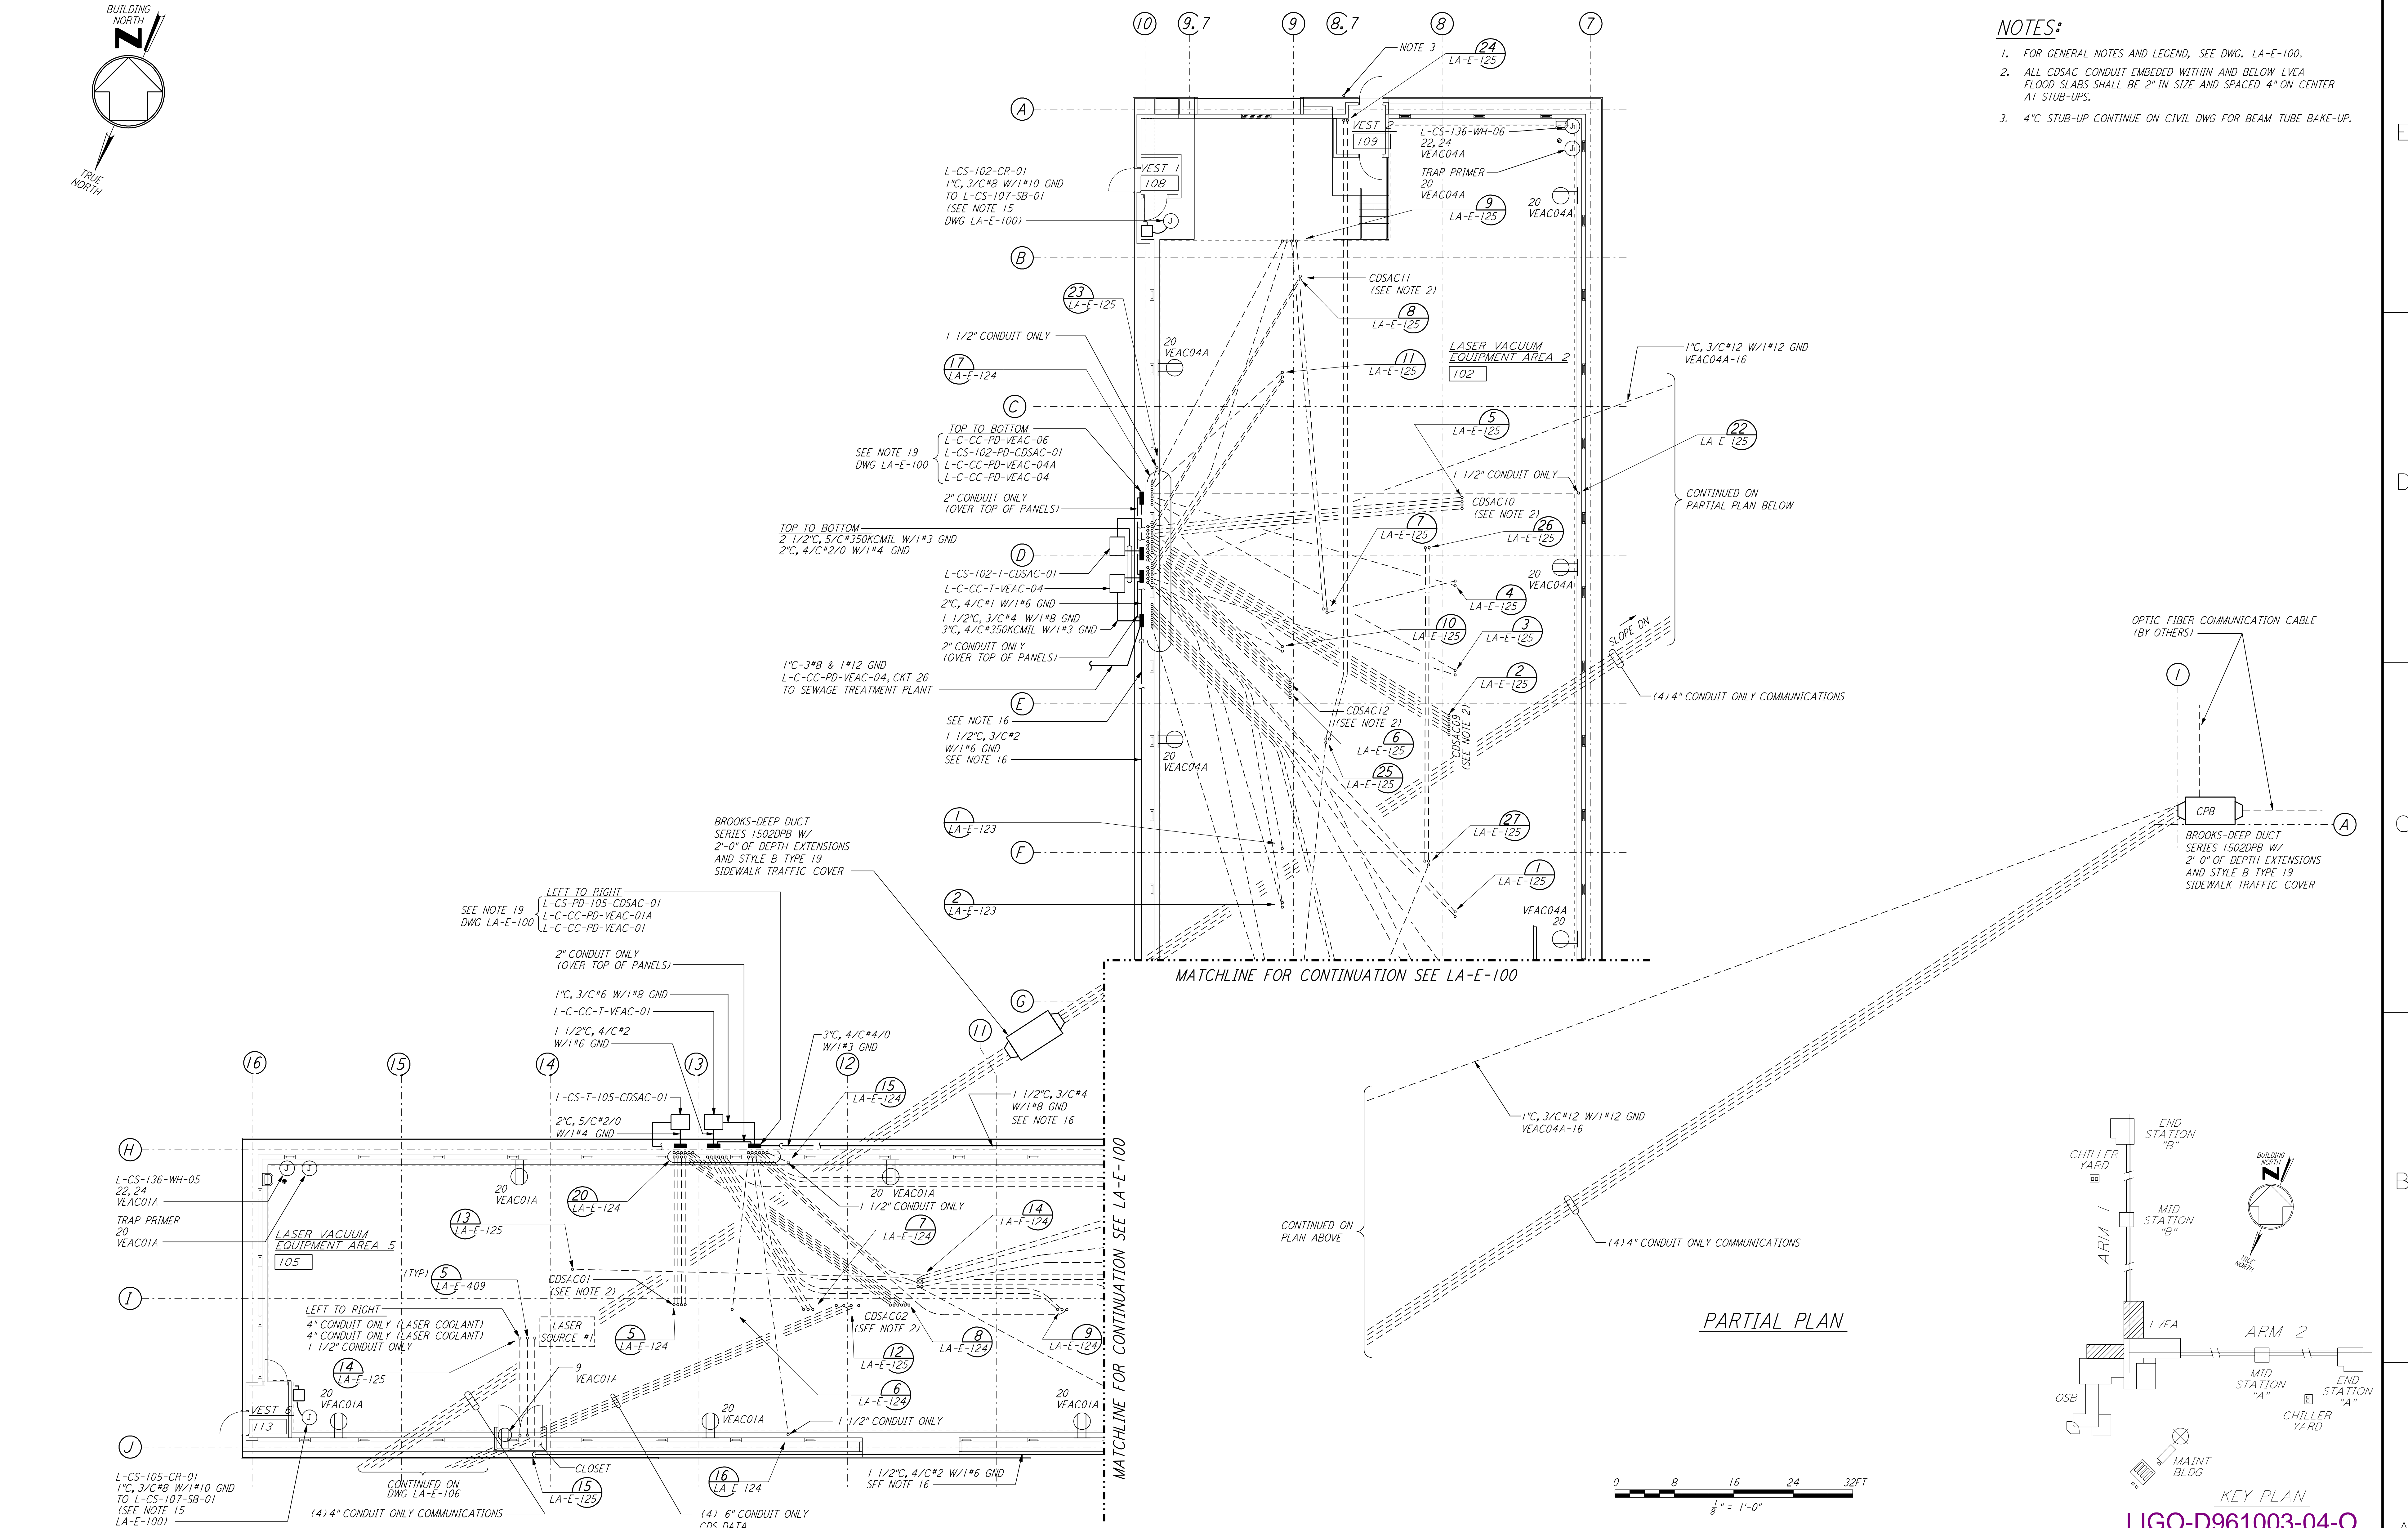

NO.	DATE	BY	CHKD	ENGR	PROJ	DESCRIPTION
4	8-7-98	JE				ISSUED FOR AS-BUILT
3	4-21-97	J.G.	KR	KR	TDM	REVISED FOR CDS AND VAC. EQUIP.
2	4-4-97	M.M.	KR	KR	TDM	GENERAL REVISIONS
1	3-21-97	J.G.	BK	KCR	TDM	GENERAL REVISIONS

NO.	DATE	BY	CHKD	ENGR	PROJ	DESCRIPTION
1	11-15-96	M.M.				ISSUED FOR CONSTRUCTION
2	7-24-96	J.C.L.				CHECKED
3	10-25-96	K.C.F.				ENGINEER
4	11-15-96	T.D.M.				PROJ

AS-BUILT DRAWINGS

PARSONS

100 WEST WALNUT STREET
 PASADENA, CALIFORNIA

LIGO

CALIFORNIA INSTITUTE OF TECHNOLOGY
 MASSACHUSETTS INSTITUTE OF TECHNOLOGY

LA-E-101

SCALE: AS NOTED
 CONTRACT NUMBER: PP150969
 PROJECT NUMBER: 8094