



This document and the design it covers are the property of PARSONS. They are loaned only with the borrower's expressed written agreement that they will not be reproduced, copied, loaned, exhibited, or used in any other way, except by written consent from PARSONS to the borrower.

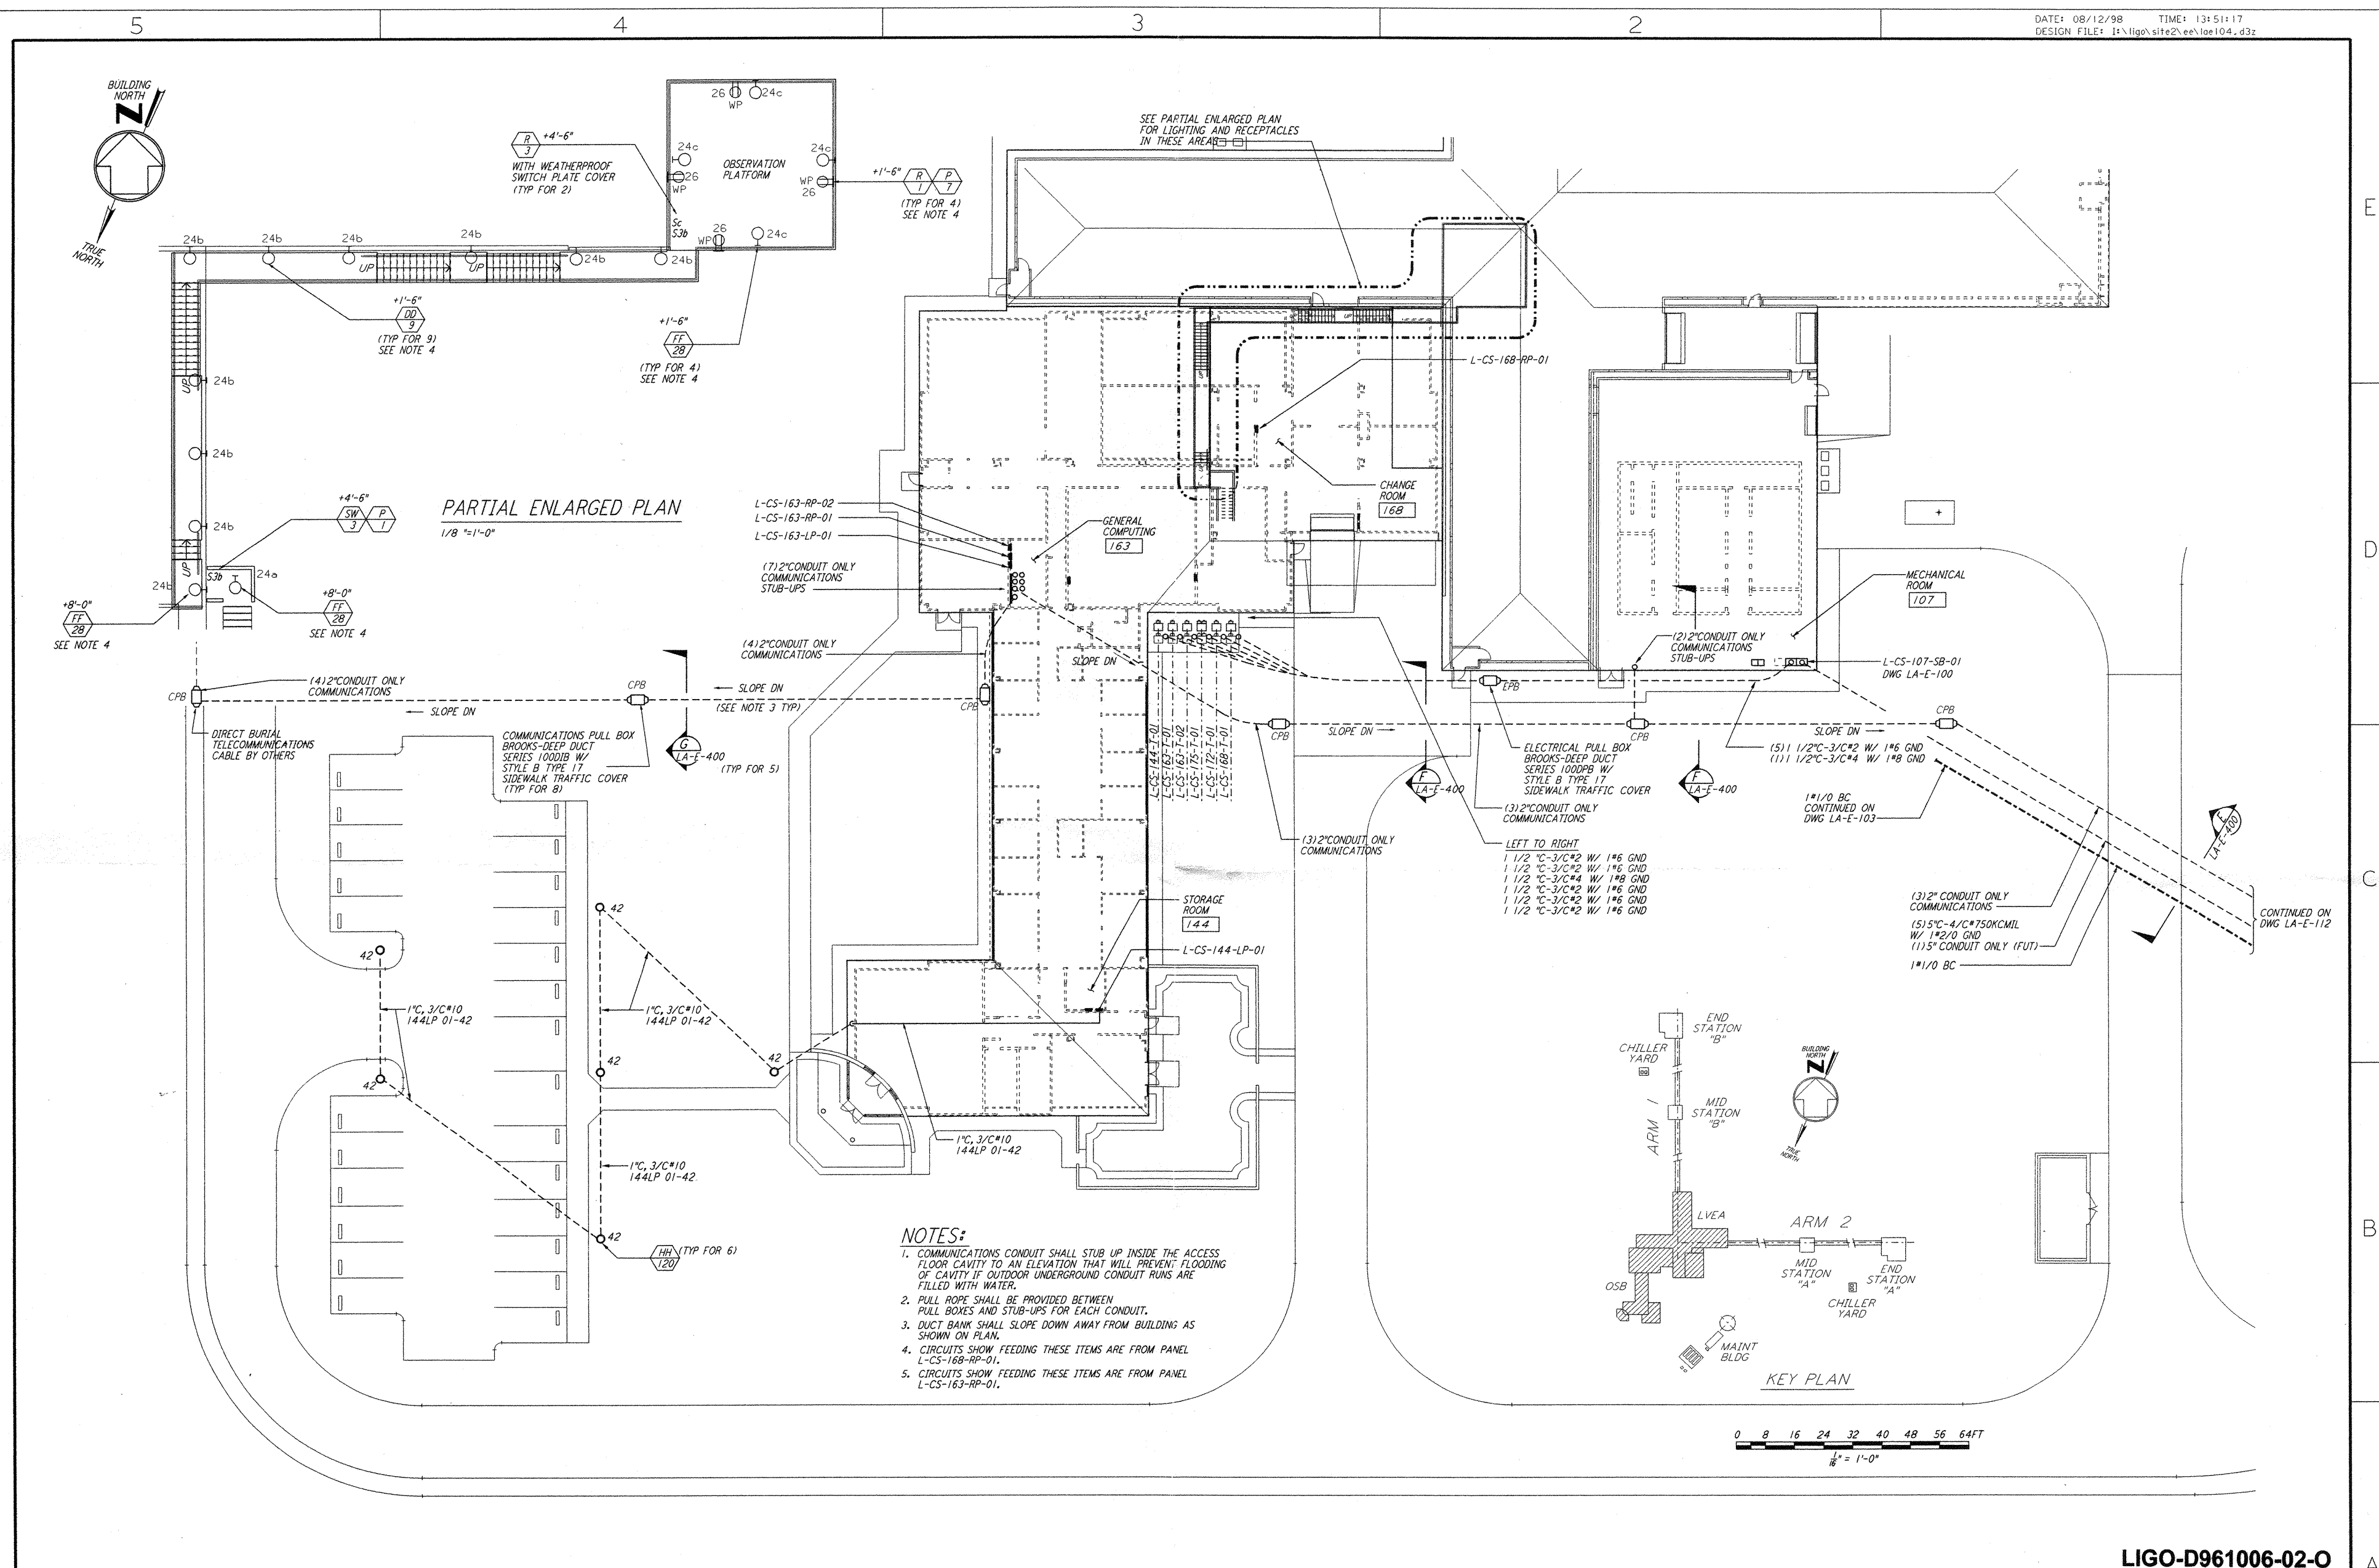

- NOTES:**
- COMMUNICATIONS CONDUIT SHALL STUB UP INSIDE THE ACCESS FLOOR CAVITY TO AN ELEVATION THAT WILL PREVENT FLOODING OF CAVITY IF OUTDOOR UNDERGROUND CONDUIT RUNS ARE FILLED WITH WATER.
 - PULL ROPE SHALL BE PROVIDED BETWEEN PULL BOXES AND STUB-UPS FOR EACH CONDUIT.
 - DUCT BANK SHALL SLOPE DOWN AWAY FROM BUILDING AS SHOWN ON PLAN.
 - CIRCUITS SHOW FEEDING THESE ITEMS ARE FROM PANEL L-CS-168-RP-01.
 - CIRCUITS SHOW FEEDING THESE ITEMS ARE FROM PANEL L-CS-163-RP-01.

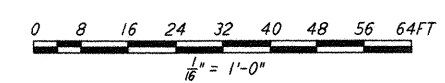

NO.	DATE	BY	CHKD	ENGR	PROJ	DESCRIPTION
2	8-7-98	JE	OK	WV		ISSUED FOR AS-BUILT
1	2-28-97	J. G.	RDC	KCR	F. D. M	GENERAL REVISIONS

ISSUED FOR CONSTRUCTION
 DRAWN M. M. 11-15-98
 CHECKED J. C. L. 7-24-98
 ENGINEER K. C. P. 10-25-98
 PROJ. T. D. M. 11-15-98

AS-BUILT DRAWINGS

PARSONS
 100 WEST WALNUT STREET
 PASADENA, CALIFORNIA

LIGO
 CALIFORNIA INSTITUTE OF TECHNOLOGY
 MASSACHUSETTS INSTITUTE OF TECHNOLOGY

LIGO-D961006-02-0
 LASER INTERFEROMETER
 GRAVITATIONAL-WAVE OBSERVATORY
 SITE NO. 2 - LIVINGSTON, LOUISIANA

**ELECTRICAL
 CORNER STATION
 POWER & LIGHTING
 PARKING & OBSERVATION PLAN**

SCALE: NONE
 CONTRACT NUMBER: PPI50969
 PROJECT NUMBER: 8094
 SHEET NUMBER: **LA-E-104**

Mod Aug 12 13:50:41 1998 C:\PLOT\QUE\S3\19882.DWG 52885 KLV5622.ees004.prf