

**LEGEND:**

- WP RECEPTACLE, 208V, 3Ø, 5W, 4 POLE GROUNDING  
NEMA L21-30R HUBBELL #2810 WITH WEATHERPROOF BOX AND COVER
- R RECEPTACLE, 208V, 3Ø, 5W, 4 POLE GROUNDING  
NEMA L21-30R HUBBELL #2810 WITH BOX AND COVER



**NOTES:**

1. FOR ABBREVIATIONS AND ACRONYMS SEE DWG. LA-E-001.
2. FOR SYMBOLS SEE DWG. LA-E-002.
3. FOR GENERAL NOTES SEE DWG. LA-E-100.
4. PANELS L-CS-175-RP-01 AND L-CS-175-RP-02 ARE RESERVED FOR CUSTOMER USE.
5. NOT USED.
6. FOR ALL PANEL FEEDER CONDUIT AND CABLE SIZES SEE SINGLE LINE DIAGRAM DWG. LA-E-006. ROUTE CABLES IN CONCEALED CONDUIT TO L-CS-107-SB-01. FOR LOCATION SEE DWG. LA-E-100.
7. SEE PANEL SCHEDULES ON DWG. LA-E-115 & LA-E-116 FOR GFCI CIRCUITS.



**REFERENCE DRAWINGS:**

- LA-E-109 COMMUNICATION RISER DIAGRAM
- LA-E-115 LIGHTING AND POWER PANEL SCHEDULES
- LA-E-116 LIGHTING AND POWER PANEL SCHEDULES

This document and the design it covers are the property of PARSONS. They are loaned only with the borrower's expressed written agreement that they will not be reproduced, copied, loaned, exhibited, or used in any other way, except by written consent from PARSONS to the borrower.

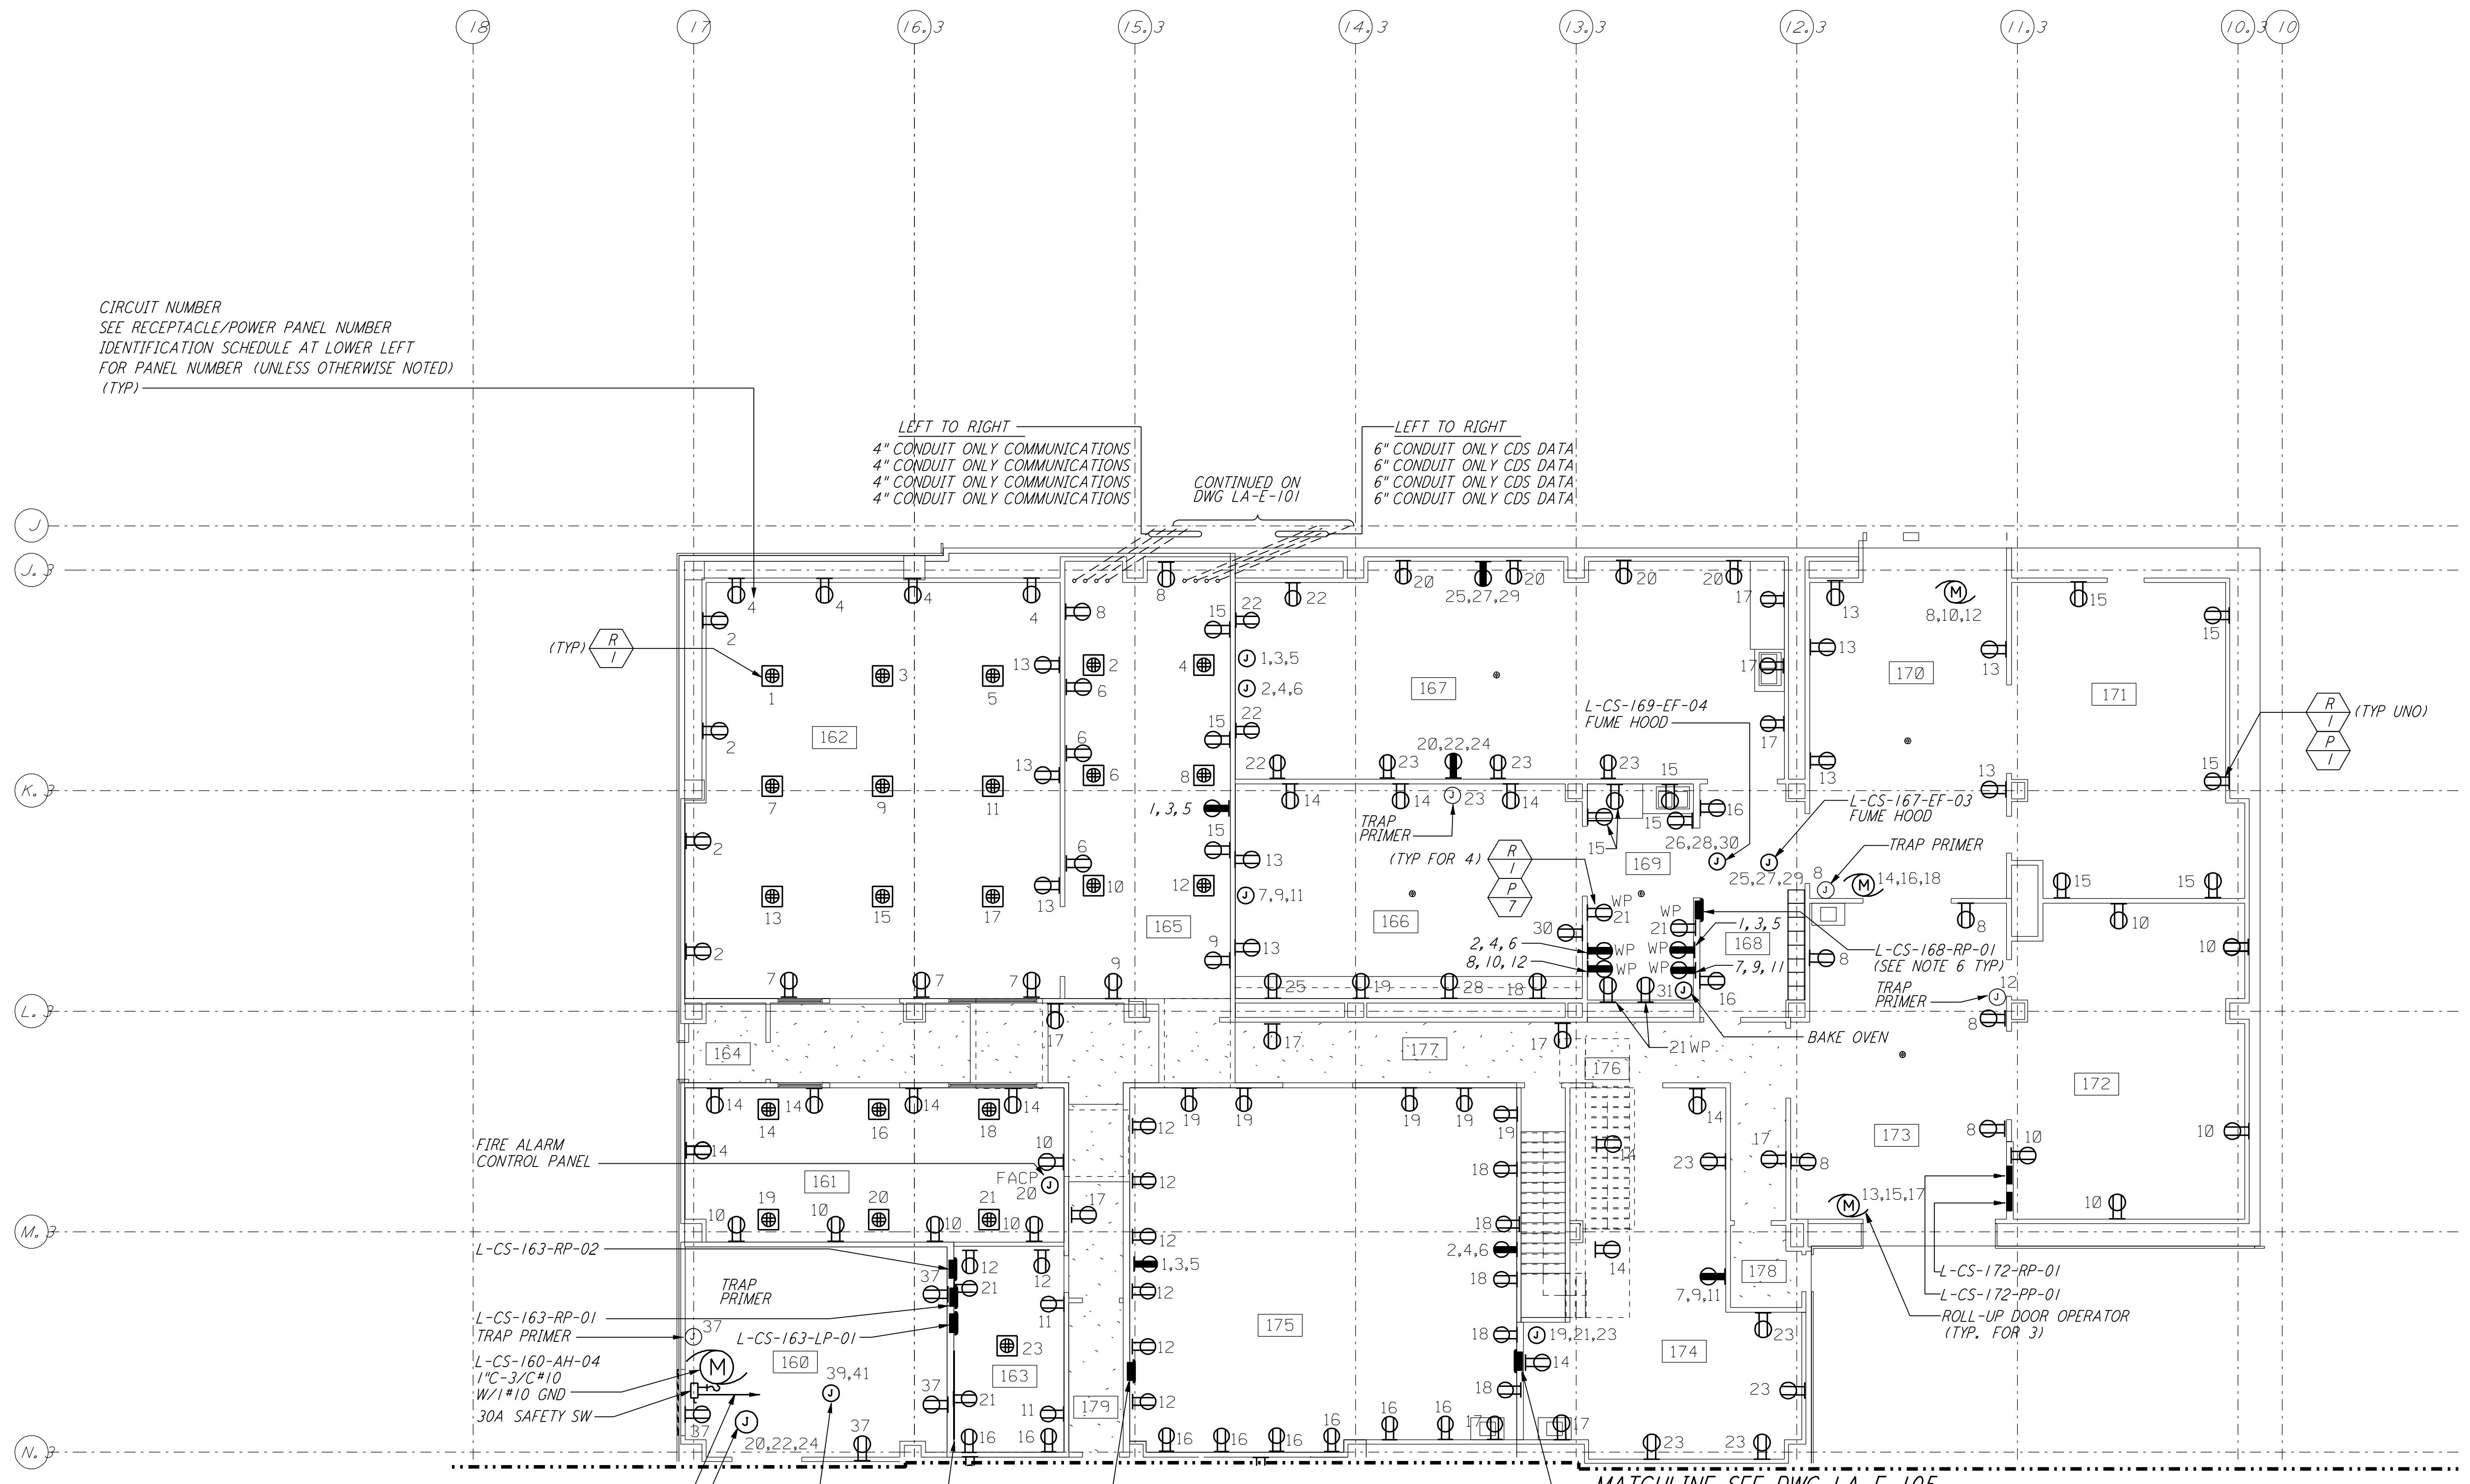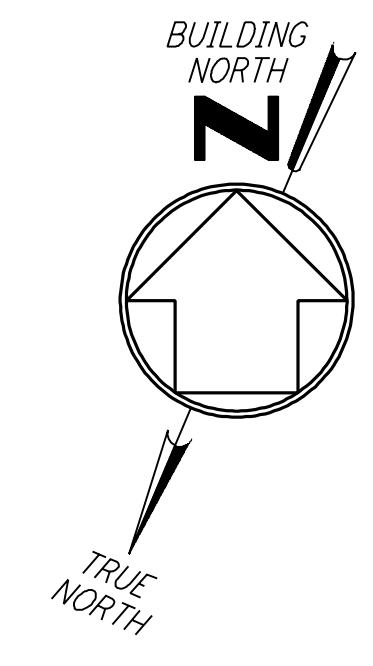

RECEPTACLE/POWER PANEL NUMBER IDENTIFICATION SCHEDULE (SEE NOTE 7)					
ROOM NUMBER	PANEL NUMBER FOR DUPLEX RECEPTACLE	PANEL NUMBER FOR DUAL-DUPLEX RECEPTACLE	PANEL NUMBER FOR 3Ø, 5-POLE RECEPTACLE	PANEL NUMBER FOR JUNCTION BOX POWER	PANEL NUMBER FOR ROLL-UP DOOR POWER
160	L-CS-163-RP-01	---	---	L-CS-163-RP-01	---
161	L-CS-163-RP-01	L-CS-163-RP-02	---	L-CS-163-RP-01	---
162	L-CS-163-RP-01	L-CS-163-RP-02	---	---	---
163	L-CS-163-RP-01	L-CS-163-RP-02	---	---	---
164	---	---	---	---	---
165	L-CS-163-RP-01	L-CS-163-RP-02	L-CS-163-RP-01	---	---
166	L-CS-168-RP-01	---	---	L-CS-172-PP-01	---
167	L-CS-168-RP-01	---	L-CS-172-RP-01	L-CS-172-PP-01	---
168	L-CS-168-RP-01	---	---	---	---
169	L-CS-168-RP-01	---	L-CS-168-RP-01	L-CS-172-PP-01	---
170	L-CS-172-RP-01	---	---	---	L-CS-172-PP-01
171	L-CS-172-RP-01	---	---	---	---
172	L-CS-172-RP-01	---	---	---	---
173	L-CS-172-RP-01	---	---	---	L-CS-172-PP-01
174	L-CS-172-RP-01	---	L-CS-172-RP-01	L-CS-172-PP-01	---
175	L-CS-172-RP-01	---	L-CS-172-RP-01	---	---
176	---	---	---	---	---
177	L-CS-163-RP-01	---	---	---	---
178	---	---	---	---	---
179	L-CS-163-RP-01	---	---	---	---

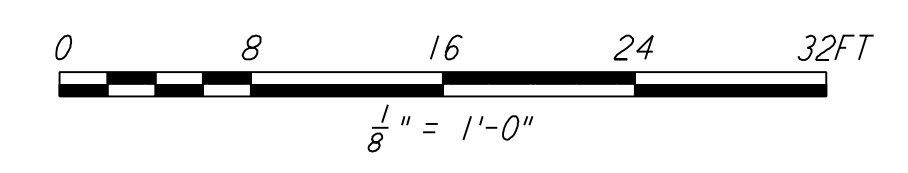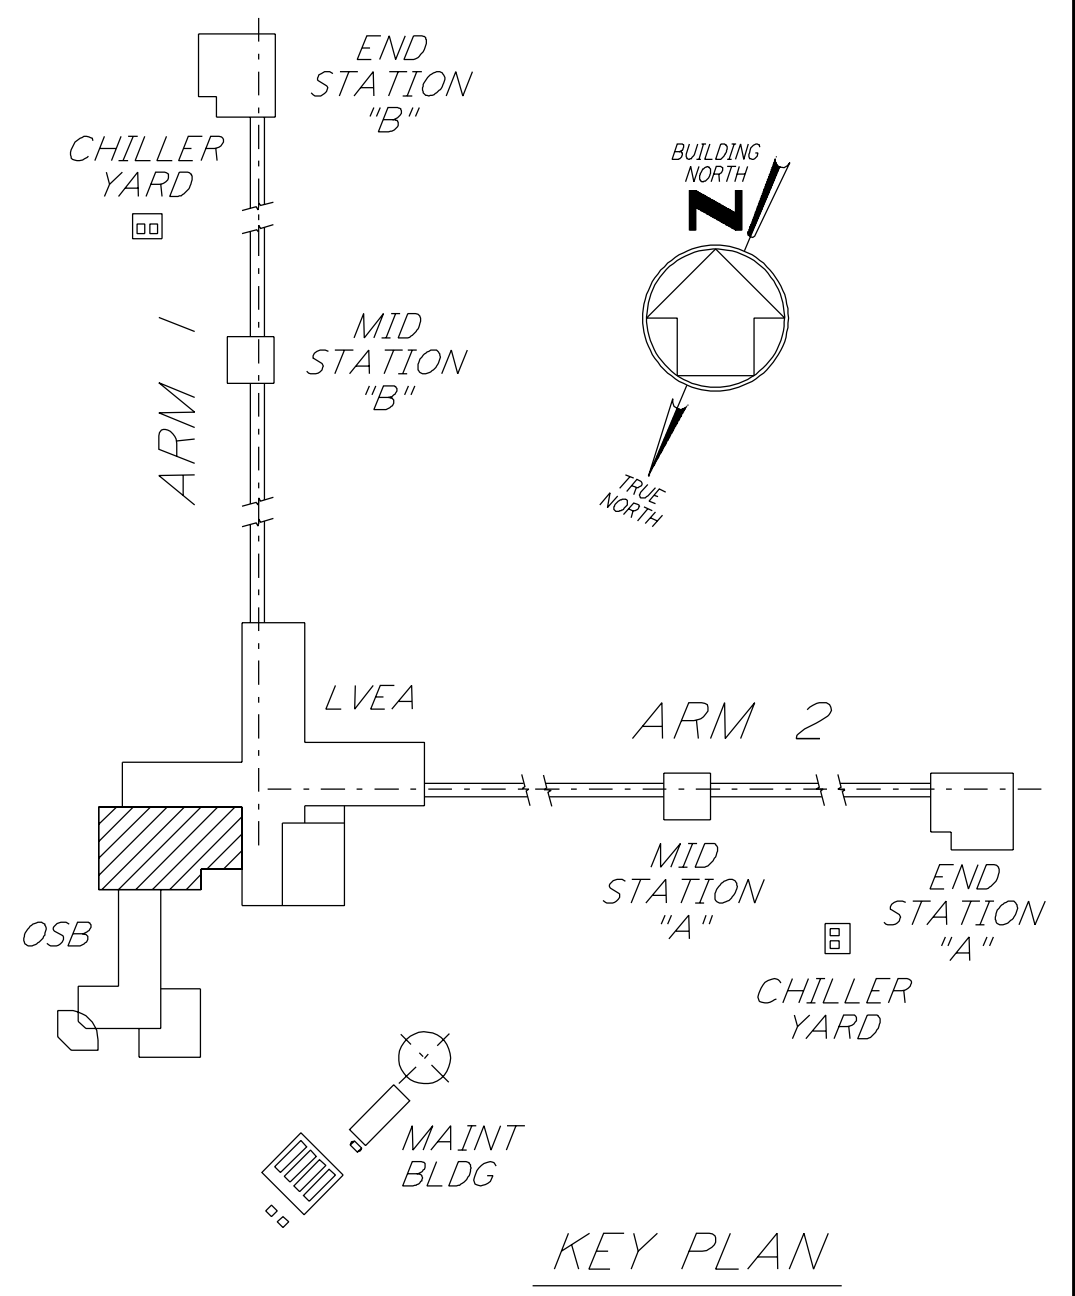

NO.	DATE	BY	CHKD	ENGR	PROJ	DESCRIPTION
1	8-7-98	JE				ISSUED FOR AS-BUILT

ISSUED FOR CONSTRUCTION		
DRAWN	M. M.	11-15-96
CHECKED	JCL	7-24-96
ENGINEER	KCR	10-25-96
PROJ	T. D. M.	11-15-96

**AS-BUILT DRAWINGS**

**PARSONS**  
 100 WEST WALNUT STREET  
 PASADENA, CALIFORNIA

**LIGO**  
 CALIFORNIA INSTITUTE OF TECHNOLOGY  
 MASSACHUSETTS INSTITUTE OF TECHNOLOGY

LASER INTERFEROMETER  
 GRAVITATIONAL-WAVE OBSERVATORY  
 SITE NO. 2 - LIVINGSTON, LOUISIANA

TITLE	SCALE	CONTRACT NUMBER	PROJECT NUMBER
ELECTRICAL CORNER STATION OSB LAB AREA RECEPTACLE & POWER PLAN	NONE	PP150969	8094
SHEET NUMBER		REVISIONS	
<b>LA-E-106</b>			

LIGO-D961008-01-0

*Note 1, LIGO, 02/12/99 09:15:47 AM*  
LIGO-D961008-01-O