
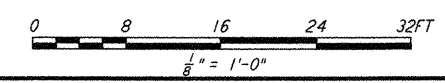
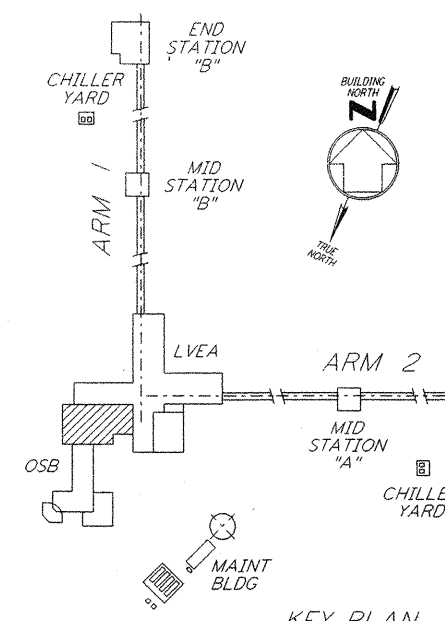
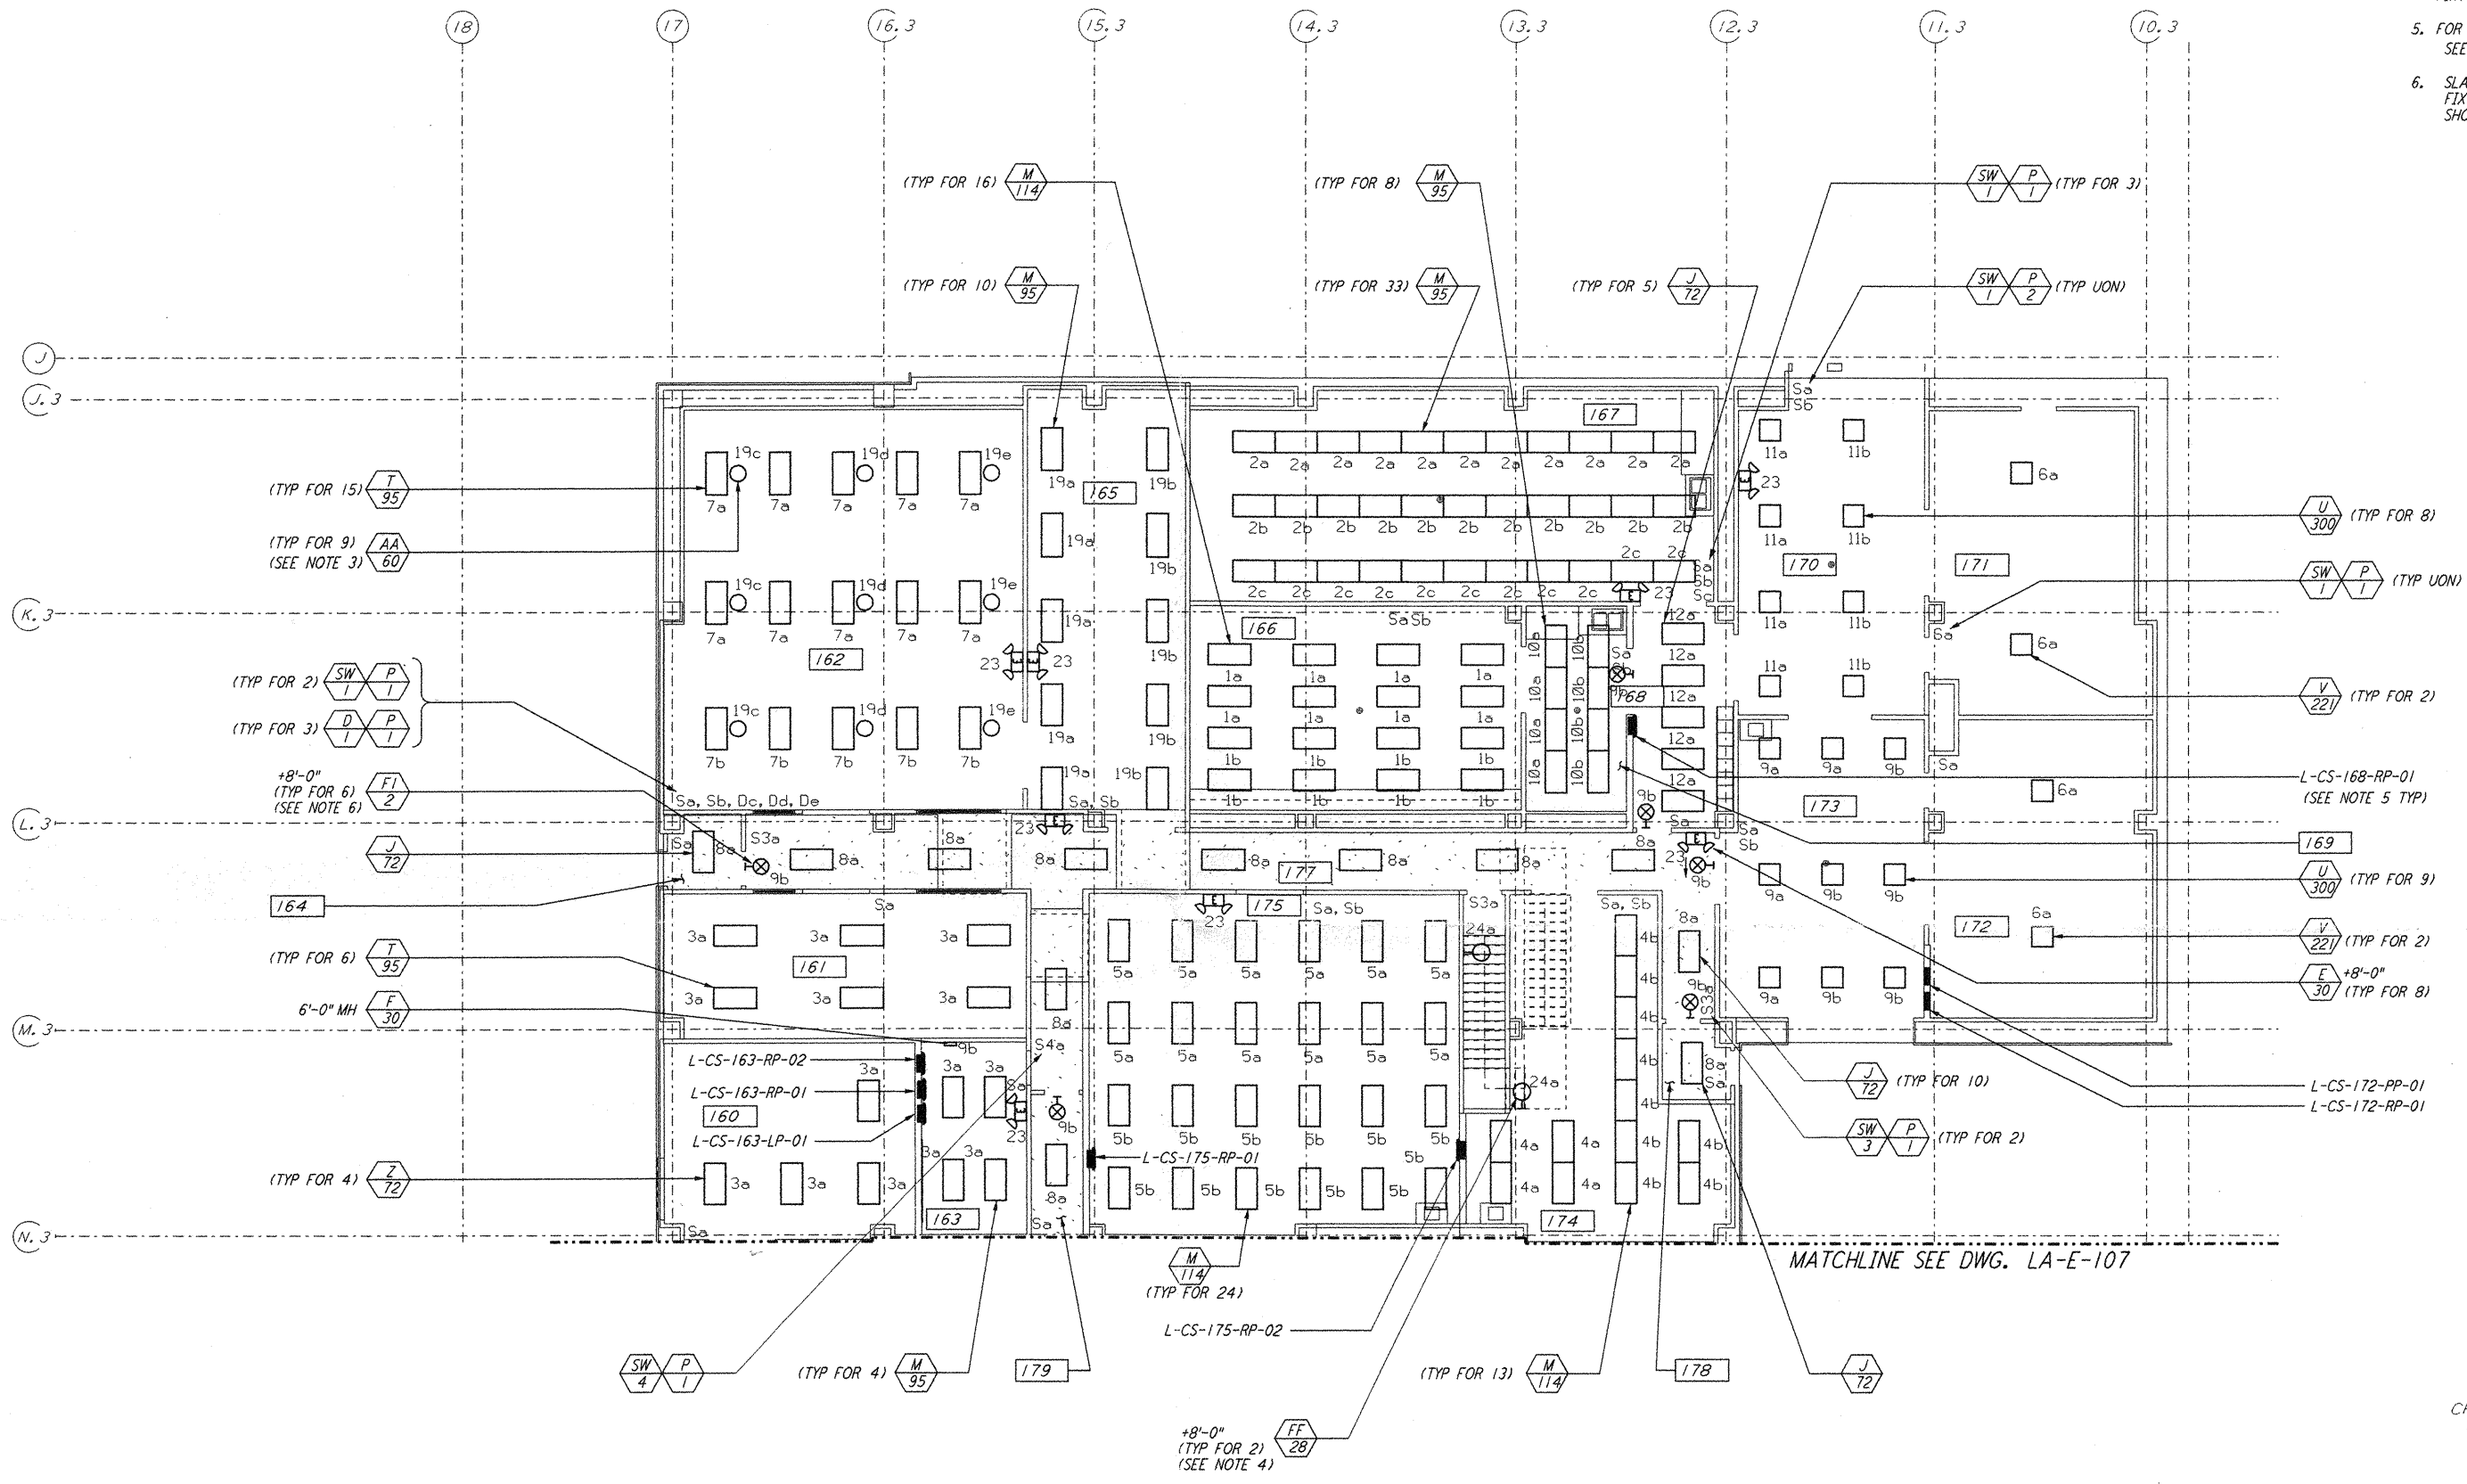


NOTES:

- FOR NOTES AND REFERENCE DRAWINGS SEE DWG. LA-E-107.
- ALL LIGHTING CIRCUITS SHOWN ON THIS DRAWING ARE FROM PANEL L-CS-163-LP-01 UNLESS NOTED OTHERWISE.
- CIRCUIT SHOWN FEEDING THESE LIGHTING FIXTURES IS FROM L-CS-163-RP-01.
- CIRCUIT SHOWN FEEDING THESE LIGHTING FIXTURES IS FROM L-CS-168-RP-01.
- FOR ALL PANEL FEEDER CONDUIT AND WIRE SIZES SEE SINGLE LINE DIAGRAM DWG LA-E-006.
- SLAVE UNIT, CIRCUIT SHOWN FEEDING THESE FIXTURES IS FROM L-CS-144-LP-01 VIA TYPE F-30 FIXTURE SHOWN ON THIS DWG.

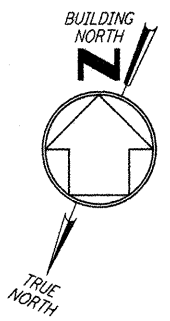

This document and the design it covers are the property of PARSONS. They are loaned only with the borrower's expressed written agreement that they will not be reproduced, copied, loaned, exhibited, or used in any other way, except by written consent from PARSONS to the borrower.

NO.	DATE	BY	CHKD	ENGR	PROJ	DESCRIPTION
1	8-7-98	JF				ISSUED FOR AS-BUILT

ISSUED FOR CONSTRUCTION	
DRAWN	M. M. 11-15-96
CHECKED	KCL 7-24-96
ENGINEER	KCR 10-25-96
PROJ	T. D. M. 11-15-96
AS-BUILT DRAWINGS	

PARSONS
 100 WEST WALNUT STREET
 PASADENA, CALIFORNIA

LIGO
 CALIFORNIA INSTITUTE OF TECHNOLOGY
 MASSACHUSETTS INSTITUTE OF TECHNOLOGY

LIGO-D961010-01-O		
LASER INTERFEROMETER GRAVITATIONAL-WAVE OBSERVATORY SITE NO. 2 - LIVINGSTON, LOUISIANA		
TITLE	SCALE	PROJECT NUMBER
ELECTRICAL CORNER STATION OSB LAB AREA LIGHTING PLAN	AS NOTED	PP150969 8094
SHEET NUMBER		REVISIONS
LA-E-108		