


not be reproduced, copied, loaned, exhibited, or used in any other way, except by written consent from PARSONS to the borrower.

This document and the design it covers are the property of PARSONS. They are loaned only with the borrower's expressed written agreement that they will not be reproduced, copied, loaned, exhibited, or used in any other way, except by written consent from PARSONS to the borrower.

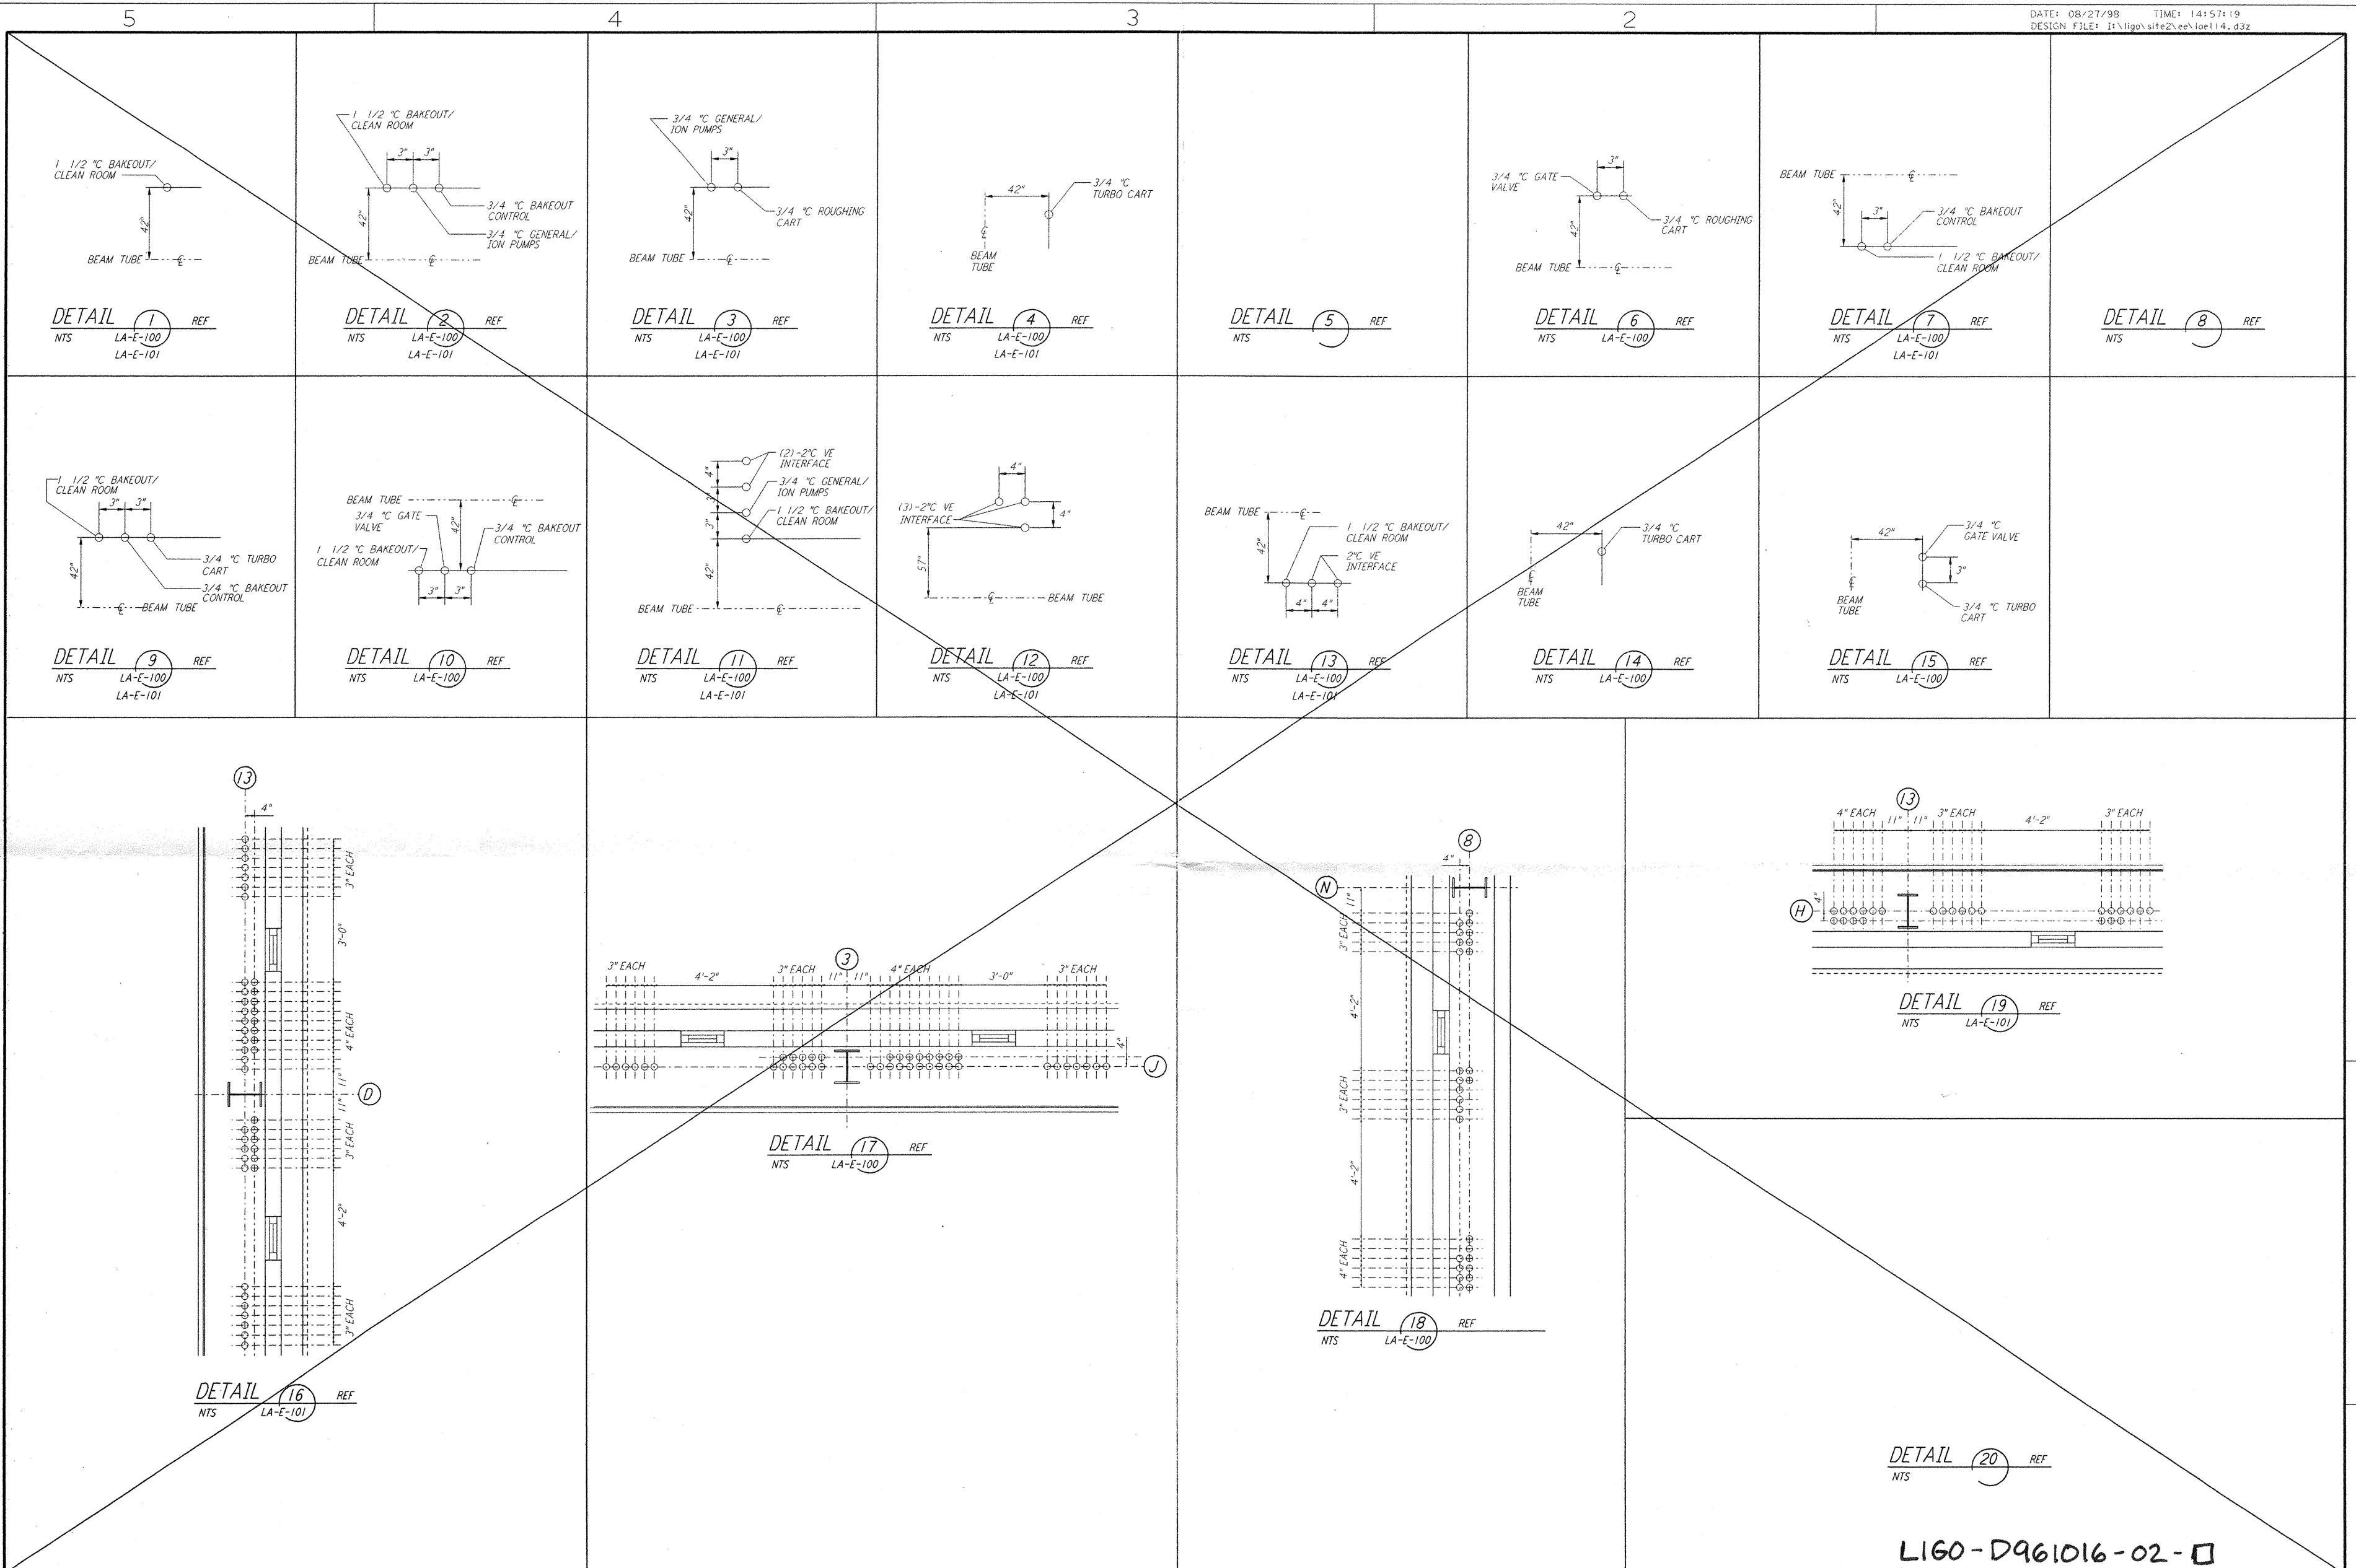

NO.	DATE	BY	CHKD	ENGR	PRJG	DESCRIPTION
2	8-7-98	JE	AK	AK	AK	ISSUED FOR AS-BUILT
1	3-21-97	J. G.	BN	KCR	T. D. M.	ISSUED FOR DELETE

ISSUED FOR CONSTRUCTION  
 DRAWN M. M. 11-15-96  
 CHECKED J. C. L. 7-24-96  
 ENGINEER K. C. R. 10-25-96  
 PROJ T. D. M. 11-15-96  
**AS-BUILT DRAWINGS**

**PARSONS**  
 100 WEST WALNUT STREET  
 PASADENA, CALIFORNIA

**LIGO**  
 CALIFORNIA INSTITUTE OF TECHNOLOGY  
 MASSACHUSETTS INSTITUTE OF TECHNOLOGY

LASER INTERFEROMETER  
 GRAVITATIONAL-WAVE OBSERVATORY  
 SITE NO. 2 - LIVINGSTON, LOUISIANA  
 TITLE: ELECTRICAL CORNER STATION LVEA AREAS 101, 102, 103, 104 DETAILS  
 SCALE: NONE  
 CORRECT NUMBER: PPI50969  
 PROJECT NUMBER: 8094  
**LA-E-114**