



POWER PLAN
 1/8" = 1'-0"

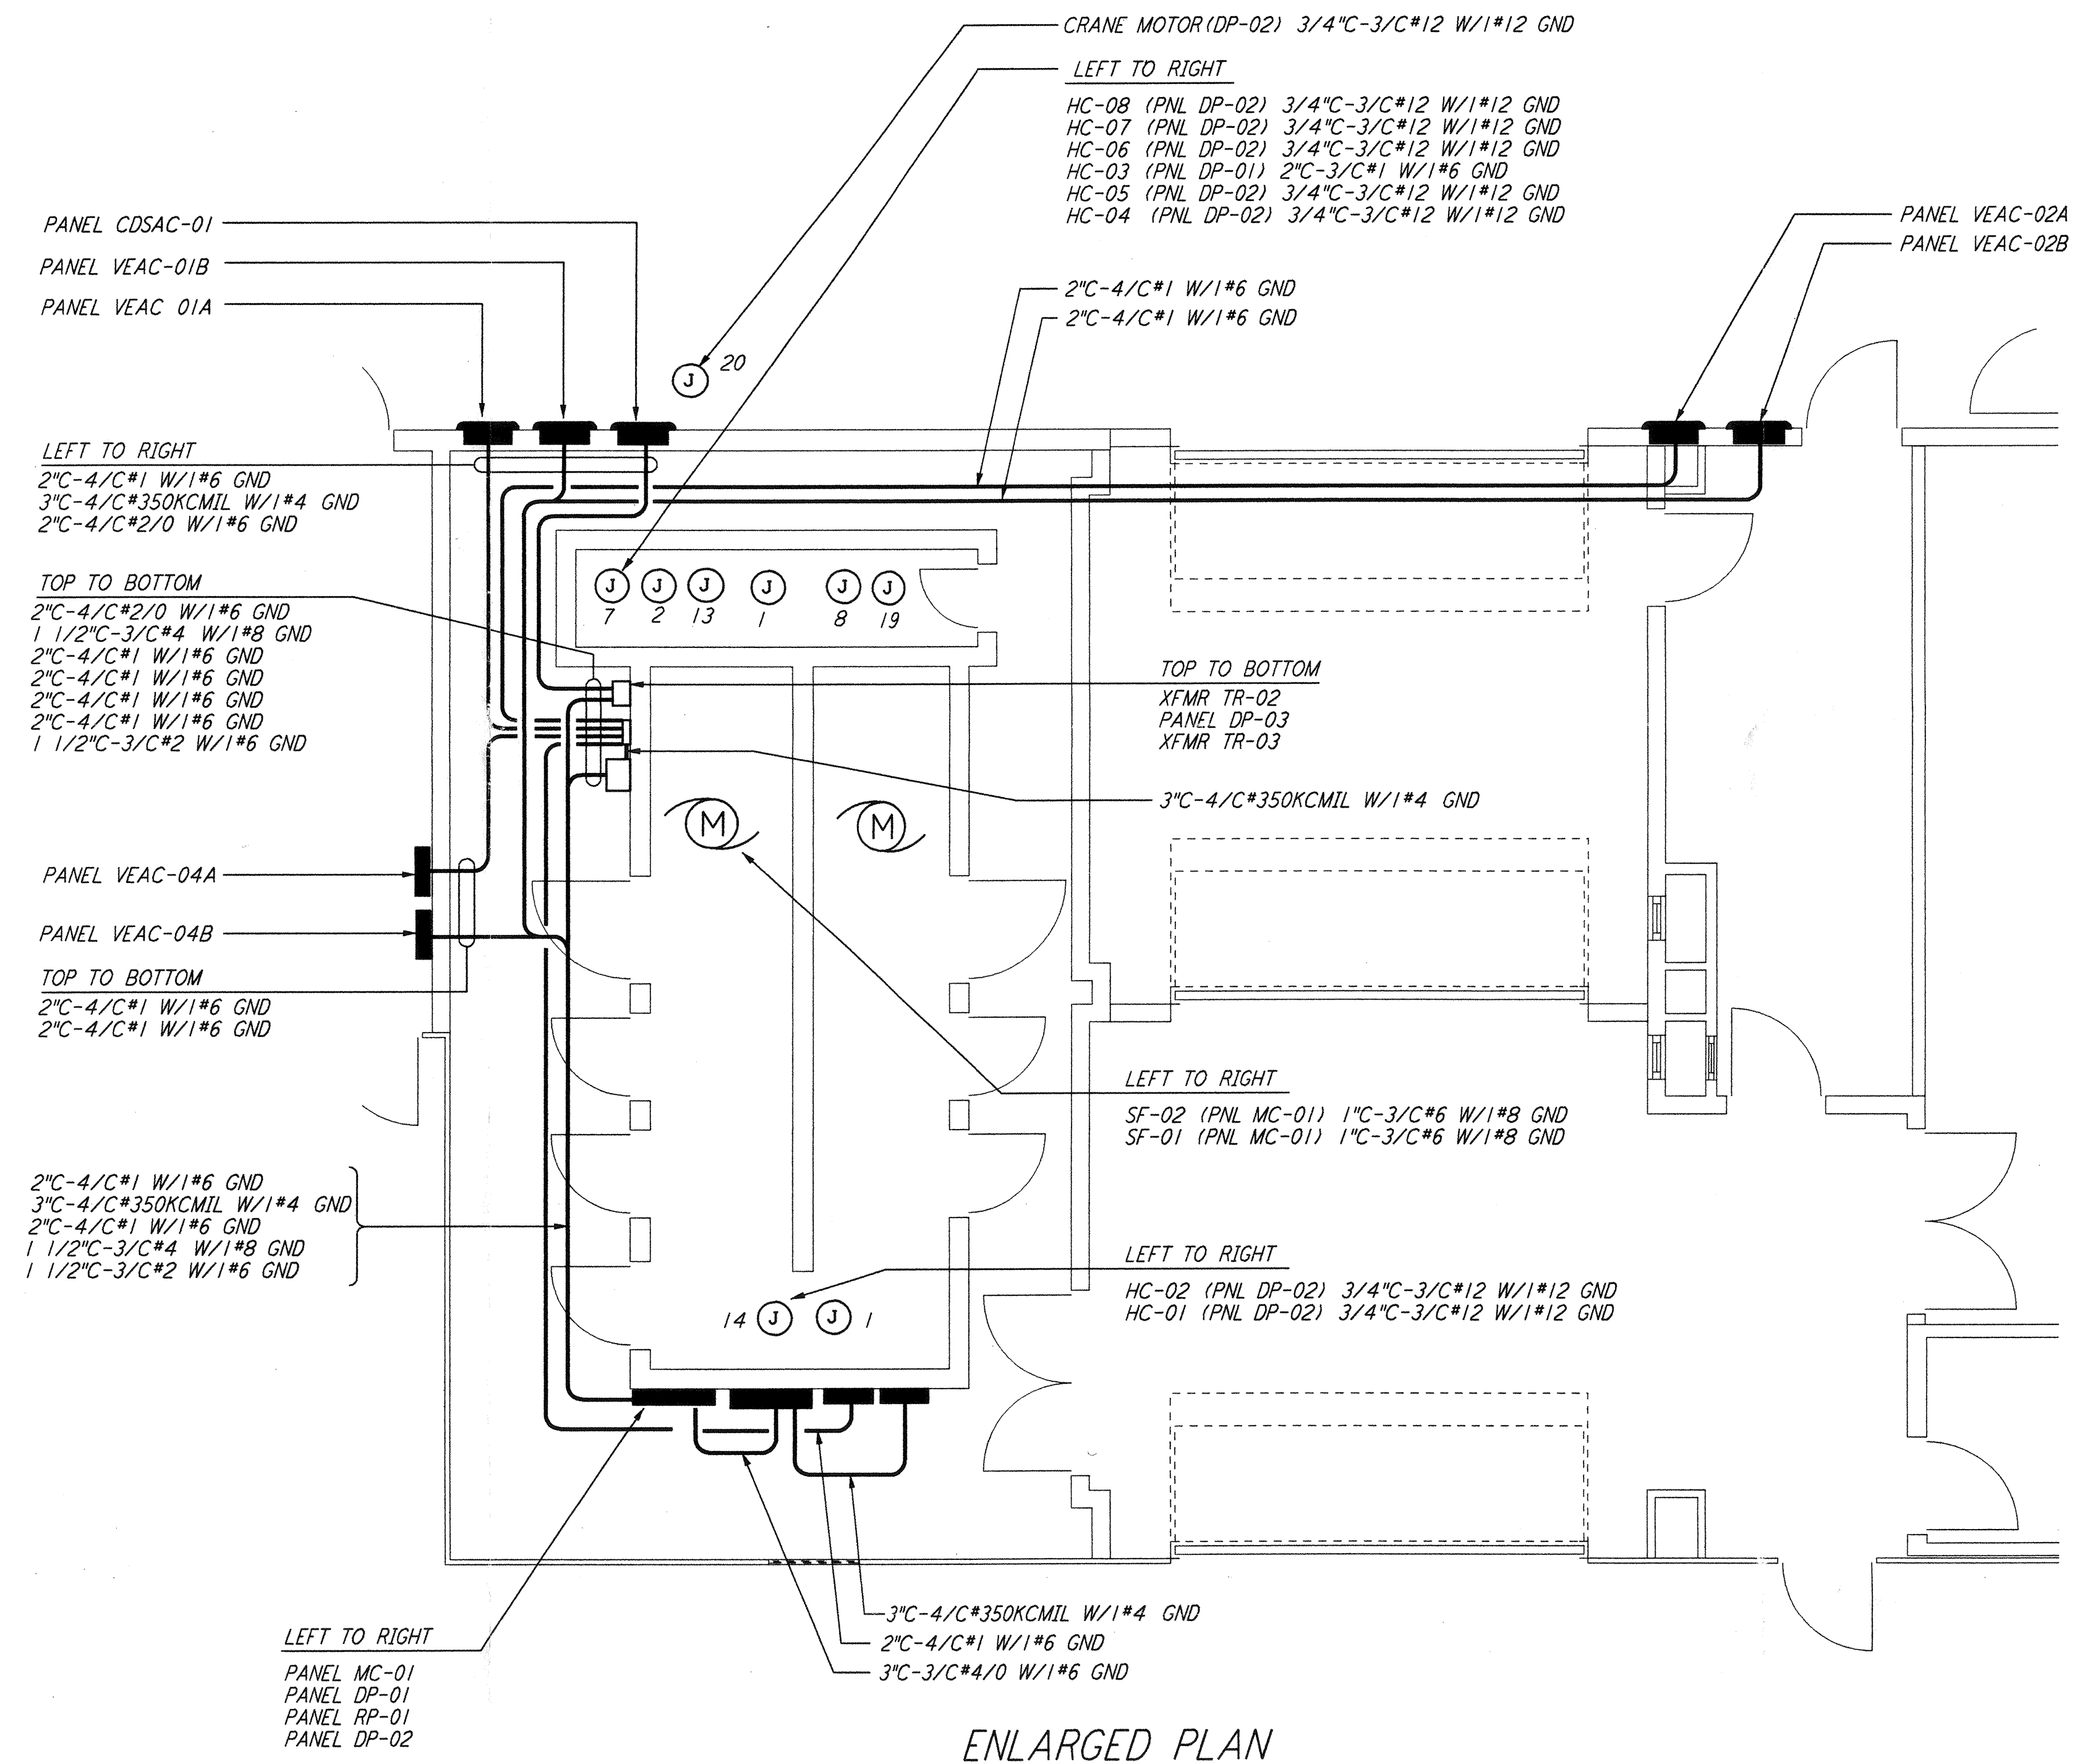


ENLARGED PLAN
 1/4" = 1'-0"

- NOTES:**
- FOR STANDARD SYMBOLS, ABBREVIATIONS AND ACRONYMS SEE DWG. LA-E-001.
 - FOR ELECTRICAL SYMBOLS SEE DWG. LA-E-002.
 - FOR STANDARD INSTALLATION DETAILS SEE DWG. LA-E-404 AND LA-E-409.
 - FOR CABLE TYPE DESCRIPTION SEE DWG. LA-E-007.
 - ALL CONDUIT RUNS ARE SHOWN DIAGRAMMATICALLY ONLY, CONTRACTOR SHALL COORDINATE INSTALLATION WITH OTHER DISCIPLINES.
 - FOR SINGLE LINE DIAGRAM, SEE DWG. LA-E-008.
 - FOR EQUIPMENT LOCATION, SEE HVAC DWG. LA-H-211.
 - ALL CIRCUITS SHOWN ON THIS DRAWING ARE FROM PANEL RP01 UNLESS OTHERWISE NOTED.
 - CIRCUIT SHOWN FEEDING THESE ITEMS ARE FROM DP-02.
 - PANEL SCHEDULES ARE SHOWN ON DRAWINGS LA-E-205 AND LA-E-206.

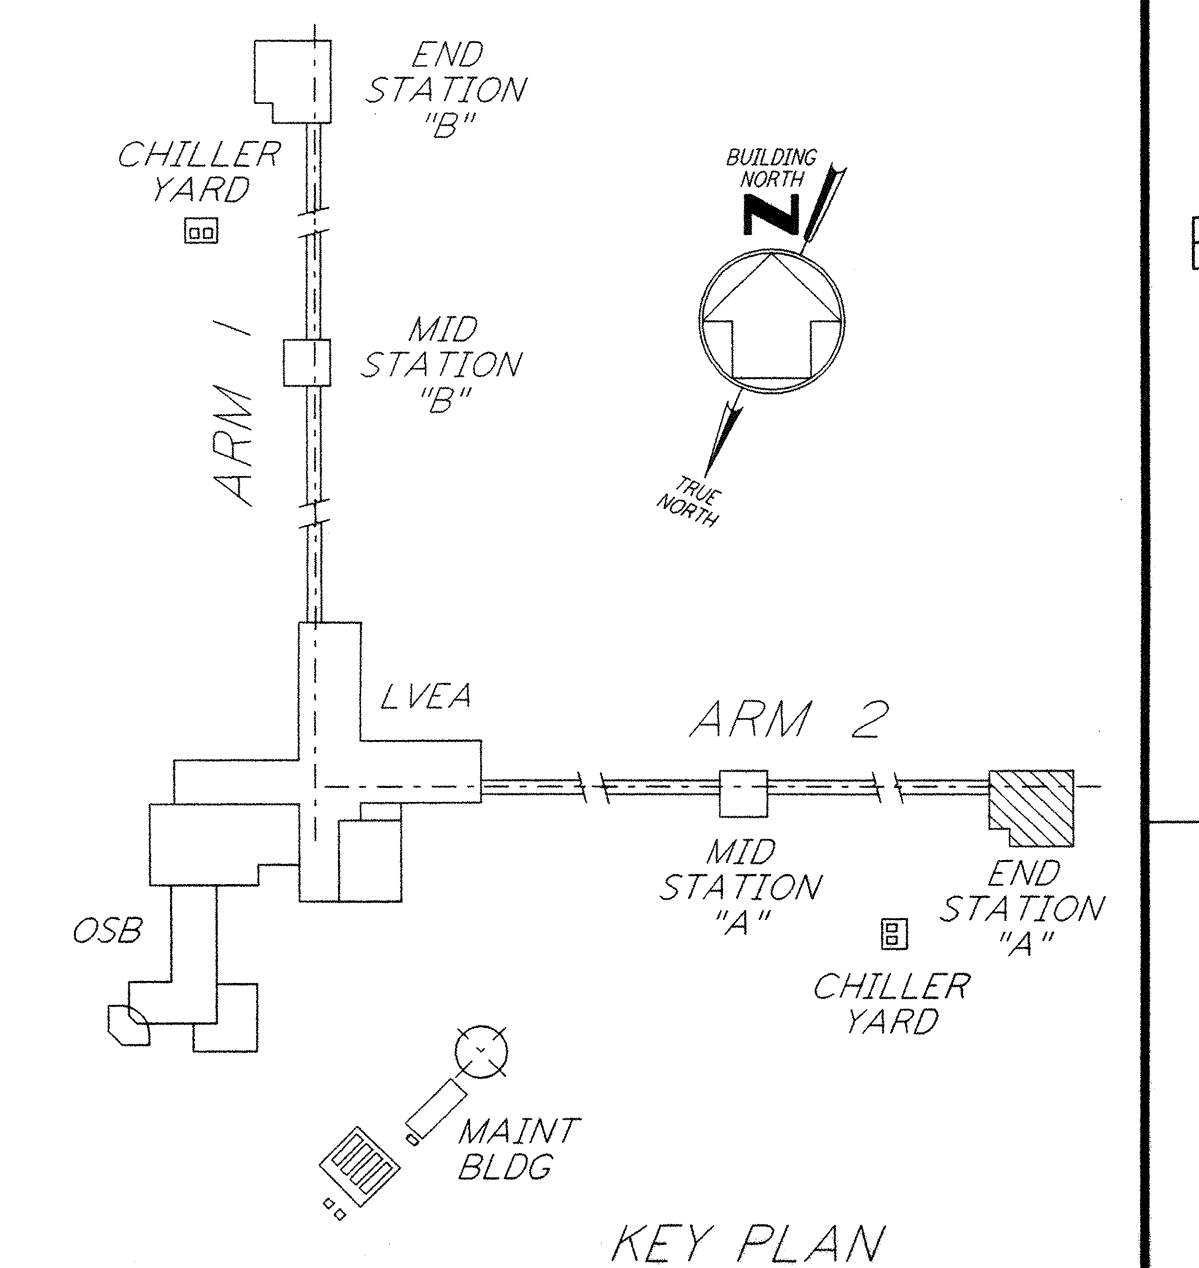

KEY PLAN
 LIGO-D961028-02-0

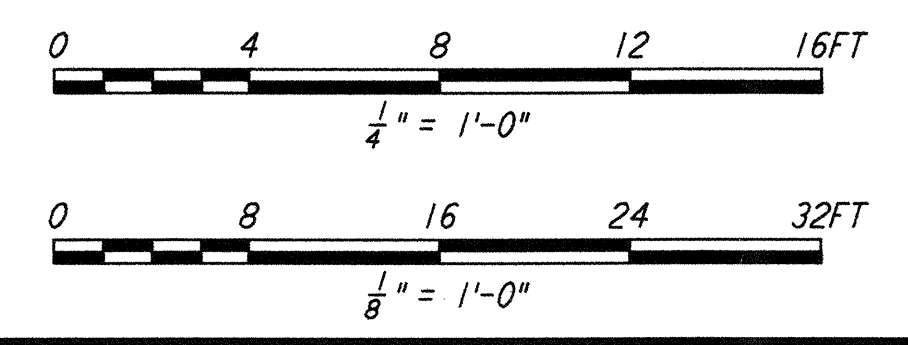

not be reproduced, copied, loaned, exhibited, or used in any other way, except by written consent from PARSONS to the borrower.

This document and the design it covers are the property of PARSONS. They are loaned only with the borrower's expressed written agreement that they will

NO.	DATE	BY	CHKD	ENGR	PROJ	DESCRIPTION
2	8-7-98	JE	RDC	KCR	T.D.M.	ISSUED FOR AS-BUILT GENERAL REVISIONS
1	2-28-97	J.G.	RDC	KCR	T.D.M.	ISSUED FOR CONSTRUCTION

ISSUED FOR CONSTRUCTION
 DRAWN M.M. 11-15-96
 CHECKED J.C.L. 7-24-96
 ENGINEER K.C.R. 10-25-96
 PROJ T.D.M. 11-15-96

AS-BUILT DRAWINGS

PARSONS
 100 WEST WALNUT STREET
 PASADENA, CALIFORNIA

LIGO
 CALIFORNIA INSTITUTE OF TECHNOLOGY
 MASSACHUSETTS INSTITUTE OF TECHNOLOGY

LASER INTERFEROMETER GRAVITATIONAL-WAVE OBSERVATORY SITE NO. 2 - LIVINGSTON, LOUISIANA	
TITLE	AS NOTED PP150969 8094
ELECTRICAL END STATION A ABOVEGROUND POWER PLAN	LA-E-204