
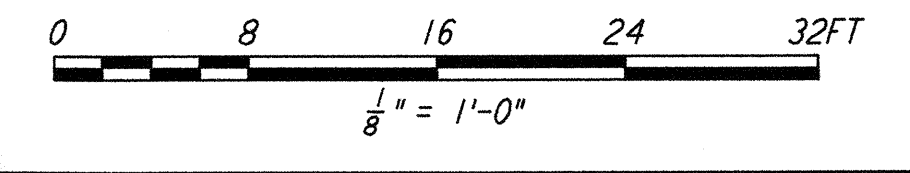
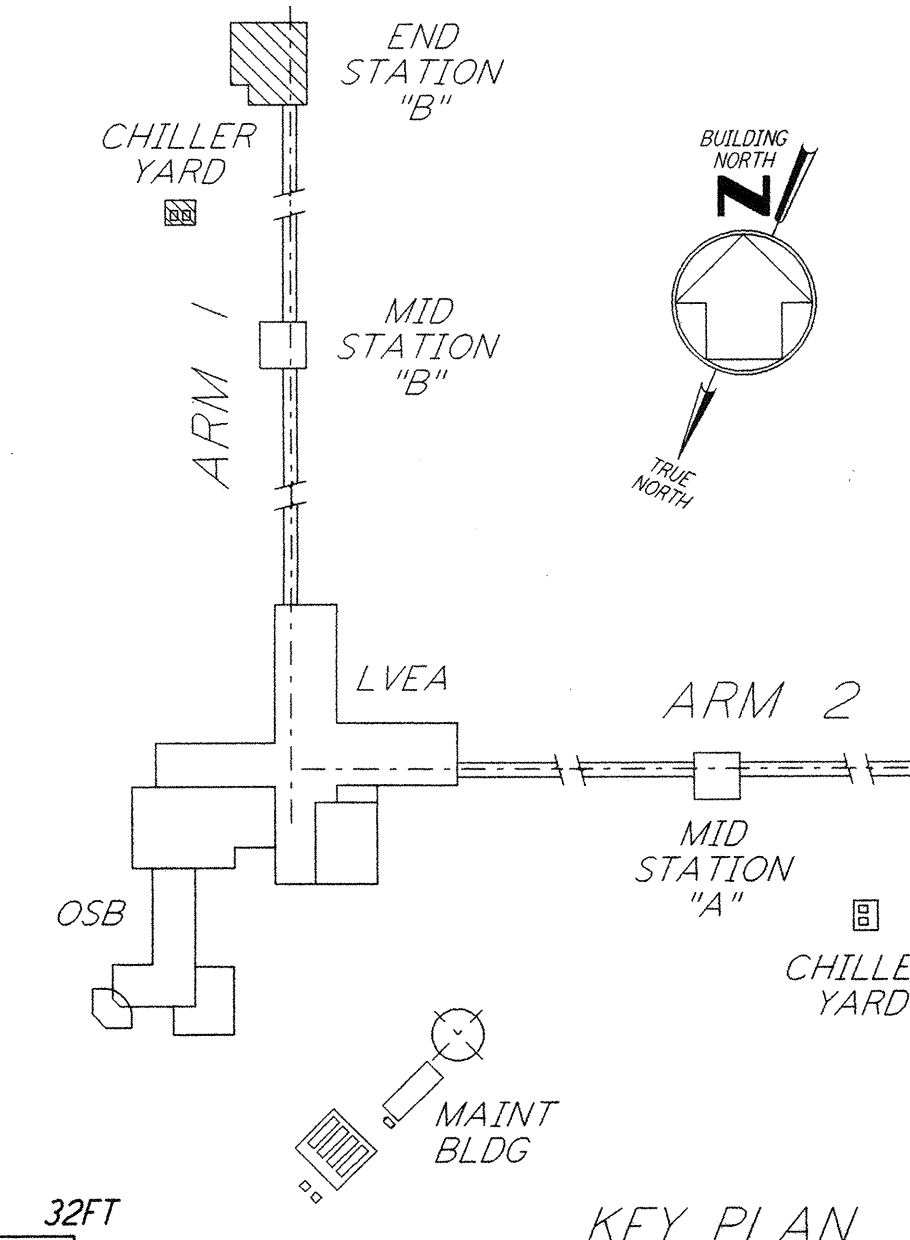
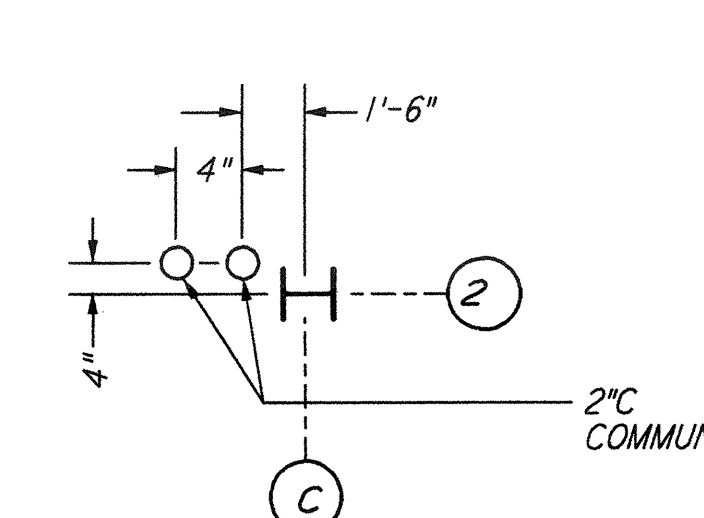
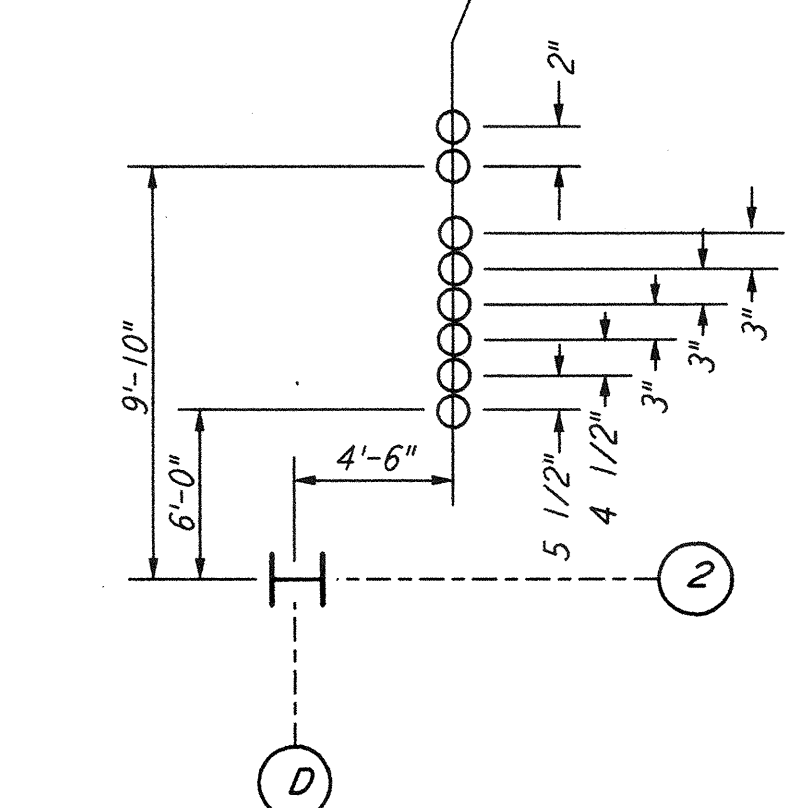
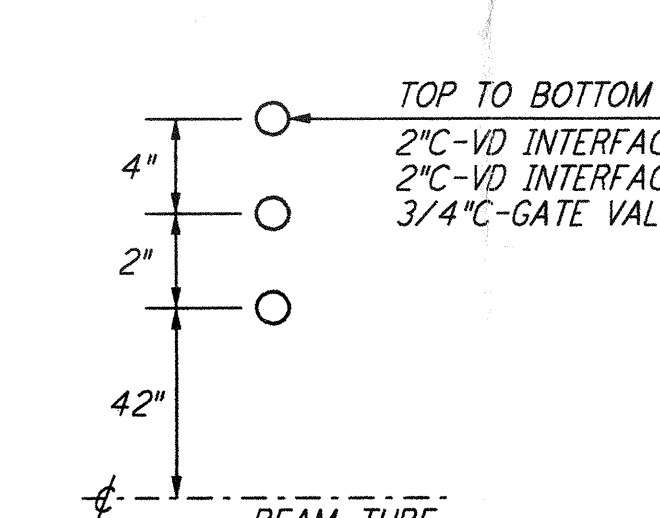
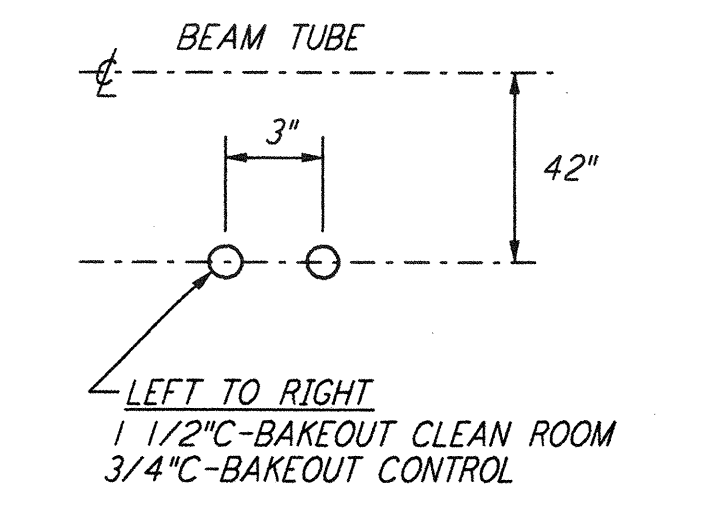
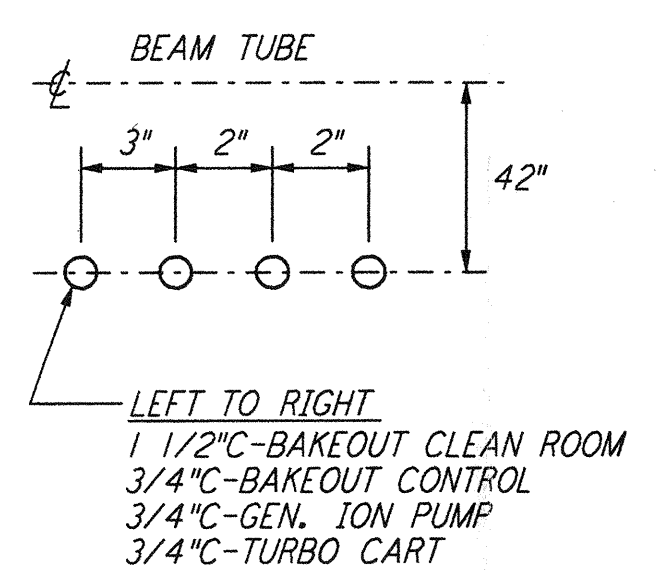
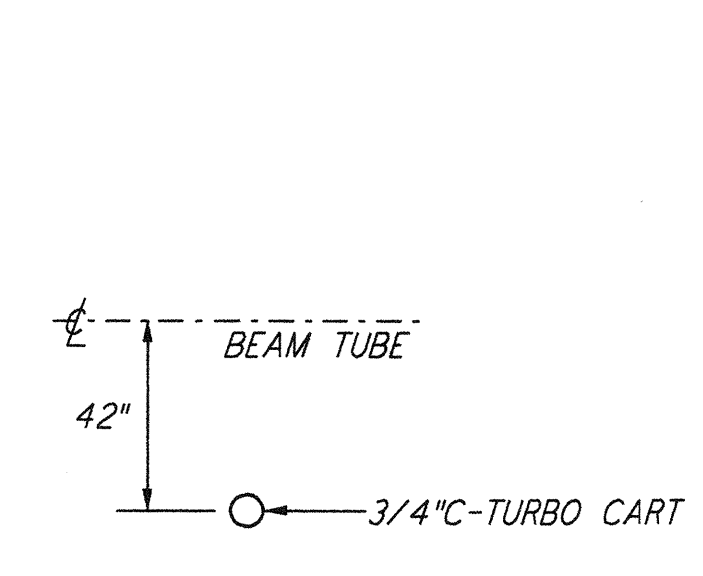
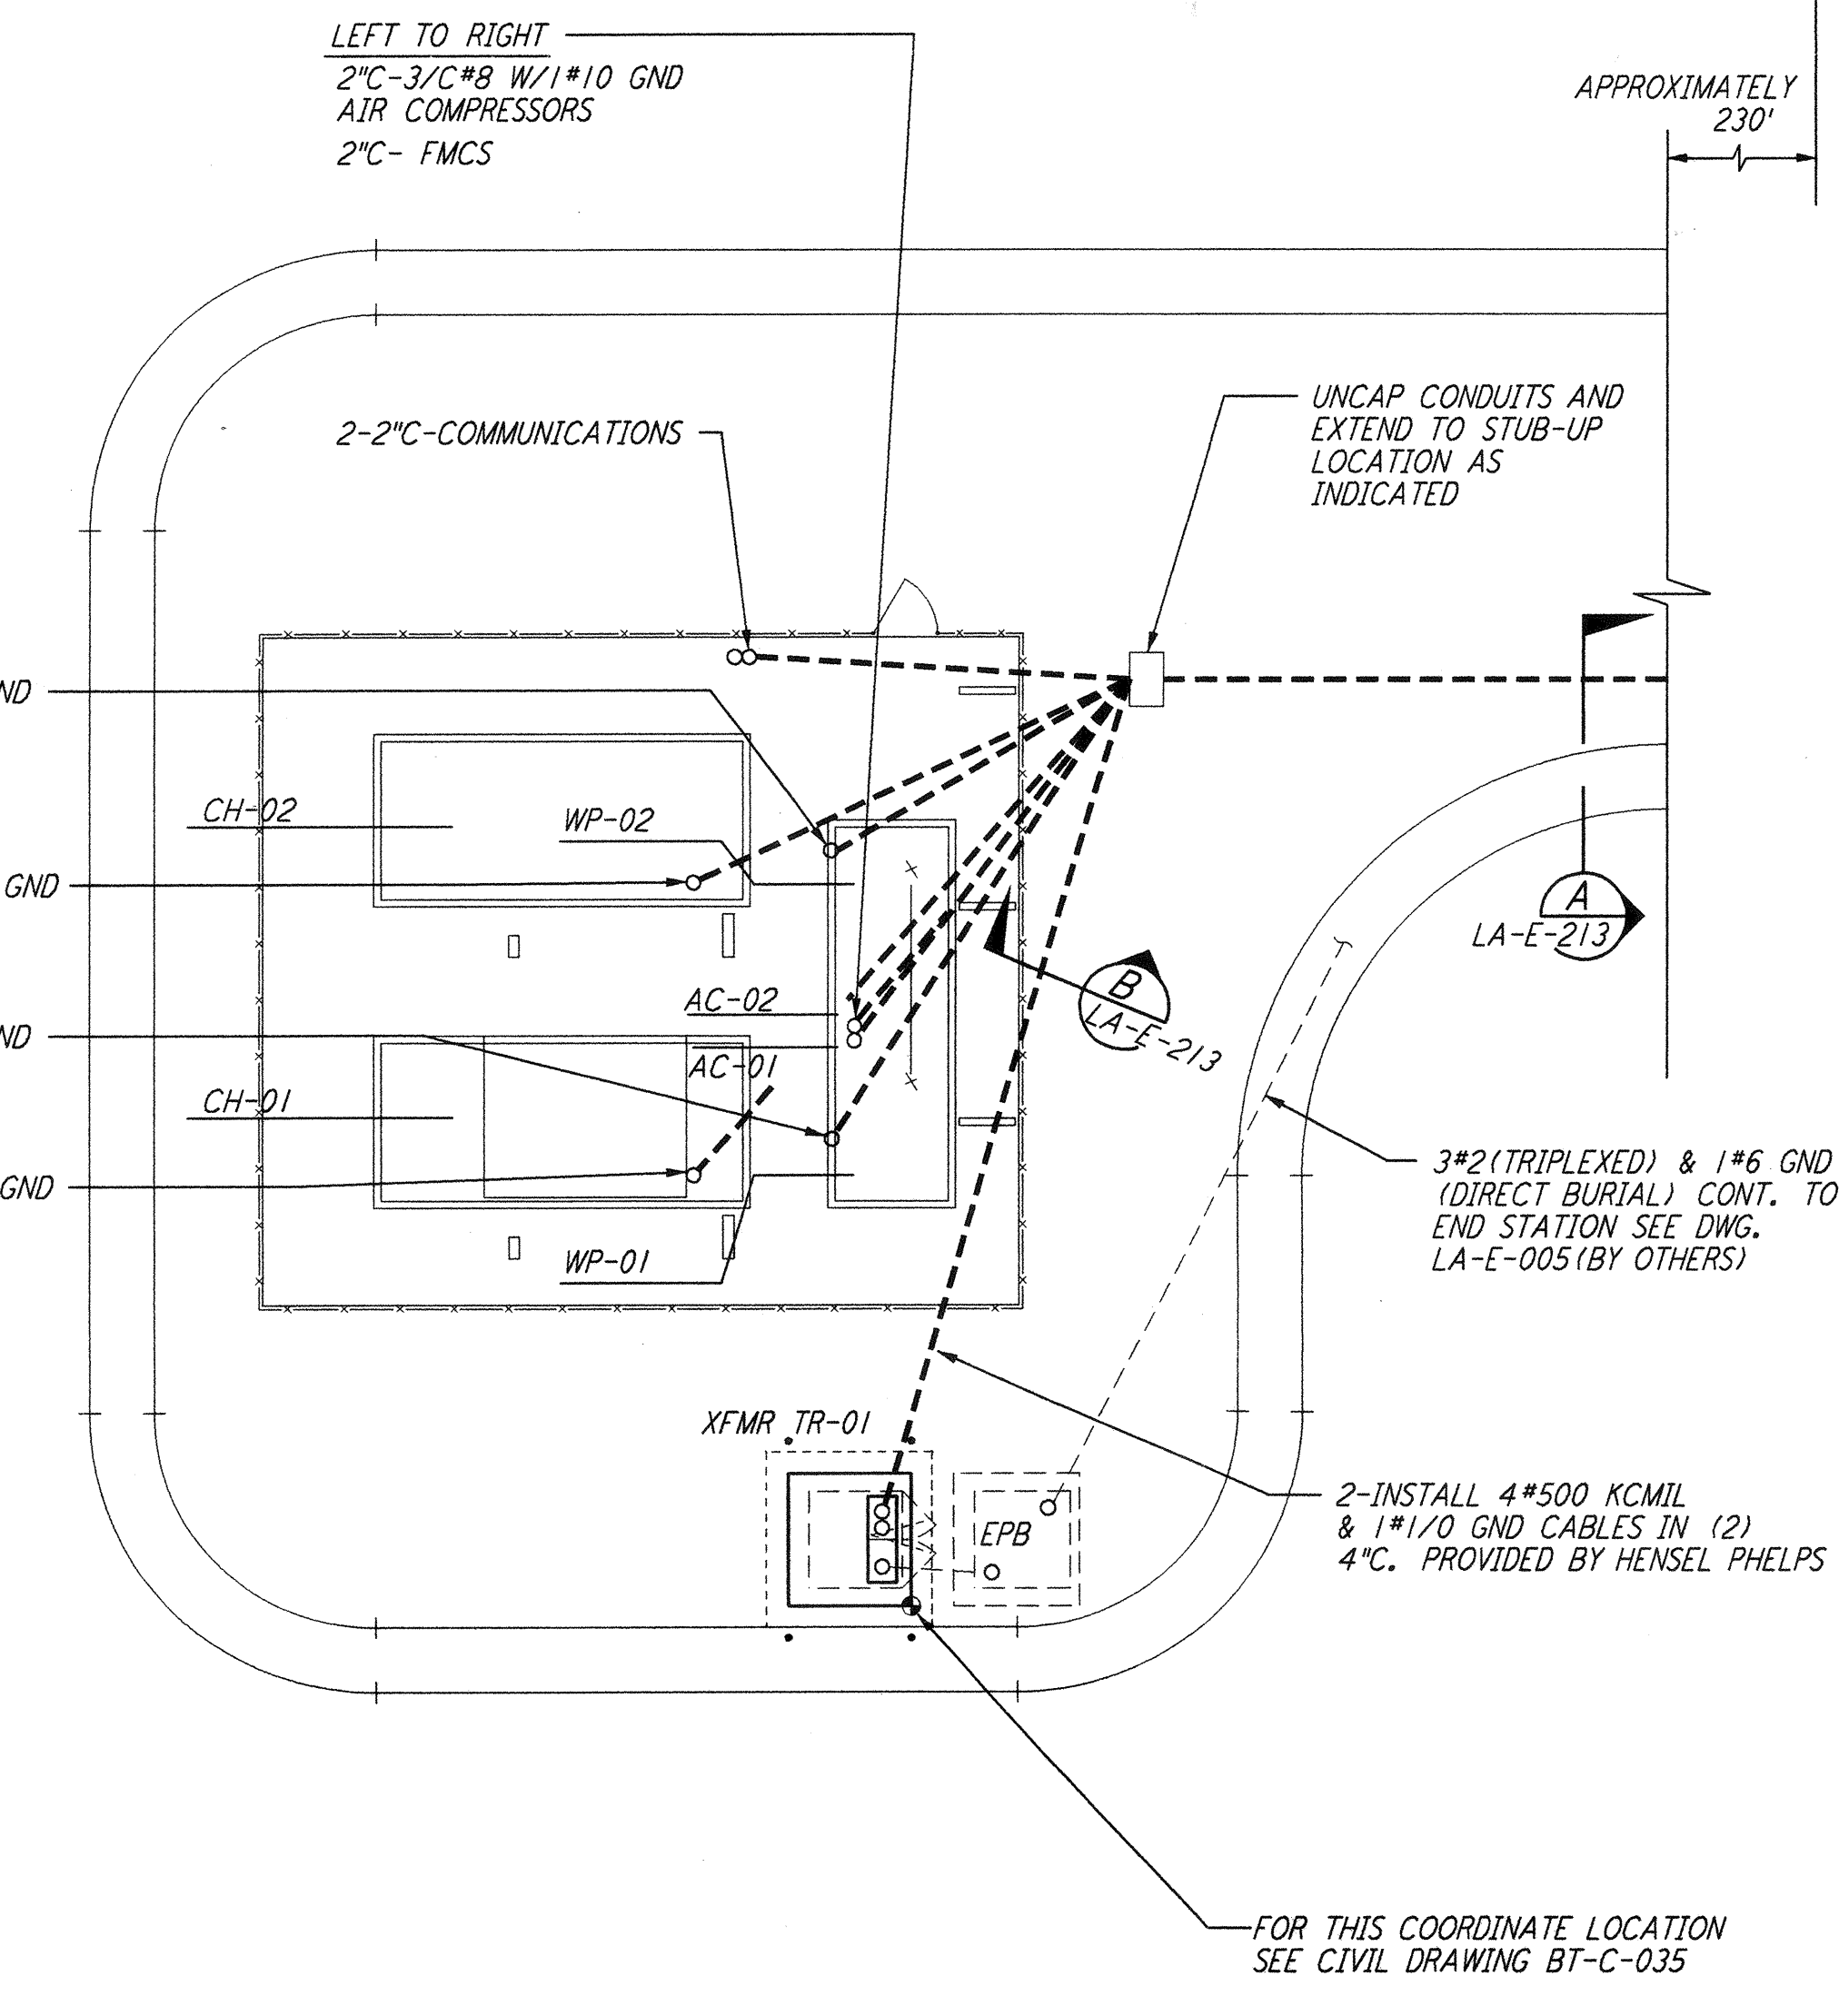
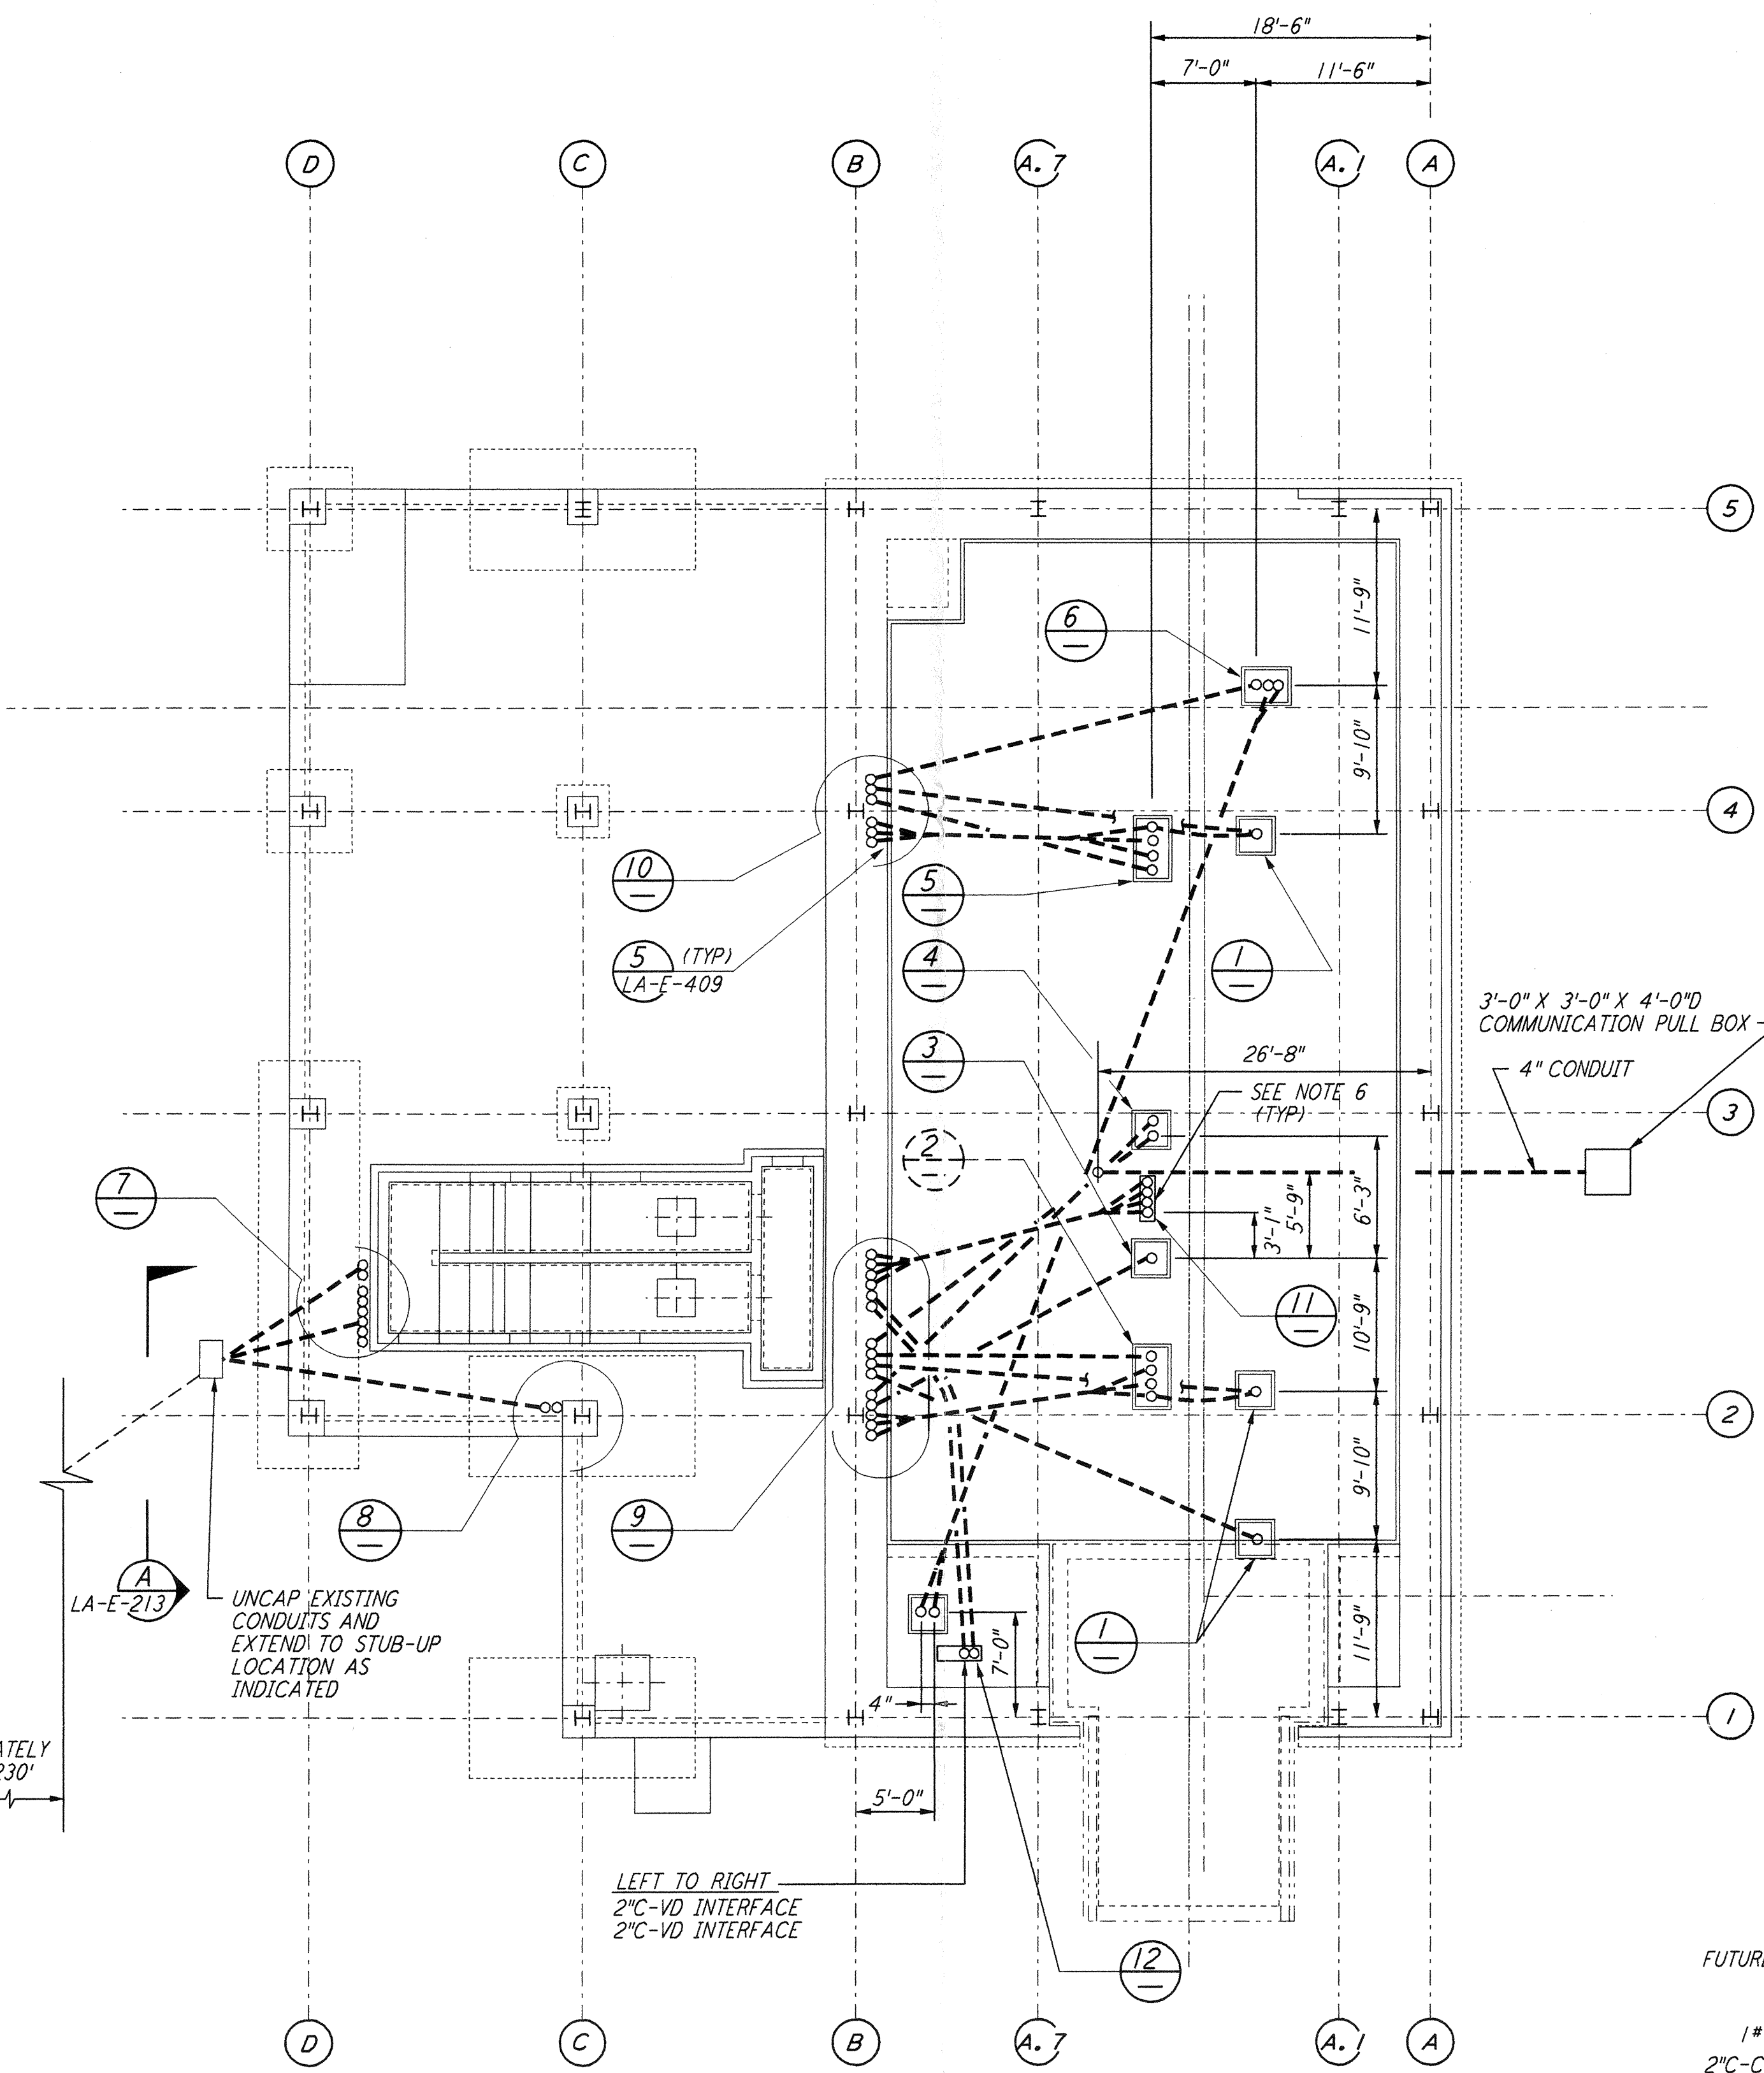
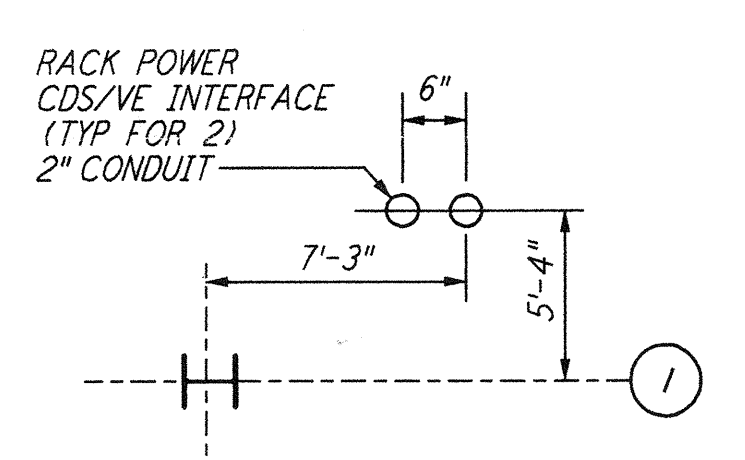
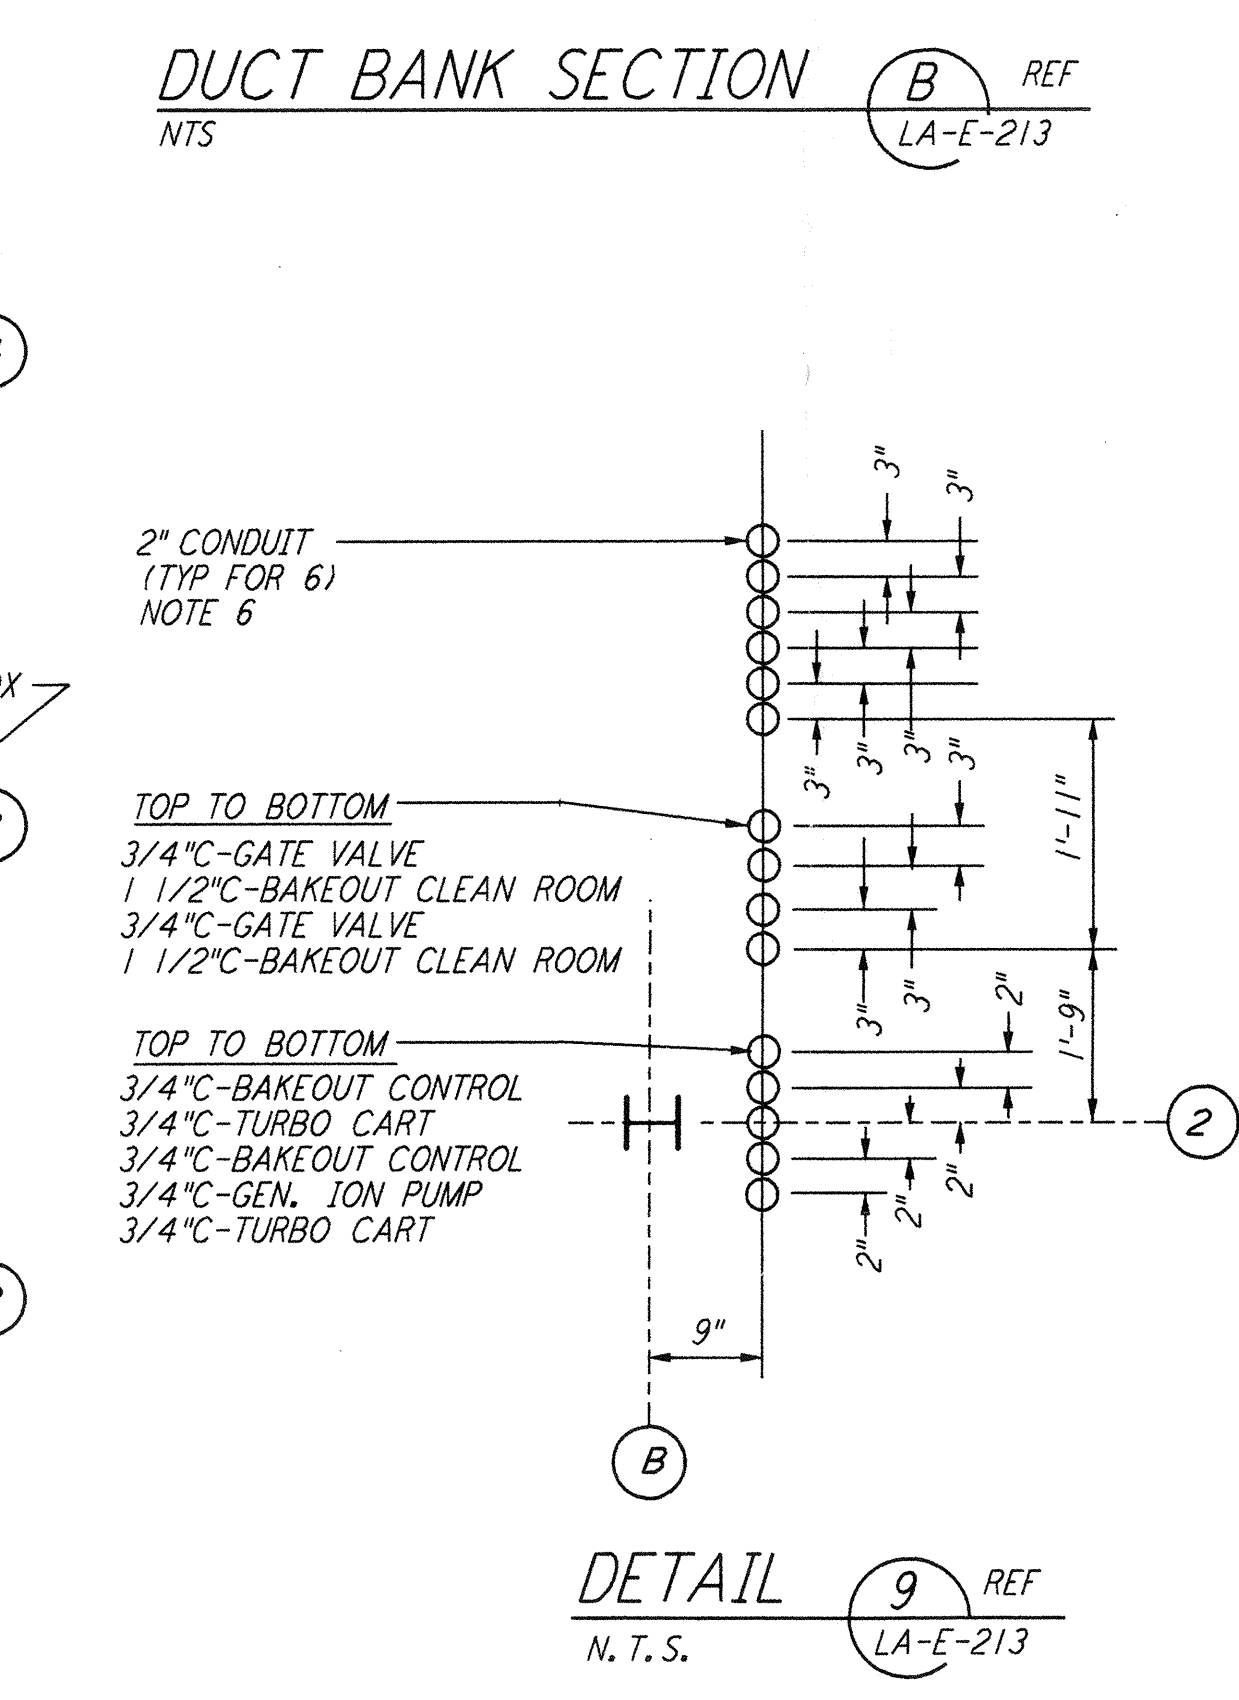
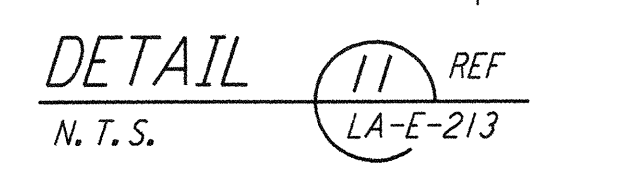
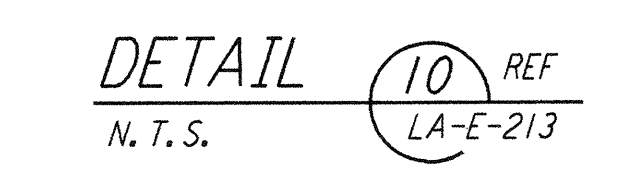
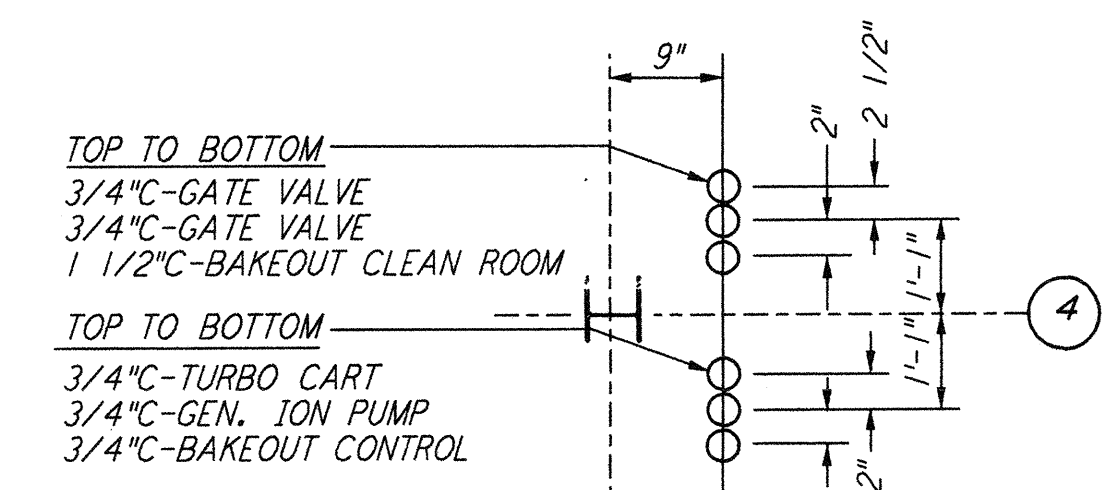
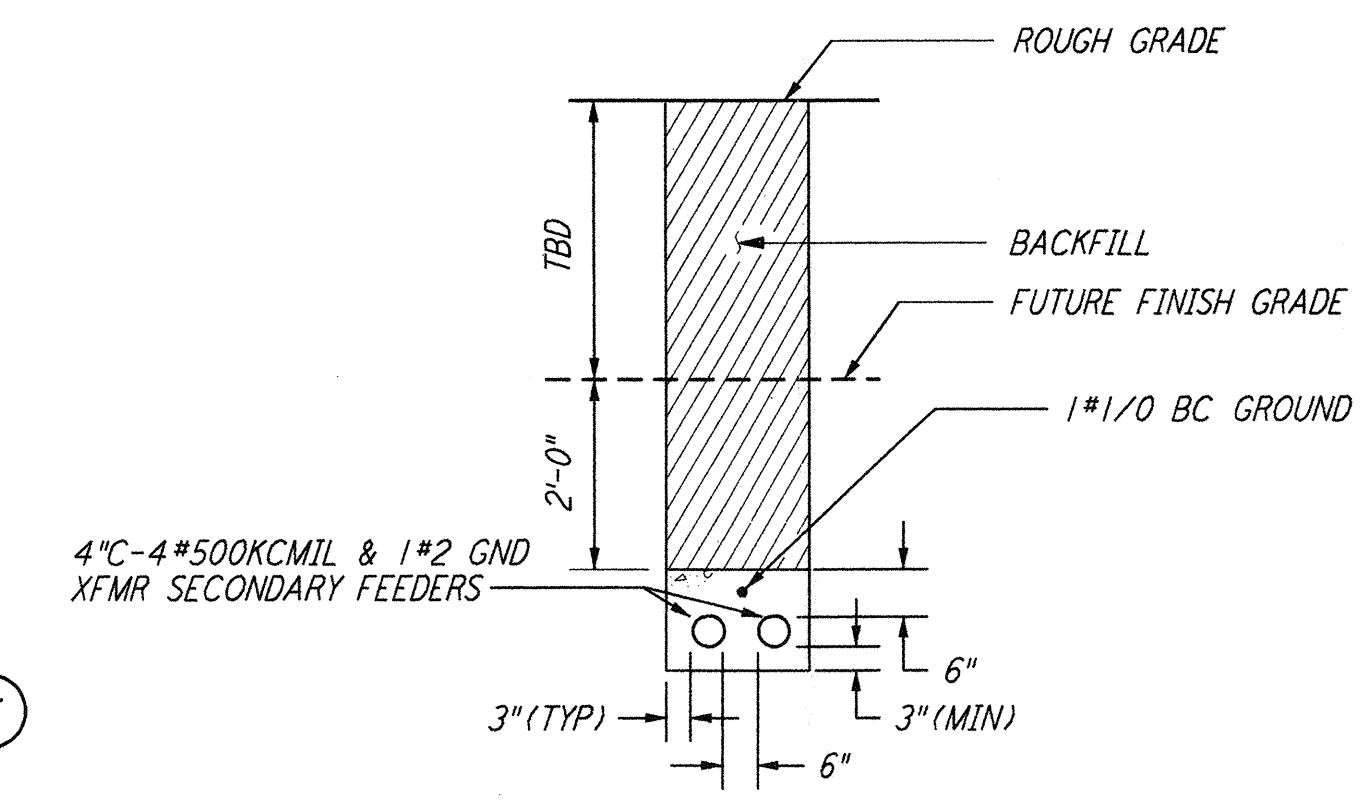
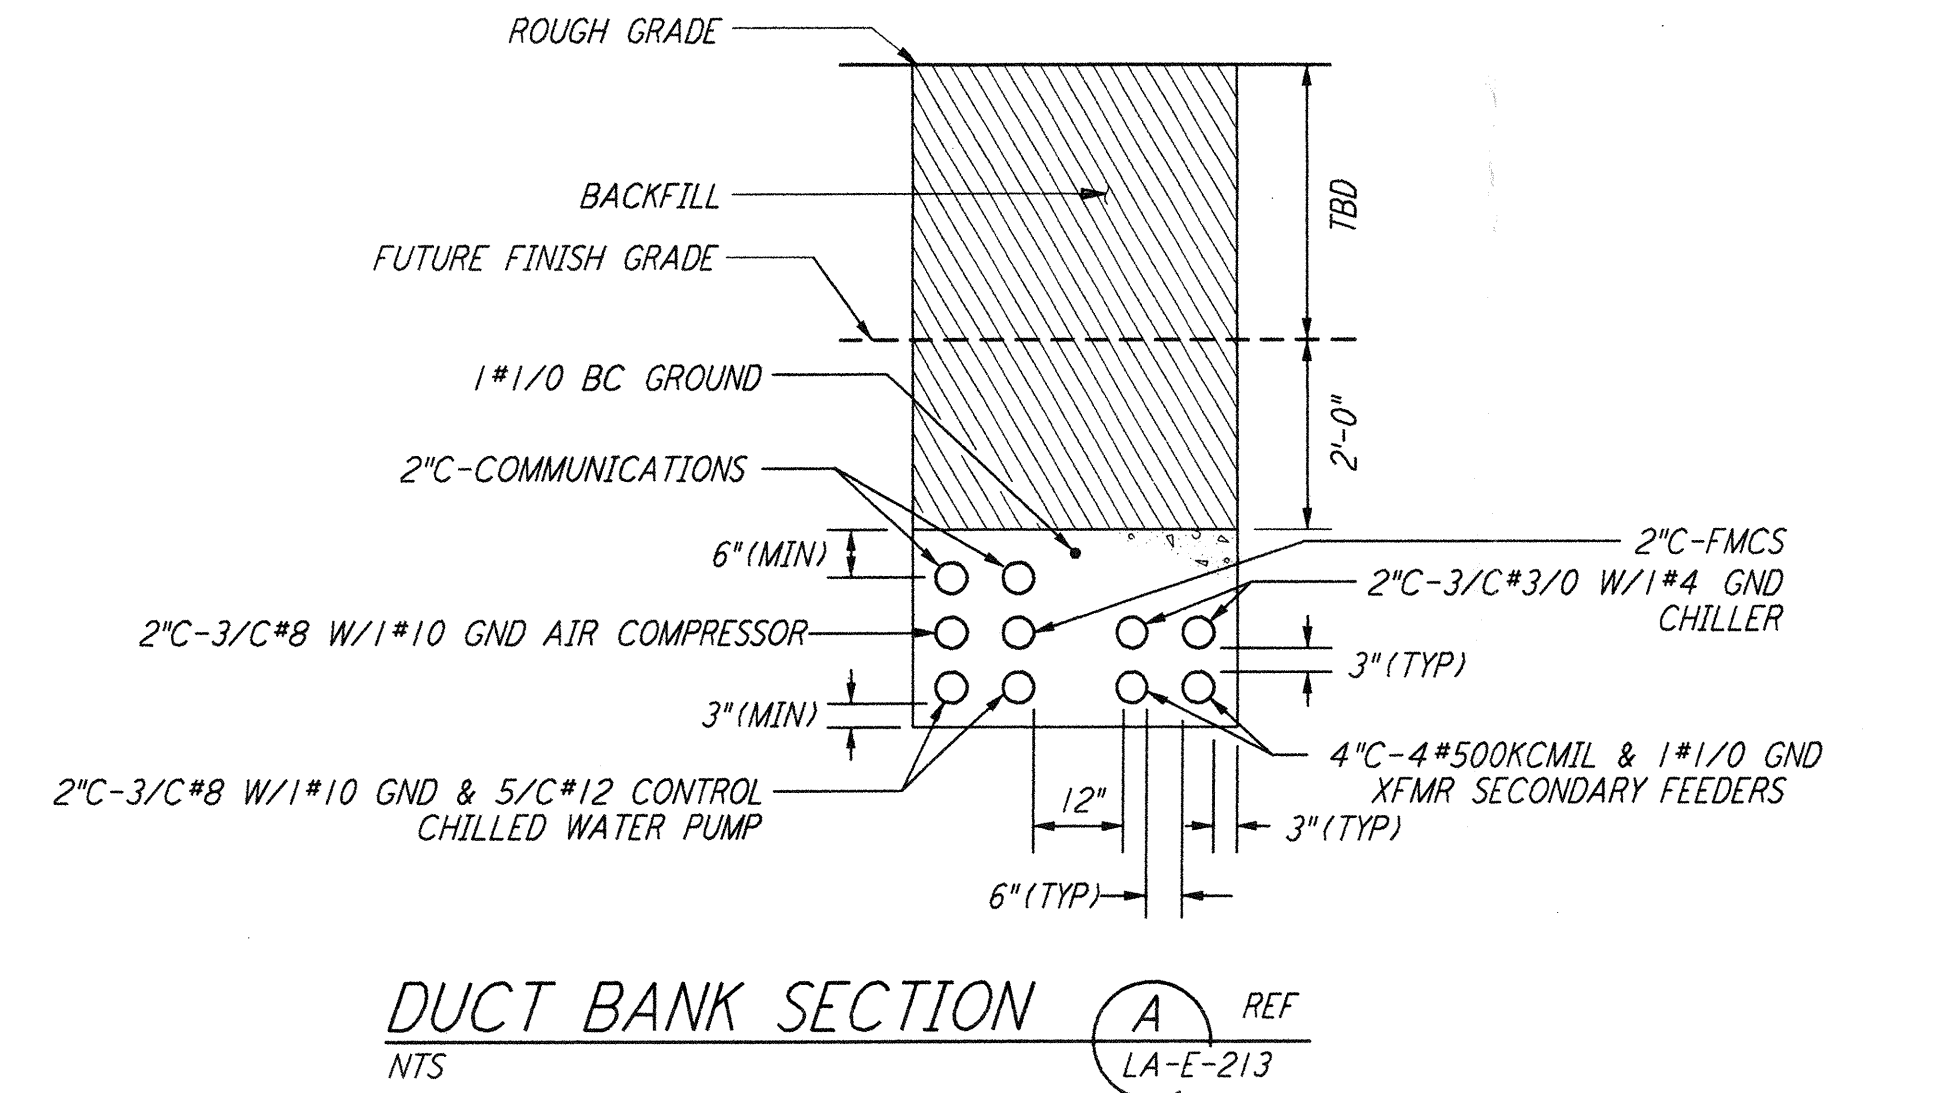
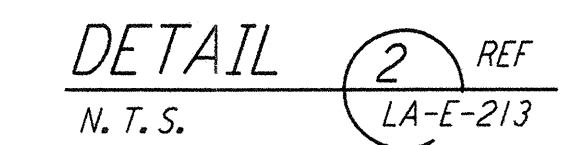
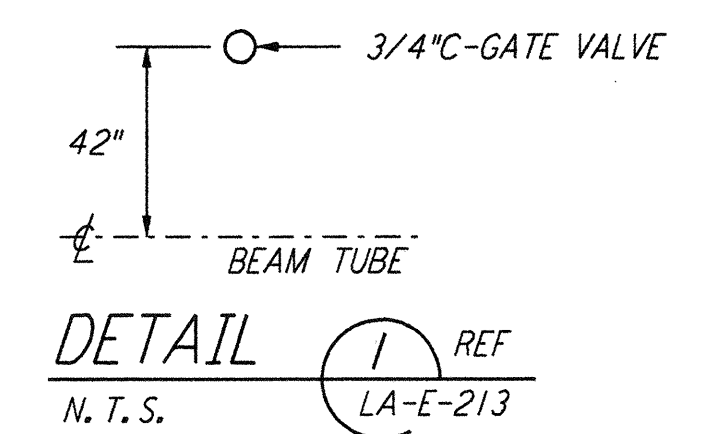


NOTES:

1. FOR STANDARD SYMBOLS, ABBREVIATIONS AND ACRONYMS SEE DWG. LA-E-001.
2. FOR ELECTRICAL SYMBOLS SEE DWG. LA-E-002.
3. FOR STANDARD INSTALLATION DETAILS SEE DWG. LA-E-405 THRU LA-E-407.
4. FOR CABLE TYPE DESCRIPTION SEE DWG. LA-E-007.
5. ALL DUCTBANK RUNS ARE SHOWN DIAGRAMMATICALLY ONLY. CONTRACTOR SHALL COORDINATE INSTALLATION WITH OTHER DISCIPLINES. TO USE COMMON TRENCH, BACK FILL ETC.
6. ARRANGEMENT OF CDS POWER CONDUIT STUB-UPS SHALL BE COORDINATED WITH THE VACUUM EQUIPMENT VENDOR.

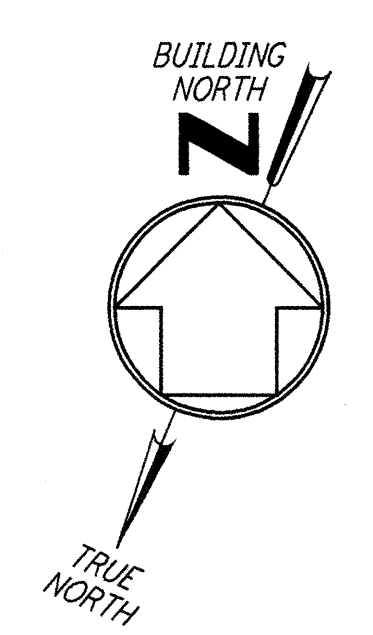

not be reproduced, copied, loaned, exhibited, or used in any other way, except by written consent from PARSONS to the borrower.

This document and the design it covers are the property of PARSONS. They are loaned only with the borrower's expressed written agreement that they will

NO.	DATE	BY	CHKD	ENGR	PROJ	DESCRIPTION
3	8-7-98	JE	AK	AK	T.D.M.	ISSUED FOR AS-BUILT
2	4-4-97	JG	KR	KR	T.D.M.	REVISED DIMENSION
1	3-17-97	J.G.	TDM	KR	T.D.M.	REVISED VACUUM EQUIP. LOCATIONS

ISSUED FOR CONSTRUCTION	DRAWN	M.M.	11-15-96
CHECKED	J.C.L.	7-24-96	
ENGINEER	K.C.R.	10-25-96	
PROJ	T.D.M.	11-15-96	

AS-BUILT DRAWINGS

100 WEST WALNUT STREET
PASADENA, CALIFORNIA

CALIFORNIA INSTITUTE OF TECHNOLOGY
MASSACHUSETTS INSTITUTE OF TECHNOLOGY

LASER INTERFEROMETER
GRAVITATIONAL-WAVE OBSERVATORY
SITE NO. 2 - LIVINGSTON, LOUISIANA

ELECTRICAL END STATION B UNDERGROUND PLAN

SCALE: AS NOTED
CONTRACT NUMBER: PPI50969
PROJECT NUMBER: 8094

LA-E-213