

5

4

3

2


E

D

C

B


A

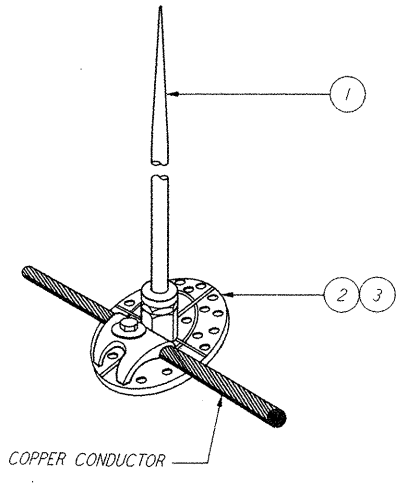

LIST OF MATERIAL

ITEM NO.	QTY	DESCRIPTION
1	1	AIR TERMINAL, SOLID COPPER, 1/2" X 24" HARGER # 719
2	1	BRONZE ADHESIVE BASE, HARGER # 152
3	1	ADHESIVE, HARGER # 263


AIR TERMINAL HORIZONTAL MTG. (1) REF. E-103, E-112, E-202, E-208  
 N. T. S.

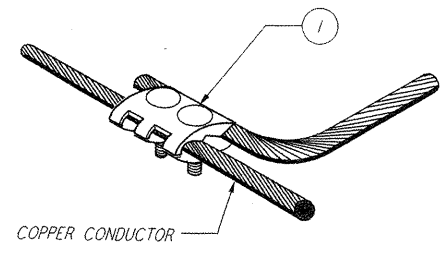

LIST OF MATERIAL

ITEM NO.	QTY	DESCRIPTION
1	2	BOLT PARALLEL SPLICER, HARGER # 204


CABLE TAP (2) REF. E-202, E-208  
 N. T. S.

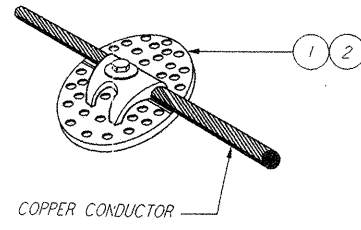

LIST OF MATERIAL

ITEM NO.	QTY	DESCRIPTION
1	1	ADHESIVE CABLE HOLDER, HARGER # 260
2	1	ADHESIVE, HARGER # 263

CABLE BONDING TO SURFACE (3) REF. E-103, E-202, E-208  
 N. T. S.

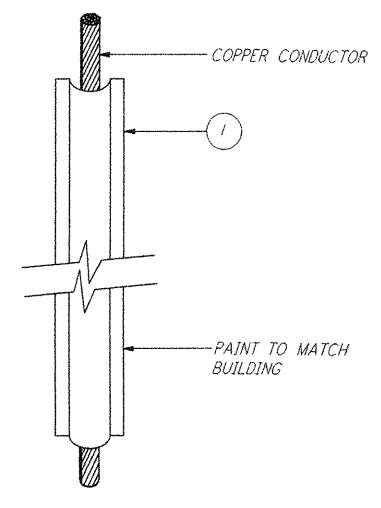

LIST OF MATERIAL

ITEM NO.	QTY	DESCRIPTION
1	AR	PVC CABLE GUARD HARGER # 321

EXTERIOR DOWN CONDUCTOR SUPPORT (4) REF. E-103, E-202, E-208  
 N. T. S.

not be reproduced, copied, loaned, exhibited, or used in any other way, except by written consent from PARSONS to the borrower.

This document and the design it covers are the property of PARSONS. They are loaned only with the borrower's expressed written agreement that they will

REV. NO.	DATE	BY	CHKD	ENGR	PROJ	DESCRIPTION
1	8-7-98	JE	AK	AK	AK	ISSUED FOR AS-BUILT

AS-BUILT DRAWINGS

ISSUED FOR CONSTRUCTION  
 DRAWN M. M. 11-15-96  
 CHECKED JGL 7-24-96  
 ENGINEER KCP 10-25-96  
 PROJ T. D. M. 11-15-96

**PARSONS**  
 100 WEST WALNUT STREET  
 PASADENA, CALIFORNIA

**LIGO**  
 CALIFORNIA INSTITUTE OF TECHNOLOGY  
 MASSACHUSETTS INSTITUTE OF TECHNOLOGY

**LIGO-D961044-01-0**  
 LASER INTERFEROMETER  
 GRAVITATIONAL-WAVE OBSERVATORY  
 SITE NO. 2 - LIVINGSTON, LOUISIANA

TITLE	SCALE	CONTRACT NUMBER	PROJECT NUMBER
ELECTRICAL LIGHTNING PROTECTION DETAILS	NONE	PP150969	8094
SHEET NUMBER	REVISIONS		
<b>LA-E-408</b>			

5

4

3

2