



This document and the design it covers are the property of PARSONS. They are loaned only with the borrower's expressed written agreement that they will not be reproduced, copied, loaned, exhibited, or used in any other way, except by written consent from PARSONS to the borrower.

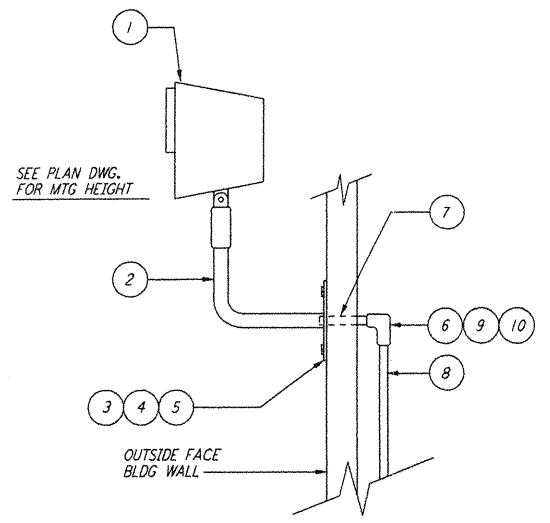


ITEM NO.	QTY.	DESCRIPTION
1	1	LIGHTING FIXTURE-TYPE AS SPECIFIED ON PLAN
2	1	WALL MTG BRACKET FOR FLD LIGHT
3	4	BOLT HEX HEAD, 3/8"-16 X 1 1/2" LG GALV.
4	4	ANCHOR MASONARY 3/8"-16
5	4	LOCKWASHER SPRING 3/8" BOLT SST
6	1	CONDUIT FITTING 3/4"
7	AR	CONDUIT 3/4" RIGID STEEL GALV
8	AR	CONDUIT 3/4" RIGID STEEL GALV
9	1	CONDUIT FITTING COVER, CAST 3/4"
10	1	CONDUIT FITTING COVER GASKET, NEOPRENE, 3/4"

FLOODLIGHT MOUNTING DETAIL (2) REF
 N. T. S.

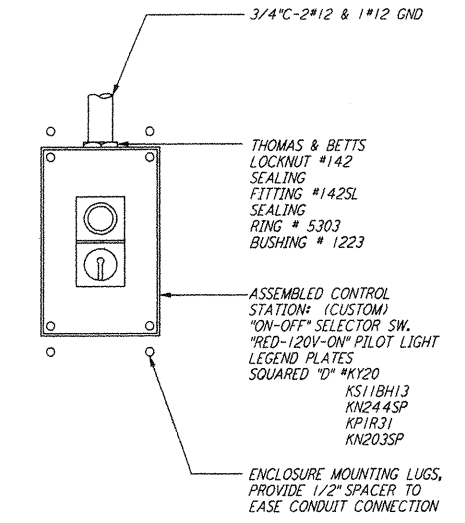


DETAIL (3) REF
 N. T. S.

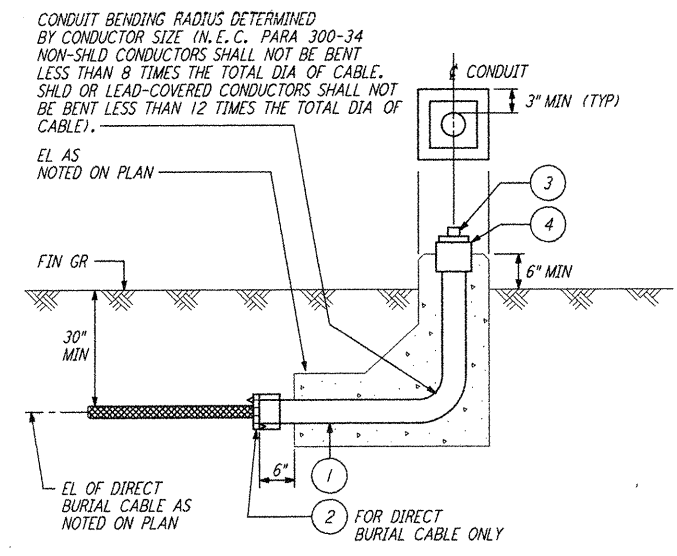

ITEM NO.	QTY.	DESCRIPTION
1	AR	CONDUIT, RIGID GALVANIZED STEEL, SIZE PER PLAN
2	1	CONDUIT BUSHING, NON-INSULATED GALV, PER CONDUIT SIZE
3	1	PLUG, SD HD RIGID AL, PER CONDUIT SIZE
4	1	CONDUIT COUPLING, RIGID GALVANIZED STEEL, PER CONDUIT SIZE

CONDUIT STUB-UP (4) REF
 N. T. S.

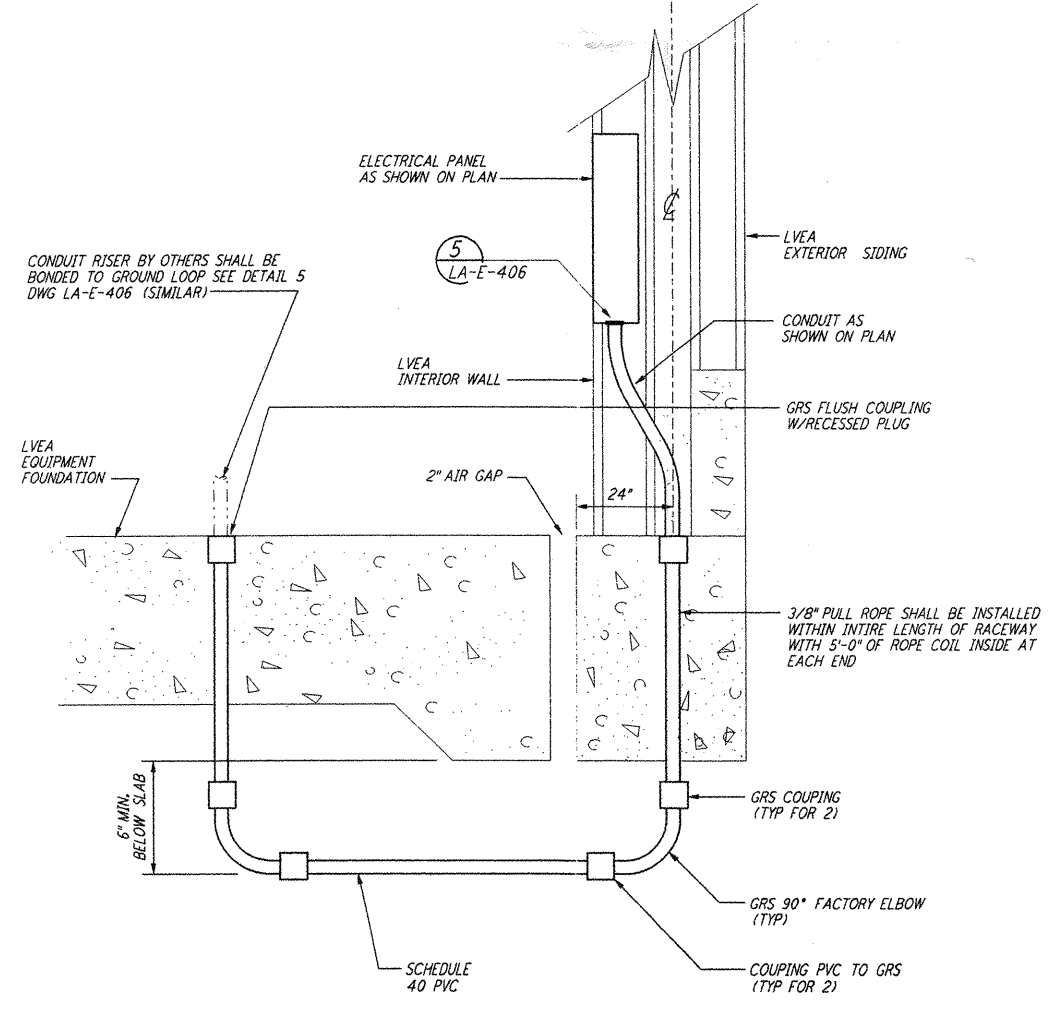

LVEA CONDUIT FLOOR RISER (5) REF
 N. T. S.

NO.	DATE	BY	CHKD	ENGR	PROJ	DESCRIPTION
1	8-7-98	JE	OK	AK	WJW	ISSUED FOR AS-BUILT

ISSUED FOR CONSTRUCTION
 DRAWN M. M. 11-15-96
 CHECKED JCL 7-24-96
 ENGINEER KCR 10-25-96
 PROJ T. D. M. 11-15-96

AS-BUILT DRAWINGS

PARSONS
 100 WEST WALNUT STREET
 PASADENA, CALIFORNIA

LIGO
 CALIFORNIA INSTITUTE OF TECHNOLOGY
 MASSACHUSETTS INSTITUTE OF TECHNOLOGY

LIGO-D961045-01-O
 LASER INTERFEROMETER
 GRAVITATIONAL-WAVE OBSERVATORY
 SITE NO. 2 - LIVINGSTON, LOUISIANA

TITLE	SCALE	CONTRACT NUMBER	PROJECT NUMBER
ELECTRICAL SECTIONS AND DETAILS	NONE	PP150969	8094
SHEET NUMBER	LA-E-409		REVISIONS

5

4

3

2

5

4

3

2