




PIPE SUPPORT DETAIL 1 REF
 NTS LA-P-411

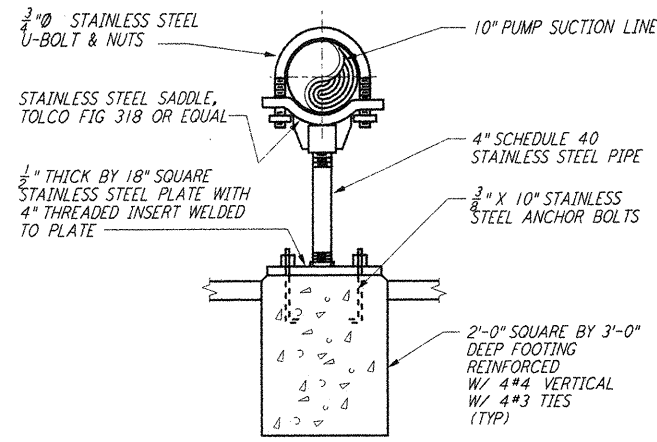


PIPE SUPPORT DETAIL 2 REF
 NTS LA-P-411

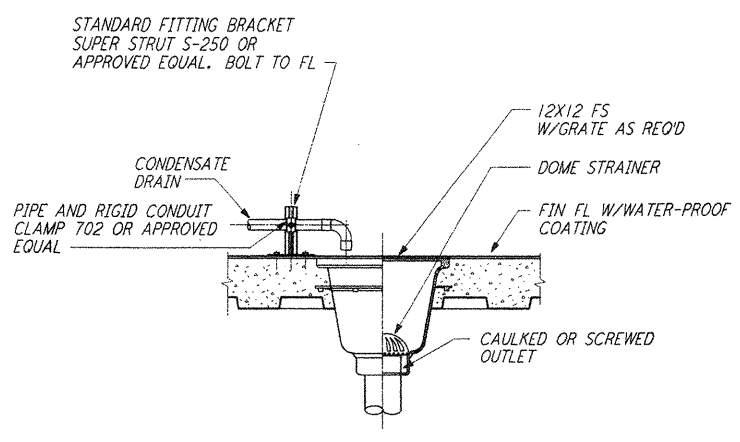


FLOOR SINK DETAIL 3 REF
 NTS LA-P-411

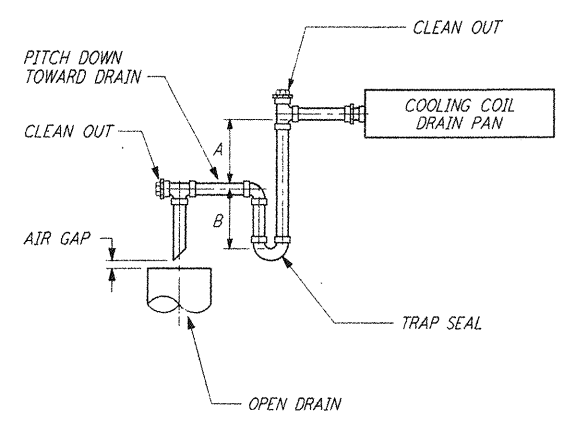


CONDENSATE DRAIN DETAIL 4 REF
 NTS LA-P-411

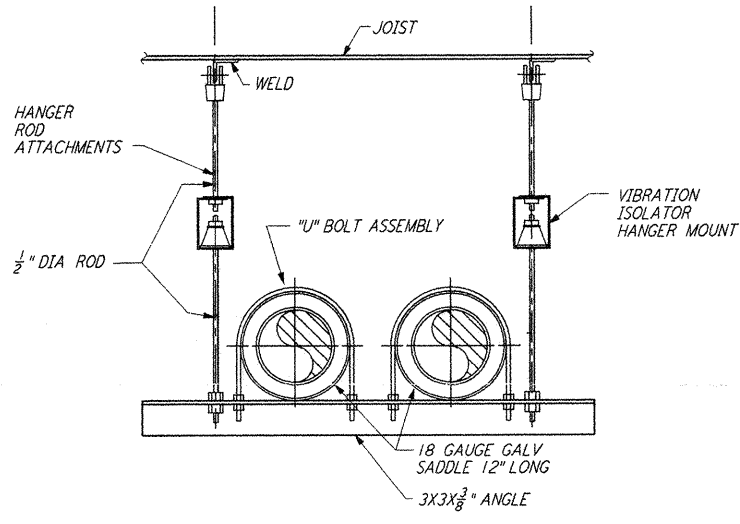


PIPE HANGER - TRAPEZE DETAIL 5 REF
 NTS LA-P-411

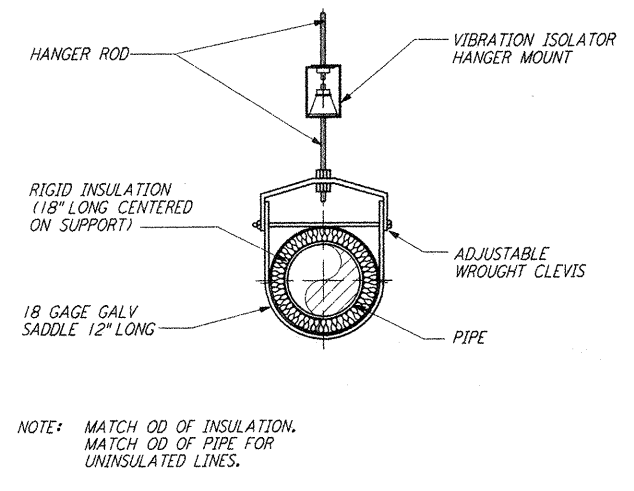

PIPE HANGER DETAIL - SINGLE PIPE 6 REF
 NTS LA-P-411

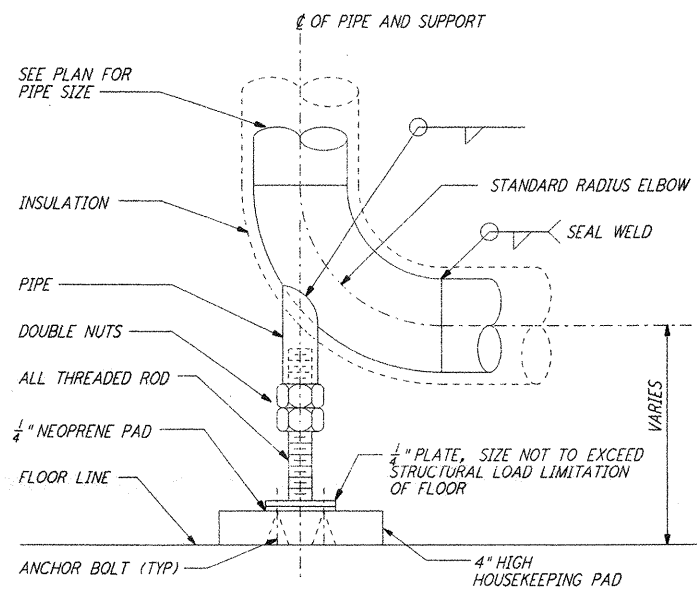

BASE ELBOW SUPPORT DETAIL 7 REF
 NTS LA-P-411

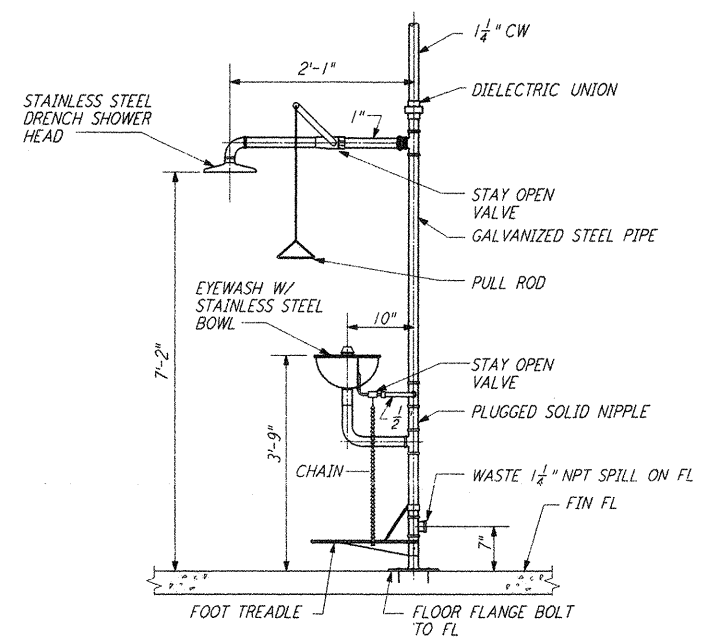

EMERGENCY SHOWER AND EYE WASH DETAIL 8 REF
 NTS LA-P-411

This document and the design it covers are the property of PARSONS. They are loaned only with the borrower's expressed written agreement that they will not be reproduced, copied, loaned, exhibited, or used in any other way, except by written consent from PARSONS to the borrower.

NO.	DATE	BY	CHKD	ENGR	PROJ	DESCRIPTION
1	8-7-98	DJB	MM	MM	MM	ISSUED FOR AS-BUILT

ISSUED FOR CONSTRUCTION			
DRAWN	DG	11-15-96	
CHECKED	ME	10-25-96	
ENGINEER	AA	10-25-96	
PROJ	TDM	11-15-96	

AS-BUILT DRAWINGS

PARSONS
 100 WEST WALNUT STREET
 PASADENA, CALIFORNIA

LIGO
 CALIFORNIA INSTITUTE OF TECHNOLOGY
 MASSACHUSETTS INSTITUTE OF TECHNOLOGY

LIGO-D961054-01-0		
LASER INTERFEROMETER GRAVITATIONAL-WAVE OBSERVATORY SITE NO. 2 - LIVINGSTON, LOUISIANA		
TITLE	SCALE	CONTRACT NUMBER
PLUMBING DETAILS	NONE	PP150969
SHEET NUMBER	PROJECT NUMBER	
LA-P-411	8094	
		REVISIONS
		▲