


EDUCATION VERSION - NOT FOR COMMERCIAL USE

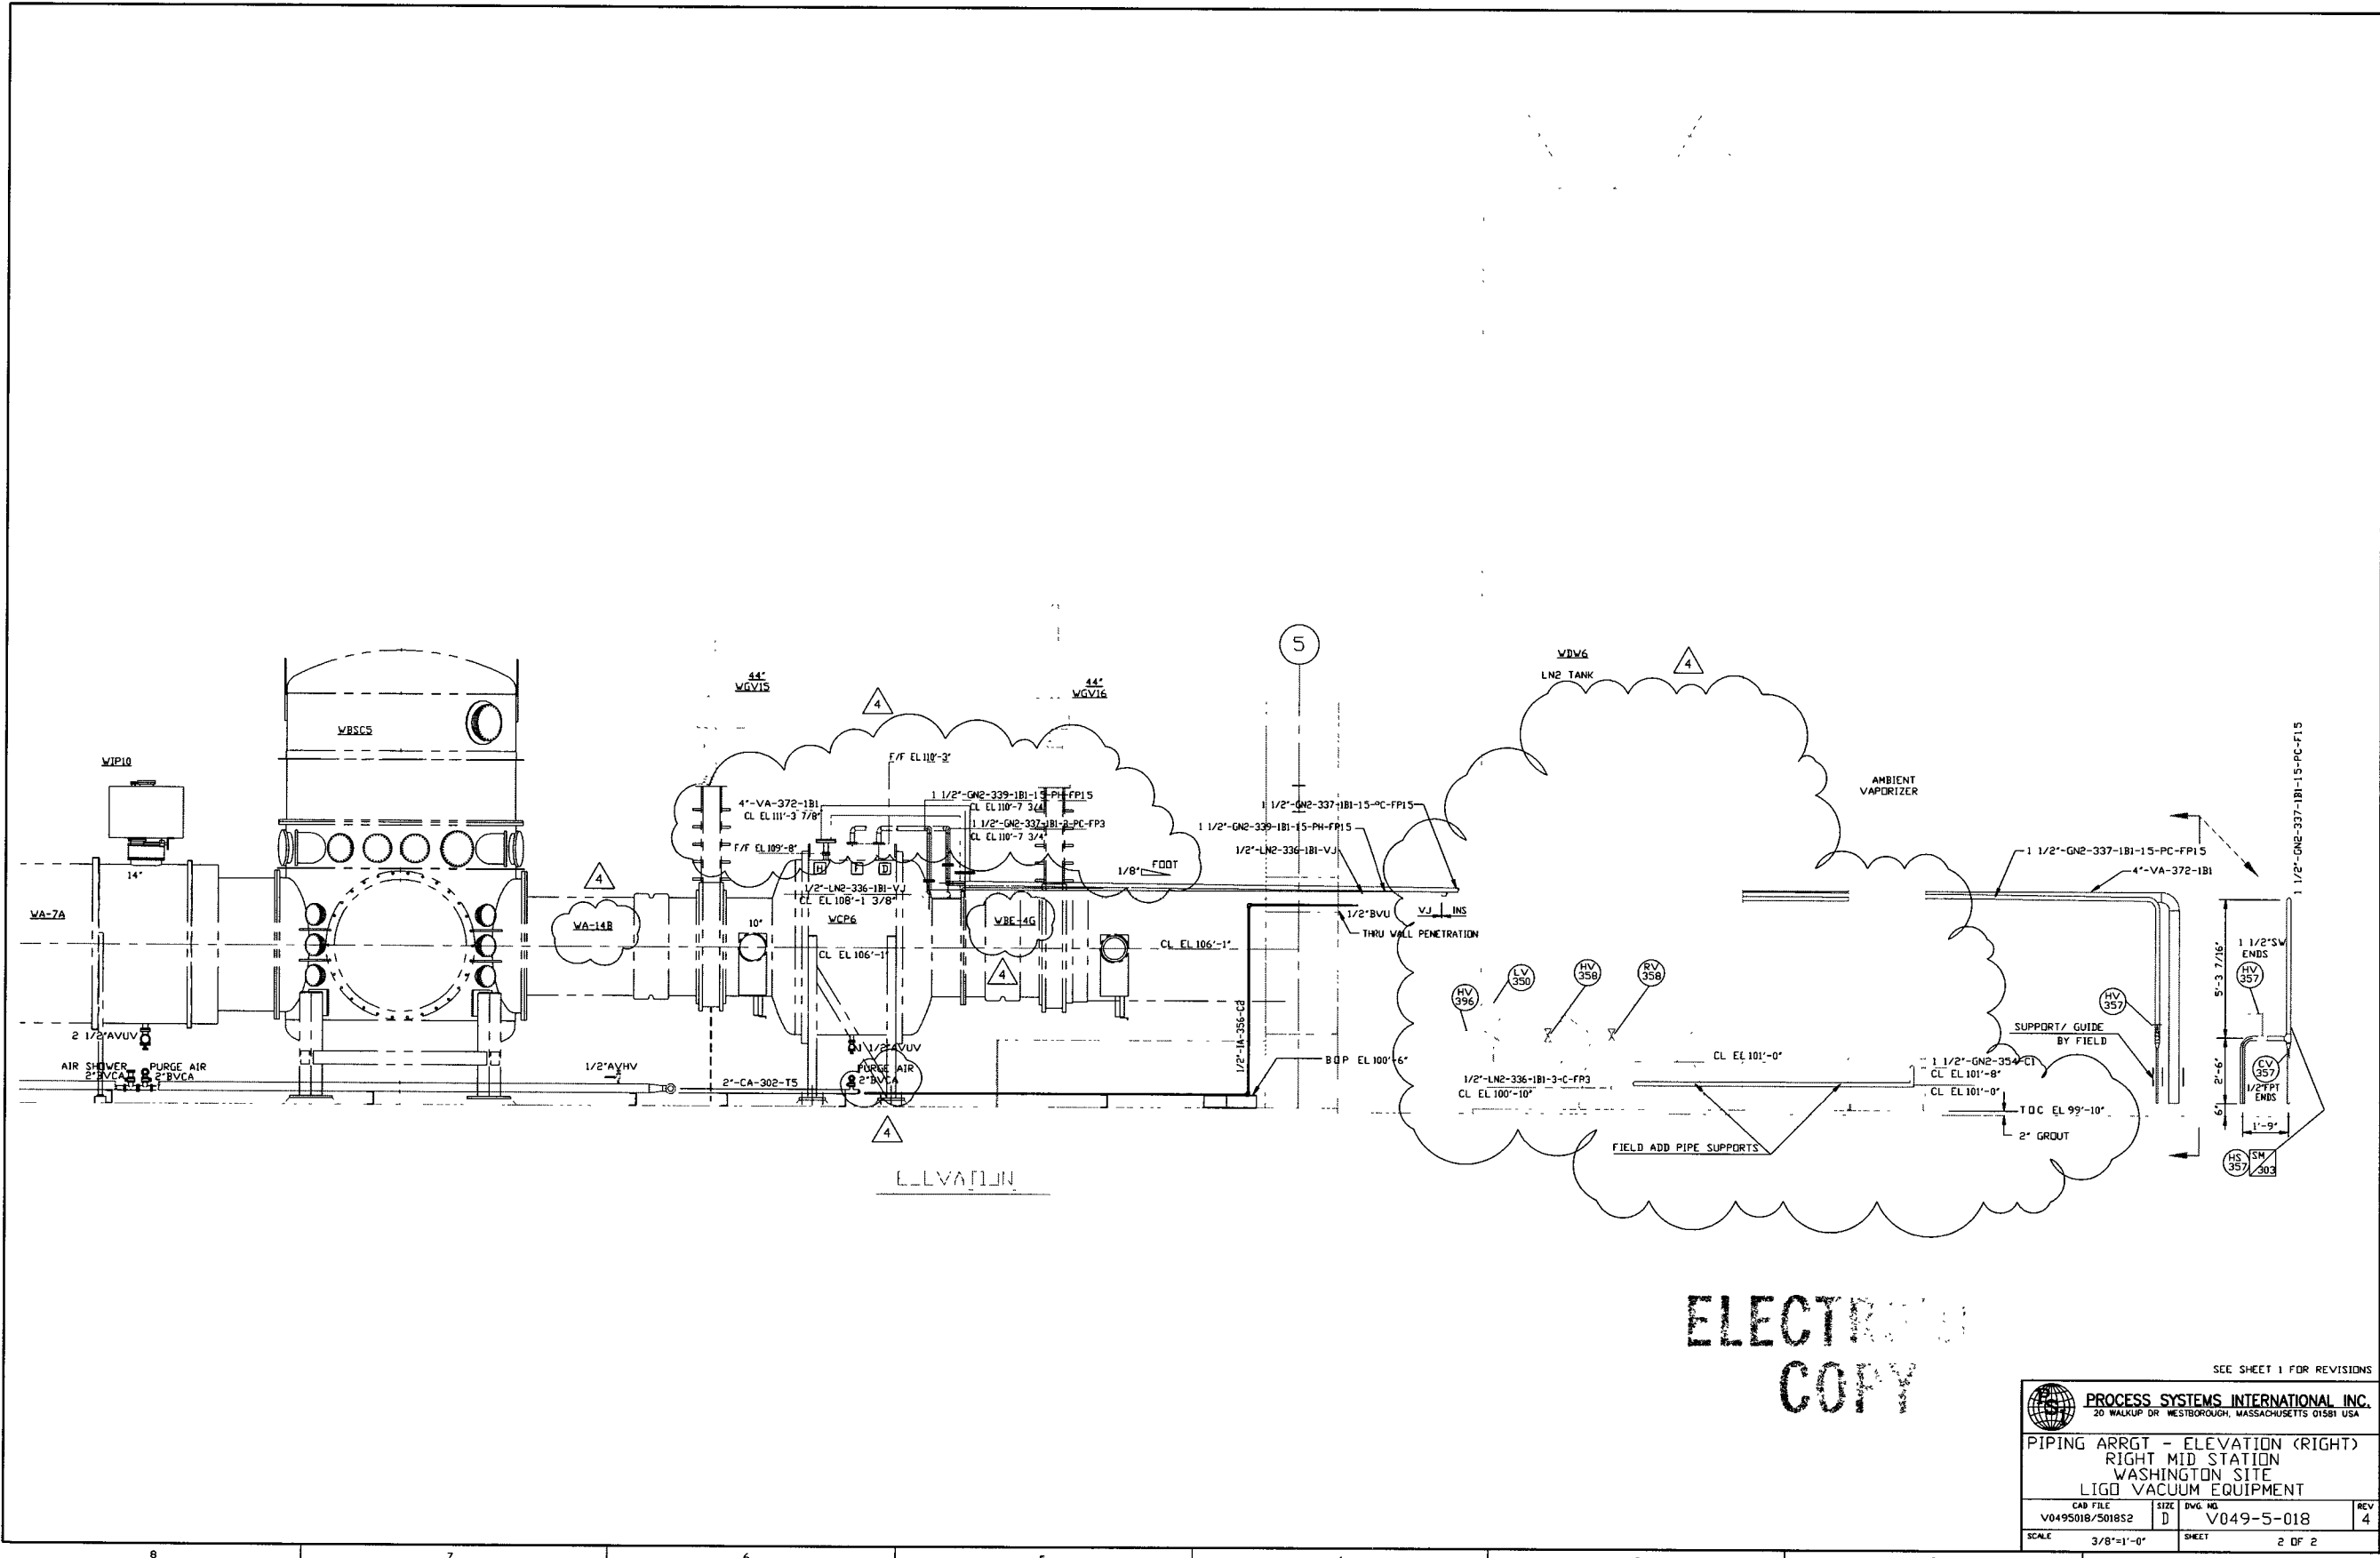

ELECTRICAL
COPY

SEE SHEET 1 FOR REVISIONS

PROCESS SYSTEMS INTERNATIONAL INC. 20 WALKUP DR WESTBOROUGH, MASSACHUSETTS 01581 USA			
PIPING ARRGT - ELEVATION (RIGHT) RIGHT MID STATION WASHINGTON SITE LIGO VACUUM EQUIPMENT			
CAD FILE	SIZE	DWG NO	REV
V0495018/5018S2	D	V049-5-018	4
SCALE	SHEET		
3/8"=1'-0"	2 OF 2		

JUN 16, 1998 10:24:24