




NOTES:
 1. SEE SHEET LA-C-002 FOR GENERAL NOTES, LEGEND AND ABBREVIATIONS.

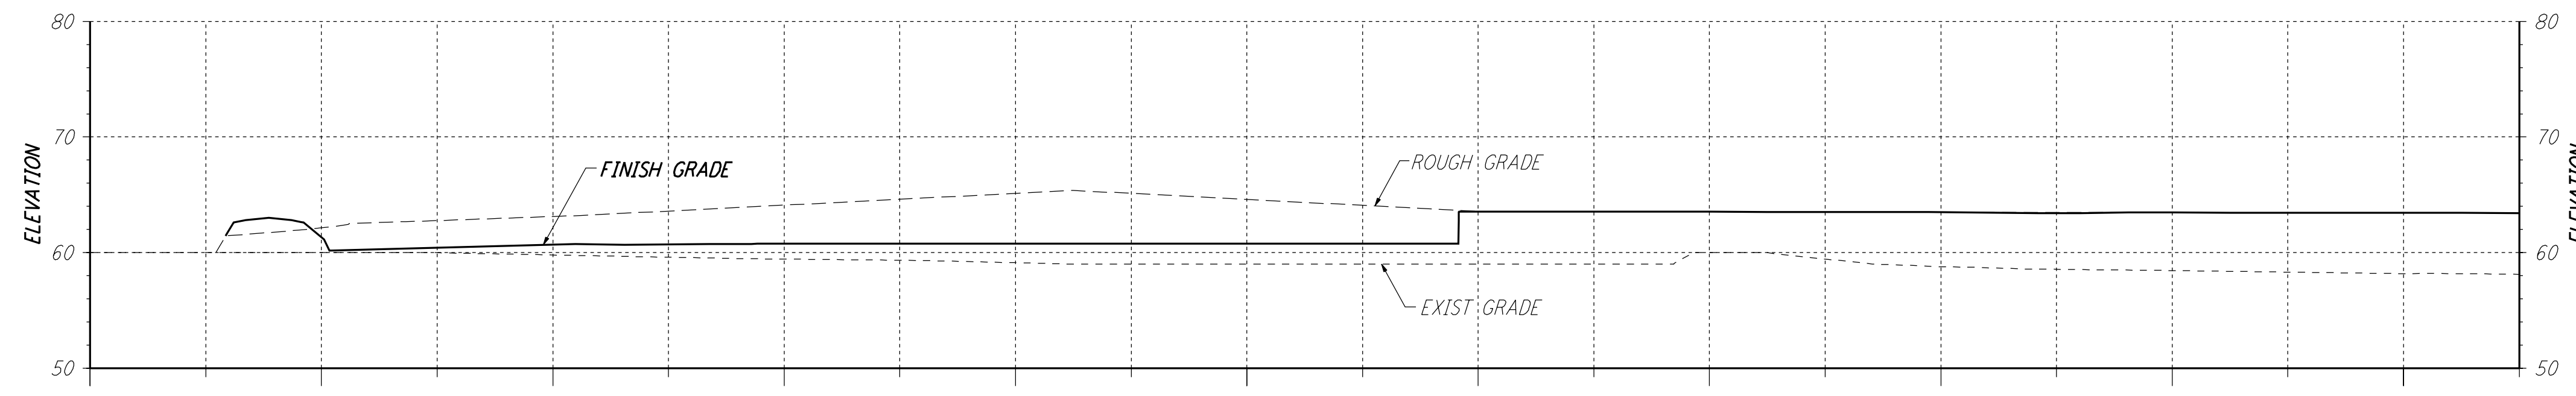


SECTION A
 SCALES: HORIZ: 1" = 50'
 VERT: 1" = 10'
 REF: LA-C-054 LA-C-007
 (CORNER STATION - ALONG SOUTHWEST ARM BEAM TUBE)

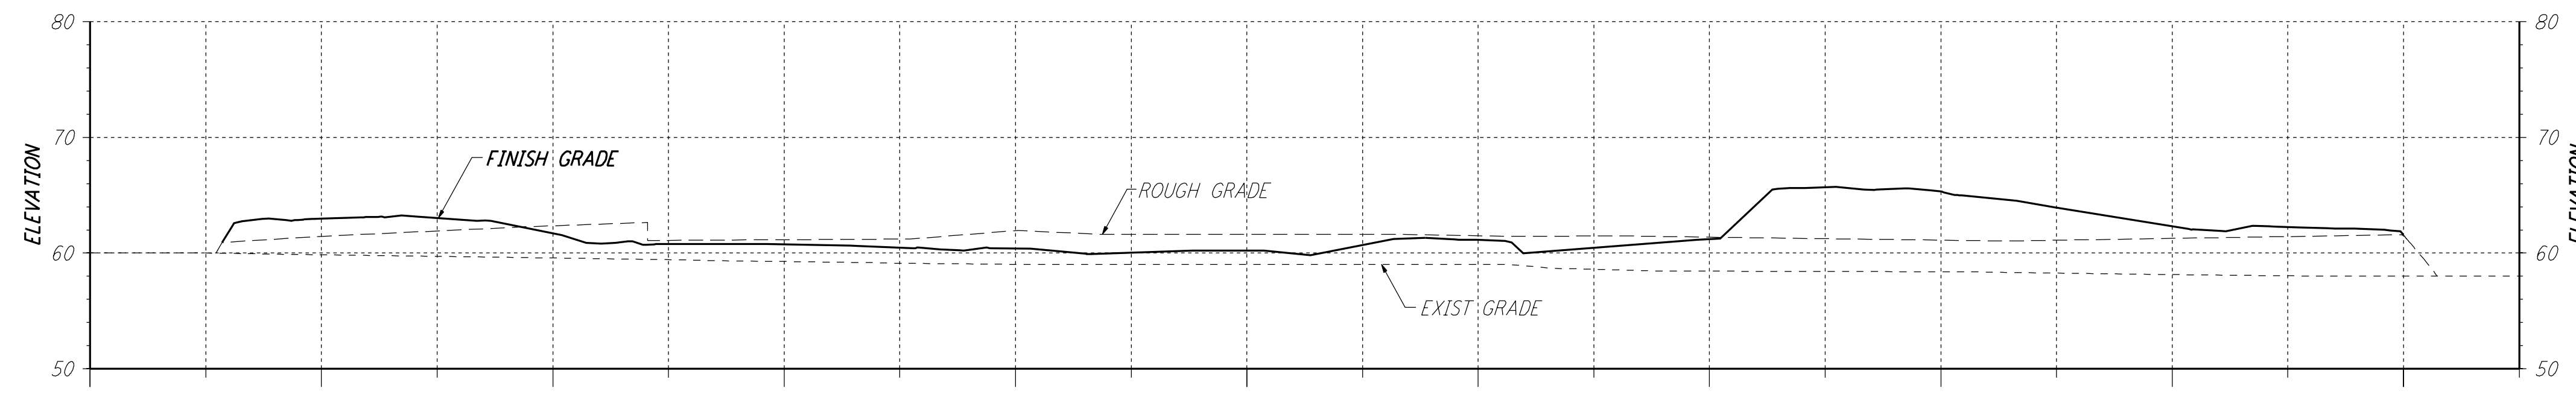


SECTION B
 SCALES: HORIZ: 1" = 50'
 VERT: 1" = 10'
 REF: LA-C-054 LA-C-007
 (CORNER STATION - ALONG SOUTHWEST AXIS)

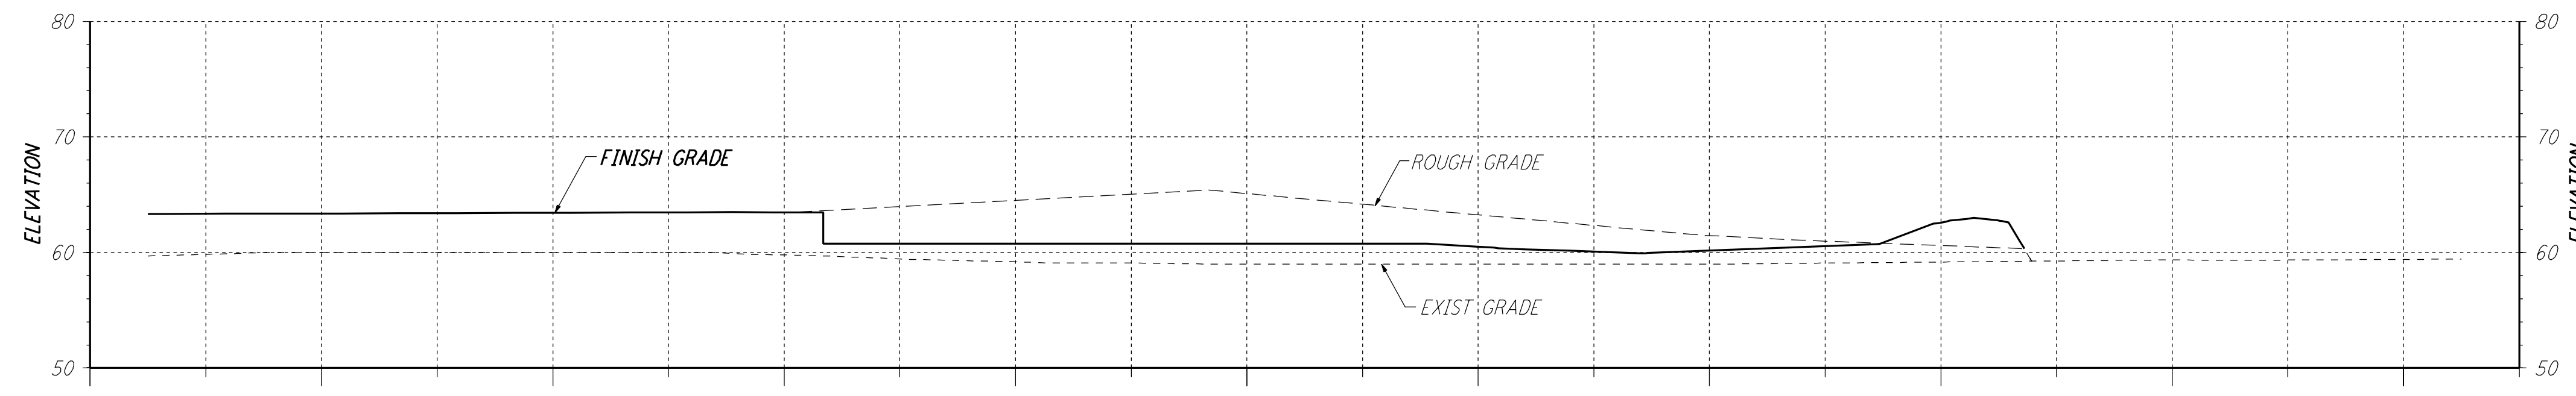


SECTION C
 SCALES: HORIZ: 1" = 50'
 VERT: 1" = 10'
 REF: LA-C-054 LA-C-007
 (CORNER STATION - ALONG SOUTHWEST AXIS)

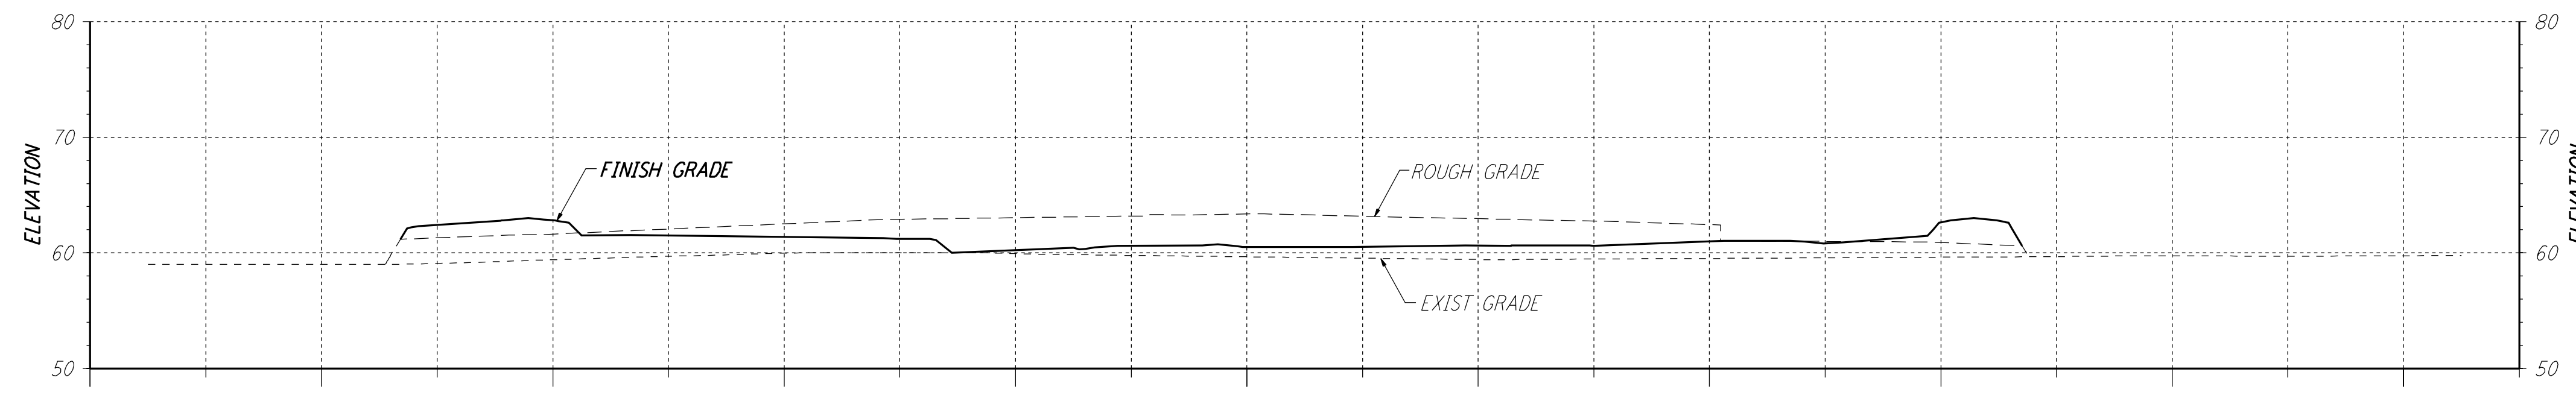


SECTION D
 SCALES: HORIZ: 1" = 50'
 VERT: 1" = 10'
 REF: LA-C-054 LA-C-007
 (CORNER STATION - ALONG SOUTHWEST AXIS)

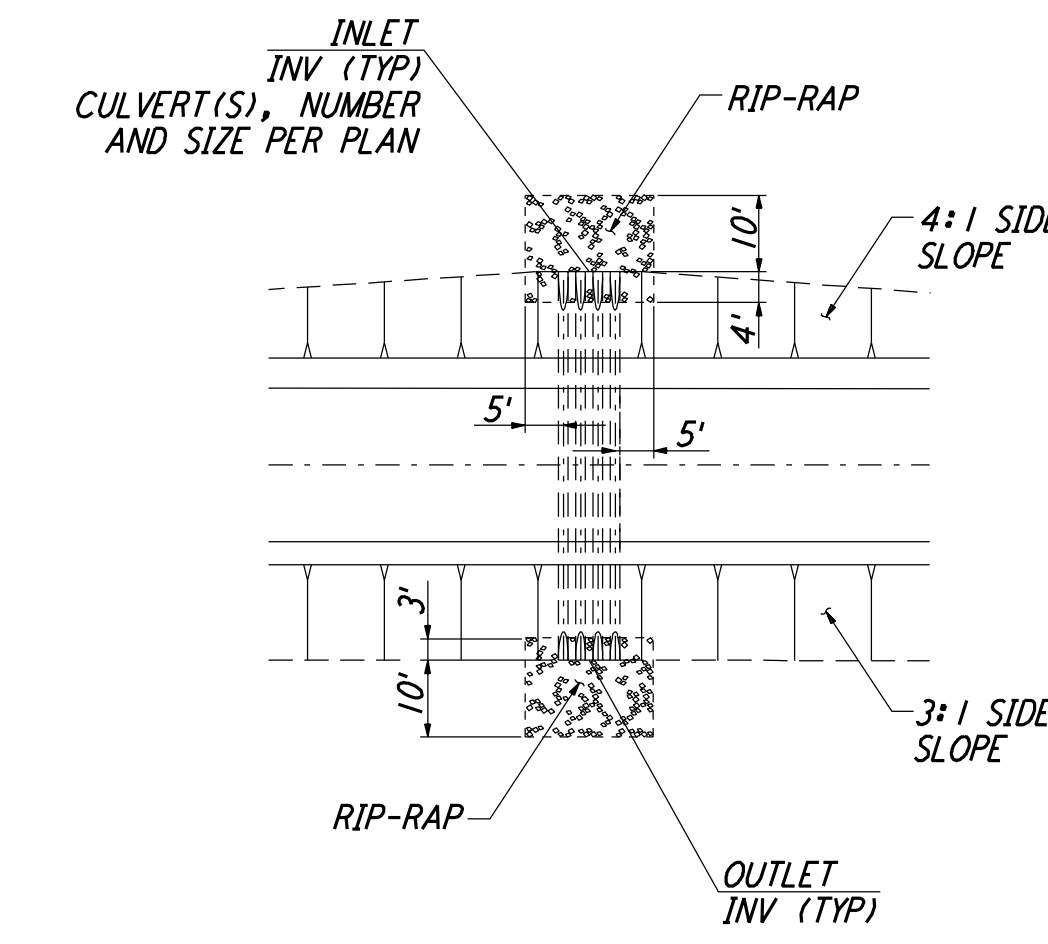


RIP-RAP
 NOT TO SCALE
 REF: LA-C-054 LA-C-007 LA-C-008

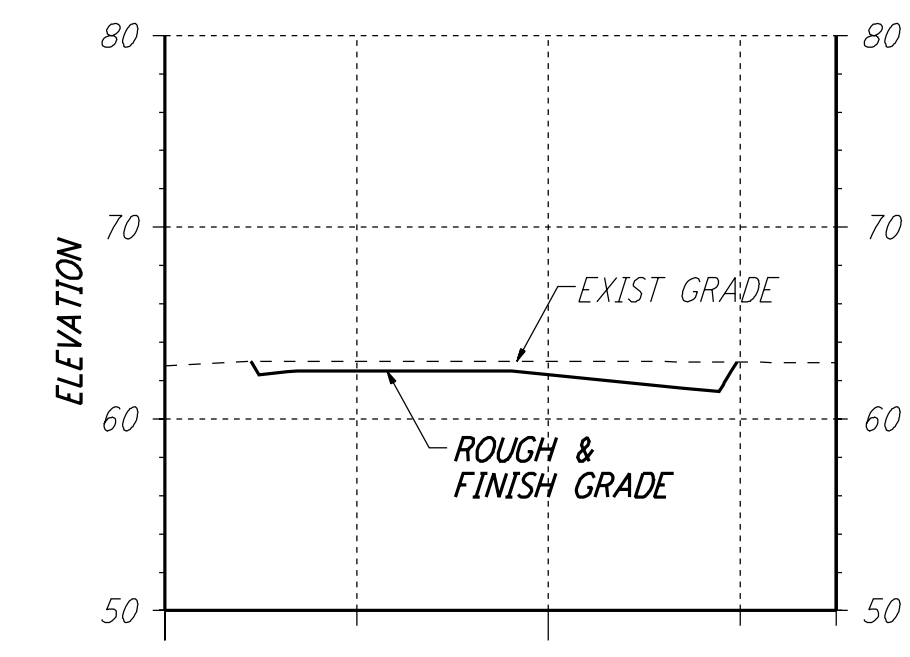


SECTION E
 SCALES: HORIZ: 1" = 50'
 VERT: 1" = 10'
 REF: LA-C-054 LA-C-022
 (MID-POINT PUMP STATION - SOUTHWEST ARM)

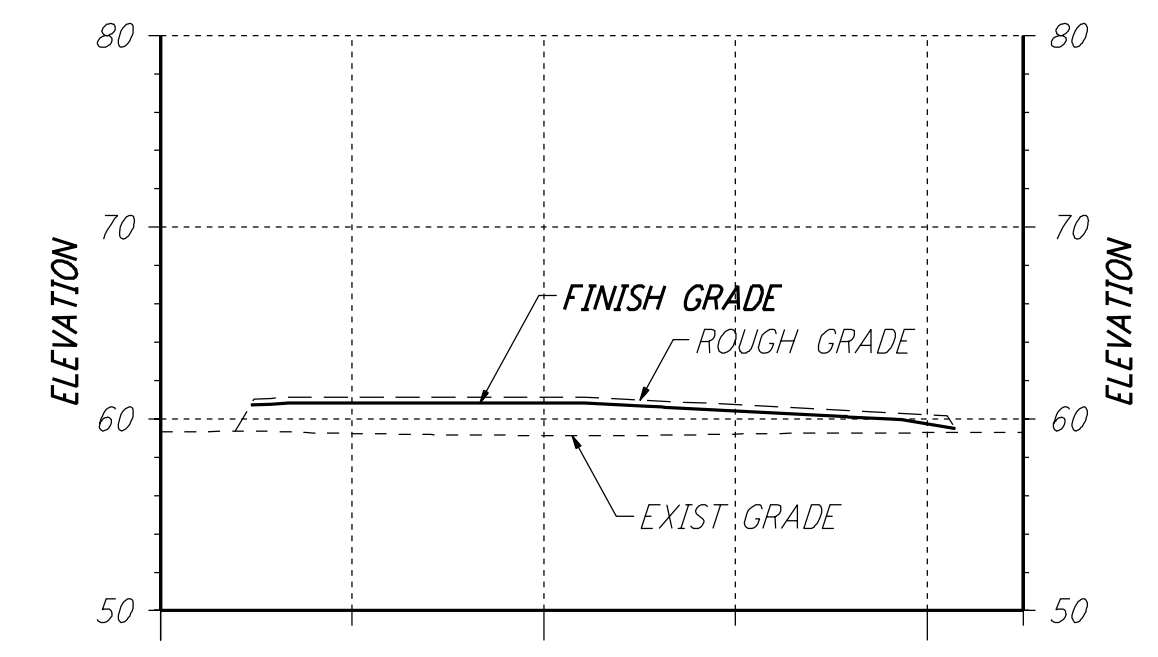


SECTION F
 SCALES: HORIZ: 1" = 50'
 VERT: 1" = 10'
 REF: LA-C-054 LA-C-026
 (END STATION - SOUTHWEST ARM)

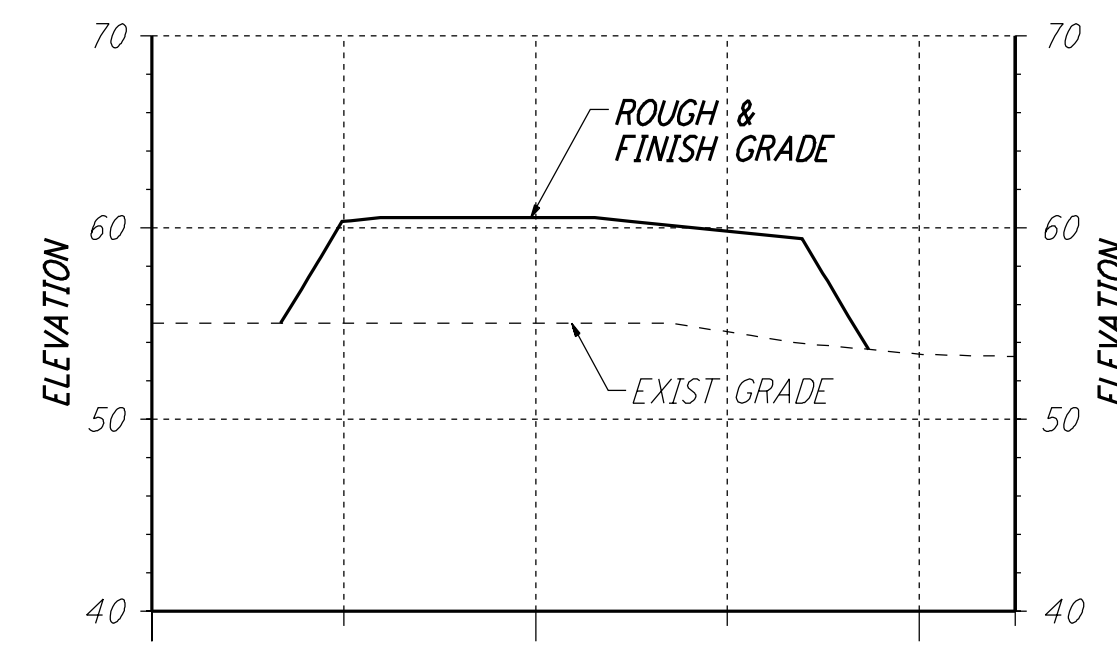

SECTION G
 SCALES: HORIZ: 1" = 50'
 VERT: 1" = 10'
 REF: LA-C-054 LA-C-042
 (MID-POINT PUMP STATION - SOUTHWEST ARM)

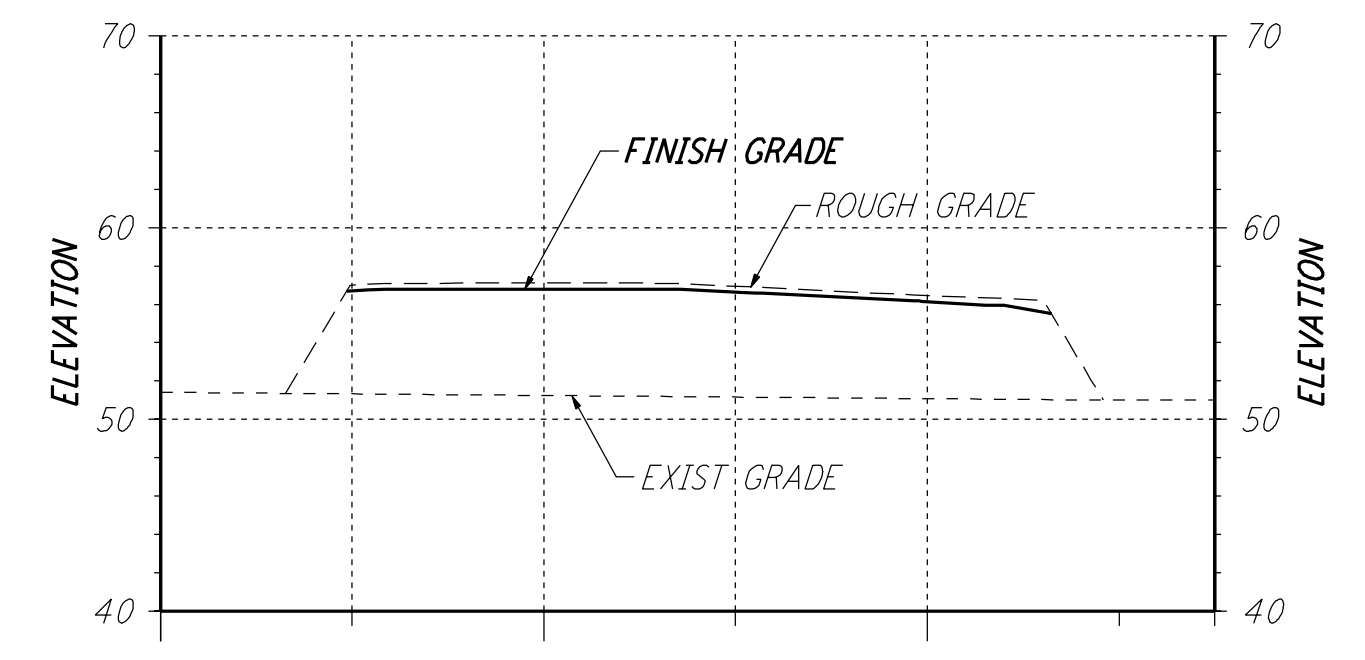

SECTION H
 SCALES: HORIZ: 1" = 50'
 VERT: 1" = 10'
 REF: LA-C-054 LA-C-046
 (END STATION - SOUTHWEST ARM)

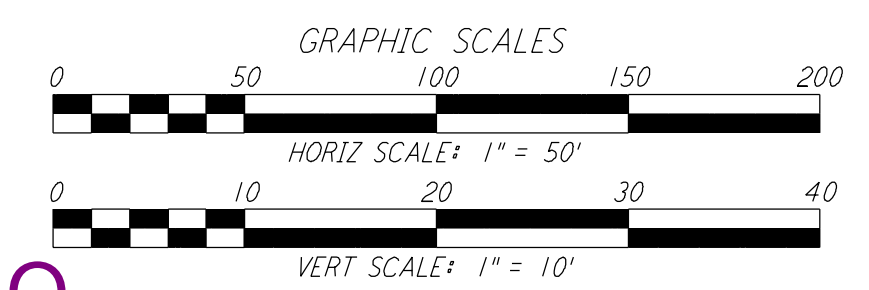

LIGO-D961206-01-0

This document and the design it covers are the property of PARSONS. They are loaned only with the borrower's expressed written agreement that they will not be reproduced, copied, loaned, exhibited, or used in any other way, except by written consent from PARSONS to the borrower.

NO.	DATE	BY	CHKD	ENGR	PROJ	DESCRIPTION
1	08-07-98	WRB				ISSUED FOR AS-BUILT

ISSUED FOR CONSTRUCTION		
DRAWN	WRB	11-15-96
CHECKED	ML	11-15-96
ENGINEER	JB	11-15-96
PROJ	TDM	11-15-96

AS-BUILT DRAWINGS

PARSONS
 100 WEST WALNUT STREET
 PASADENA, CALIFORNIA

LIGO
 CALIFORNIA INSTITUTE OF TECHNOLOGY
 MASSACHUSETTS INSTITUTE OF TECHNOLOGY

LASER INTERFEROMETER
 GRAVITATIONAL-WAVE OBSERVATORY
 SITE NO. 2 - LIVINGSTON, LOUISIANA

TITLE	SCALE	CONTRACT NUMBER	PROJECT NUMBER
CIVIL GRADING SECTIONS & DETAILS SHEET 2	AS NOTED	PP150969	8094
SHEET NUMBER		REVISIONS	
LA-C-054		1	