



This document and the design it covers are the property of PARSONS. They are loaned only with the borrower's expressed written agreement that they will not be reproduced, copied, loaned, exhibited, or used in any other way, except by written consent from PARSONS to the borrower.

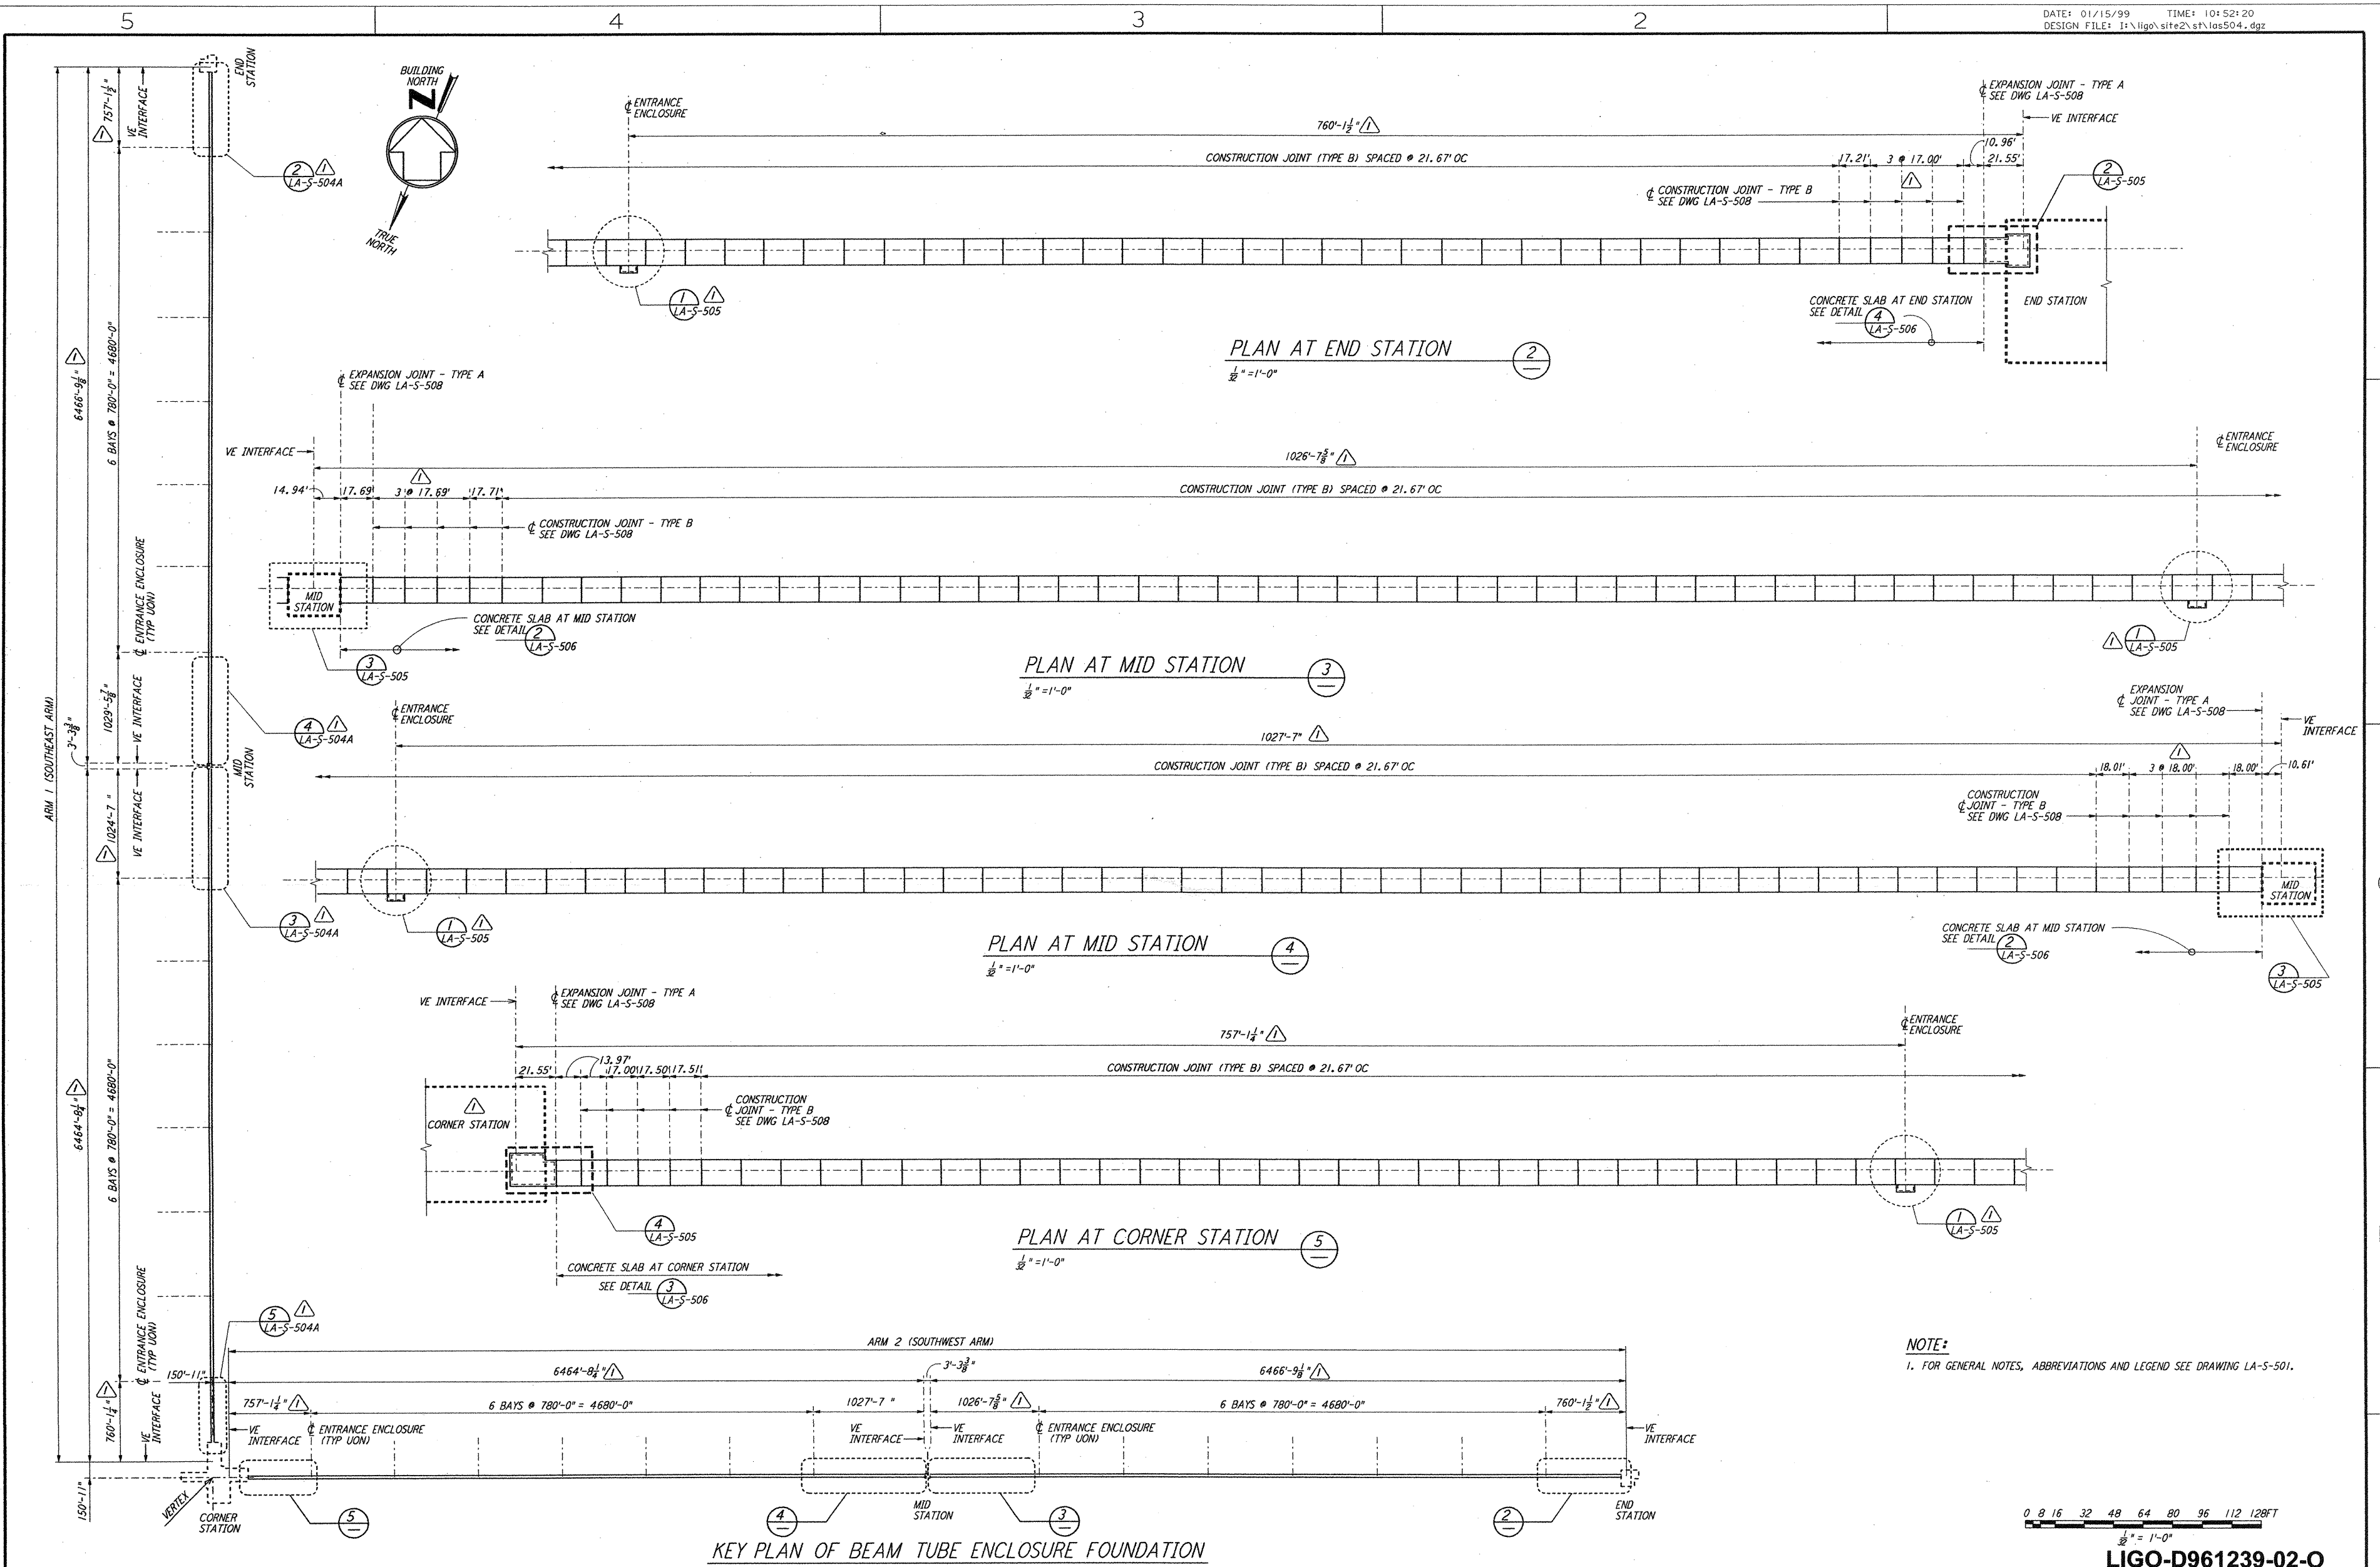

NOTE:
 1. FOR GENERAL NOTES, ABBREVIATIONS AND LEGEND SEE DRAWING LA-S-501.

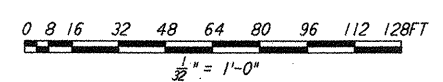

LIGO-D961239-02-0

KEY PLAN OF BEAM TUBE ENCLOSURE FOUNDATION

NO.	DATE	BY	CHKD	ENGR	PROJ	DESCRIPTION
2	1-15-99	MEI			MDW	ISSUED FOR AS BUILT
1	2-28-97	GP				REV DIMENSIONS & DET REFS

ISSUED FOR CONSTRUCTION						
DRAWN	MCS	11-15-96				
CHECKED	DDM	11-15-96				
ENGINEER	BP	11-15-96				
PROJ	TDM	11-15-96				

AS-BUILT DRAWINGS

PARSONS
 100 WEST WALNUT STREET
 PASADENA, CALIFORNIA

LIGO
 CALIFORNIA INSTITUTE OF TECHNOLOGY
 MASSACHUSETTS INSTITUTE OF TECHNOLOGY

LASER INTERFEROMETER GRAVITATIONAL-WAVE OBSERVATORY BEAM TUBE ENCLOSURE - LIVINGSTON, LA			
TITLE	SCALE	CONTRACT NUMBER	PROJECT NUMBER
STRUCTURAL KEY PLAN OF BEAM TUBE ENCLOSURE FOUNDATION & PARTIAL ENLARGED PLANS	AS NOTED	PP150969	8094
LA-S-504		REVISIONS	