



Tue Sep 10 12:54:05 1996 3-1182 J:\PLOTS\QUEUES\1182\ST504.PRF

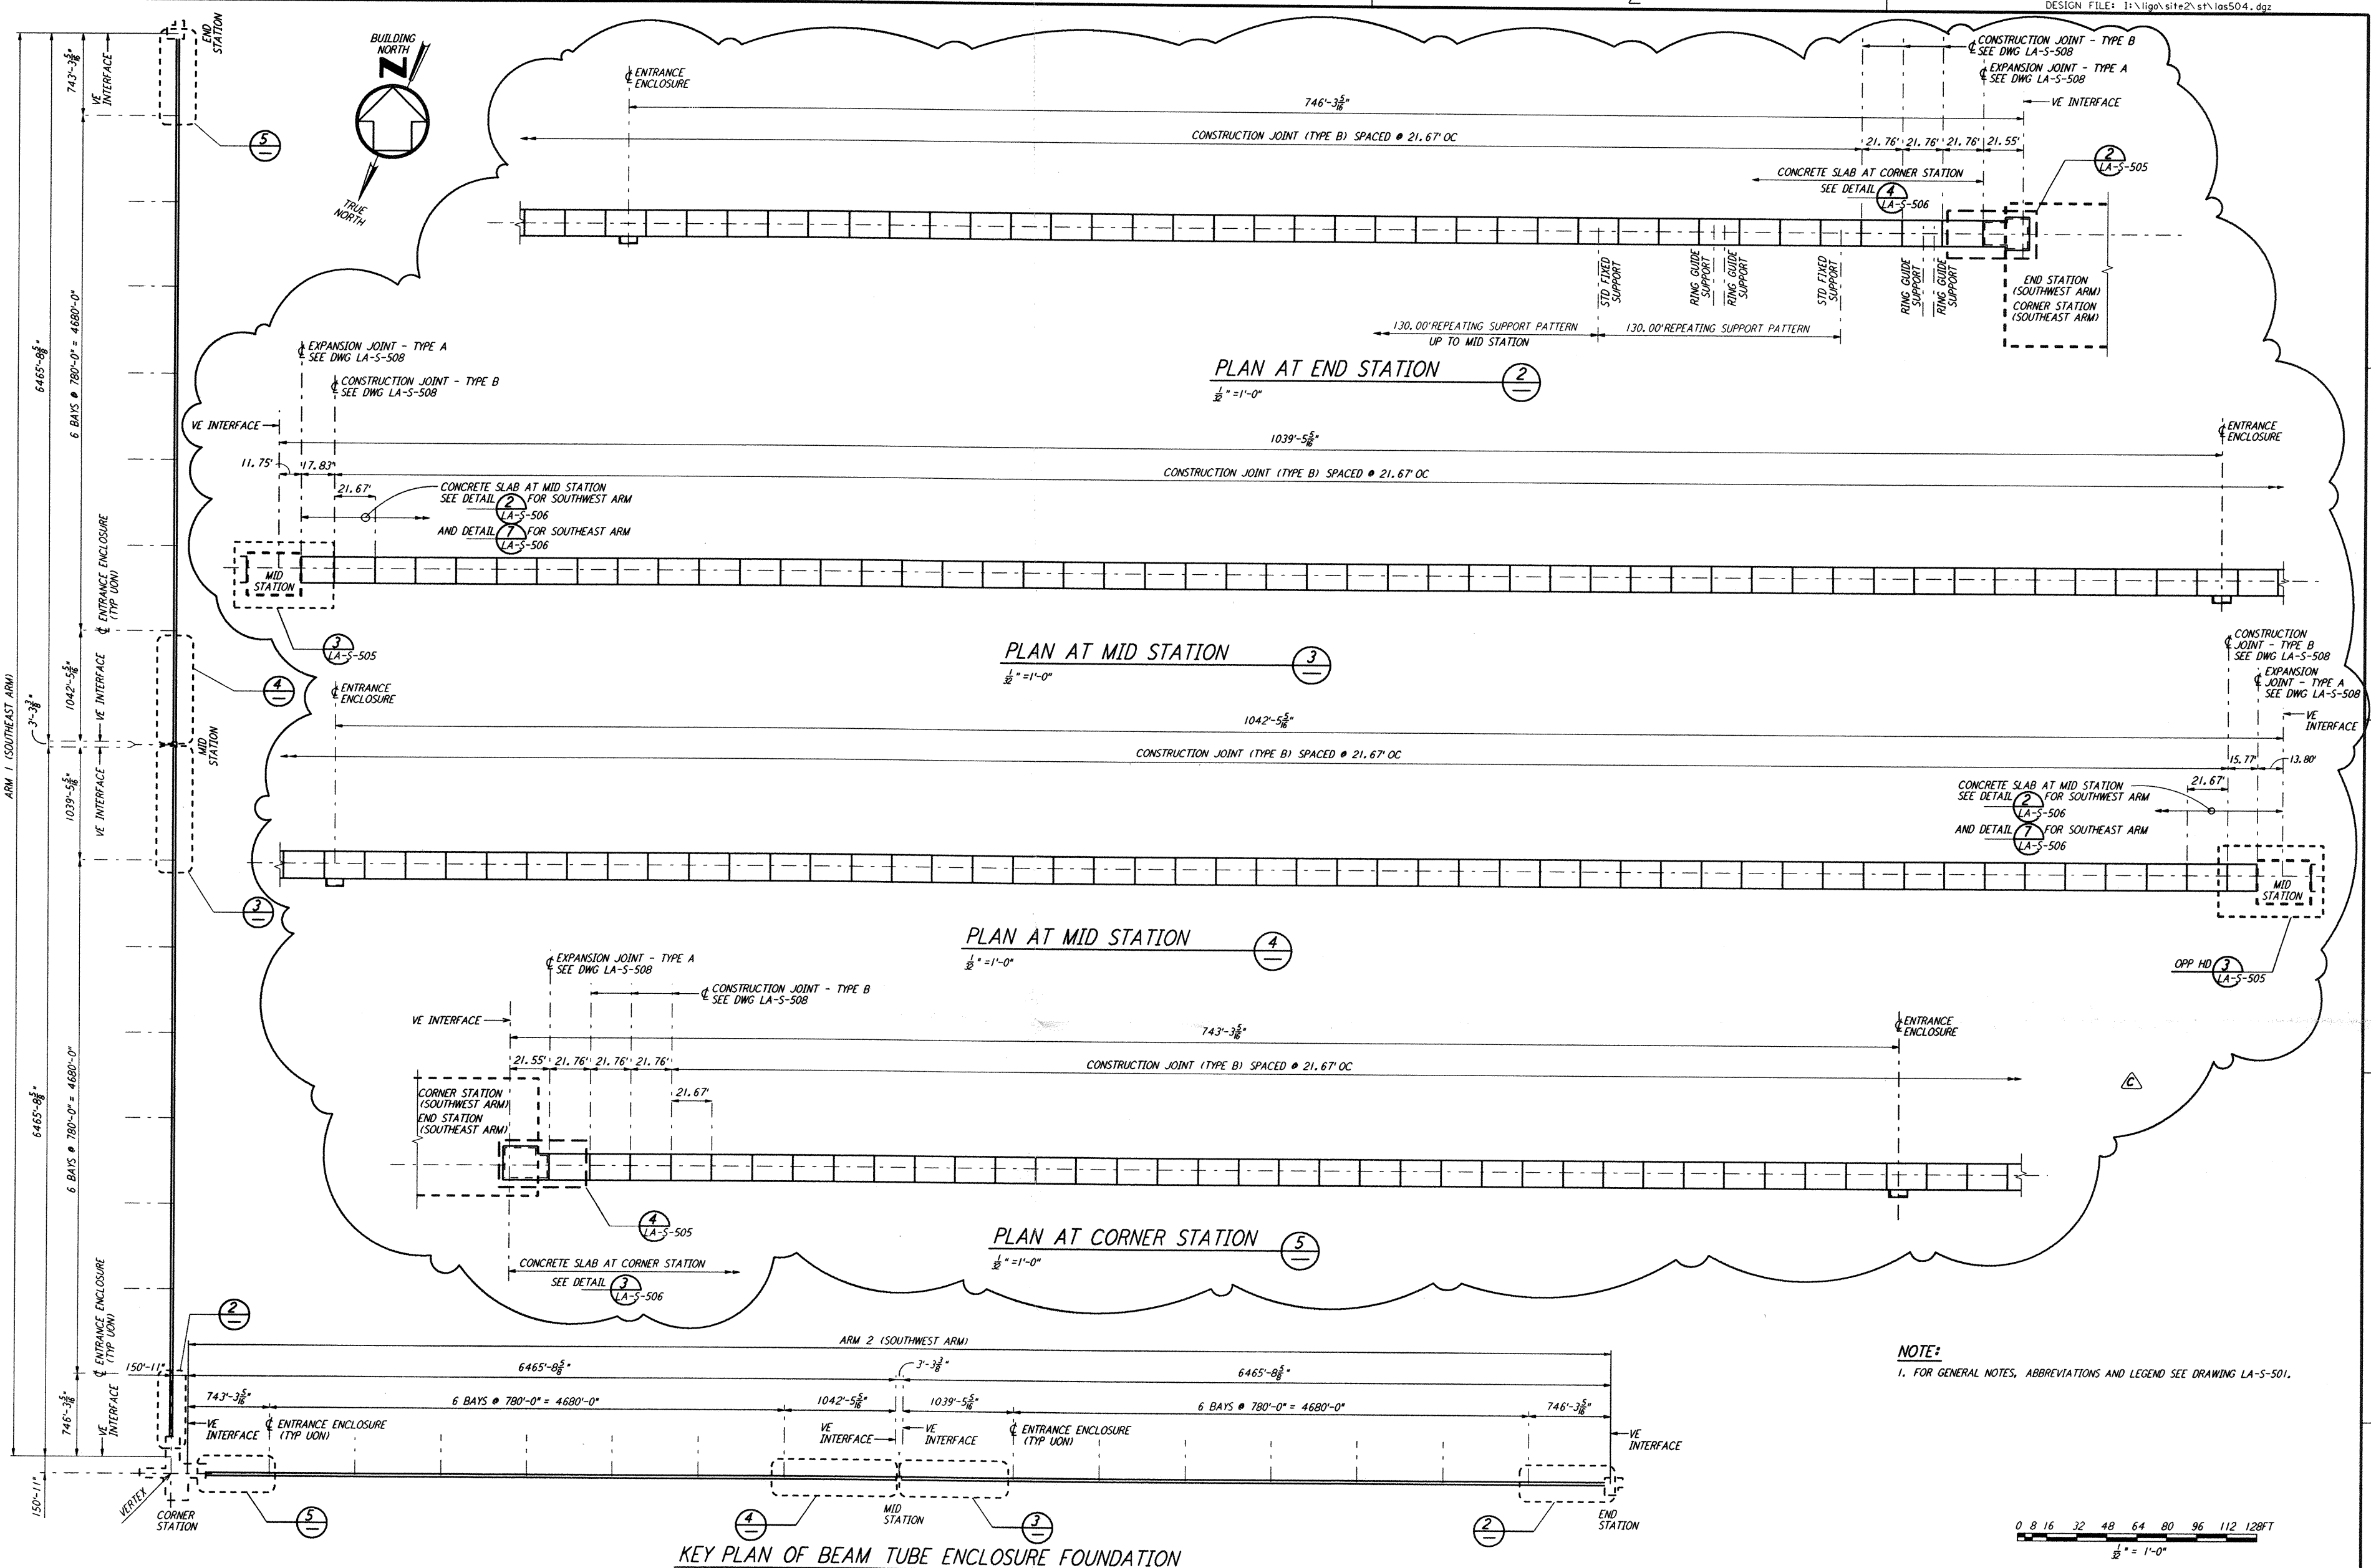

**NOTE:**  
 1. FOR GENERAL NOTES, ABBREVIATIONS AND LEGEND SEE DRAWING LA-5-501.

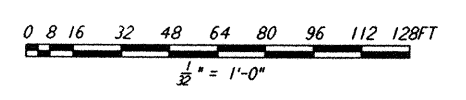

KEY PLAN OF BEAM TUBE ENCLOSURE FOUNDATION

| NO. | DATE     | BY  | CHKD | ENGR | PROJ | DESCRIPTION               |
|-----|----------|-----|------|------|------|---------------------------|
| C   | 9-10-96  | MCS | DDM  | BP   | DDM  | BID ADDENDUM #2           |
| B   | 6-14-96  | MCS | DDM  | BP   | TDM  | FINAL DESIGN REVIEW       |
| A   | 10-31-95 |     |      |      | TDM  | PRELIMINARY DESIGN REVIEW |

|          |     |
|----------|-----|
| DRAWN    | MCS |
| CHECKED  |     |
| ENGINEER |     |
| PROJ     |     |

**PARSONS**  
 100 WEST WALNUT STREET  
 PASADENA, CALIFORNIA

**LIGO**  
 CALIFORNIA INSTITUTE OF TECHNOLOGY  
 MASSACHUSETTS INSTITUTE OF TECHNOLOGY

LASER INTERFEROMETER  
 GRAVITATIONAL-WAVE OBSERVATORY  
 BEAM TUBE ENCLOSURE - LIVINGSTON, LA

STRUCTURAL  
 KEY PLAN OF BEAM TUBE  
 ENCLOSURE FOUNDATION &  
 PARTIAL ENLARGED PLANS

SCALE: AS NOTED  
 CONTRACT NUMBER: PPI 50969  
 PROJECT NUMBER: 8094

**LA-S-504**