




- NOTES:**
- SEE SHEET LA-C-502 FOR GENERAL NOTES, LEGEND AND ABBREVIATIONS.
 - SEE SHEET LA-C-504 FOR TYPICAL SECTIONS AND DETAILS.

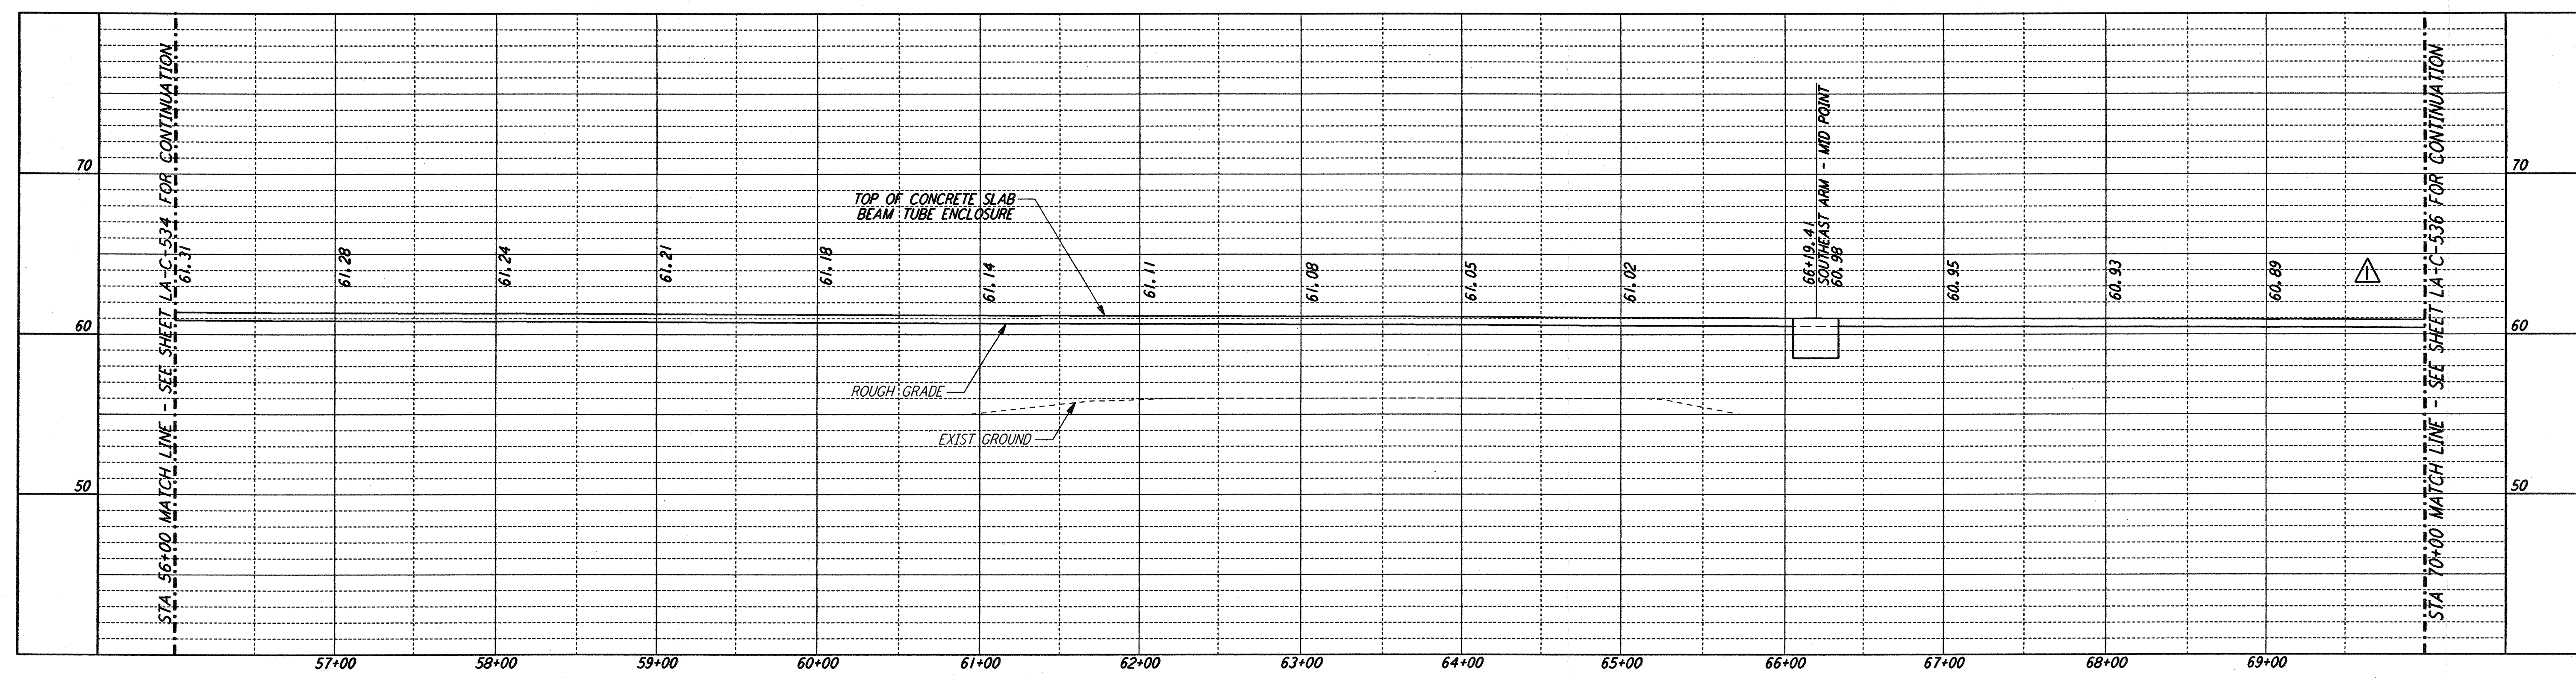


PROFILE
 SCALES: HORIZ: 1" = 50'
 VERT: 1" = 5'

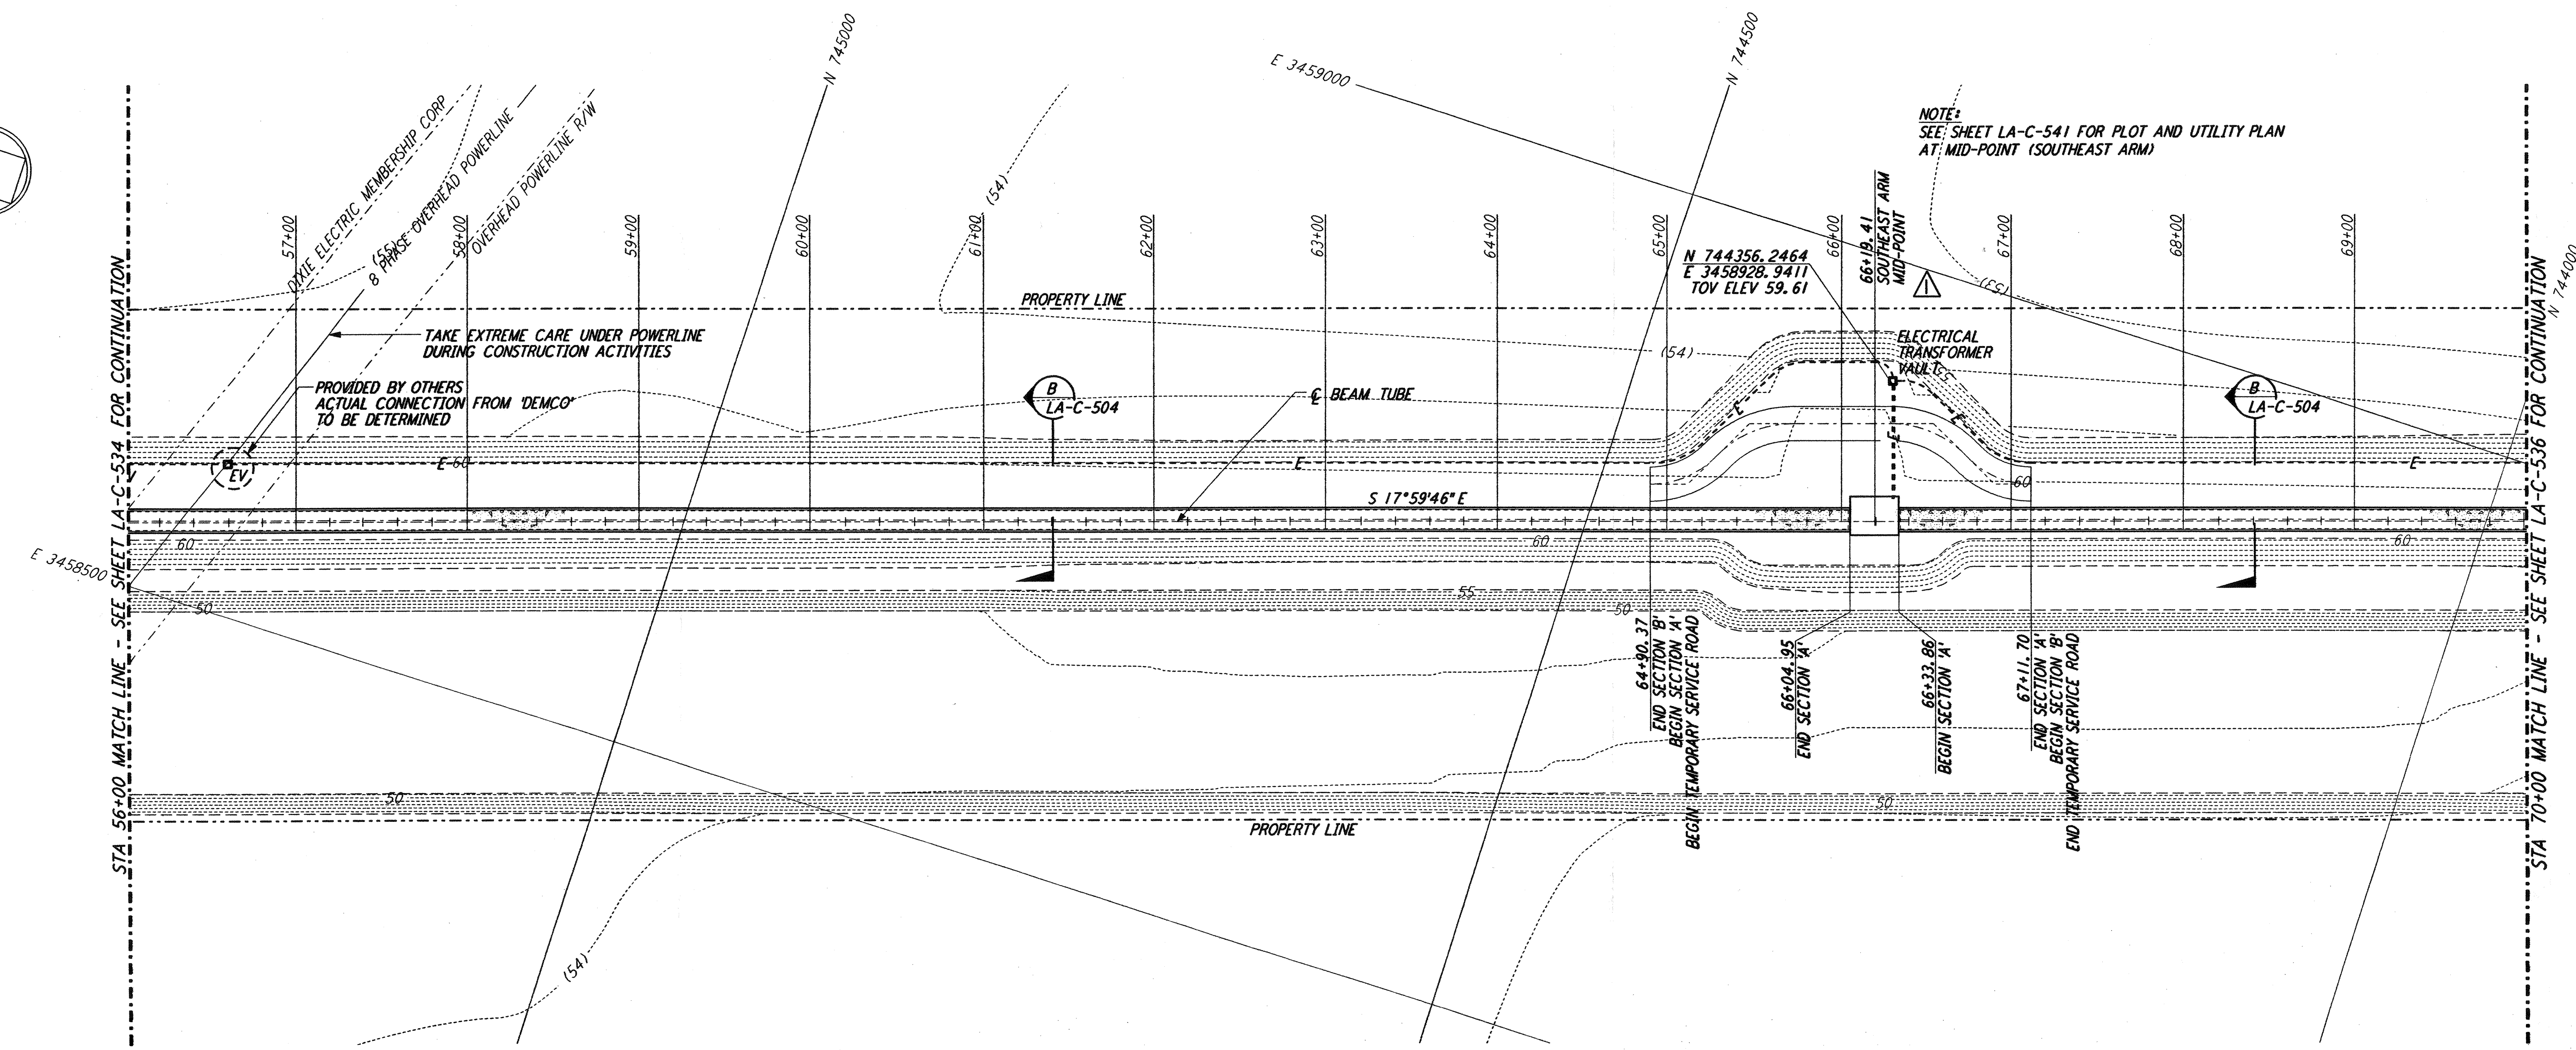

PLAN
 SCALE: 1" = 50'

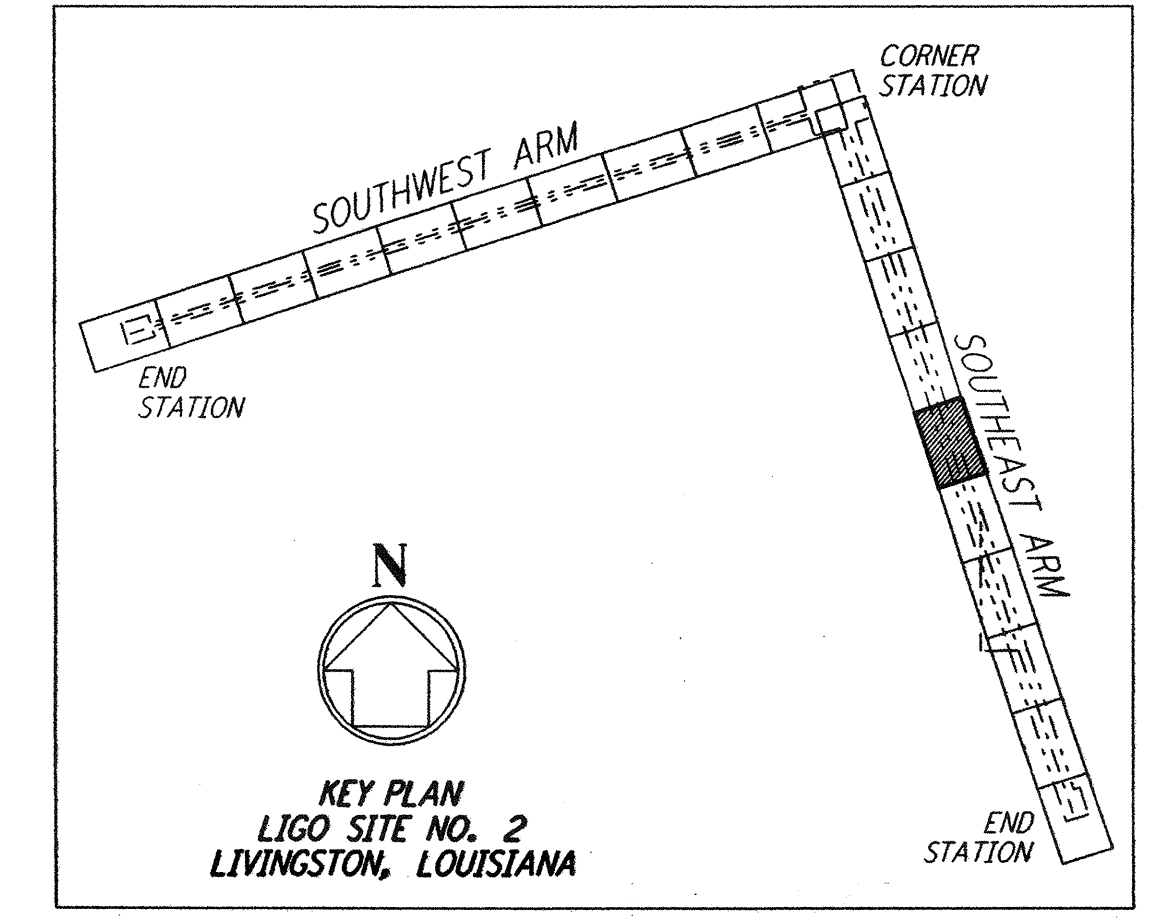

LIGO-D961280-02-O

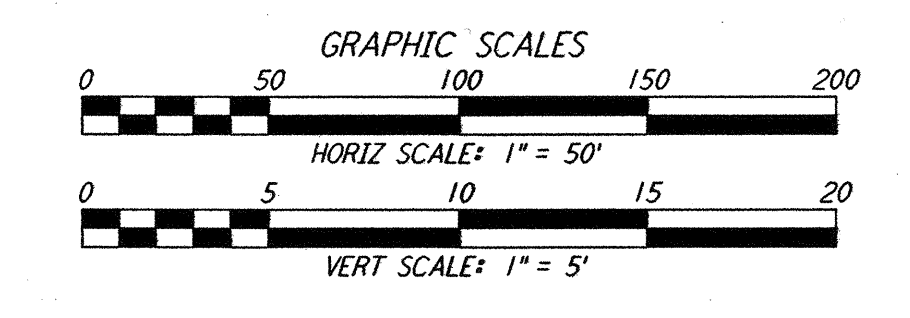

This document and the design it covers are the property of PARSONS. They are loaned only with the borrower's expressed written agreement that they will not be reproduced, copied, loaned, exhibited, or used in any other way, except by written consent from PARSONS to the borrower.

NO.	DATE	BY	CHKD	ENGR	PROJ	DESCRIPTION
2	1-15-99	MEI	--	--	MDW	ISSUED FOR AB BUILT
1	2-3-97	WRB	--	--	MDW	REVISED MID STATION, ELEC VAULT, PROFILE ELEV

NO.	DATE	BY	CHKD	ENGR	PROJ	DESCRIPTION
1	11-15-96	WRB	--	--	MDW	ISSUED FOR CONSTRUCTION
1	11-15-96	ML	--	--	MDW	CHECKED
1	11-15-96	JB	--	--	MDW	ENGINEER
1	11-15-96	TDM	--	--	MDW	PROJ

AS-BUILT DRAWINGS



100 WEST WALNUT STREET
 PASADENA, CALIFORNIA



CALIFORNIA INSTITUTE OF TECHNOLOGY
 MASSACHUSETTS INSTITUTE OF TECHNOLOGY

LASER INTERFEROMETER
 GRAVITATIONAL-WAVE OBSERVATORY
 BEAM TUBE ENCLOSURE - LIVINGSTON, LA

TITLE	SCALE	CONTRACT NUMBER	PROJECT NUMBER																																			
CIVIL SOUTHEAST ARM PLAN AND PROFILE STA 56+00 TO STA 70+00	AS NOTED	PP150969	8094																																			
SHEET NUMBER	REVISIONS																																					
LA-C-535	<table border="1"> <tr> <td>NO.</td> <td>DATE</td> <td>BY</td> <td>CHKD</td> <td>ENGR</td> <td>PROJ</td> <td>DESCRIPTION</td> </tr> <tr> <td>1</td> <td>11-15-96</td> <td>WRB</td> <td>--</td> <td>--</td> <td>MDW</td> <td>ISSUED FOR CONSTRUCTION</td> </tr> <tr> <td>1</td> <td>11-15-96</td> <td>ML</td> <td>--</td> <td>--</td> <td>MDW</td> <td>CHECKED</td> </tr> <tr> <td>1</td> <td>11-15-96</td> <td>JB</td> <td>--</td> <td>--</td> <td>MDW</td> <td>ENGINEER</td> </tr> <tr> <td>1</td> <td>11-15-96</td> <td>TDM</td> <td>--</td> <td>--</td> <td>MDW</td> <td>PROJ</td> </tr> </table>			NO.	DATE	BY	CHKD	ENGR	PROJ	DESCRIPTION	1	11-15-96	WRB	--	--	MDW	ISSUED FOR CONSTRUCTION	1	11-15-96	ML	--	--	MDW	CHECKED	1	11-15-96	JB	--	--	MDW	ENGINEER	1	11-15-96	TDM	--	--	MDW	PROJ
NO.	DATE	BY	CHKD	ENGR	PROJ	DESCRIPTION																																
1	11-15-96	WRB	--	--	MDW	ISSUED FOR CONSTRUCTION																																
1	11-15-96	ML	--	--	MDW	CHECKED																																
1	11-15-96	JB	--	--	MDW	ENGINEER																																
1	11-15-96	TDM	--	--	MDW	PROJ																																